


COLOUR REFERENCE	
[Red line]	NEW EQUIPMENT/FURNITURE (OR INDICATED BY COLOURED HATCH)
[Blue line]	EXISTING/FURNITURE EQUIPMENT
[Green line]	RELOCATED/FURNITURE EQUIPMENT
[Yellow line]	FUTURE/OPTIONAL EQUIPMENT
[Orange line]	NEW CONSTRUCTION
[Pink line]	EXISTING STRUCTURE TO BE REMOVED
[Light blue line]	EXISTING 30 MINUTE FIRE RATE WALL
[Light green line]	EXISTING 40 MINUTE FIRE RATE WALL
[Light orange line]	PROPOSED 30 MINUTE FIRE RATE WALL

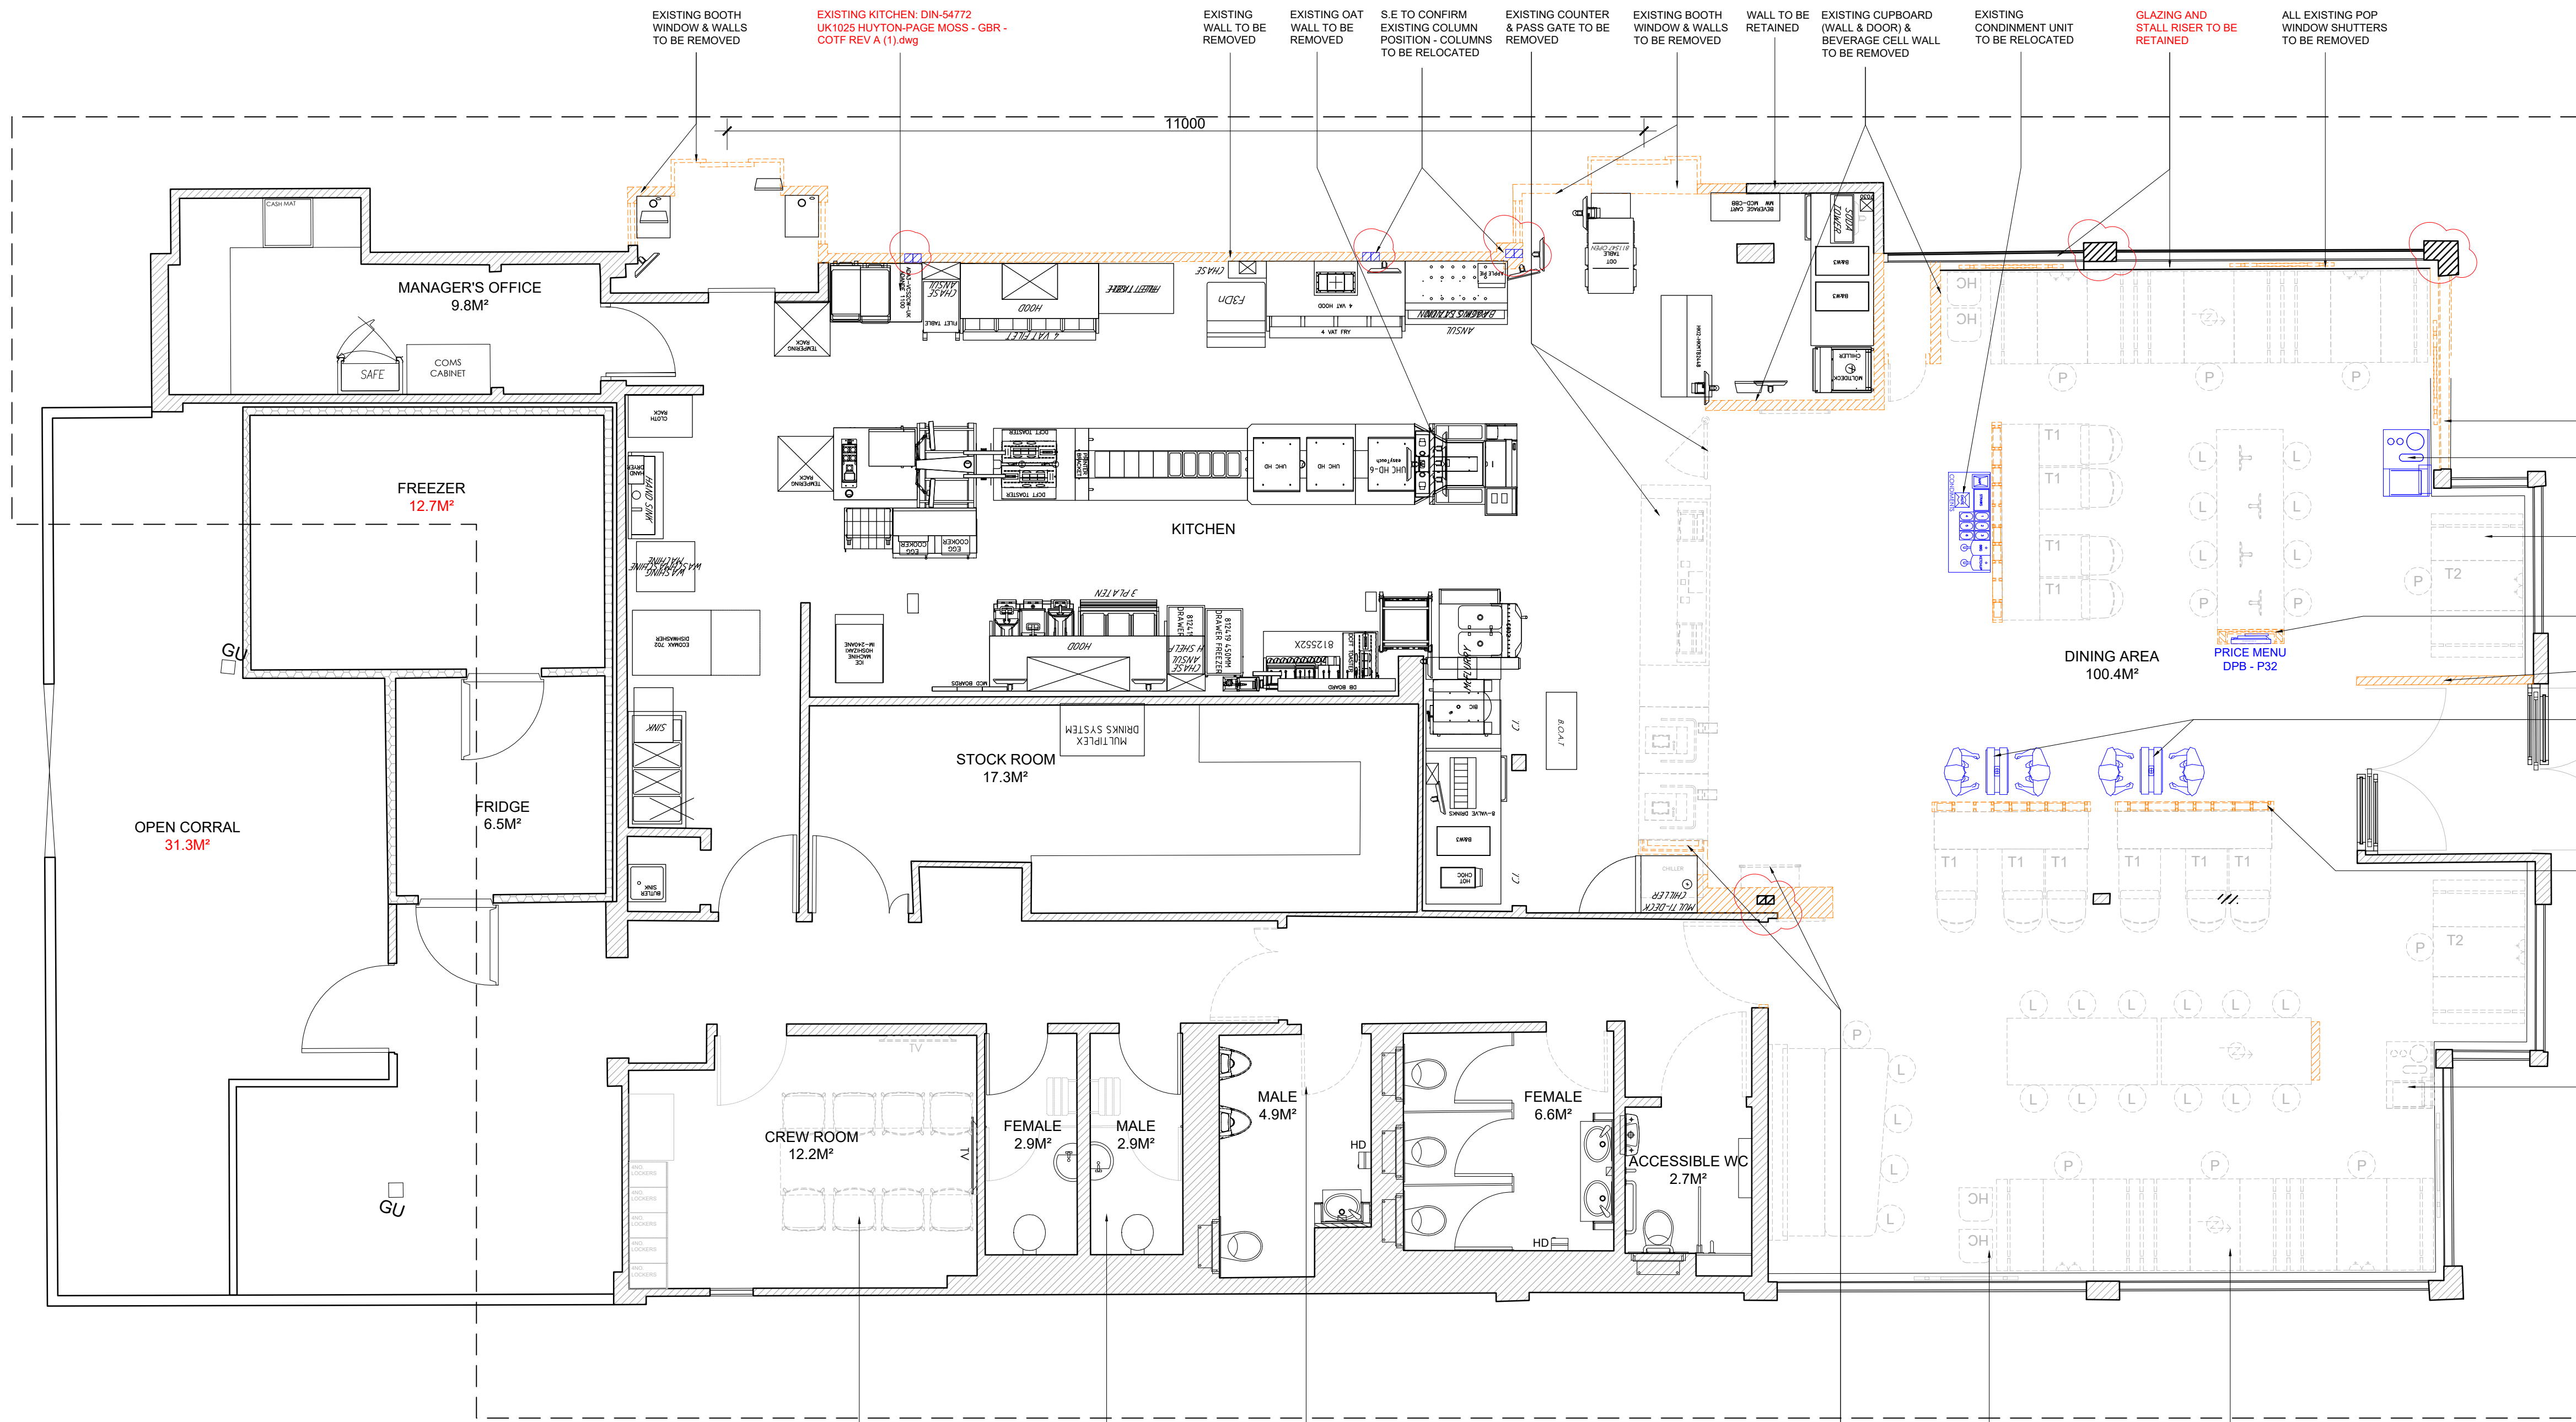

- NOTES**
- All dimensions and levels are to be checked on site.
 - Any discrepancies are to be reported to the architect before any work commences.
 - This drawing shall not be scaled to ascertain any dimensions. Work to figured dims only.
 - This drawing shall not be reproduced without express written permission from AEW.
 - Title overlay drawings and ownership boundaries are produced using all reasonable endeavours. AEW cannot be responsible for the accuracy or scale discrepancy of base plans supplied to them.
 - All works are to be undertaken in accordance with Building Regulations and the latest British Standards.
 - All proprietary materials and products are to be used strictly in accordance with the manufacturers recommendations.

CDM 2015

Client notified of duties: **At Design Workshops**

Principal Designer: **CSS**

Unless noted below, all known hazards have been highlighted on the drawing:

Notes:
All drawings to be read in conjunction with all other drawings as noted on issue sheet.

- EXISTING GLAZING & SECTION OF STALL RISER TO BE REMOVED
- EXISTING MINI RECYCLING UNIT TO BE RELOCATED
- ALL EXISTING FURNITURE IN DINING AREA TO BE REMOVED
- EXISTING PRICE MENU BOARD TO BE RELOCATED
- EXISTING WALL TO BE REMOVED
- EXISTING DOUBLE SOKS TO BE RELOCATED
- ALL EXISTING SCREENS IN DINING AREA TO BE REMOVED
- EXISTING MINI RECYCLING UNIT TO BE REMOVED

- CREW ROOM:
 - ALL EXISTING FURNITURE IN CREW ROOM TO BE REMOVED
 - LOCKERS TO BE REMOVED
 - KITCHEN UNIT TO BE REMOVED
 - EXISTING FRIDGE & MICROWAVE TO BE RELOCATED. PM TO ADVISE
 - TV TO BE RETAINED, SECONDARY SCREEN TO BE REMOVED
- SANITARYWARE TO BE RETAINED
- CUBICLE DOORS, PARTITIONS + BENCHES TO BE REMOVED
- NEW VINYL REQUIRED TO DOORS
- ALL EXISTING DOORS FACING CUSTOMER CORRIDOR TO BE REMOVED
- EXISTING WALL, MCAFE SCREEN & WALL MOUNTED HMM TO BE REMOVED
- ALL EXISTING HIGH CHAIRS TO BE REMOVED
- ANY EXISTING SOCKETS TO THE PERIMETER TO BE RETAINED

AREAS SCHEDULE	EXISTING
TOTAL COVERS	89
DINING AREA INTERNAL AREA (m²)	100.4m²
WC INTERNAL AREA (m²)	14.2m²
CREW ROOM INTERNAL AREA (m²)	12.2m²

DRAWINGS BASED ON:
AS BUILT: SGD280-1025-50_J
EXISTING KITCHEN: DIN-54772 UK1025 HUYTON-PAGE MOSS - GBR - COTF REV A (1).dwg

GEOMERTY
COTF & REIMAGE

A	22/08/2022	PC	MW
UPDATED FOLLOWING STAGE 1 MEETING 12/06/22			
- EXISTING WALL TO ENTRANCE LOBBY TO BE REMOVED			
- CREW ROOM/ CREW WC WORKS DETERMINED			
- CORRAL UPDATED TO EXISTING SITUATION ON SITE			
-	24/05/2022	AL	MW
INITIAL ISSUE			
REV	Date	Drawn by: -	Checked by: -
S2	FOR INFORMATION		
drawing stage	STAGE 1		
client	McDonald's Restaurants Ltd		
project	store		
LIVERPOOL ROAD, PAGE MOSS, HUYTON		1025	
drawing title			
EXISTING GA PLAN COTF			
date	23.05.2022	drawn	AL
scale@A1	1:50	checked	MW

EXISTING GENERAL ARRANGEMENT PLAN 1:50