



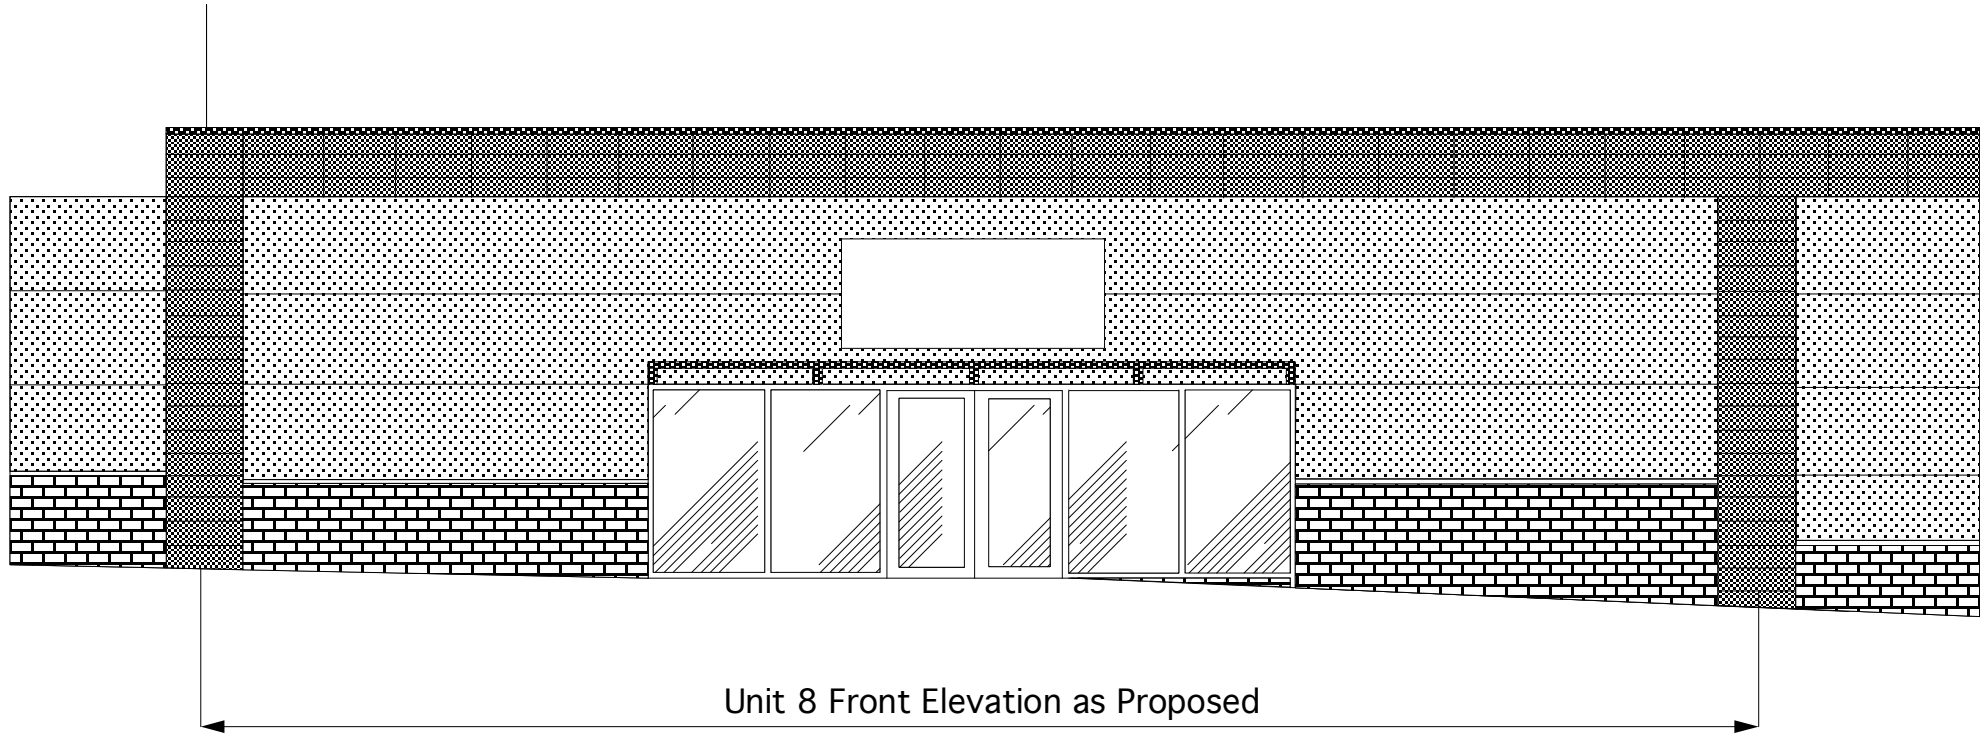


Unit 8 Front Elevation as Proposed

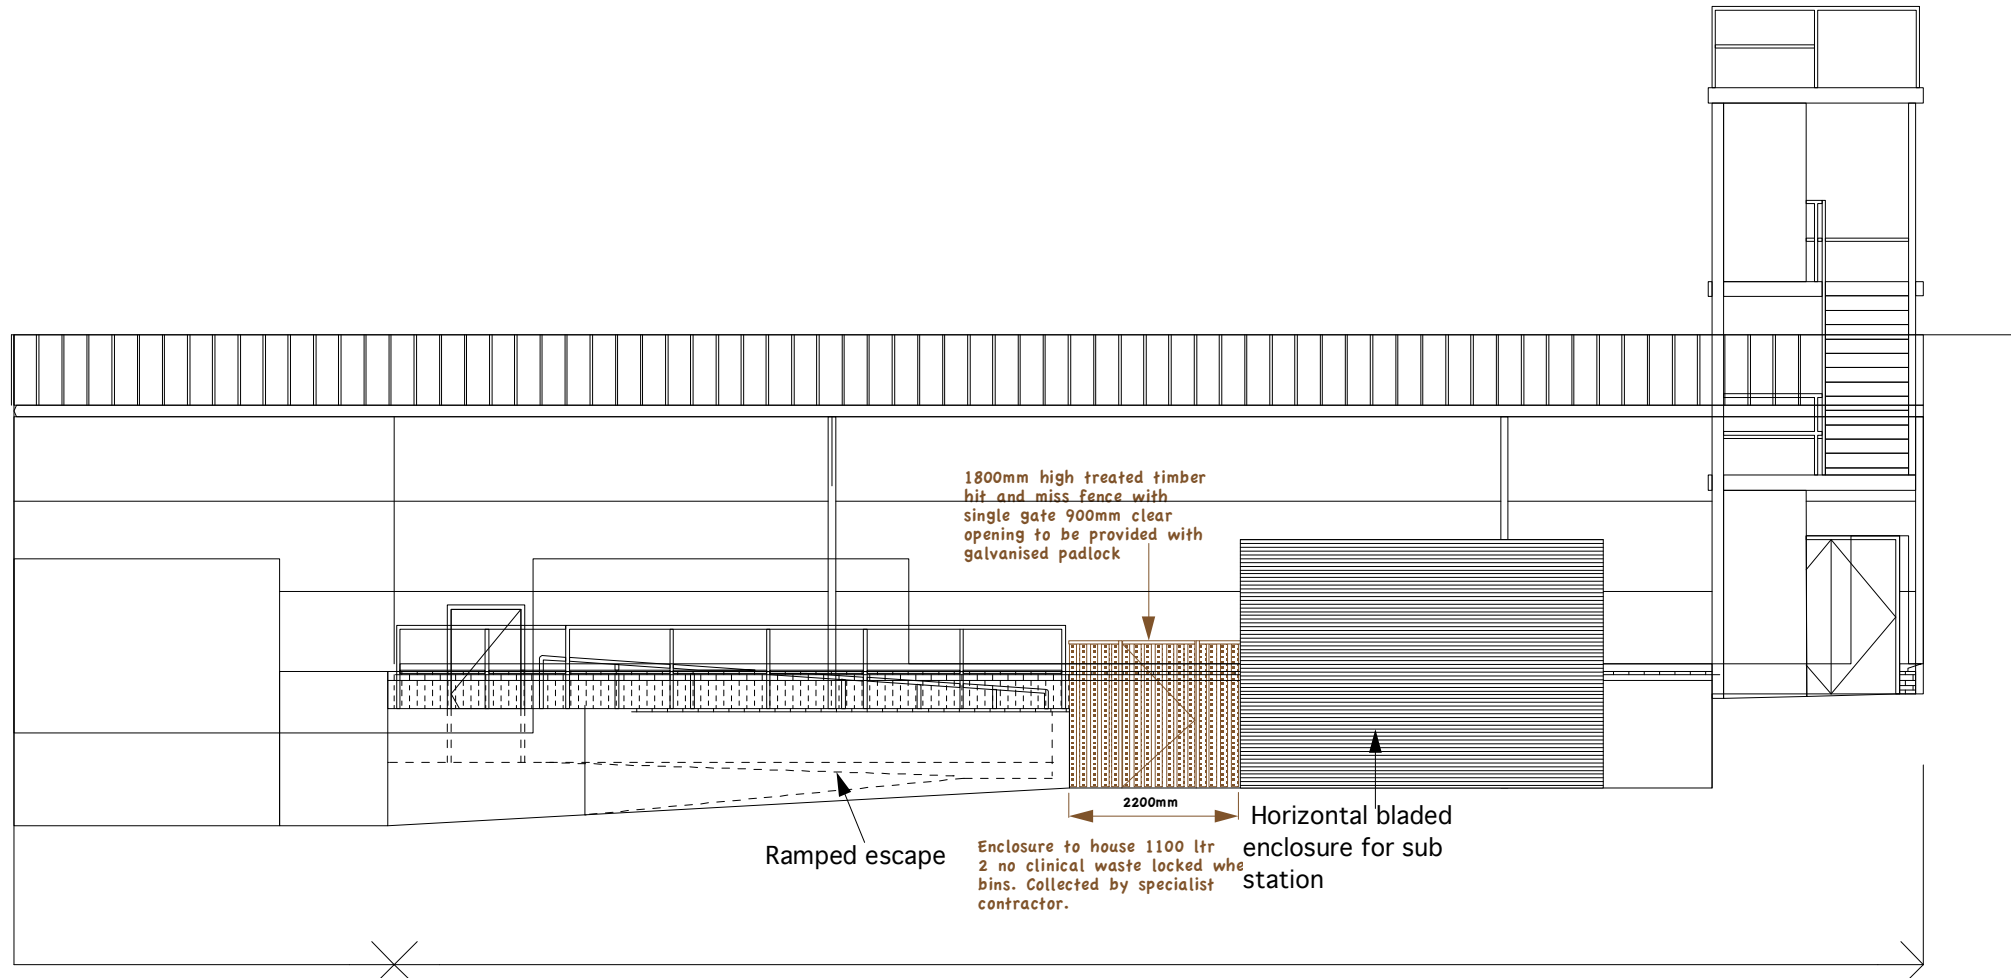

SERVICE YARD

UNIT 8 Rear Elevation as Proposed

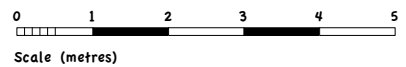

project Unit 8, Kirkby Retail Park, L32 8US			
drawing Elevations as Proposed			
dwg no. 456/04.A		scale 1:100@A3	
date April 2024		drawn by PGL	
preliminary	approval	planning	X
tender	construction	as built	
 PETER LITTLEWOOD ASSOCIATES LTD 1 Brock Drive, Cheadle Hulme, Cheadle, Cheshire, SK8 6LP T 0161 485 4964 E peter@peterlittlewood.com			

Rev.A. Clinical Waste dim added...07.05.24

under the BIAT conditions of engagement the copyright in all drawings specifications and documents prepared by the designer and in the work executed form them shall remain the property of the designer unless otherwise agreed. Do not scale from the drawing. Work to figured dimensions. Check all dimensions on site. In event of any discrepancy, refer to the designer.