


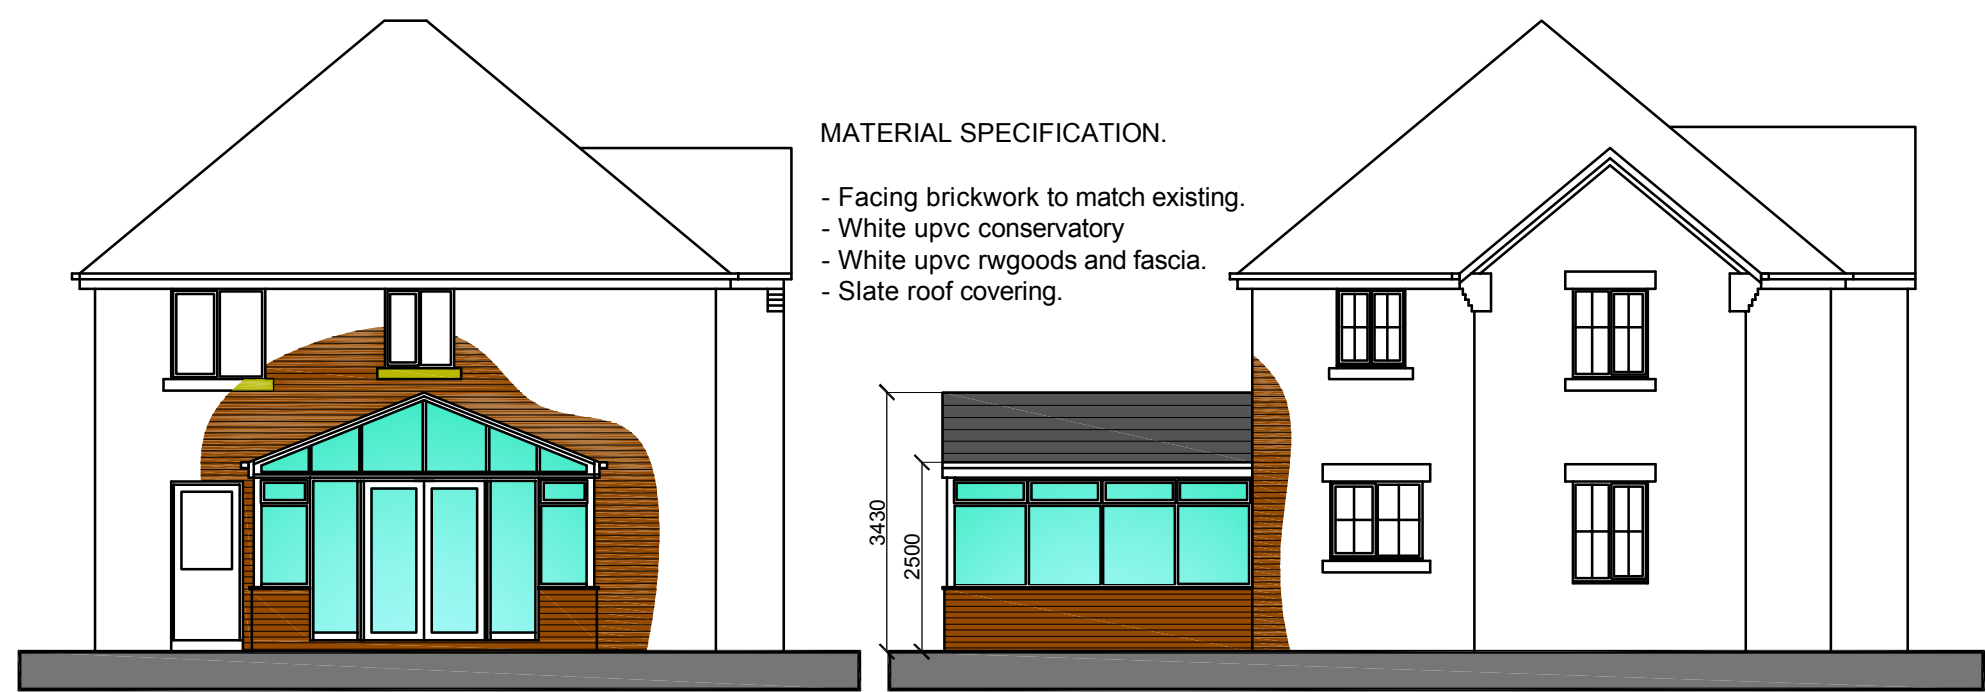


MATERIAL SPECIFICATION.


- Facing brickwork to match existing.
- White upvc conservatory
- White upvc rsgoods and fascia.
- Slate roof covering.

proposed - as built
rear elevation

proposed - as built
side / street elevation

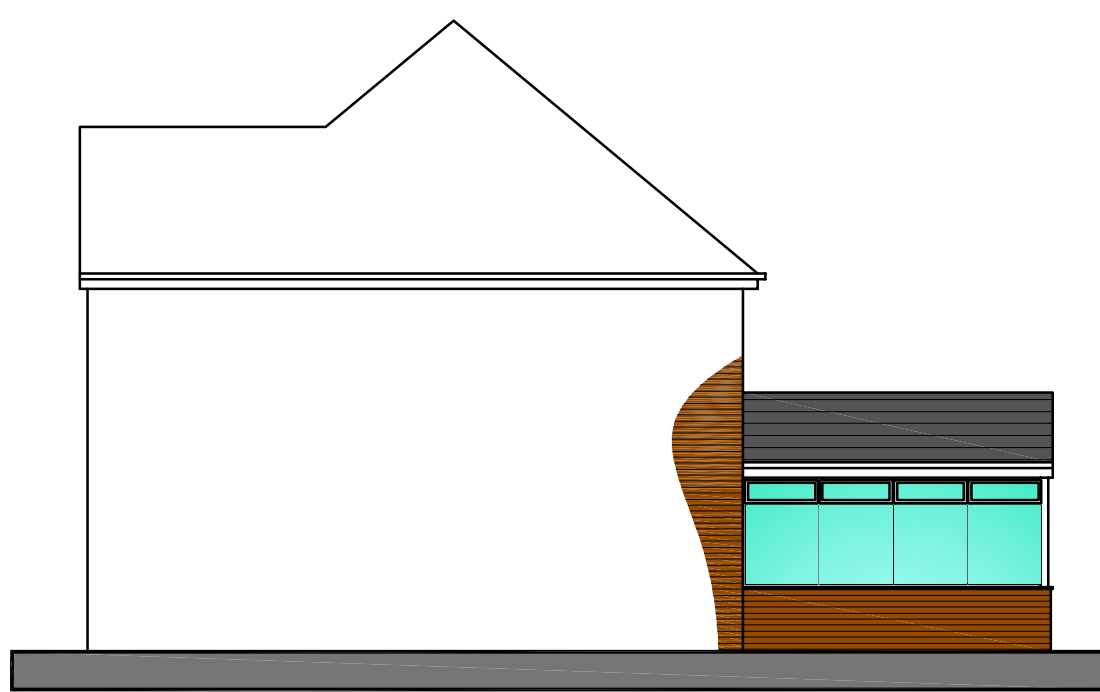


proposed - as built - 1:100
side / driveway elevation

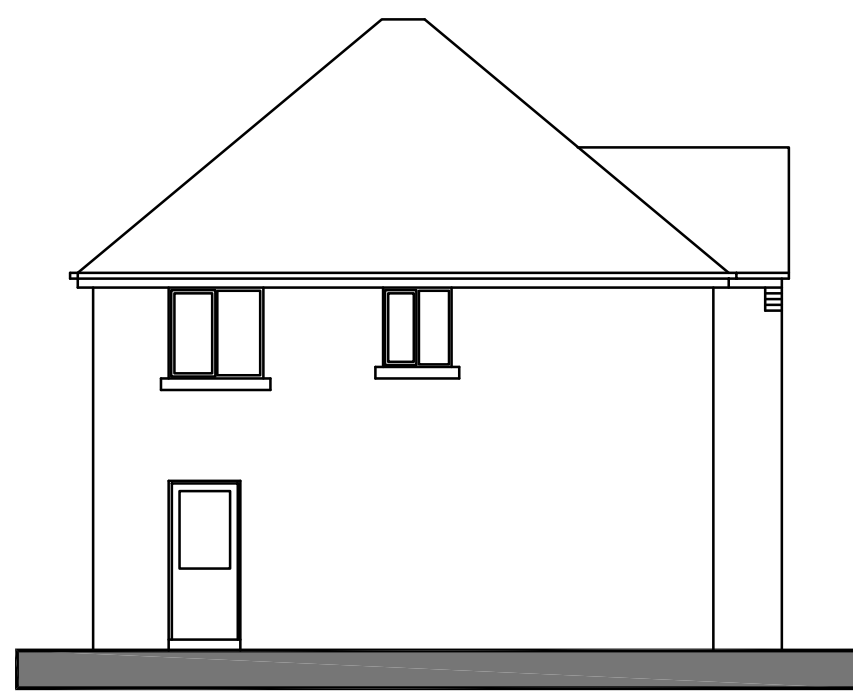


existing
rear elevation




existing
side / street elevation

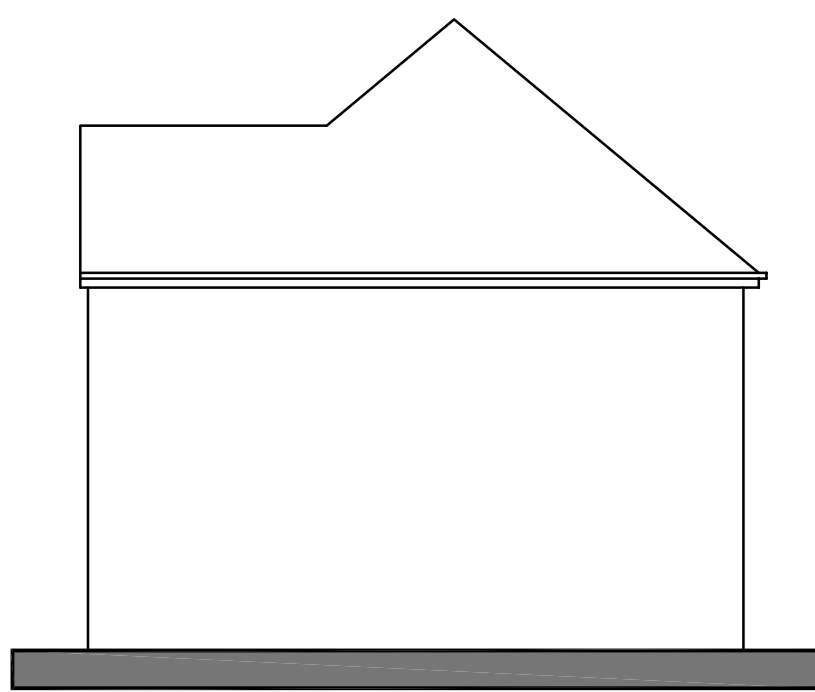


existing
side / driveway elevation

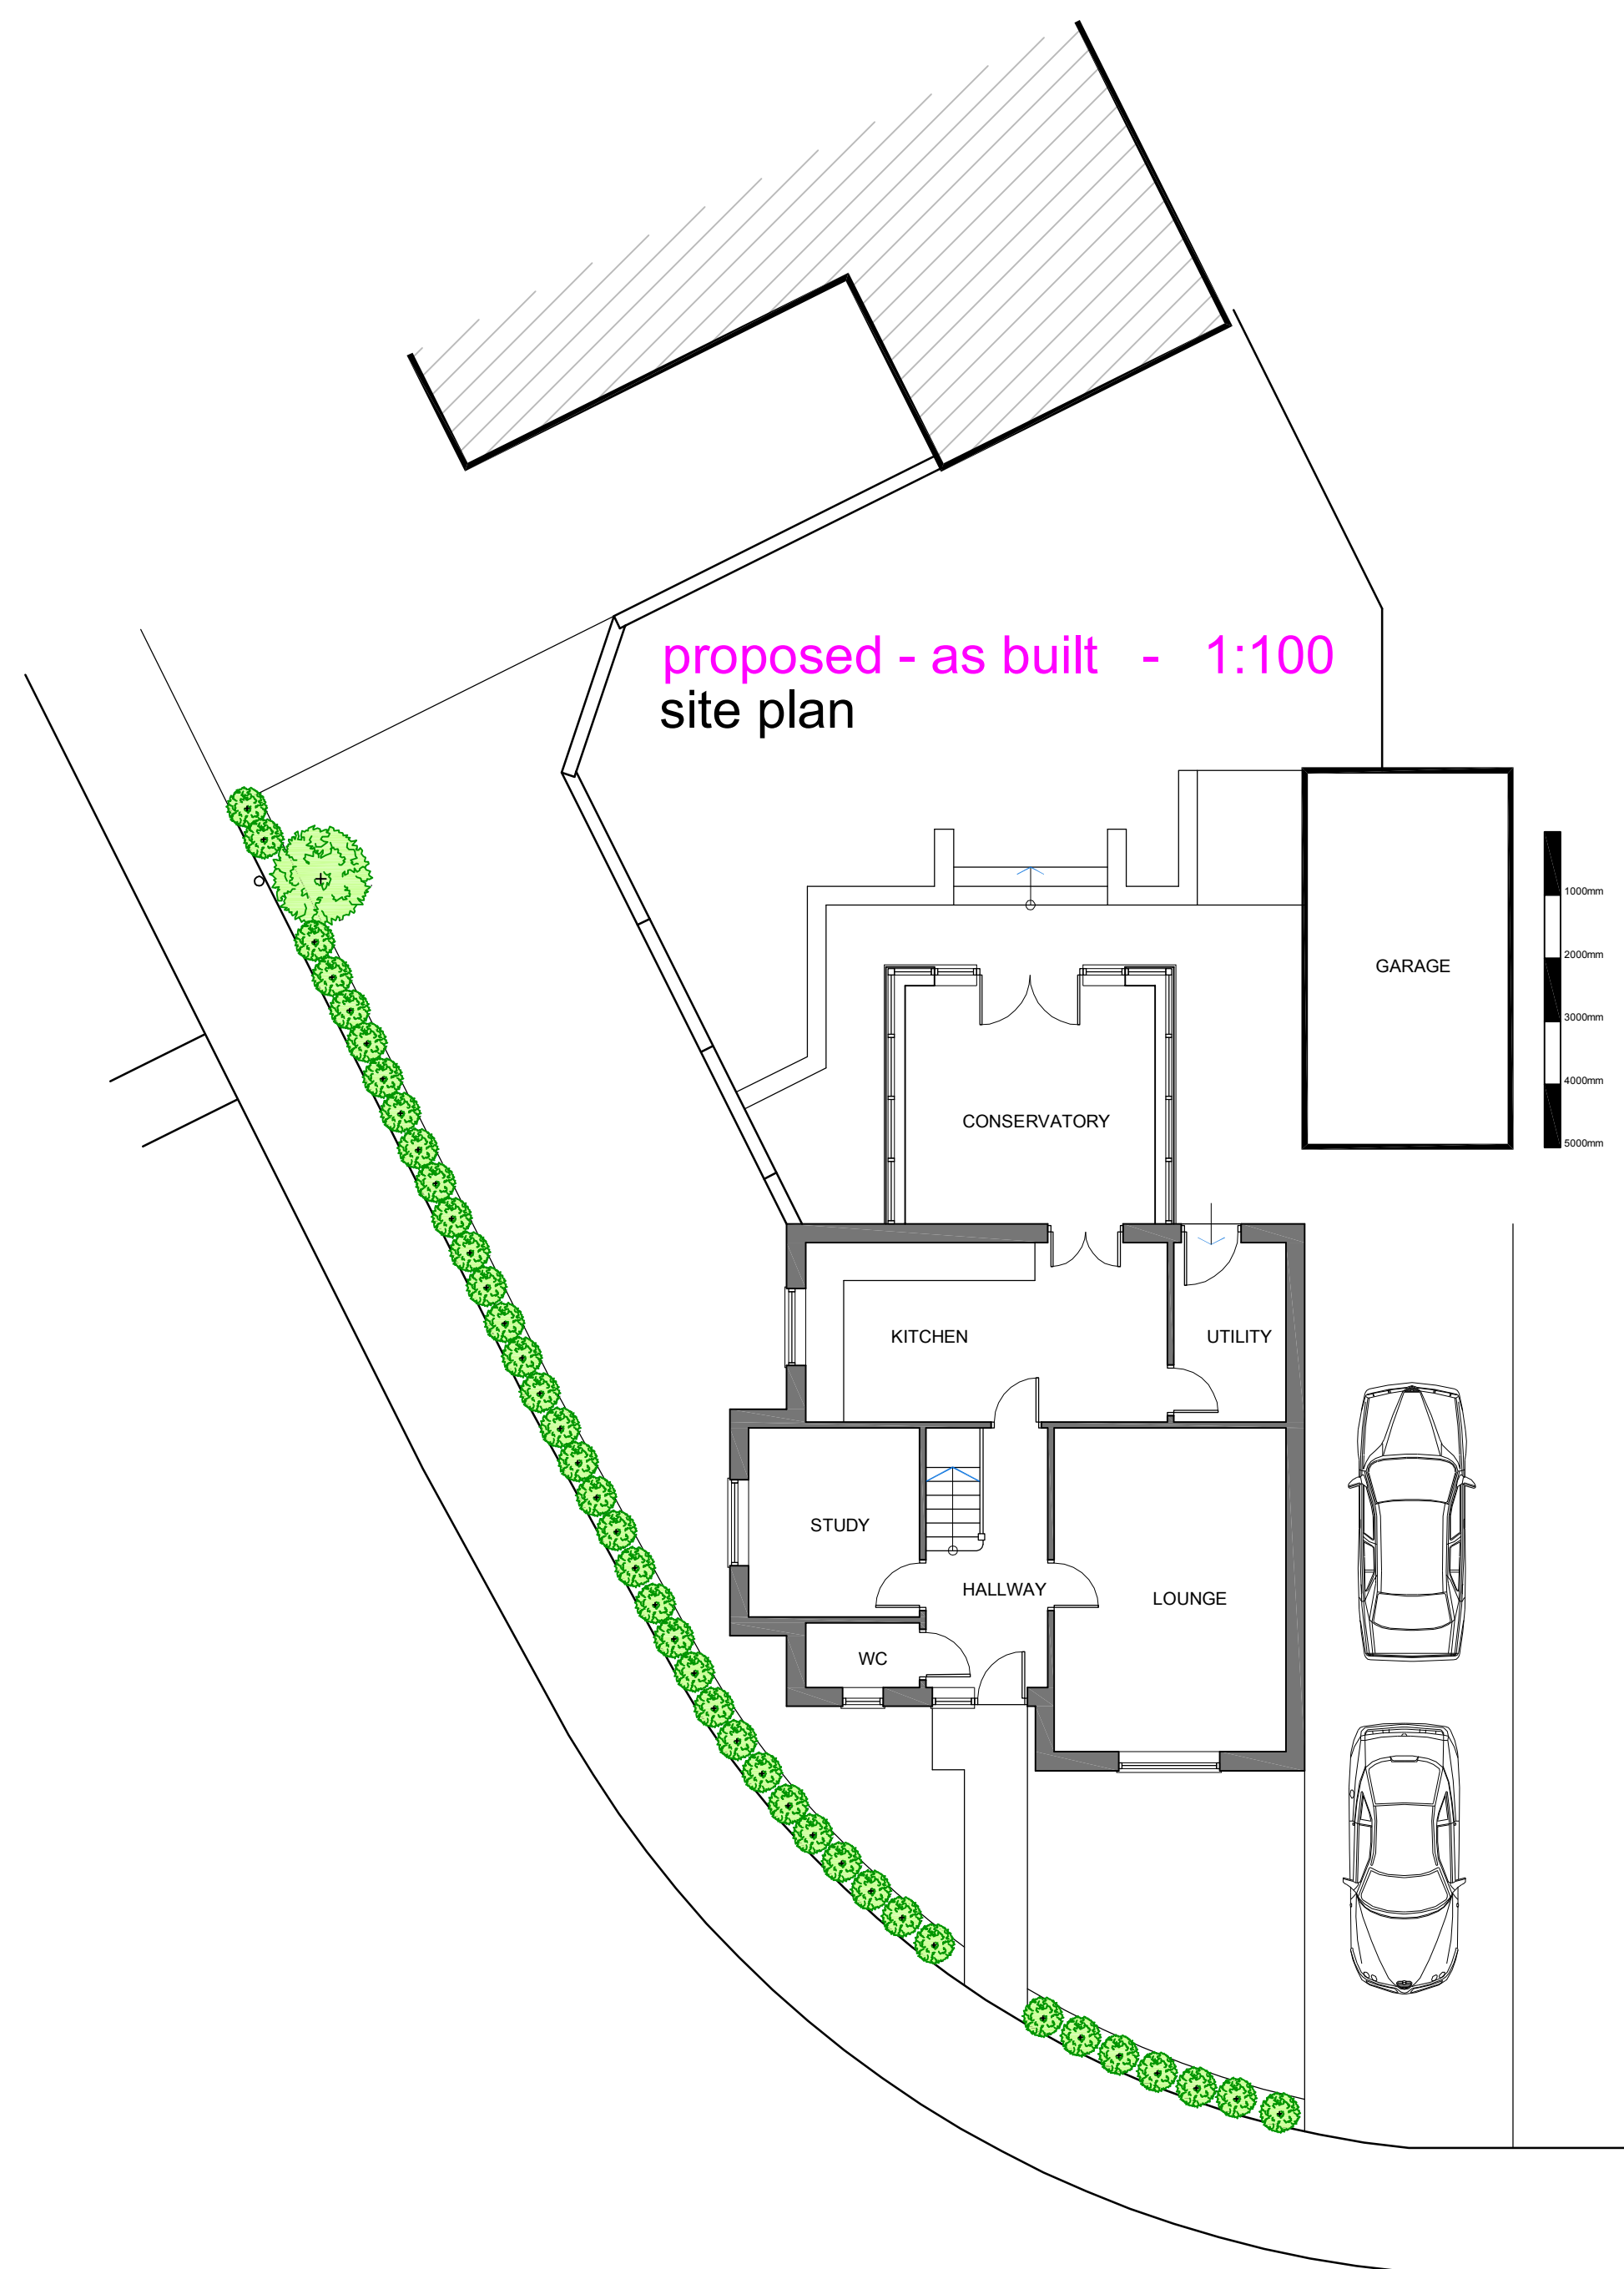


proposed - as built - 1:100
site plan

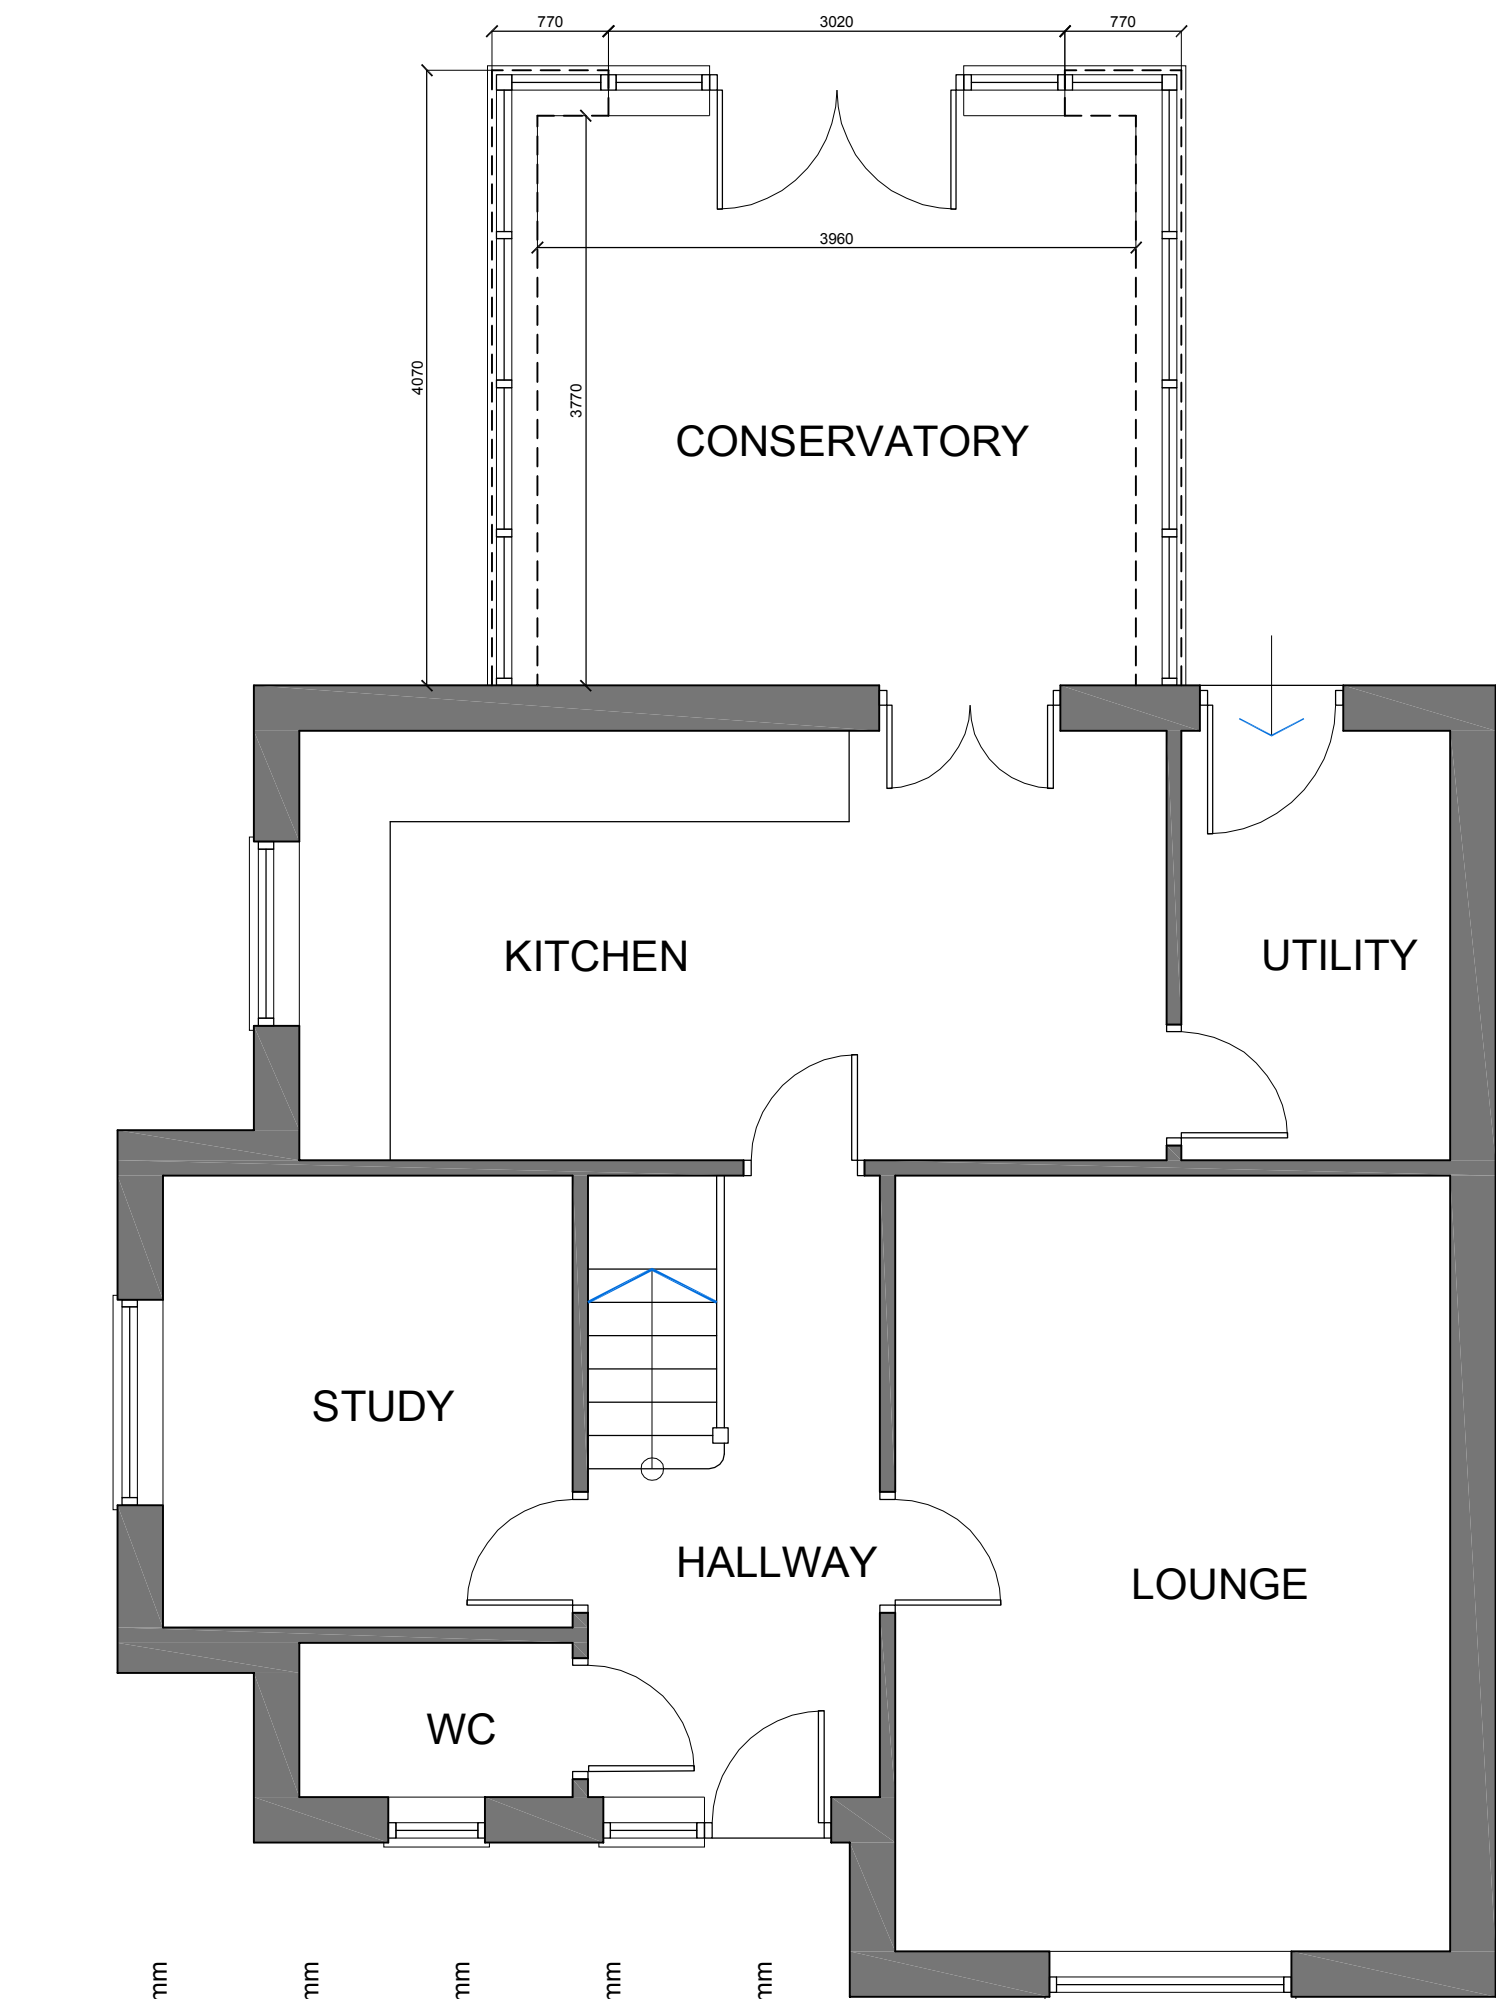


proposed - as built
ground floor plan 1:50

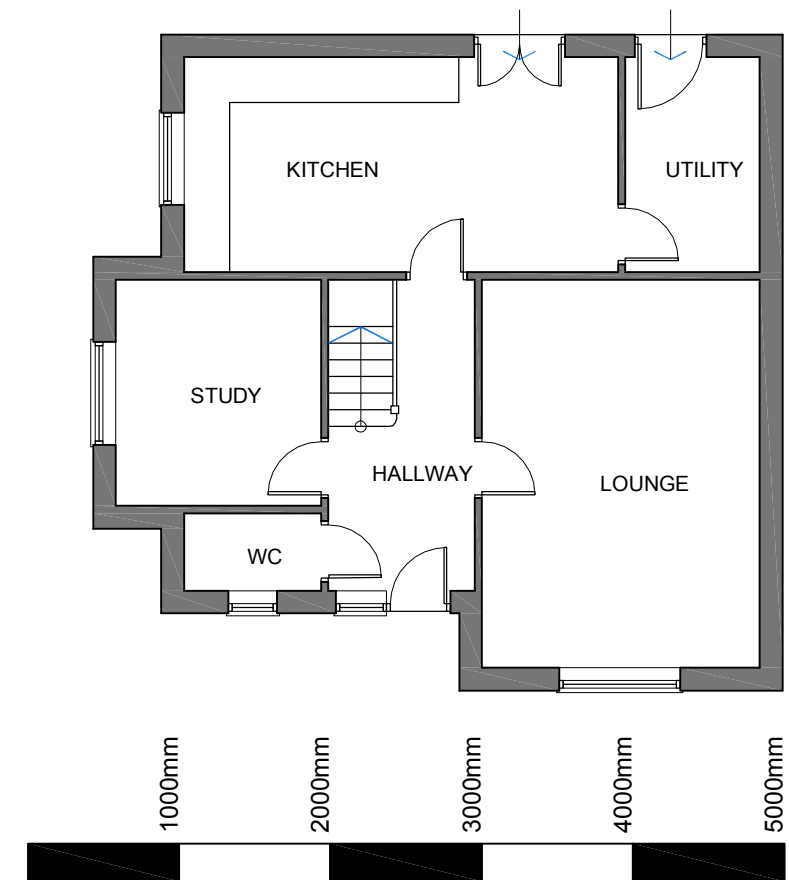

existing
ground floor plan 1:100

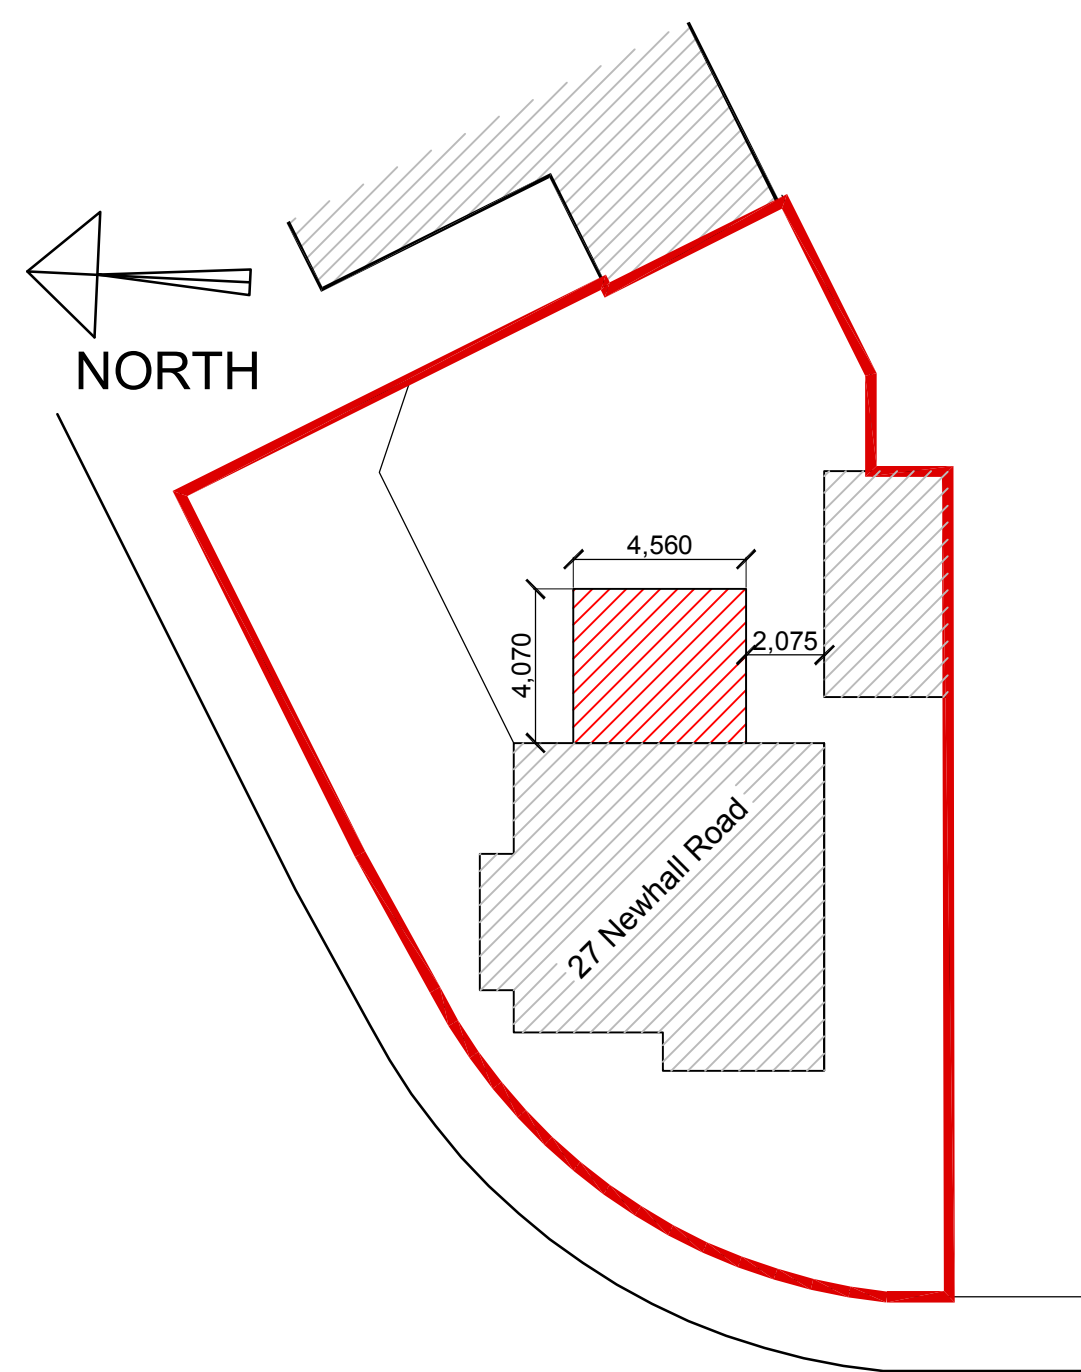

proposed
block plan - 1:200

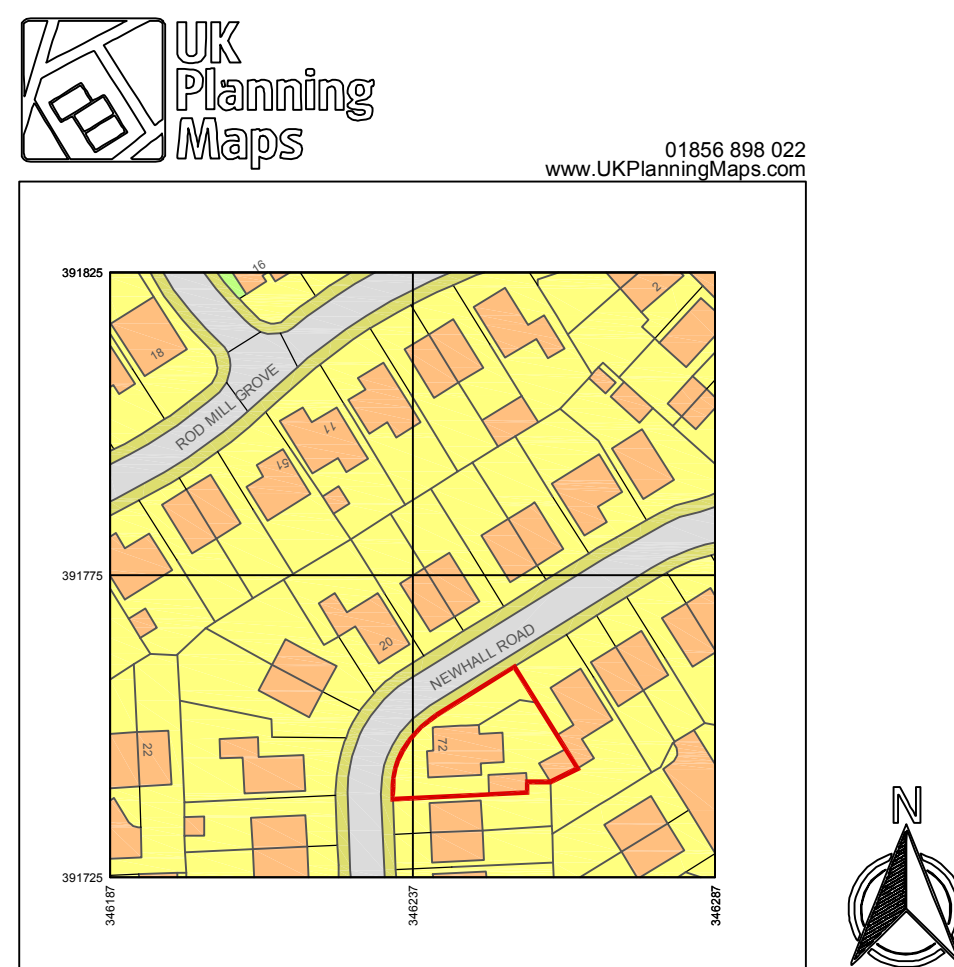

proposed
location plan 1:1250

Client	Mr & Mrs Brian Doyle	Rev		Date		Description	
Job Ref	27 Newhall Road, Prescott, Merseyside, L34 1AQ						
Drawing Title	Existing / As Built Floor Plans, Elevations & Siteplan						
Job No.	Studio-2026-388-001-PL						
Scale	1:50 / 100 / 200 / 250	Revision	/				
Date	March 26	Drawn	Dave H				

STUDIO
architecture
Bringing extensions to desirable dwellings

The Annexe
75 St. Helens Road
Ormskirk
L39 4QW.
M: 07729 099011
E: studio.architecture@outlook.com

A1
A2
A3
A4