



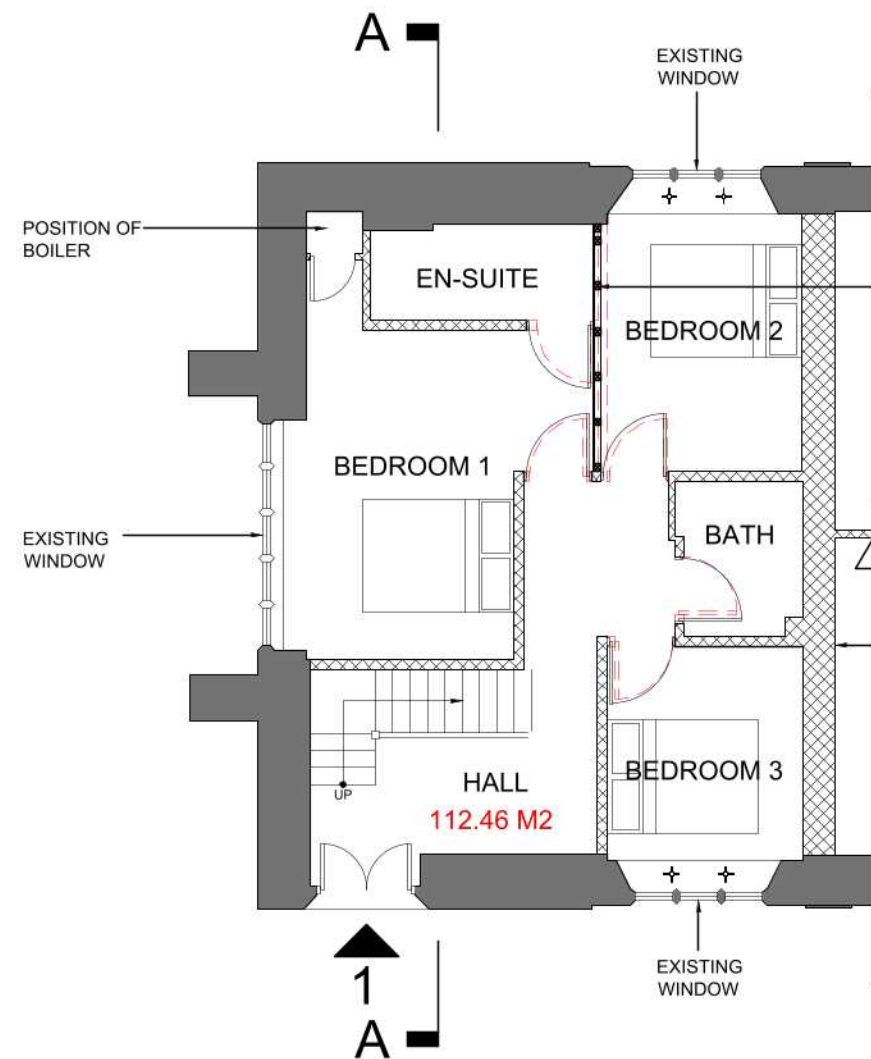


PROPOSED GROUND FLOOR PLAN

### KEY

- EXISTING WALL CONSTRUCTION
- AS BUILT WALL CONSTRUCTION

### SCALE BAR (M)

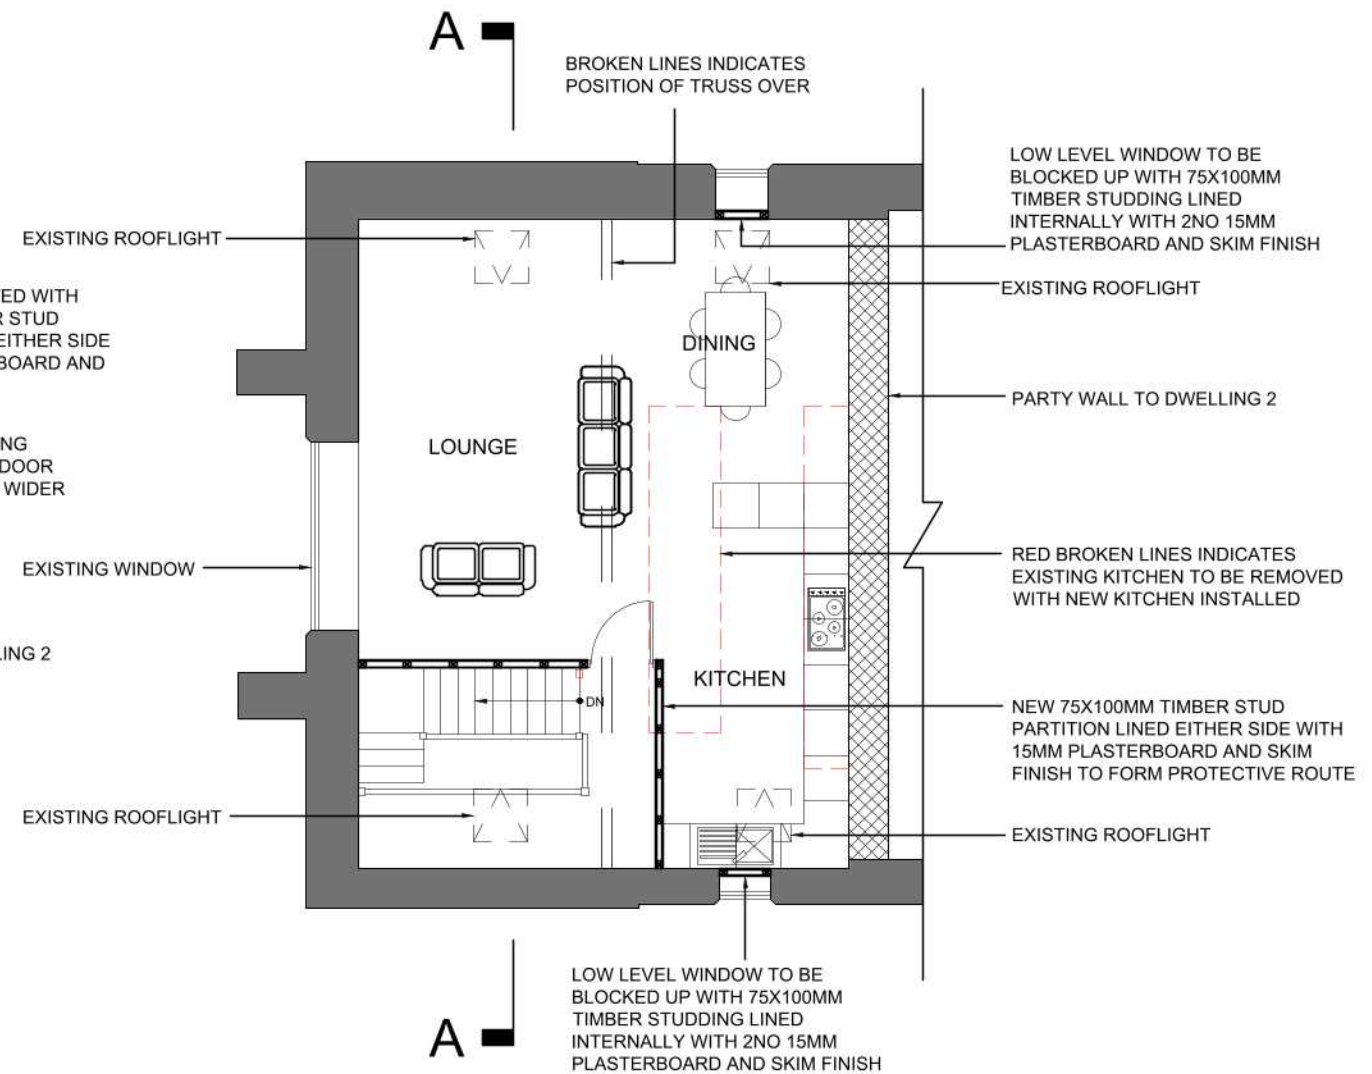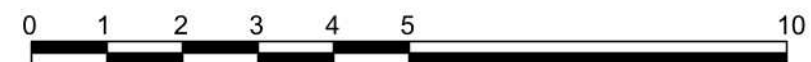

PROPOSED FIRST FLOOR PLAN

| REV                                                                                                                                                                                                                           | DESCRIPTION                                                  |
|-------------------------------------------------------------------------------------------------------------------------------------------------------------------------------------------------------------------------------|--------------------------------------------------------------|
| A                                                                                                                                                                                                                             | FIRST FLOOR LOW LEVEL WINDOWS TO BE BLOCKED UP 16.01.24 D.D. |
| <b>DWELLING 1 - PROPOSED FLOOR PLANS</b>                                                                                                                                                                                      |                                                              |
| <b>PROPOSED CONVERSION OF EXISTING CHURCH INTO FIVE DWELLINGS</b>                                                                                                                                                             |                                                              |
| <b>PARK HALL, HUYTON HEY ROAD, LIVERPOOL</b>                                                                                                                                                                                  |                                                              |
| CLIENT:                                                                                                                                                                                                                       | PARK HALL HUYTON LTD                                         |
| DWG NO:                                                                                                                                                                                                                       | PL K1116/04                                                  |
| SCALE:                                                                                                                                                                                                                        | 1/100 @ A3                                                   |
| DRAWN BY:                                                                                                                                                                                                                     | D.D.                                                         |
| DATE:                                                                                                                                                                                                                         | 13/11/23                                                     |
| REV:                                                                                                                                                                                                                          | A                                                            |
| MICHIGAN HOUSE, 17-19 CHORLEY NEW ROAD, BOLTON, BL1 4QR<br>TEL: 01204 392233 FAX: 01204 528505<br>WWW.NEILPIKEARCHITECTS.CO.UK EMAIL: INFO@NEILPIKEARCHITECTS.CO.UK                                                           |                                                              |
| <div style="display: flex; align-items: center;"> <div> <b>NEIL PIKE</b><br/>             ARCHITECTS           </div> </div>                                                                                                  |                                                              |
| <small>COPYRIGHT OF THIS DRAWING REMAINS WITH THE ARCHITECT. DO NOT SCALE FROM THIS DRAWING. WORK TO FIGURED DIMENSIONS. CHECK ALL DIMENSIONS ON SITE. IN THE EVENT OF ANY DISCREPANCY REFER QUERY TO THE ARCHITECTS.</small> |                                                              |