



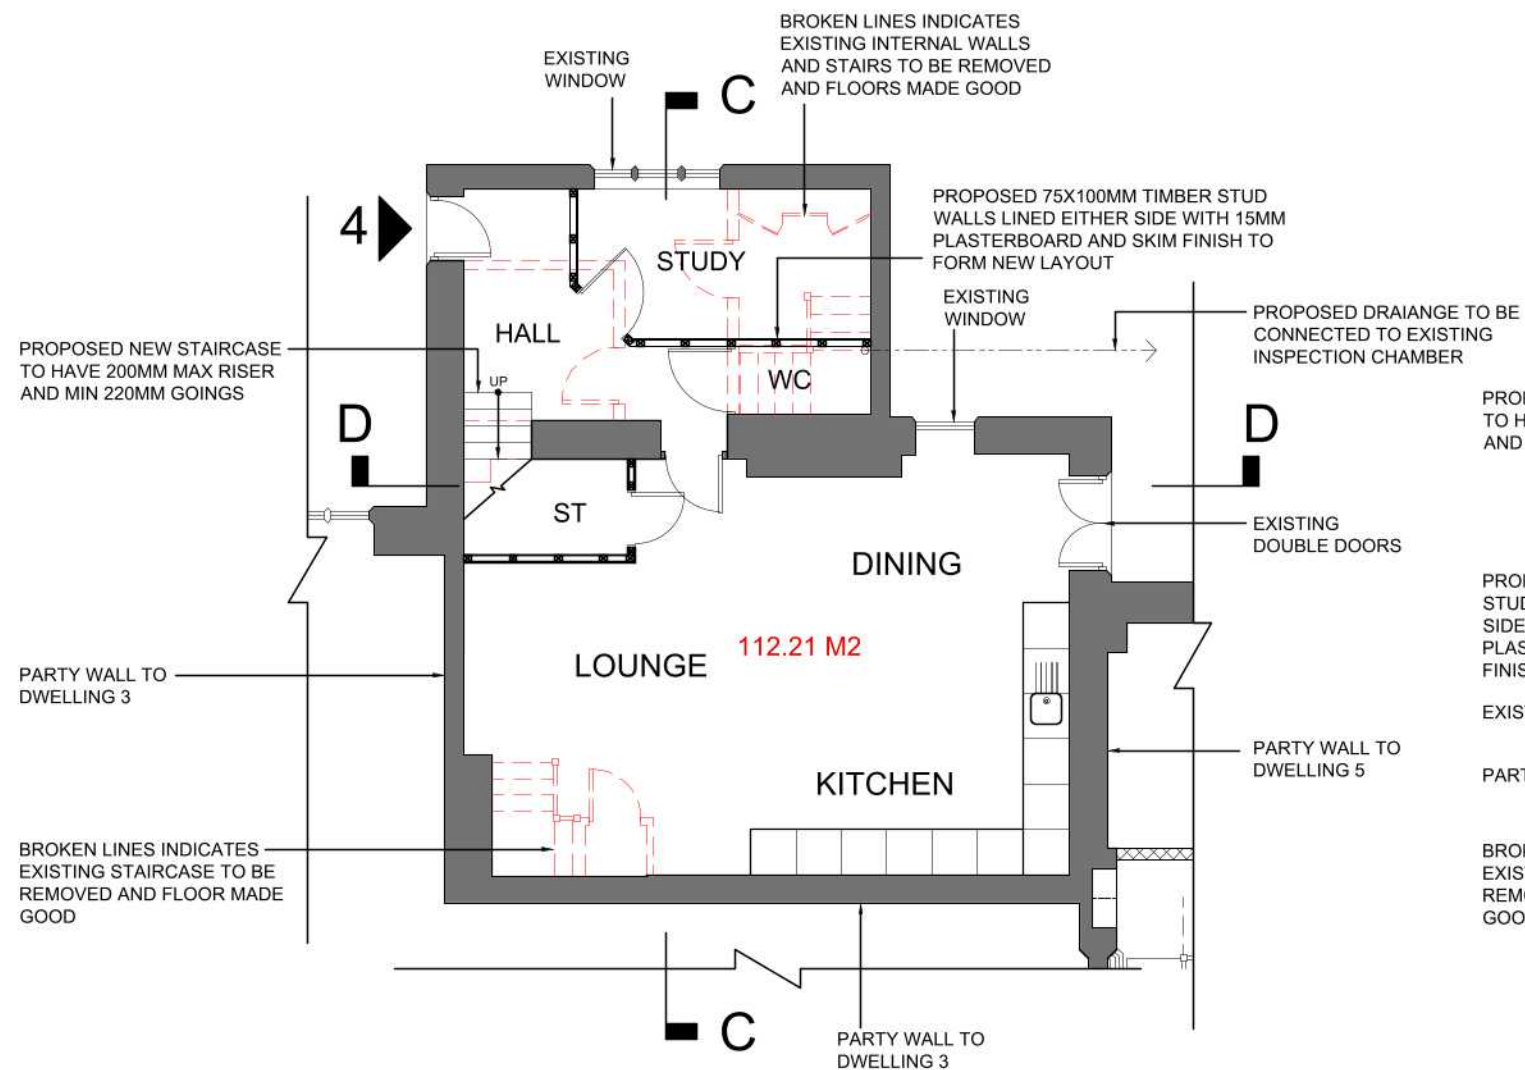

PROPOSED GROUND FLOOR PLAN

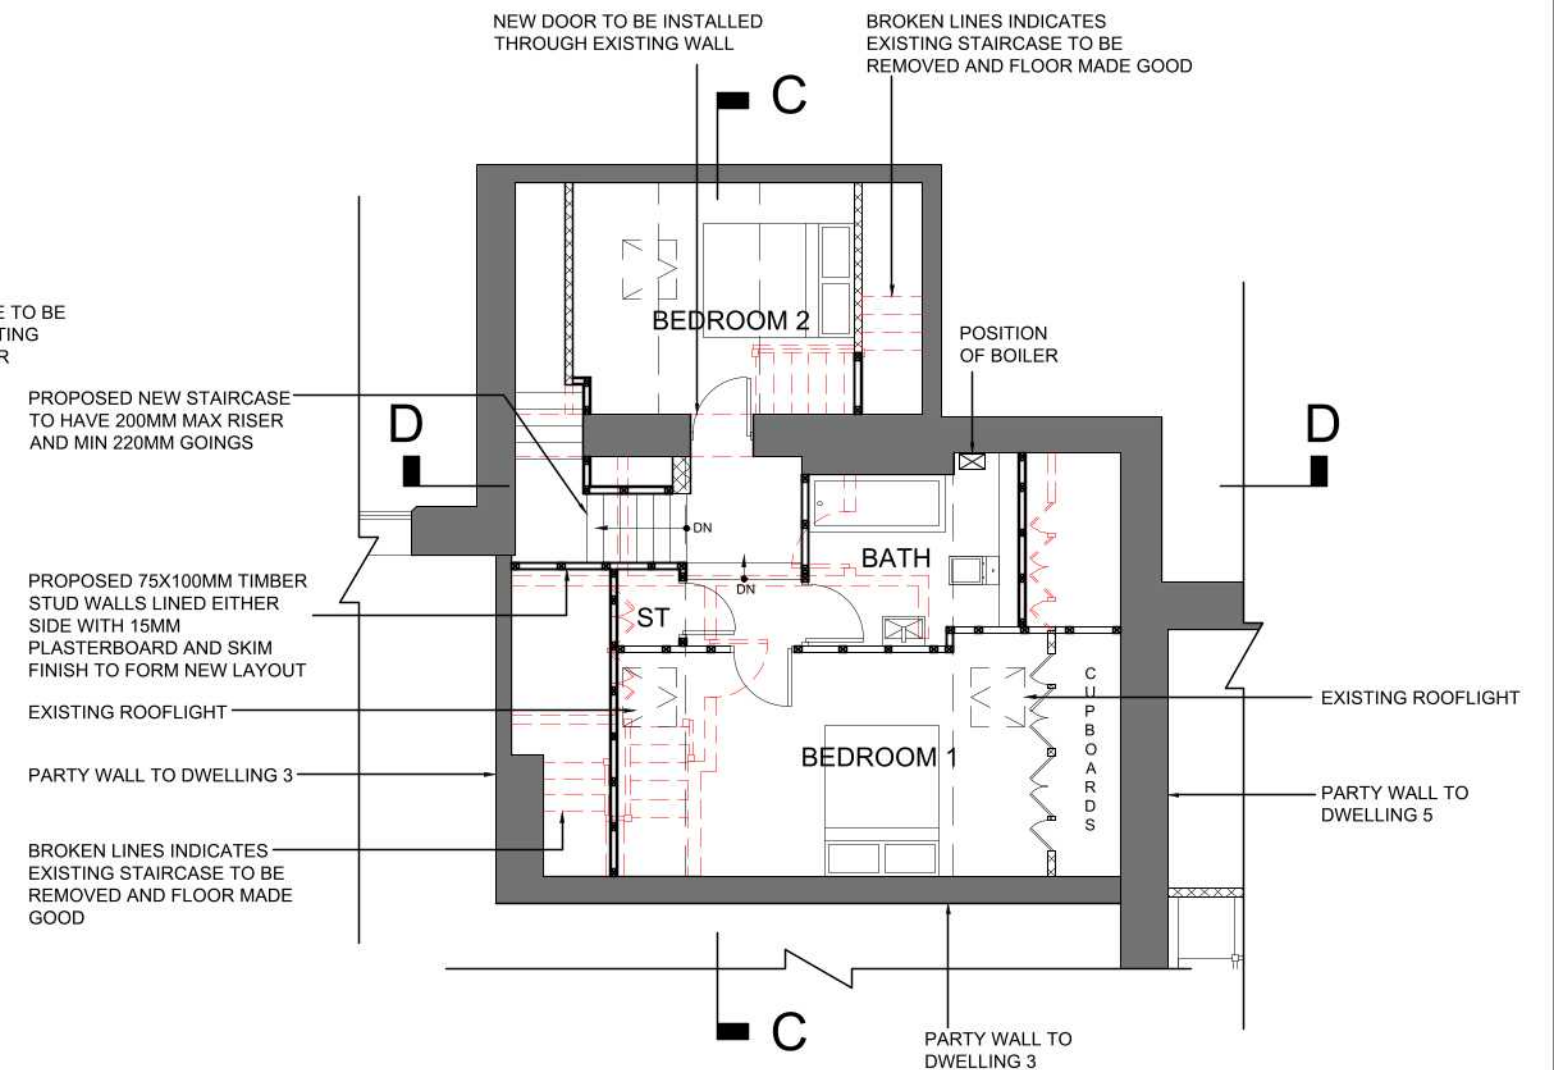


PROPOSED FIRST FLOOR PLAN

KEY

- EXISTING WALL CONSTRUCTION
- AS BUILT WALL CONSTRUCTION

SCALE BAR (M)

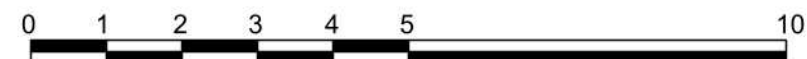

REV	DESCRIPTION
A	STAIR CASE AMENDED 11.01.24 R.P.
B	STAIR AND STORE ROOM REPOSITIONED AND LAYOUT AMENDED 16.01.24 D.D.
DWELLING 4 - PROPOSED FLOOR PLANS	
PROPOSED CONVERSION OF EXISTING CHURCH INTO FIVE DWELLINGS PARK HALL, HUYTON HEY ROAD, LIVERPOOL	
CLIENT:	PARK HALL HUYTON LTD
DWG NO:	PL K1116/07
SCALE:	1/100 @ A3
DRAWN BY:	D.D.
DATE:	13/11/23
REV:	B
MICHIGAN HOUSE, 17-19 CHORLEY NEW ROAD, BOLTON, BL1 4QR TEL: 01204 392233 FAX: 01204 528505 WWW.NEILPIKEARCHITECTS.CO.UK EMAIL: INFO@NEILPIKEARCHITECTS.CO.UK	
COPYRIGHT OF THIS DRAWING REMAINS WITH THE ARCHITECT. DO NOT SCALE FROM THIS DRAWING. WORK TO FIGURED DIMENSIONS. CHECK ALL DIMENSIONS ON SITE. IN THE EVENT OF ANY DISCREPANCY REFER QUERY TO THE ARCHITECT.	

NEIL PIKE
ARCHITECTS