


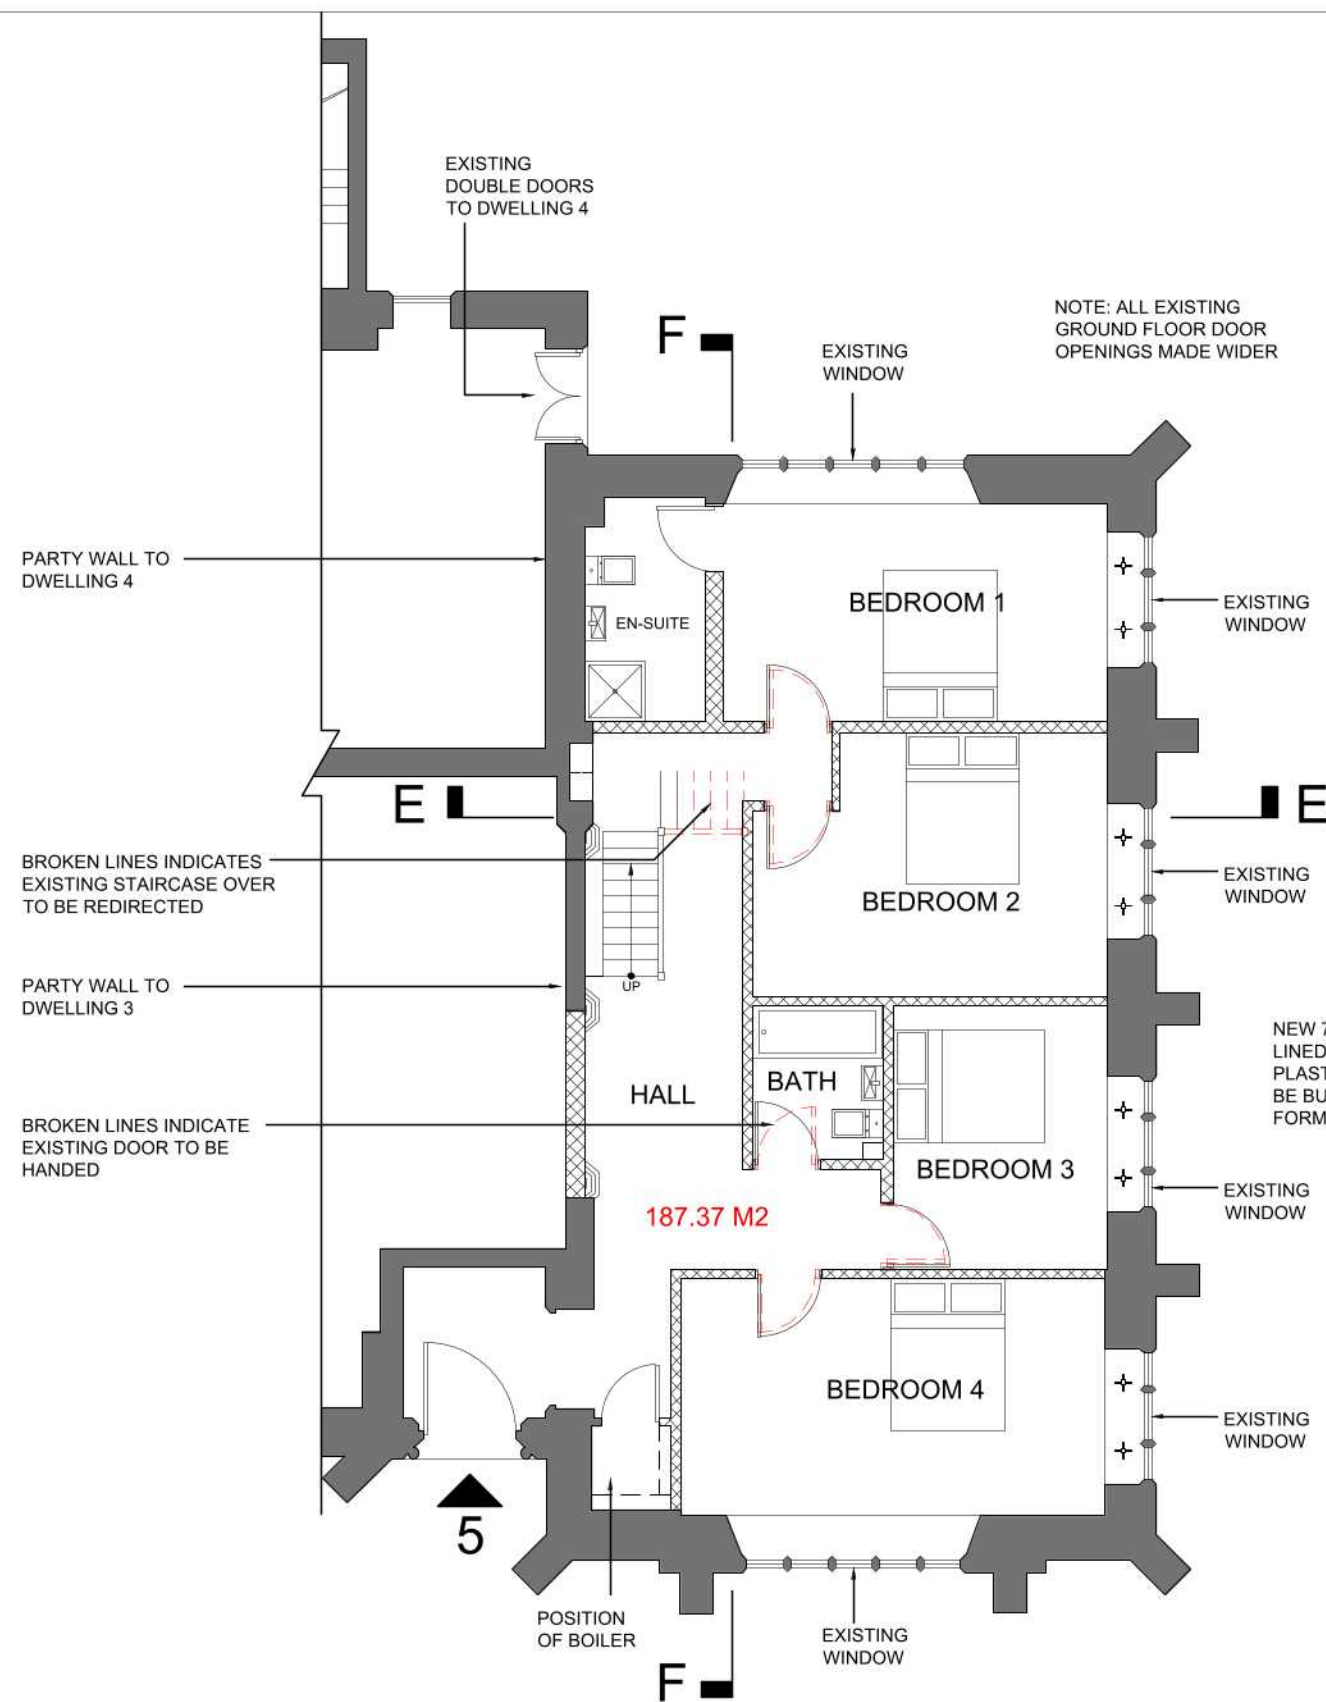


PROPOSED GROUND FLOOR PLAN

KEY

- EXISTING WALL CONSTRUCTION
- AS BUILT WALL CONSTRUCTION

SCALE BAR (M)

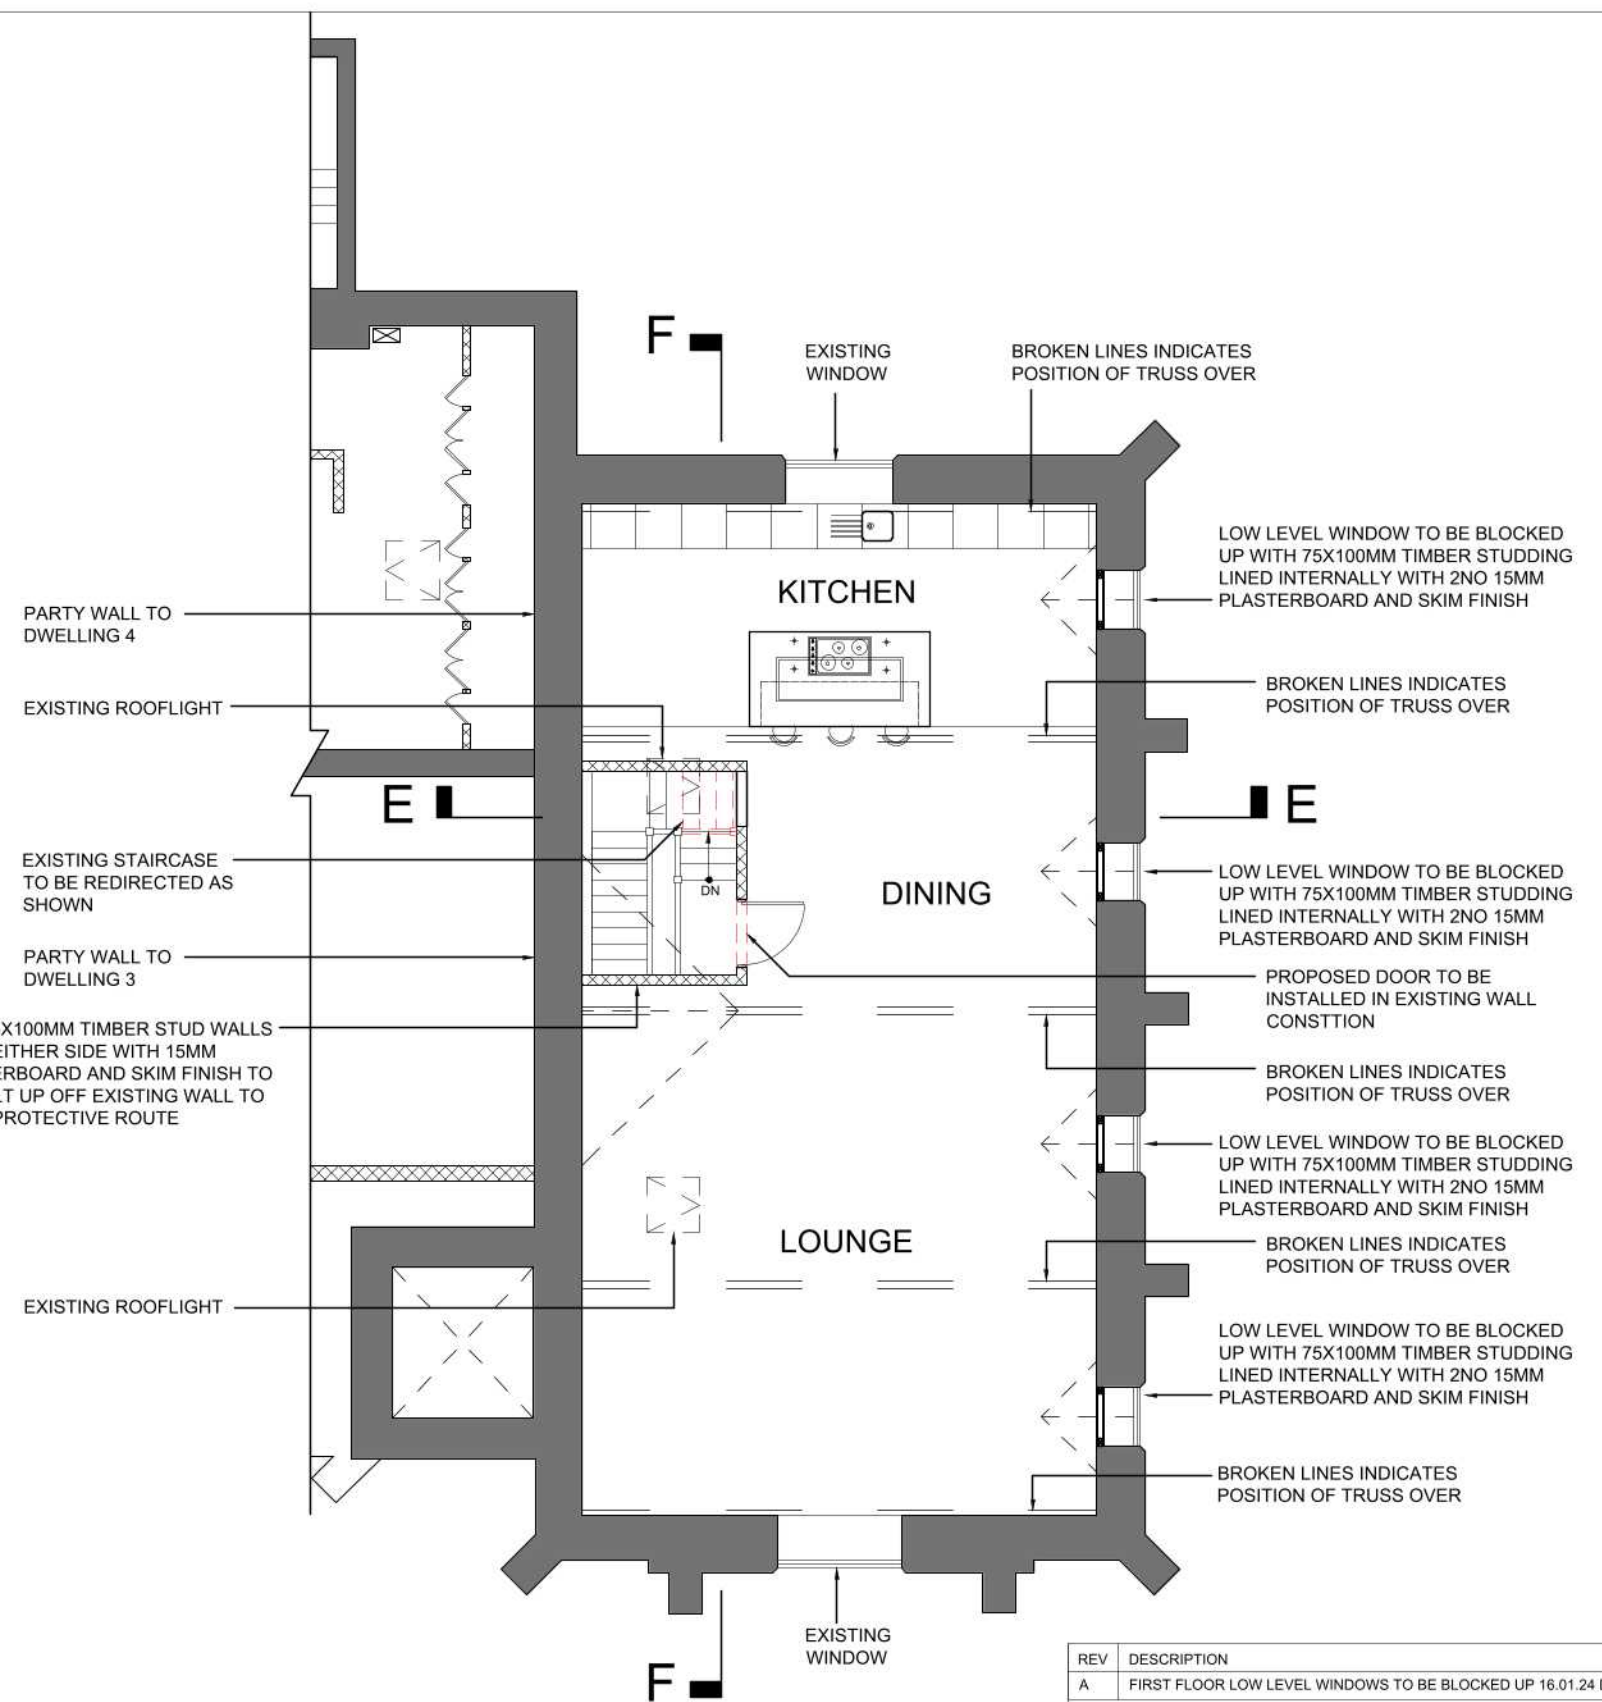

PROPOSED FIRST FLOOR PLAN

REV	DESCRIPTION
A	FIRST FLOOR LOW LEVEL WINDOWS TO BE BLOCKED UP 16.01.24 D.D.

DWELLING 5 - PROPOSED FLOOR PLANS	
PROPOSED CONVERSION OF EXISTING CHURCH INTO FIVE DWELLINGS	
PARK HALL, HUYTON HEY ROAD, LIVERPOOL	
CLIENT:	PARK HALL HUYTON LTD
DWG NO:	PL K1116/08
SCALE:	1/100 @ A3
DRAWN BY:	D.D.
DATE:	13/11/23
REV:	A

MICHIGAN HOUSE, 17-19 CHORLEY NEW ROAD, BOLTON, BL1 4QR	
TEL: 01204 392233	FAX: 01204 528505
WWW.NEILPIKEARCHITECTS.CO.UK	EMAIL: INFO@NEILPIKEARCHITECTS.CO.UK

 NEIL PIKE ARCHITECTS	
--	--

COPYRIGHT OF THIS DRAWING REMAINS WITH THE ARCHITECT. DO NOT SCALE FROM THIS DRAWING. WORK TO FIGURED DIMENSIONS. CHECK ALL DIMENSIONS ON SITE. IN THE EVENT OF ANY DISCREPANCY REFER QUERY TO THE ARCHITECTS.