



New 700x900mm
PVCu double glazed side
hung casement window unit

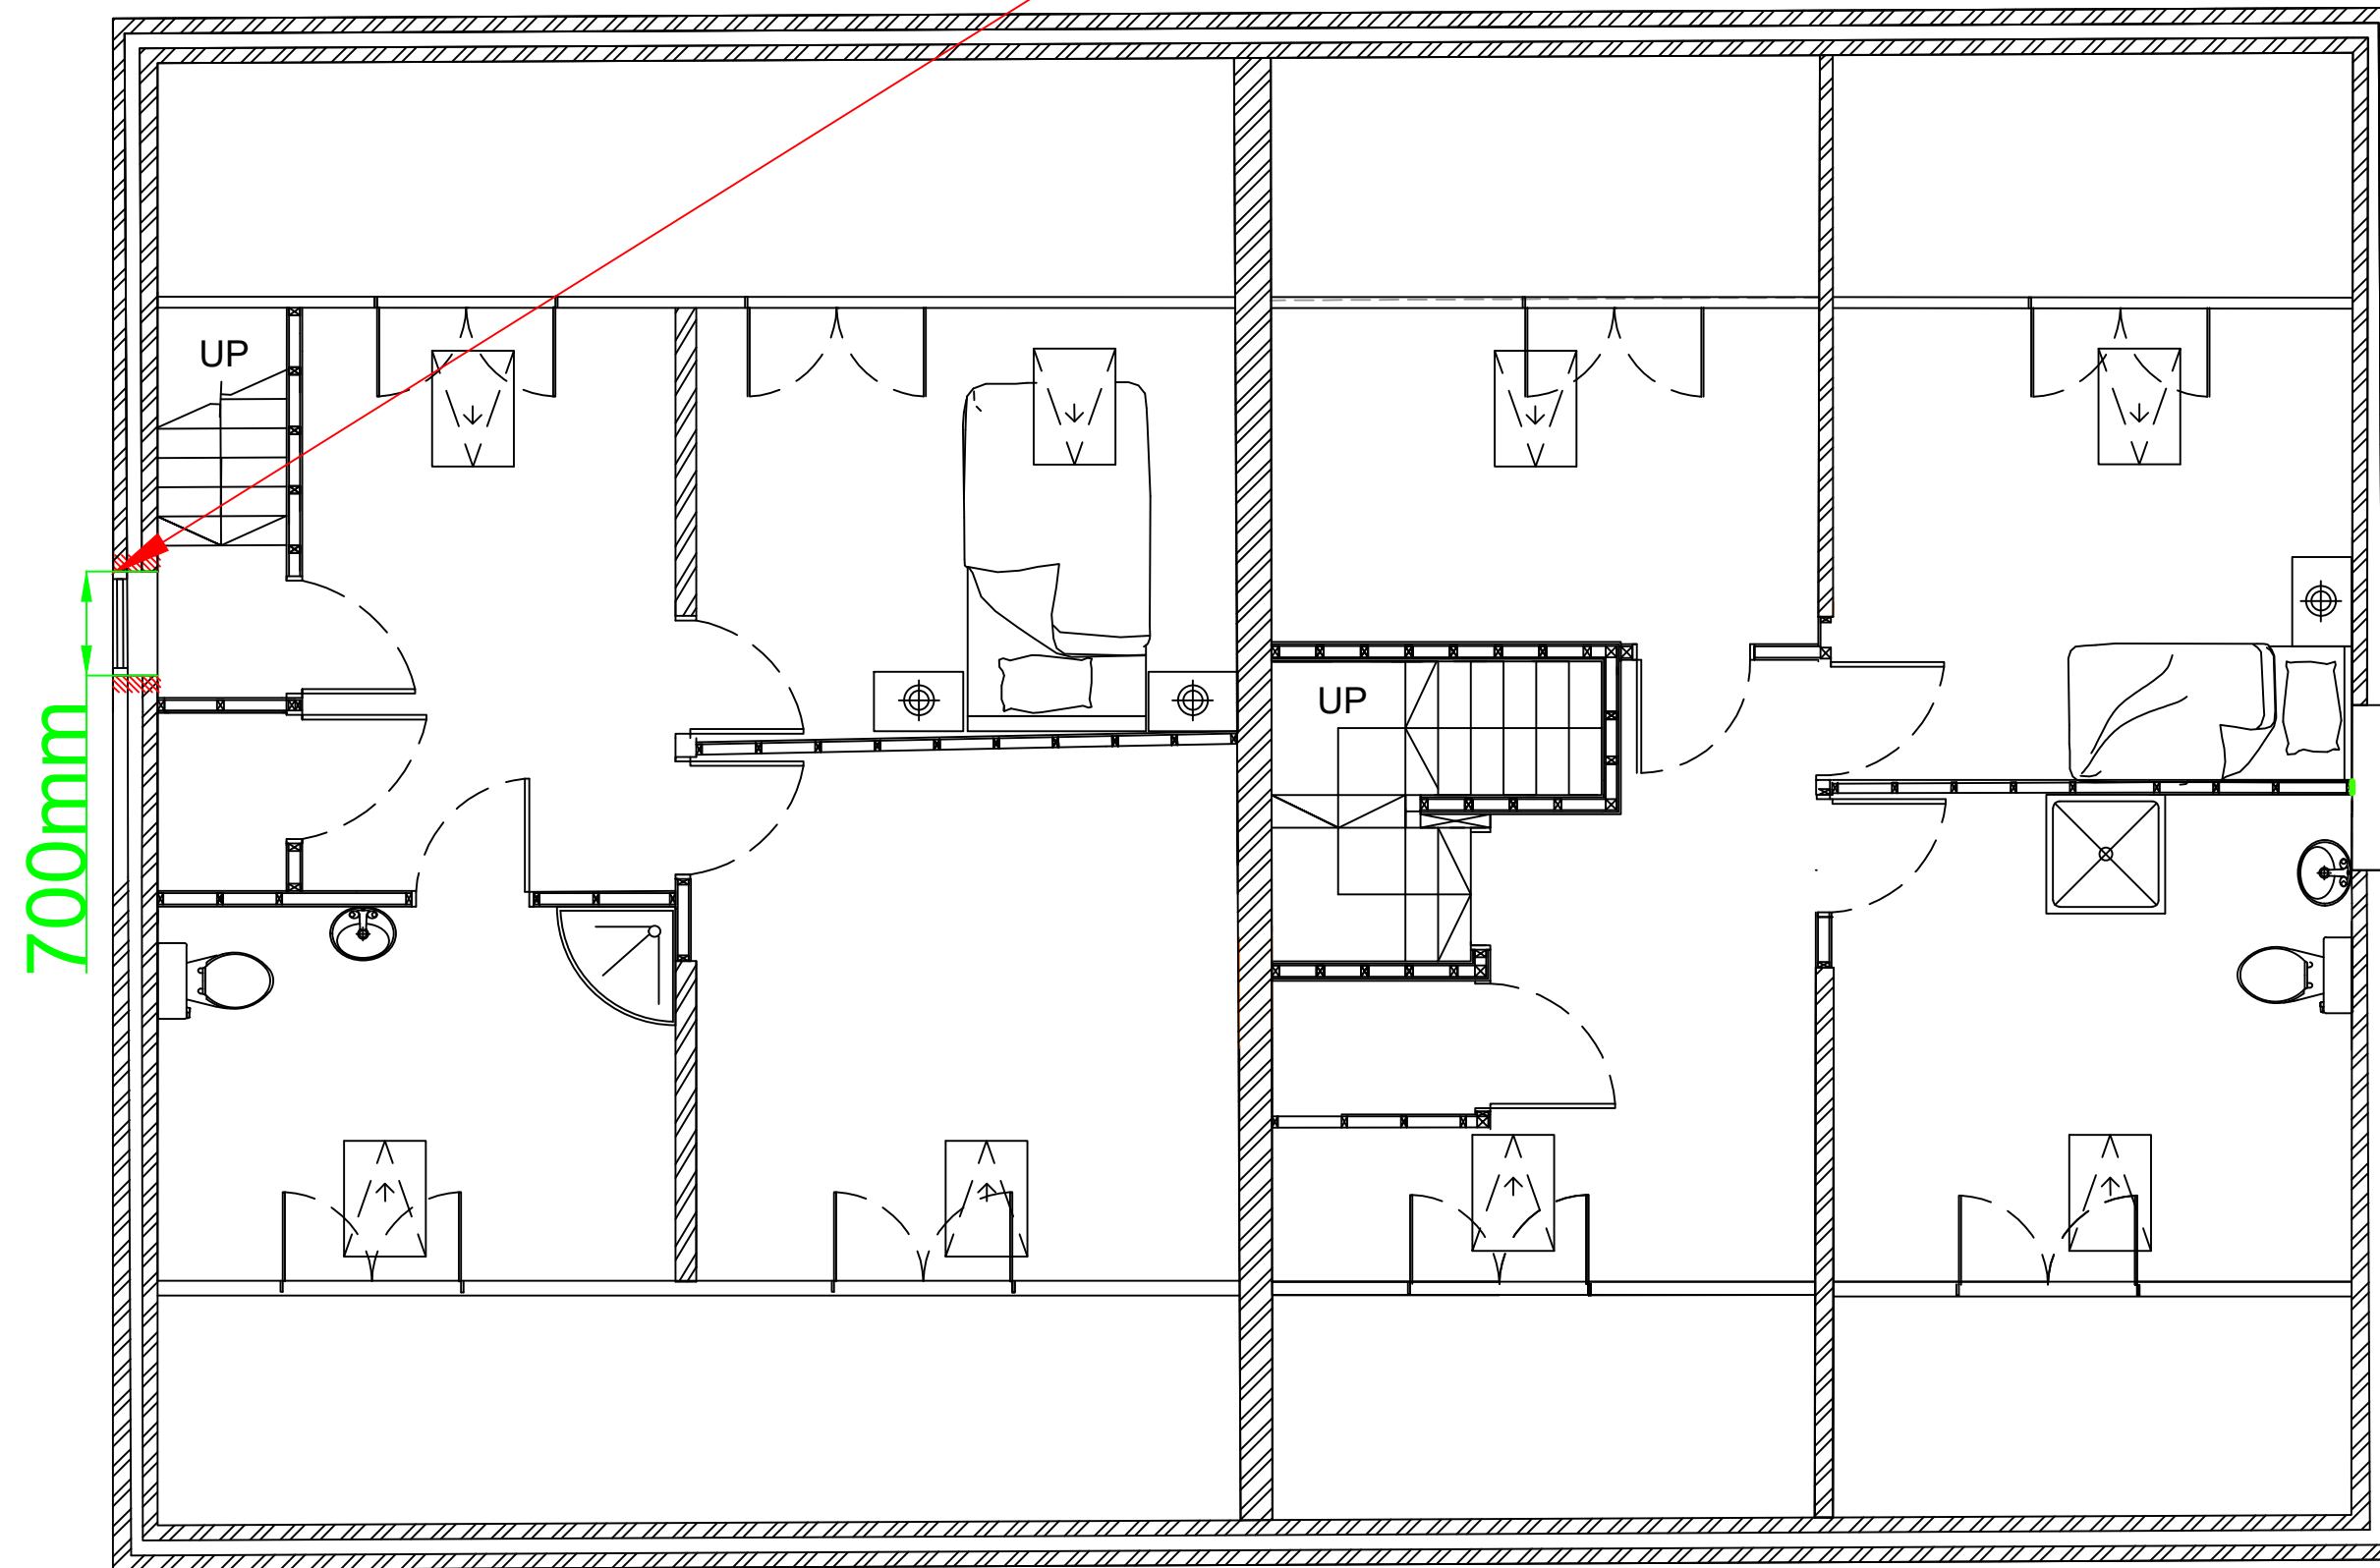

Proposed 1st Floor Plan
1:50 @ A2

SCALE BAR 1:50

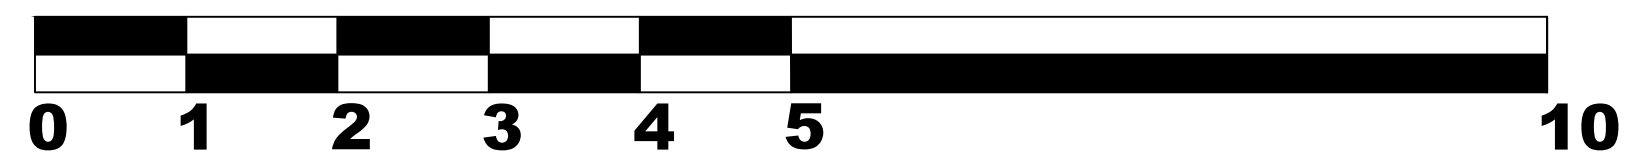

Rev	Date	Revisions

Client

Red Hazel Developments

Job Title

83A Dinas Lane

Drawing Title

Proposed 1st Floor

Draft / initial / schematic ☐

plan ☒

Planning ☐

Building Regulations ☐

Structural ☐

Construction ☐

As Built ☐

Scale

1:50 @ A2

Date

July 2025

Drawn By

WJJ

Drawing No.

3723-16

Rev

A