
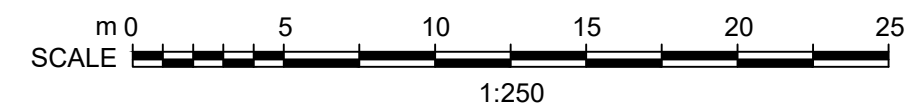


Notes:

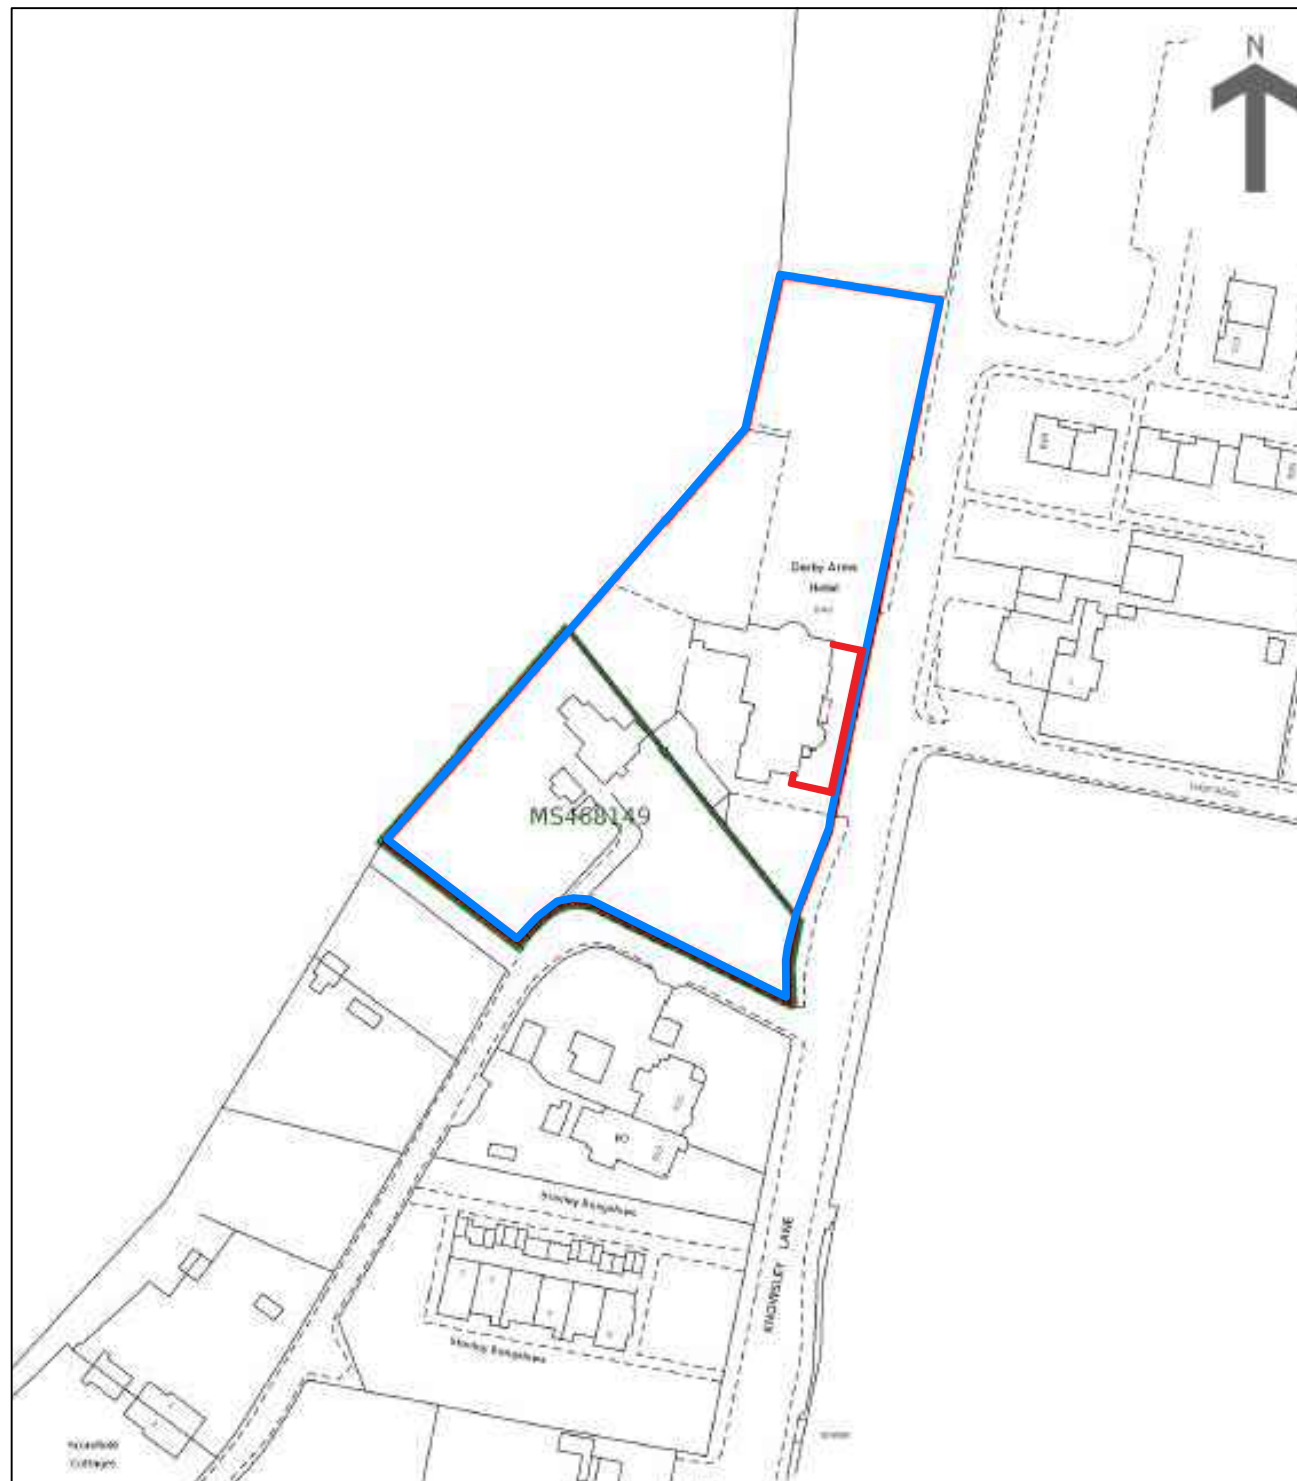

A	red line for tall posts & picket fence	30.10.24
Revision	Description	Date
 DV8 DESIGNS ARCHITECTURE+INTERIORS		
EXISTING		
NOTE DO NOT SCALE FROM THIS DRAWING. ALL DIMENSIONS TO BE CHECKED ON SITE TO BE READ IN CONJUNCTION WITH ALL RELEVANT CONSULTANTS DOCUMENTATION		
Client: GREENE KING		
Project No. 2302	Project: DERBY ARMS KNOWSLEY	
Drawing No. 200	Drawing Title: SITE LOCATION PLAN	
Revision: A	Scale: 1:1250 @ A3	Date: 21/05/24
		Drawn by: SG