



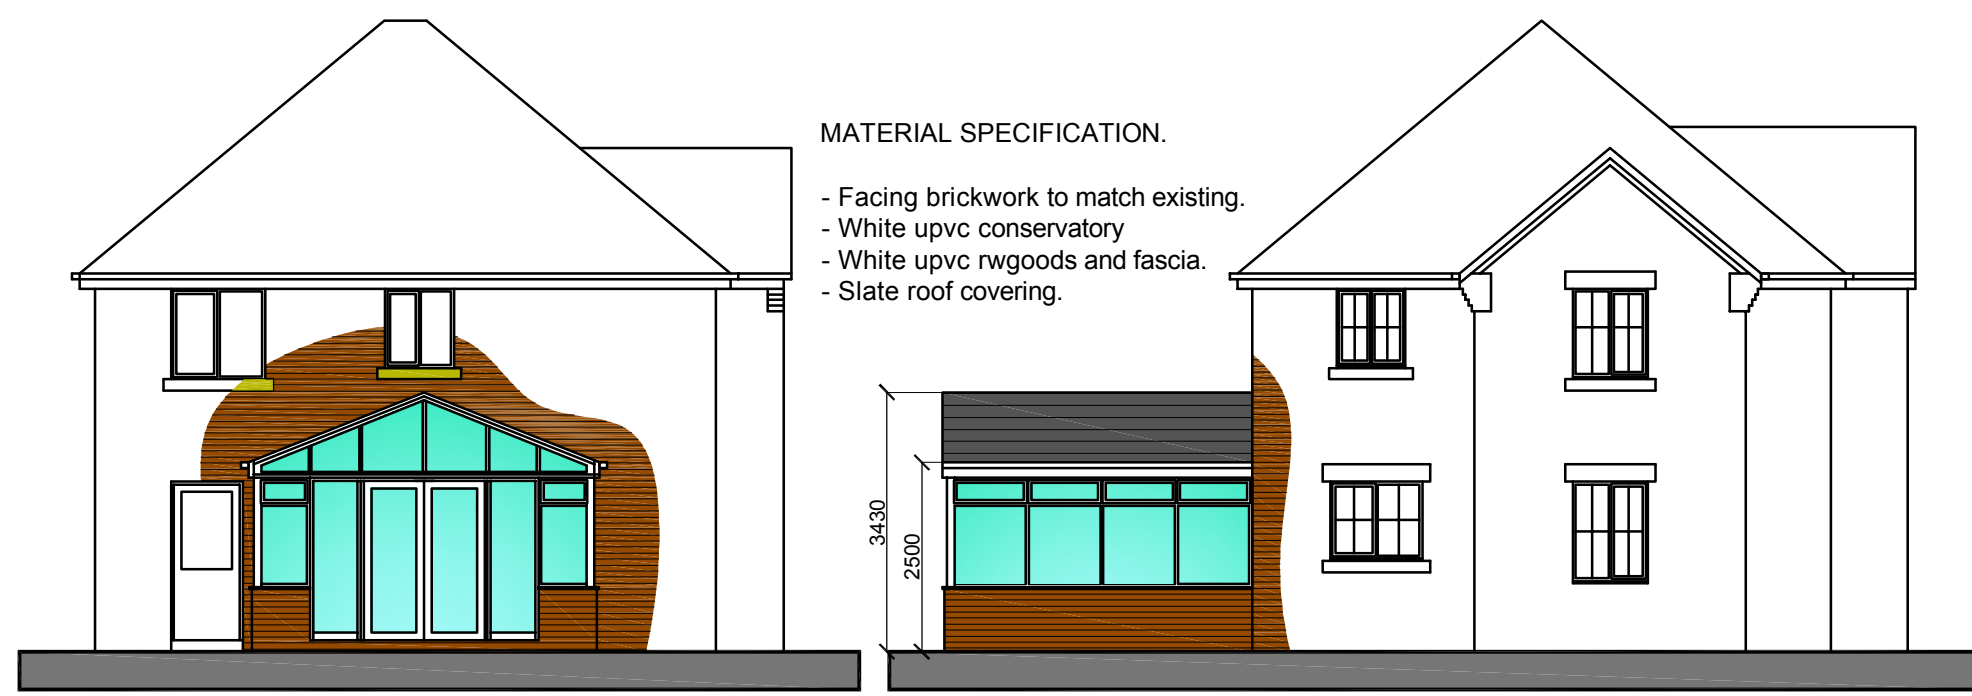


proposed - as built
rear elevation

proposed - as built
side / street elevation

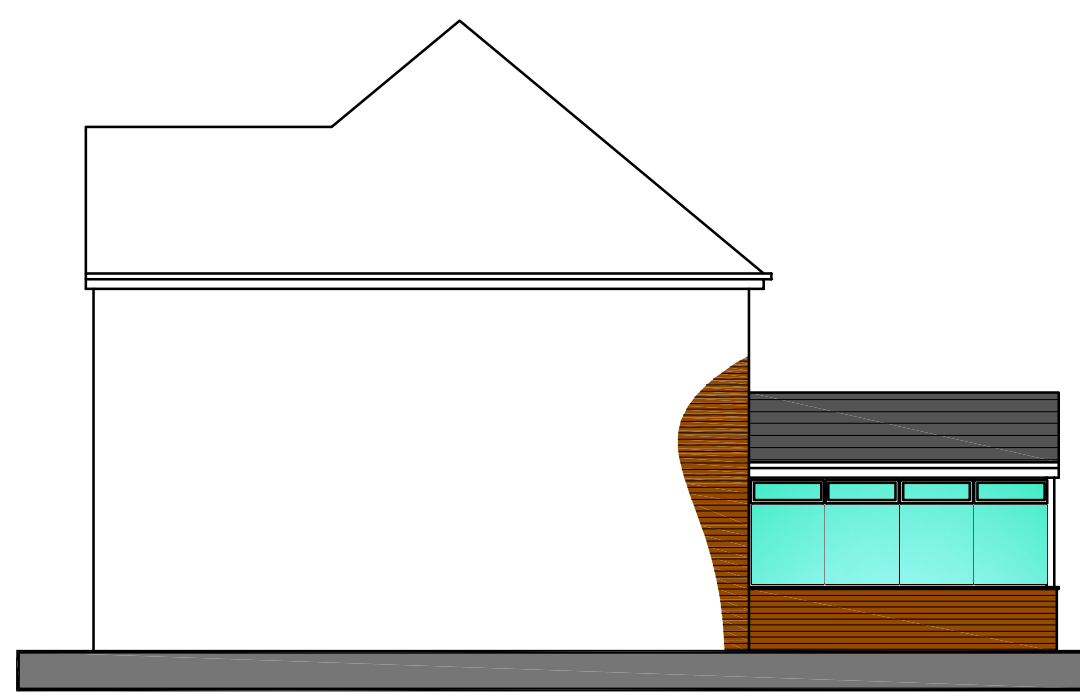


proposed - as built - 1:100
side / driveway elevation

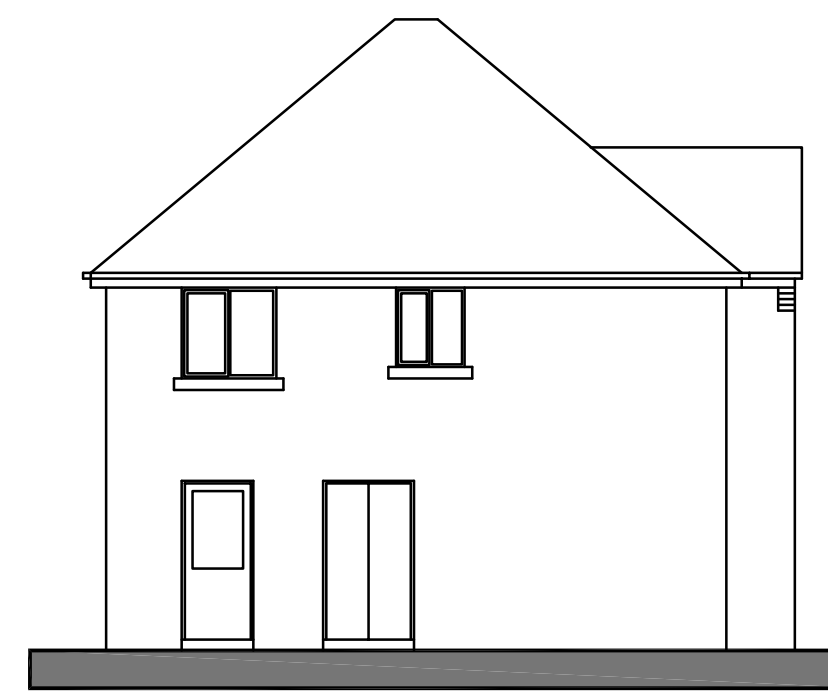


existing
rear elevation




existing
side / street elevation

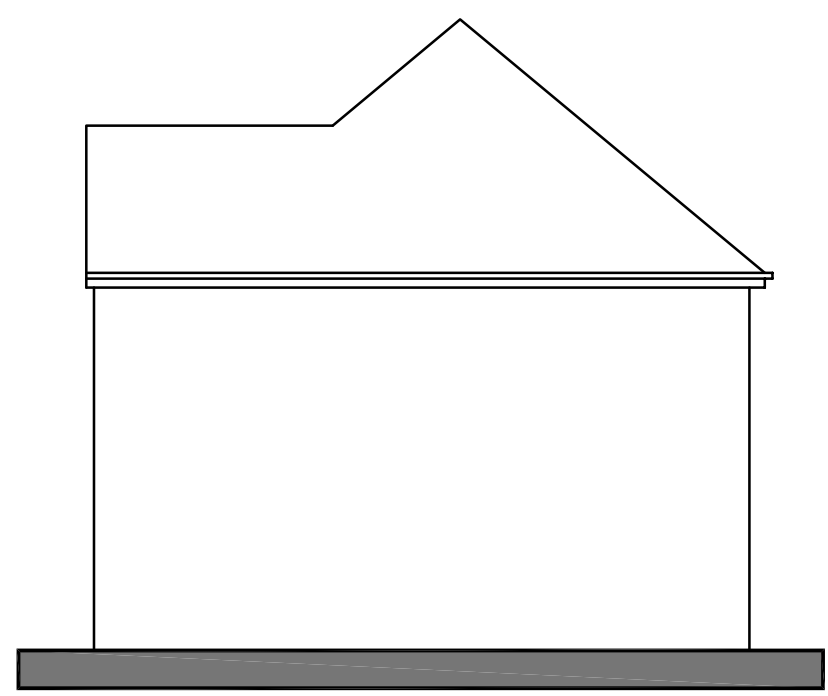


existing
side / driveway elevation

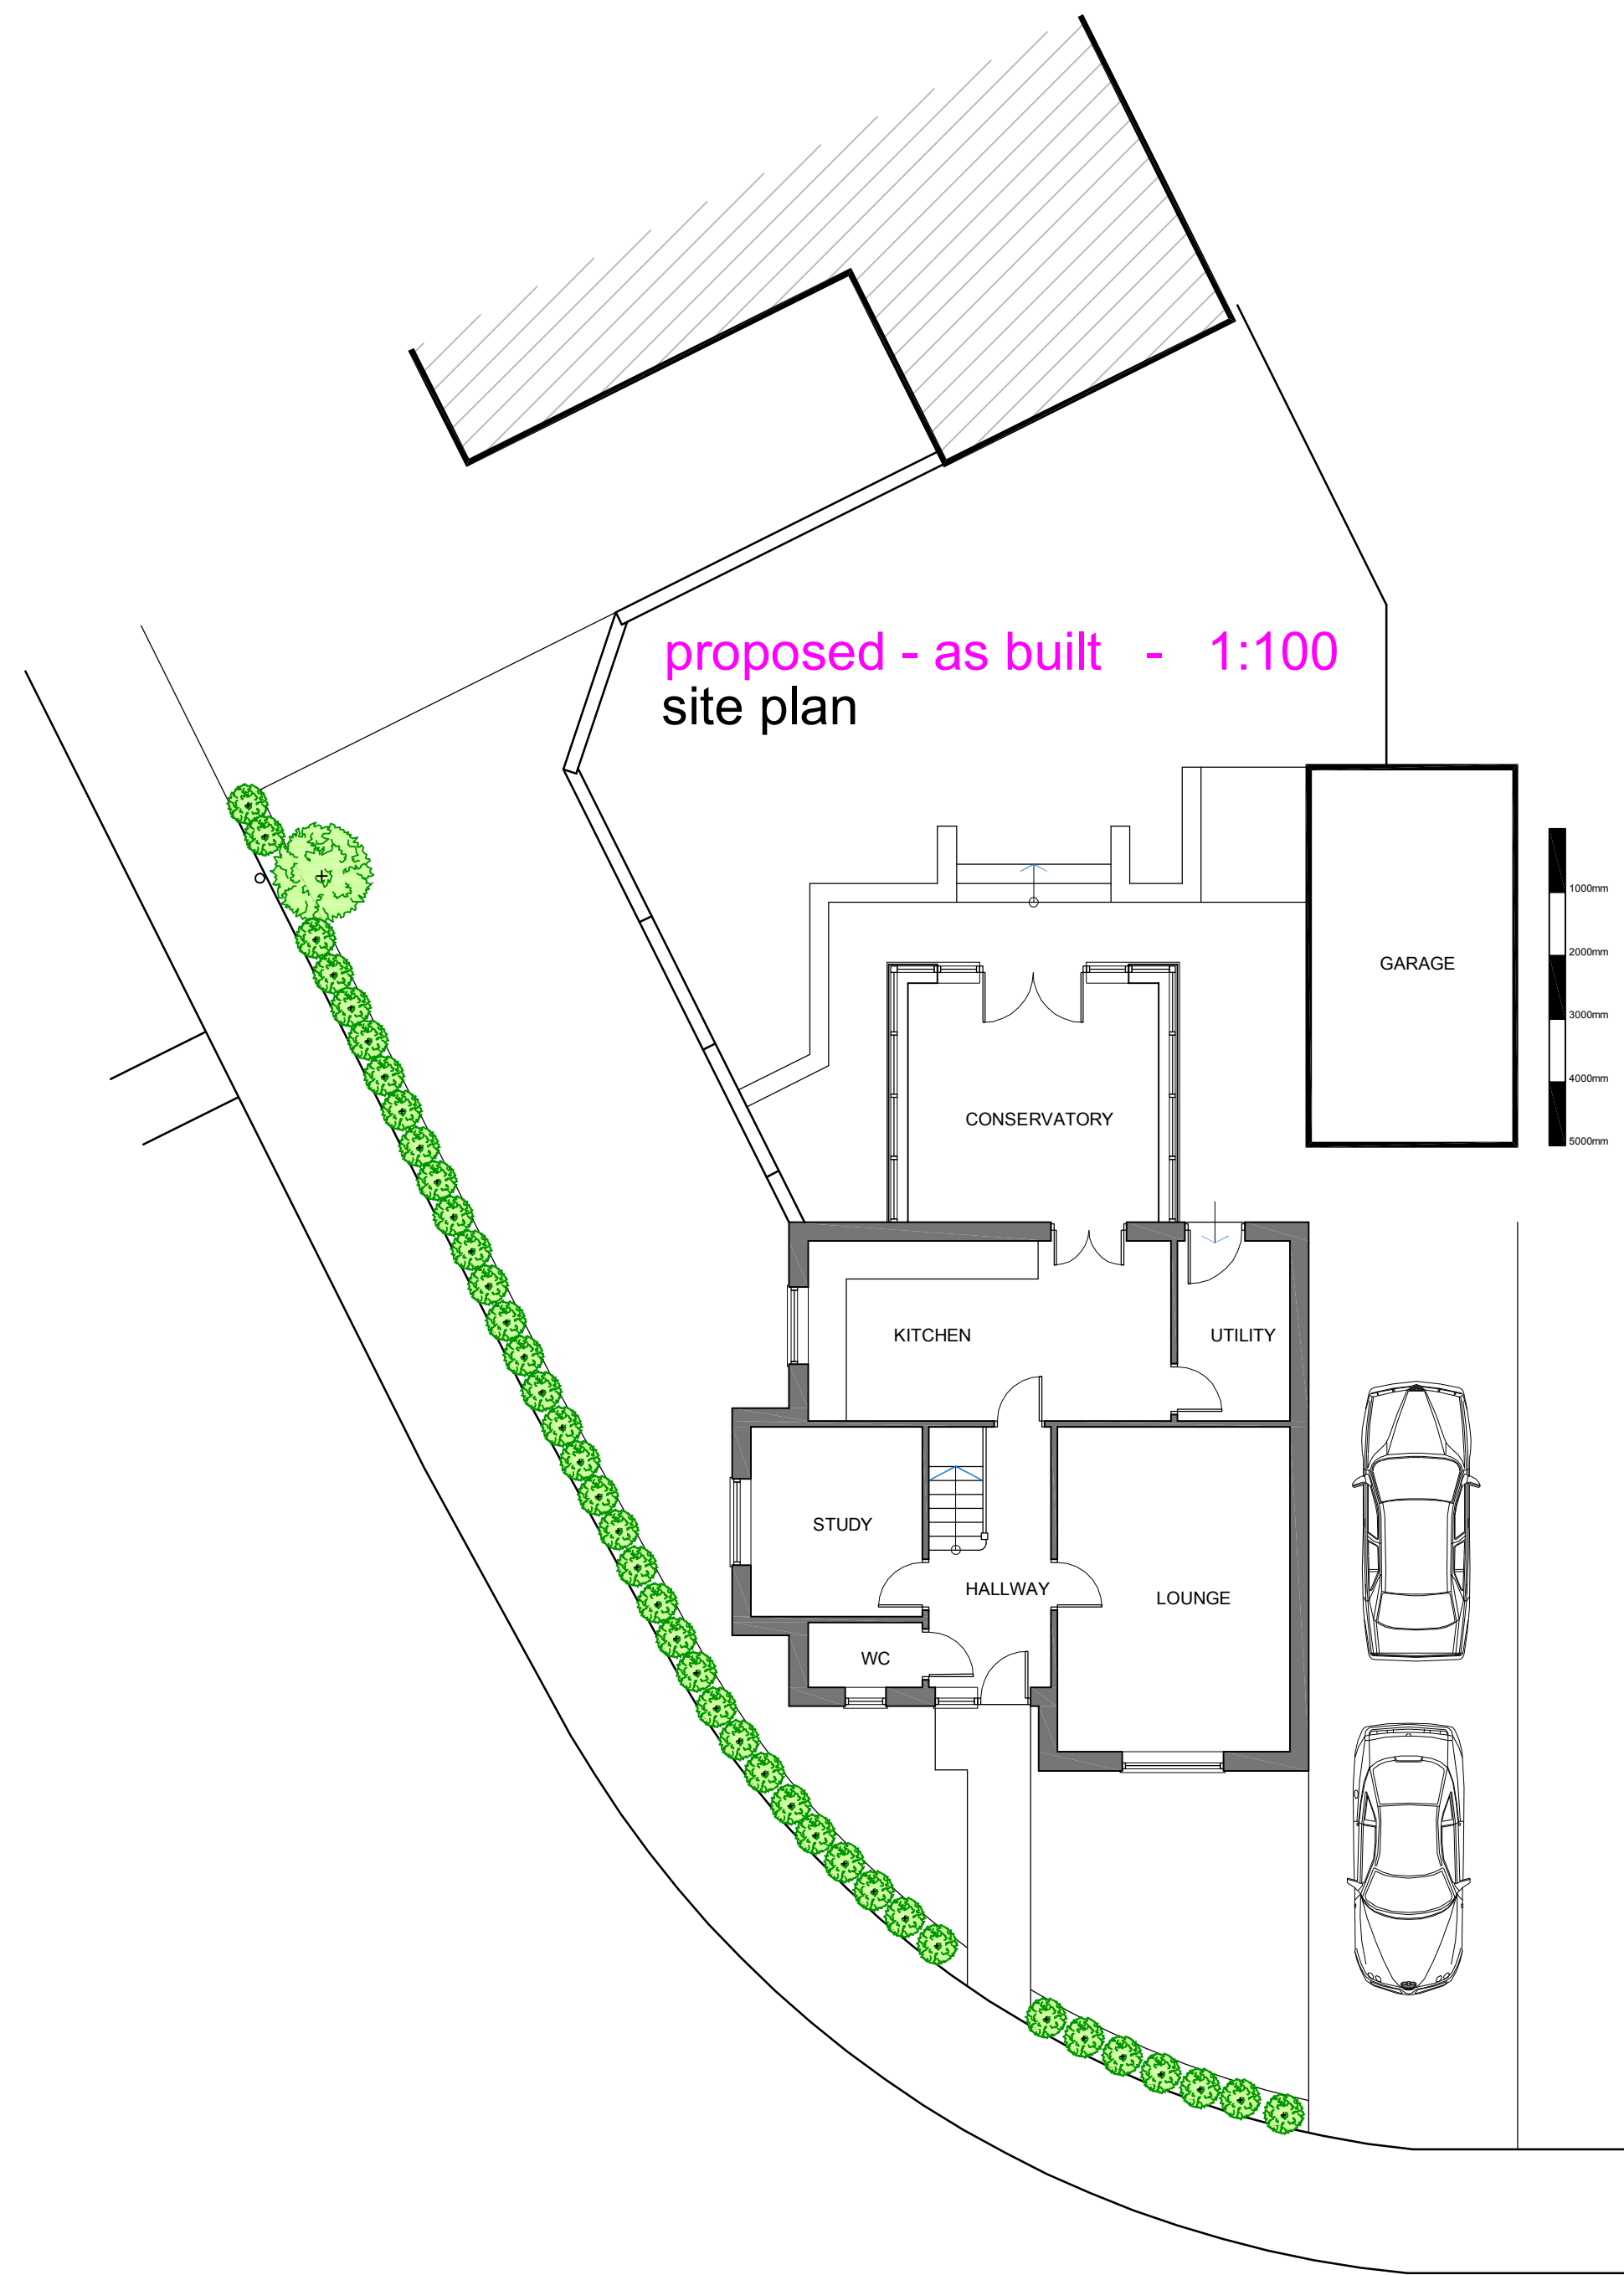


proposed - as built - 1:100
site plan

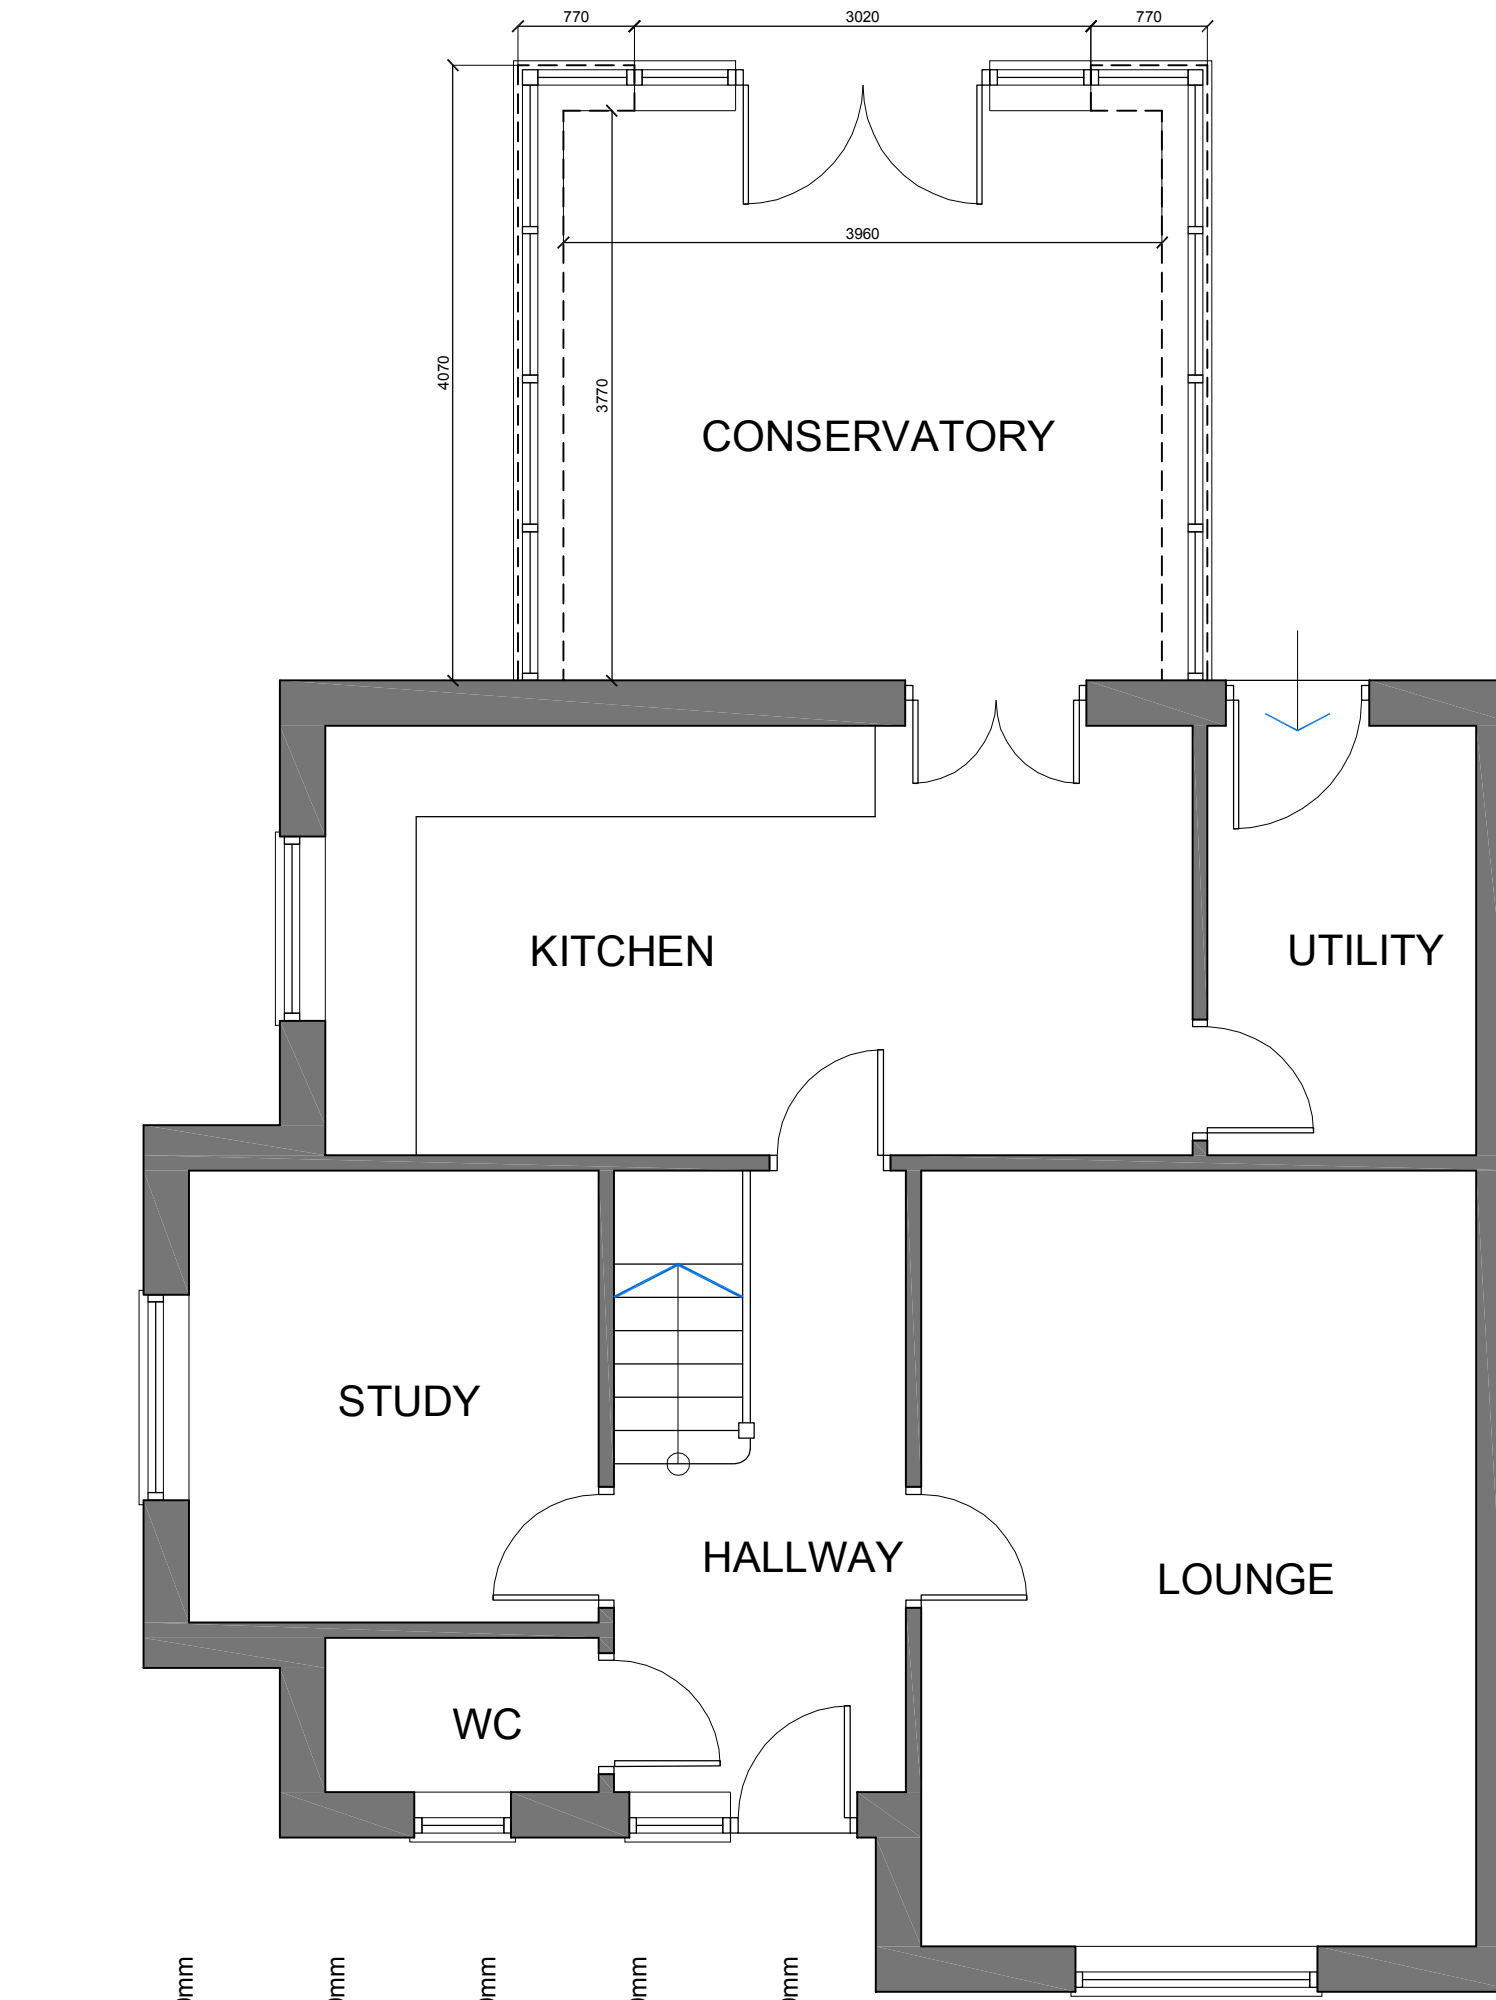


proposed - as built
ground floor plan 1:50

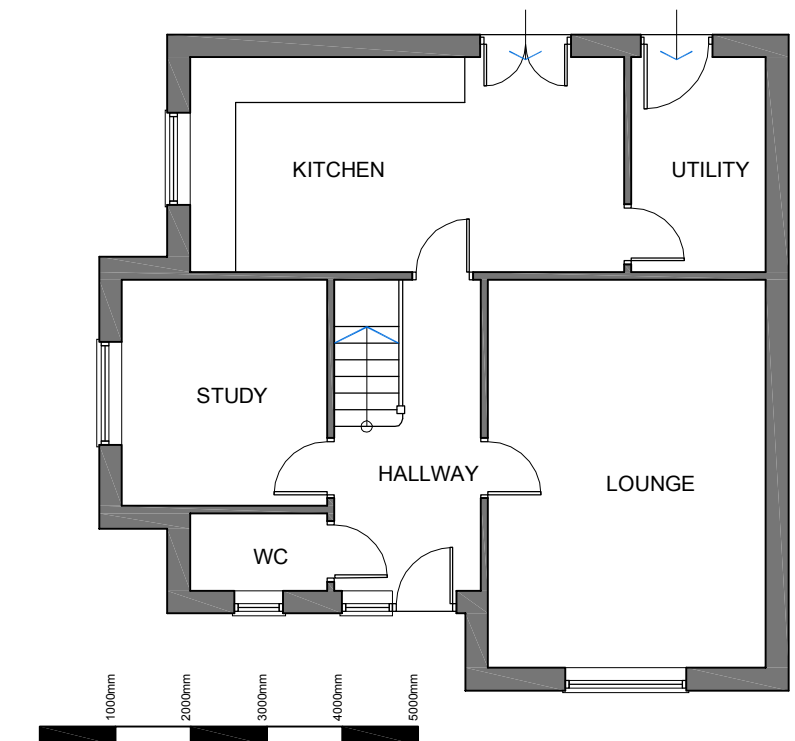

existing
ground floor plan 1:100

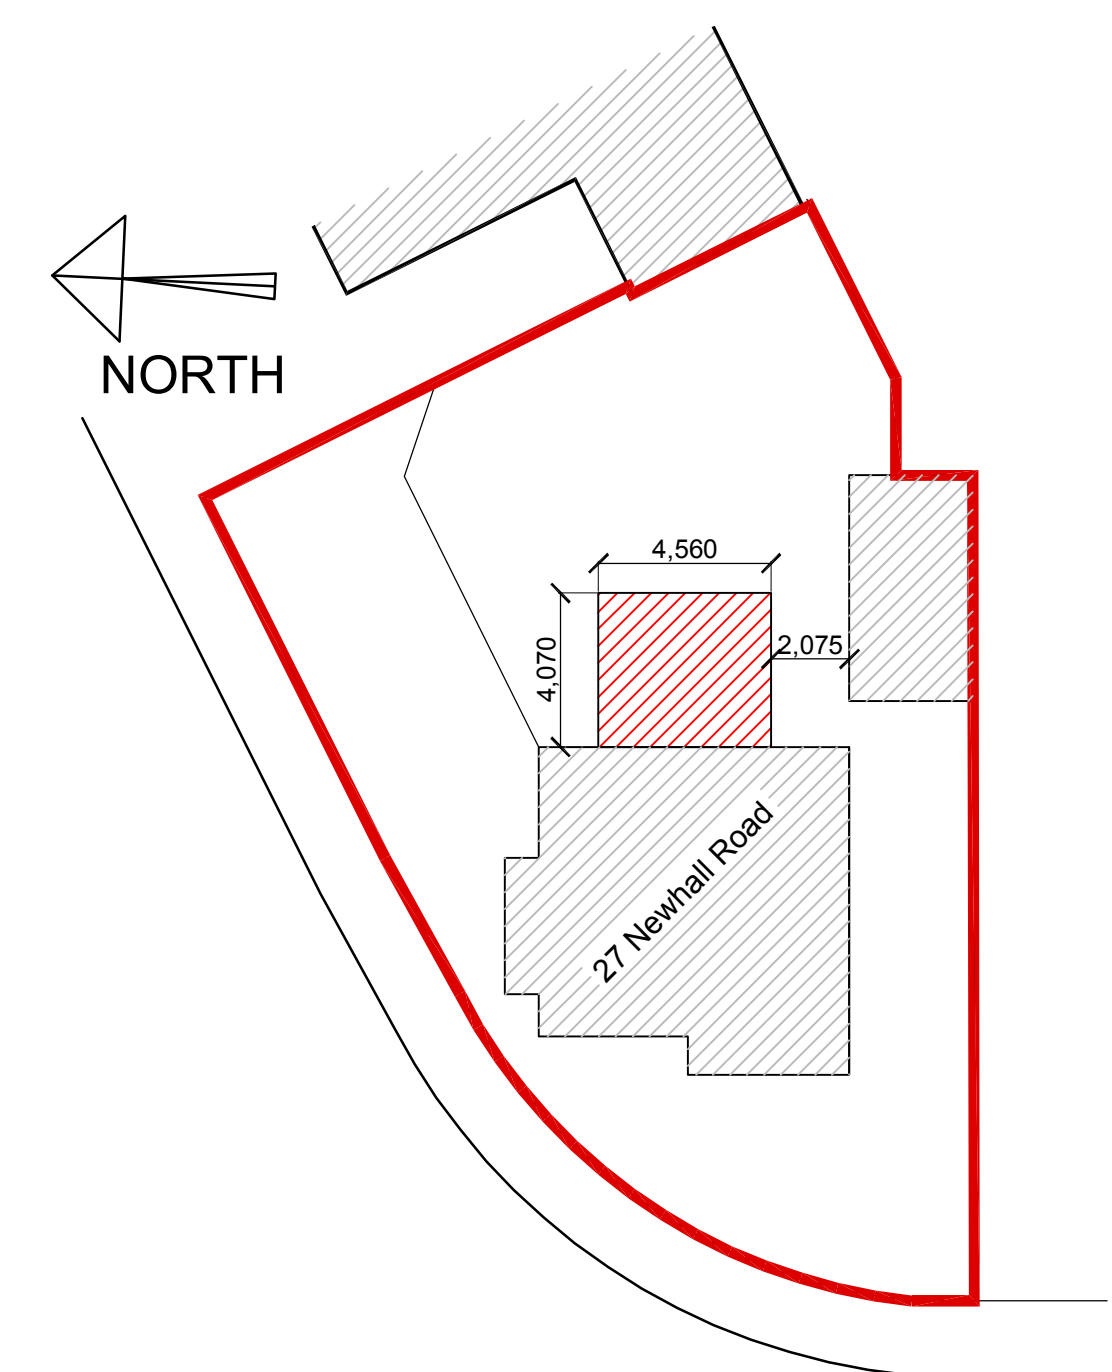

proposed
block plan - 1:200

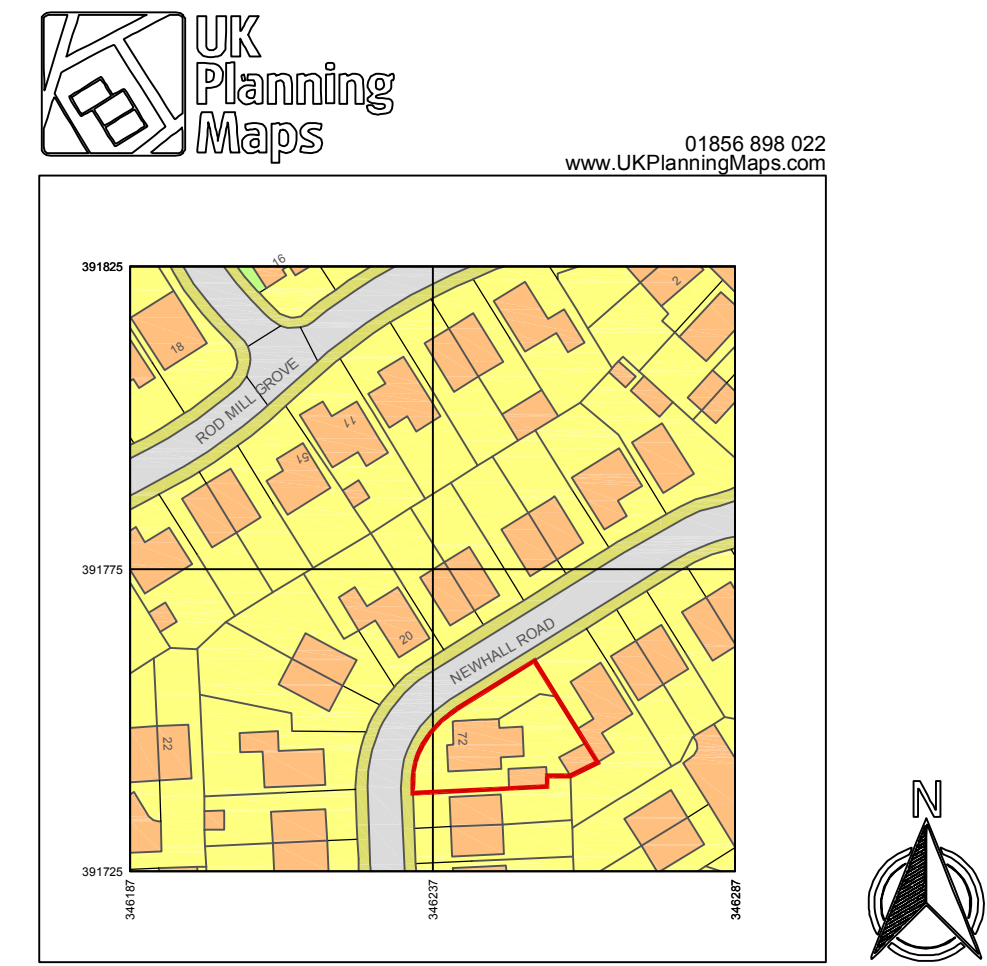

proposed
location plan 1:1250

				A	23.03.26	Scale bar indicated to location plan & amended scale bar to existing floor plan.		
Client	Mr & Mrs Brian Doyle			Rev	Date	Description		
Job Ref	27 Newhall Road, Prescott, Merseyside, L34 1AQ							
Drawing Title	Existing / As Built Floor Plans, Elevations & Siteplan							
Job No.	Studio-2026-388-001-PL							
Scale	1:50 / 100 / 200 / 250	Revision	A					
Date	March 26	Drawn	Dave H					