



As Built

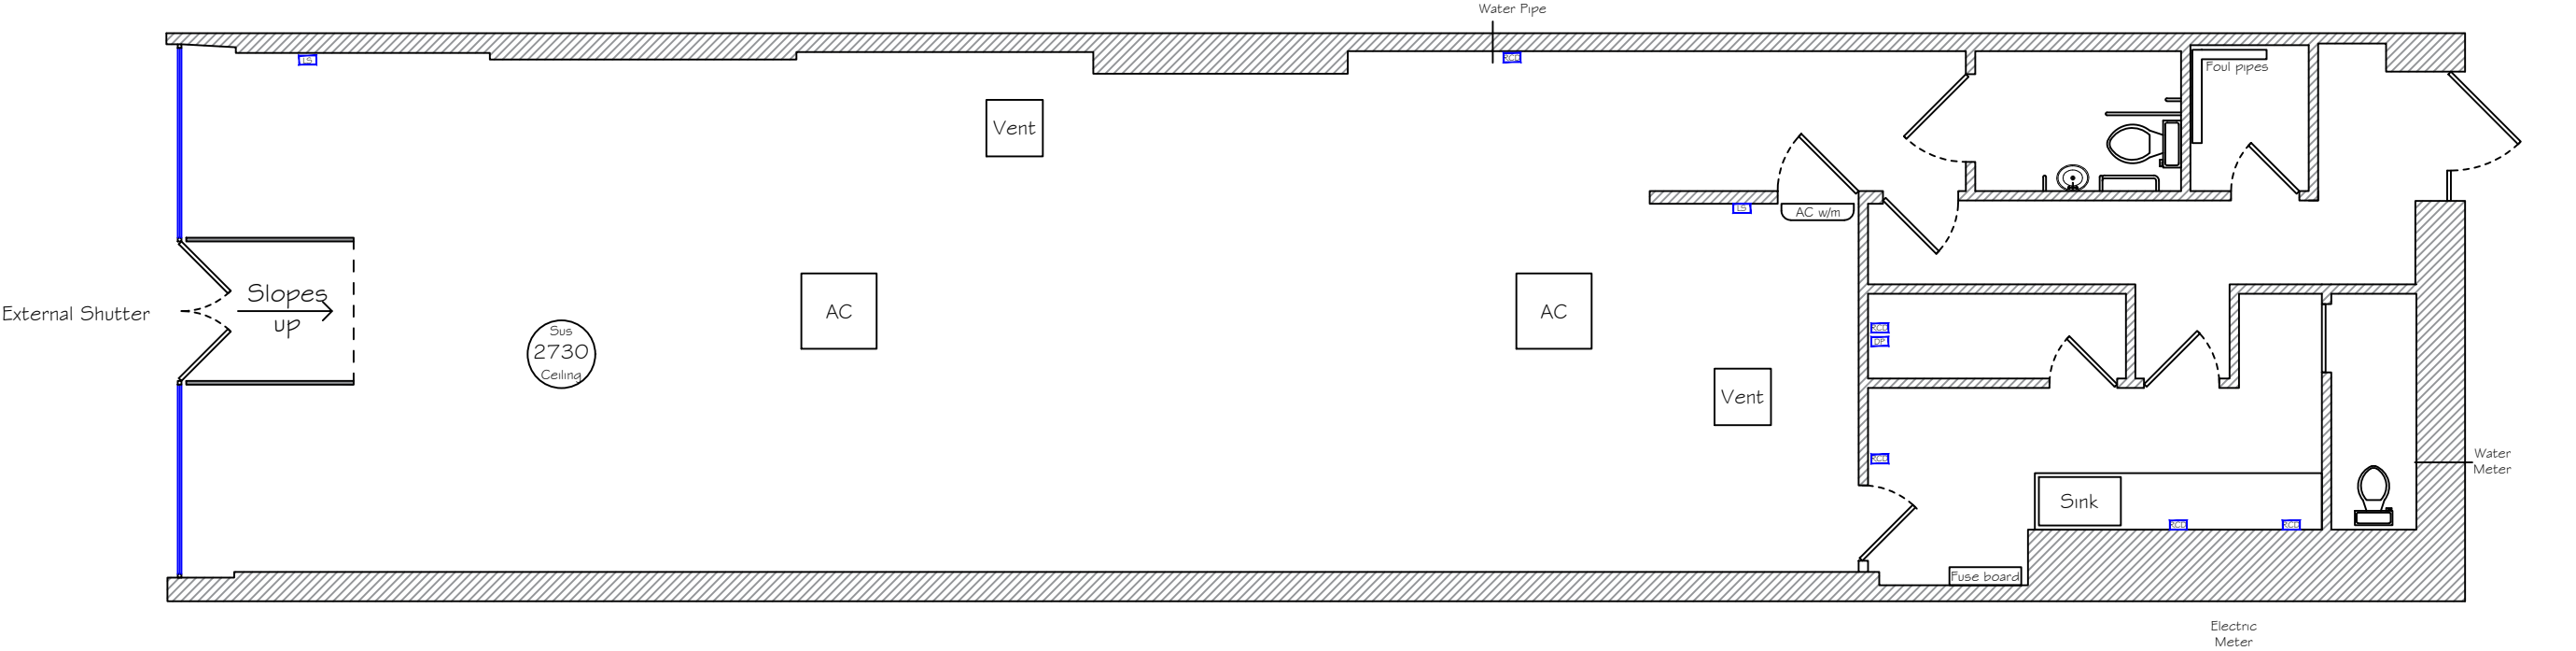

Proposal

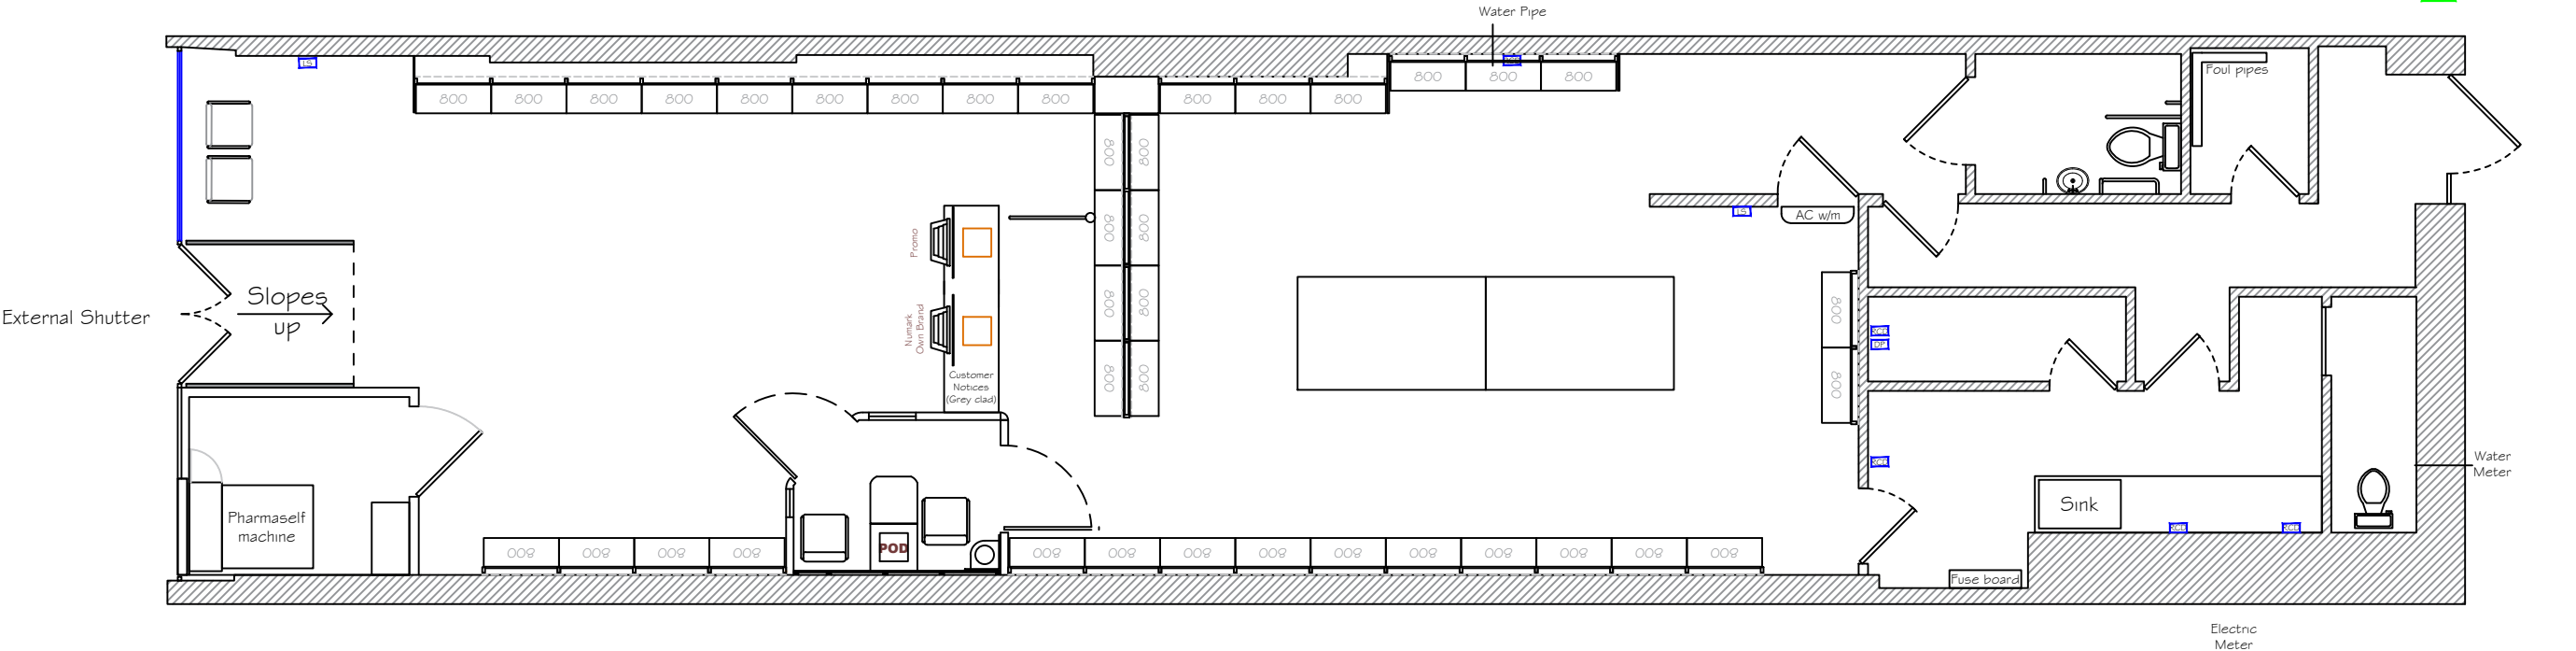

- SEP Straight End Panel
- PA Counter panic Alarm
- AK Alarm Keypad
- PIR PIR sensor
- LS Light Switch
- BT BT point
- RCD RCD DSSO
- DP Data point
- P/H Plinth heater
- M/H Myson Heater
- FE Fire extinguisher

Phoenix Medical Supplies / Rowlands Pharmacy			
Project:	St Chads Relocation		
Date:	25/08/21	Scale:	1:75 @ A3
Designer:	D.Howard	Version:	As built / v2

Notes: .