



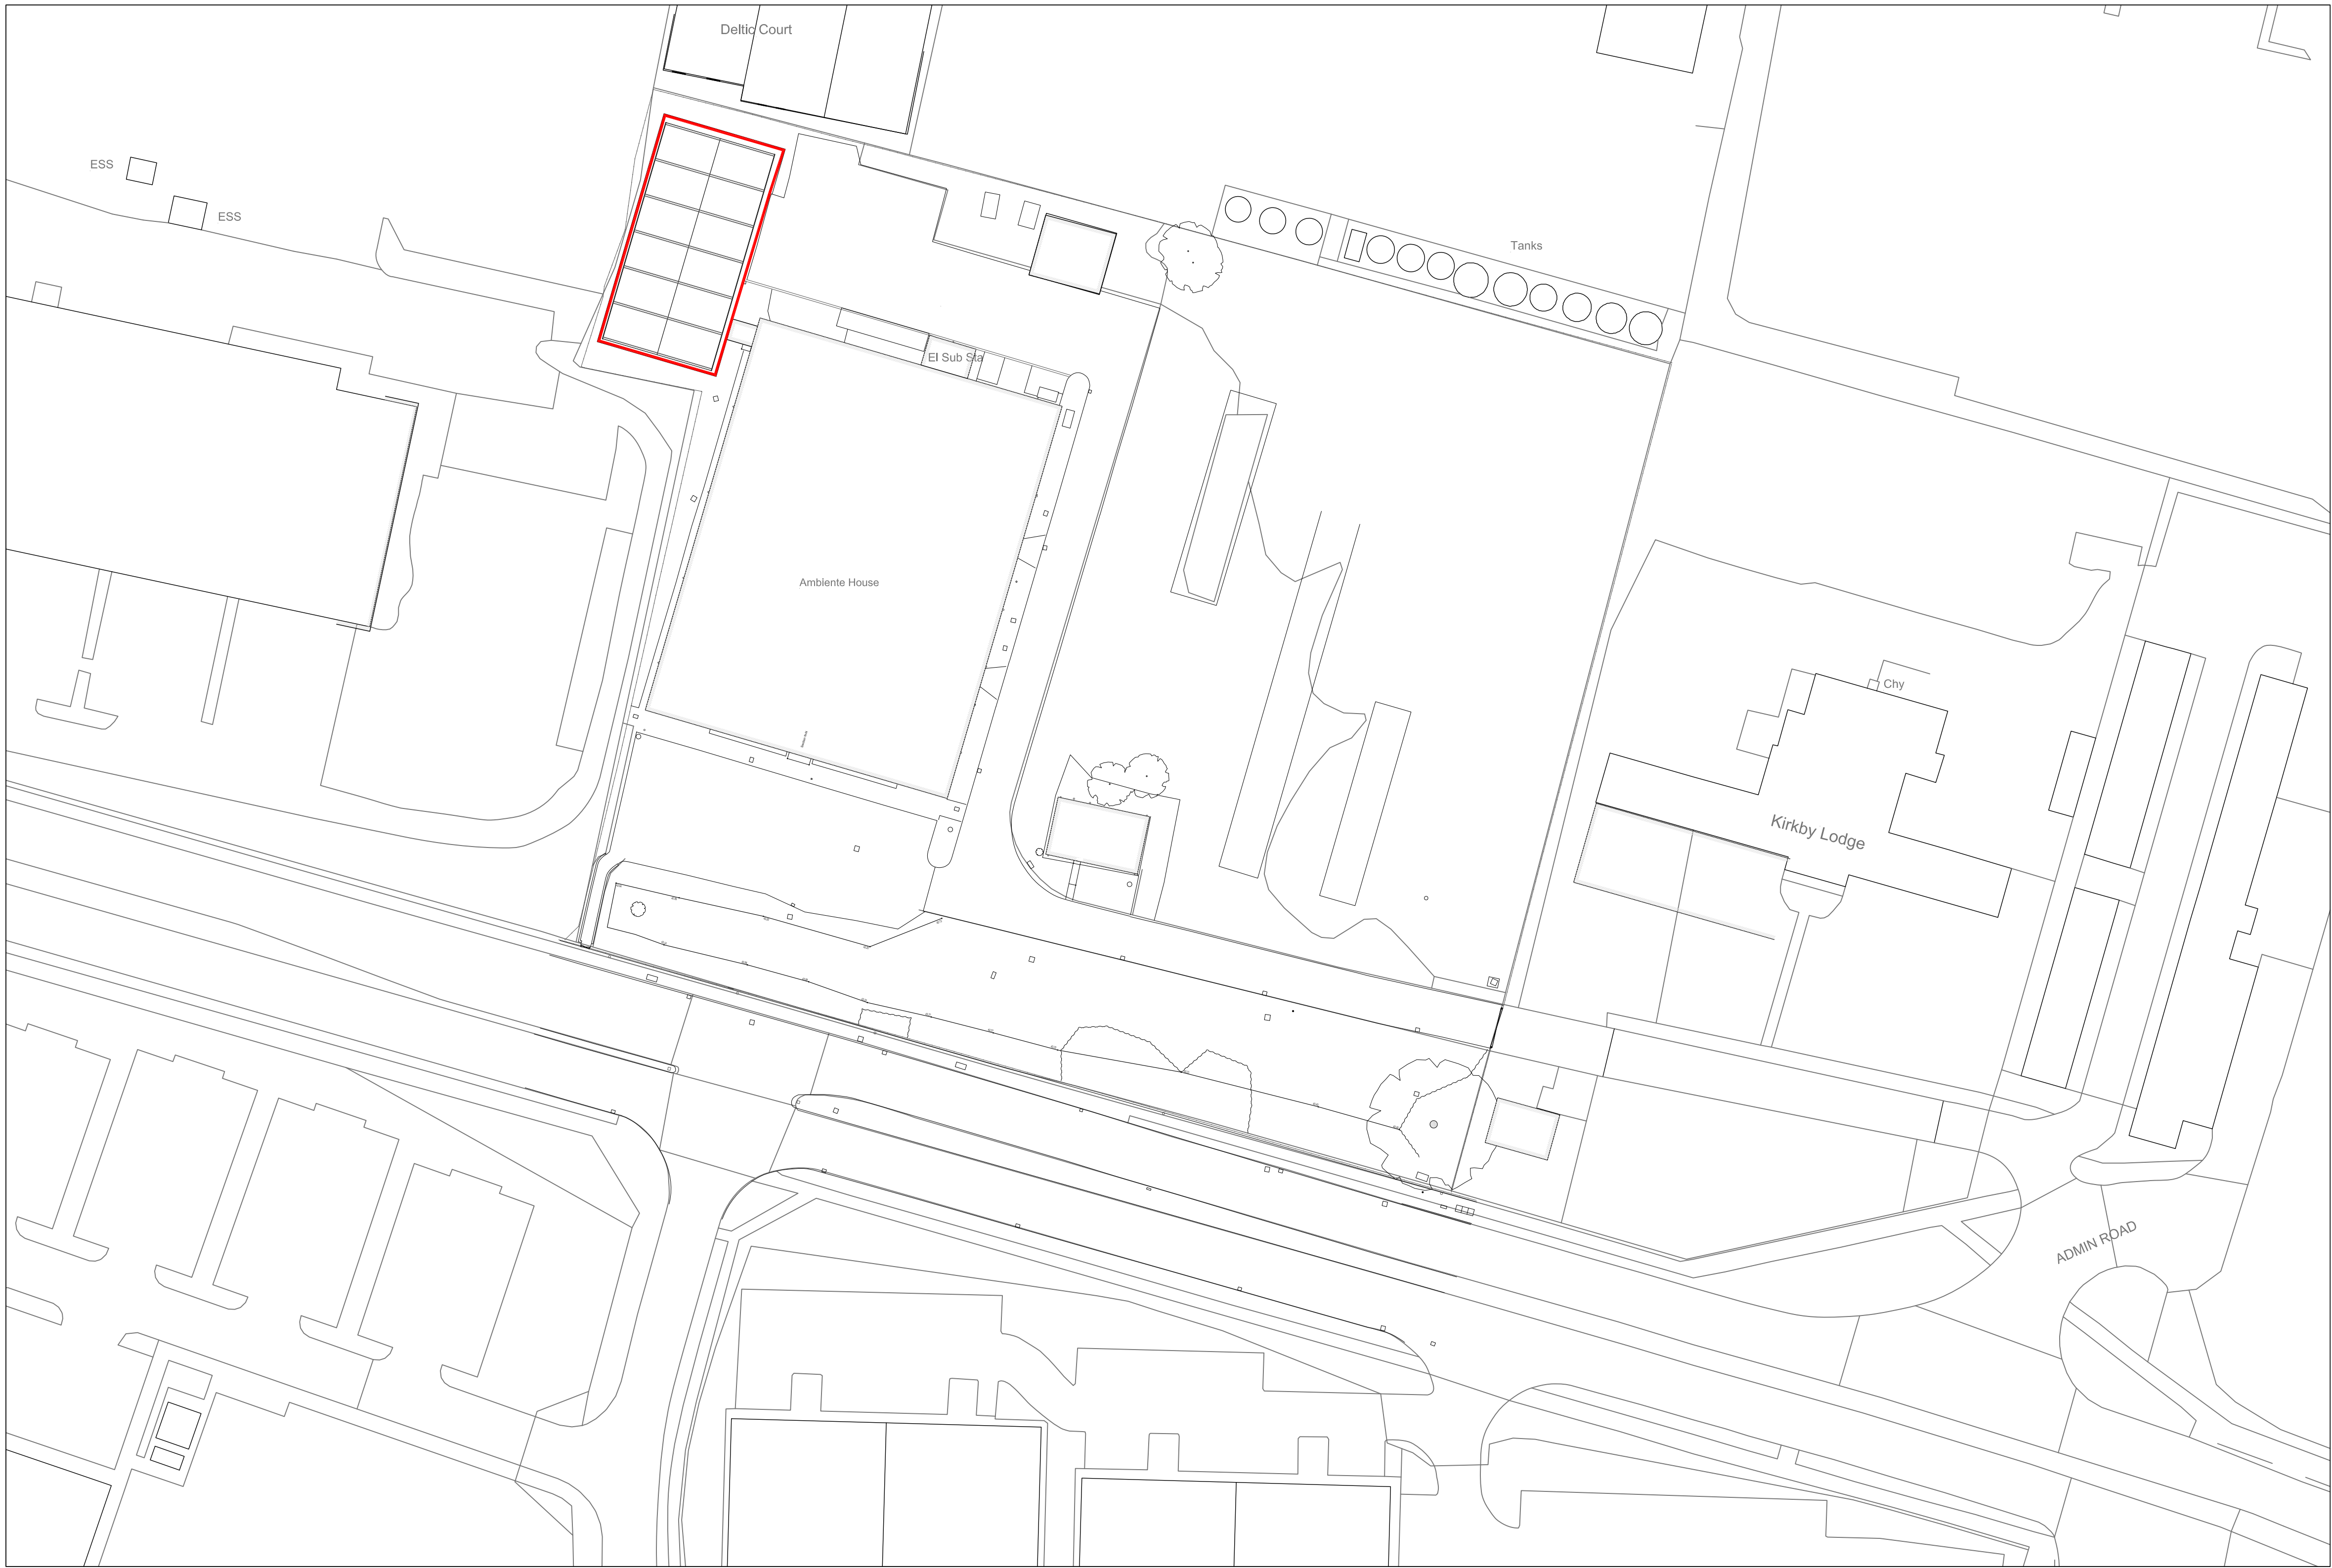

NOTES
Use only written dimensions. All areas are indicative.
Contractor to check measurements on site prior to commencement. Notify the Architect of any discrepancies.
This drawing must only be used for the purpose for which it has been supplied.

R.	DATE	DESCRIPTION
A	15.01.2025	Do not scale note removed.
-	-	-
-	-	-

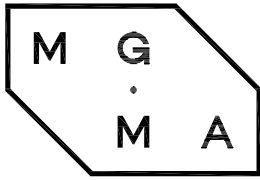

MGMA ARCHITECTS LIMITED
Oriel Chambers Suite 37
14 Water Street
Liverpool L2 8TD

+44 (0) 151 236 6627
studio@mgma-architects.co.uk

www.mgma-architects.co.uk

CLIENT
Ley Holdings Limited

PROJECT
Polymer House, Admin Road,
Kirkby L33 7TX

DRAWING
As-built Site Plan

SCALE
1:500@A1

DATE
20.12.2024

REVISION
A

NO.
10-055_101

