




NOTES
Use only written dimensions. All areas are indicative.
Contractor to check measurements on site prior to commencement. Notify the Architect of any discrepancies.
This drawing must only be used for the purpose for which it has been supplied.

SPECIFICATION NOTES

1. Roofing made of Thermo PVC coated polyester fabric.
2. Steel rainwater goods.
3. Steel roller shutter door.
4. Wall finish: steel cladding sheets RAL7000.
5. Steel exit door.
6. Concrete slab.
7. Loose gravel.
8. Existing boundary fence.

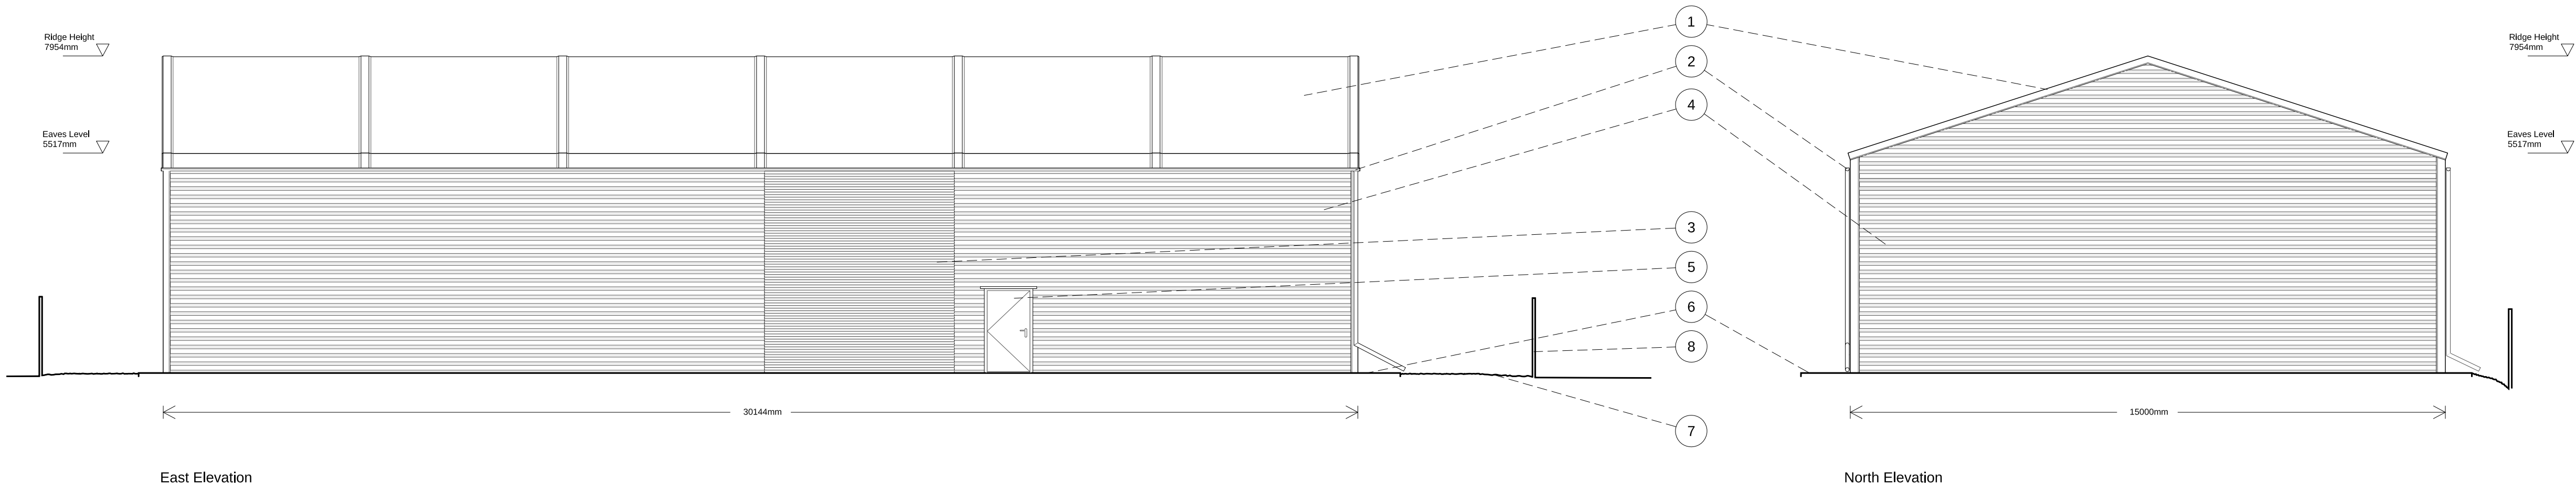

R.	DATE	DESCRIPTION
A	15.01.2025	Do not scale note removed.
-	-	-
-	-	-

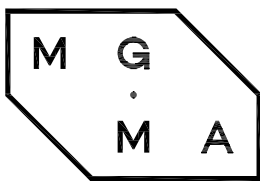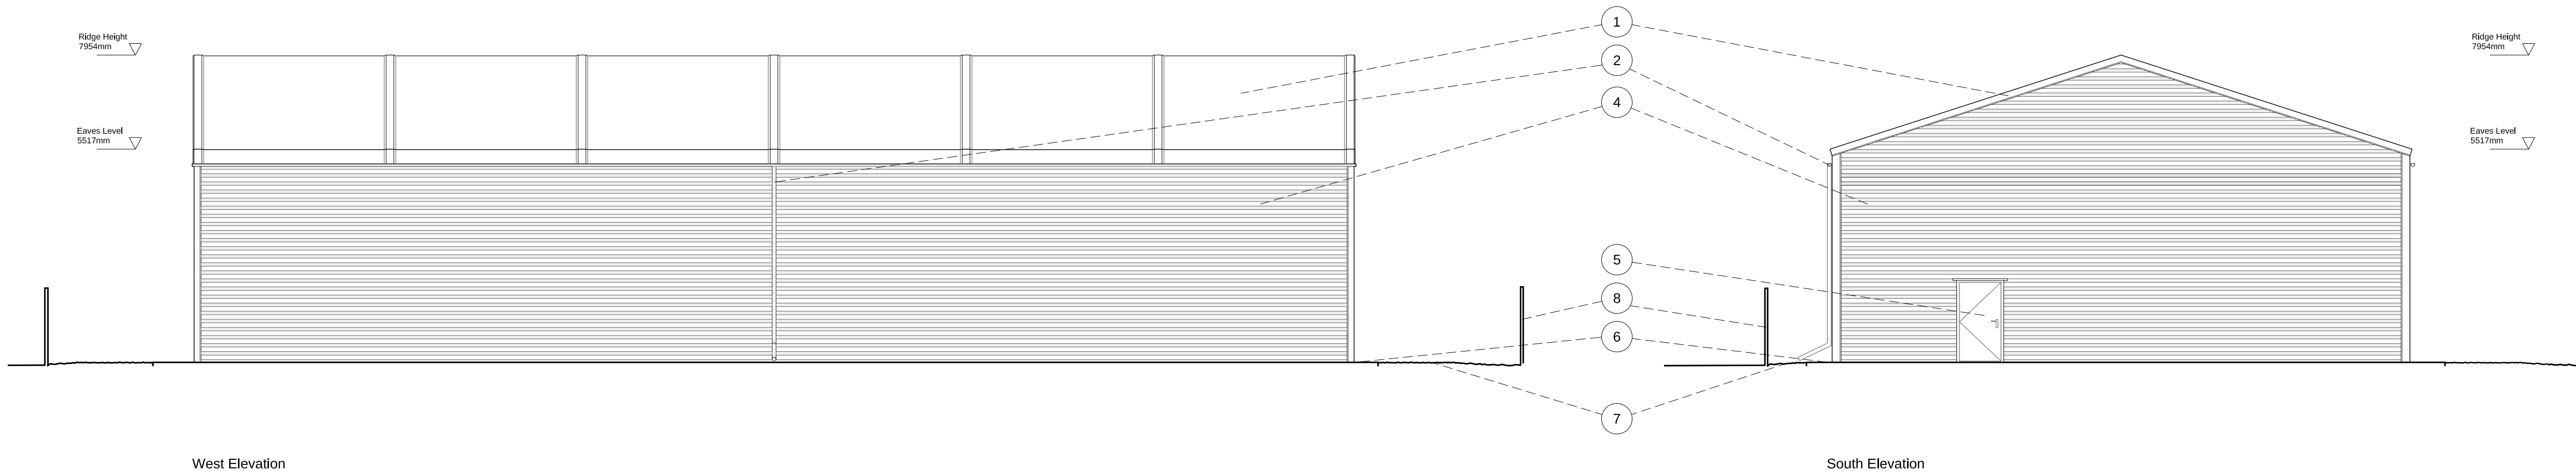

MGMA ARCHITECTS LIMITED
Oriel Chambers Suite 37
14 Water Street
Liverpool L2 8TD

+44 (0) 151 236 6627
studio@mgma-architects.co.uk

www.mgma-architects.co.uk

CLIENT
Ley Holdings Limited

PROJECT
Polymer House, Admin Road,
Kirkby L33 7TX

DRAWING
As-built New Warehouse Elevations

SCALE
1:100@A1

DATE
20.12.2024

REVISION
A

NO.
10-055_103

