


DRAINAGE AS BUILT

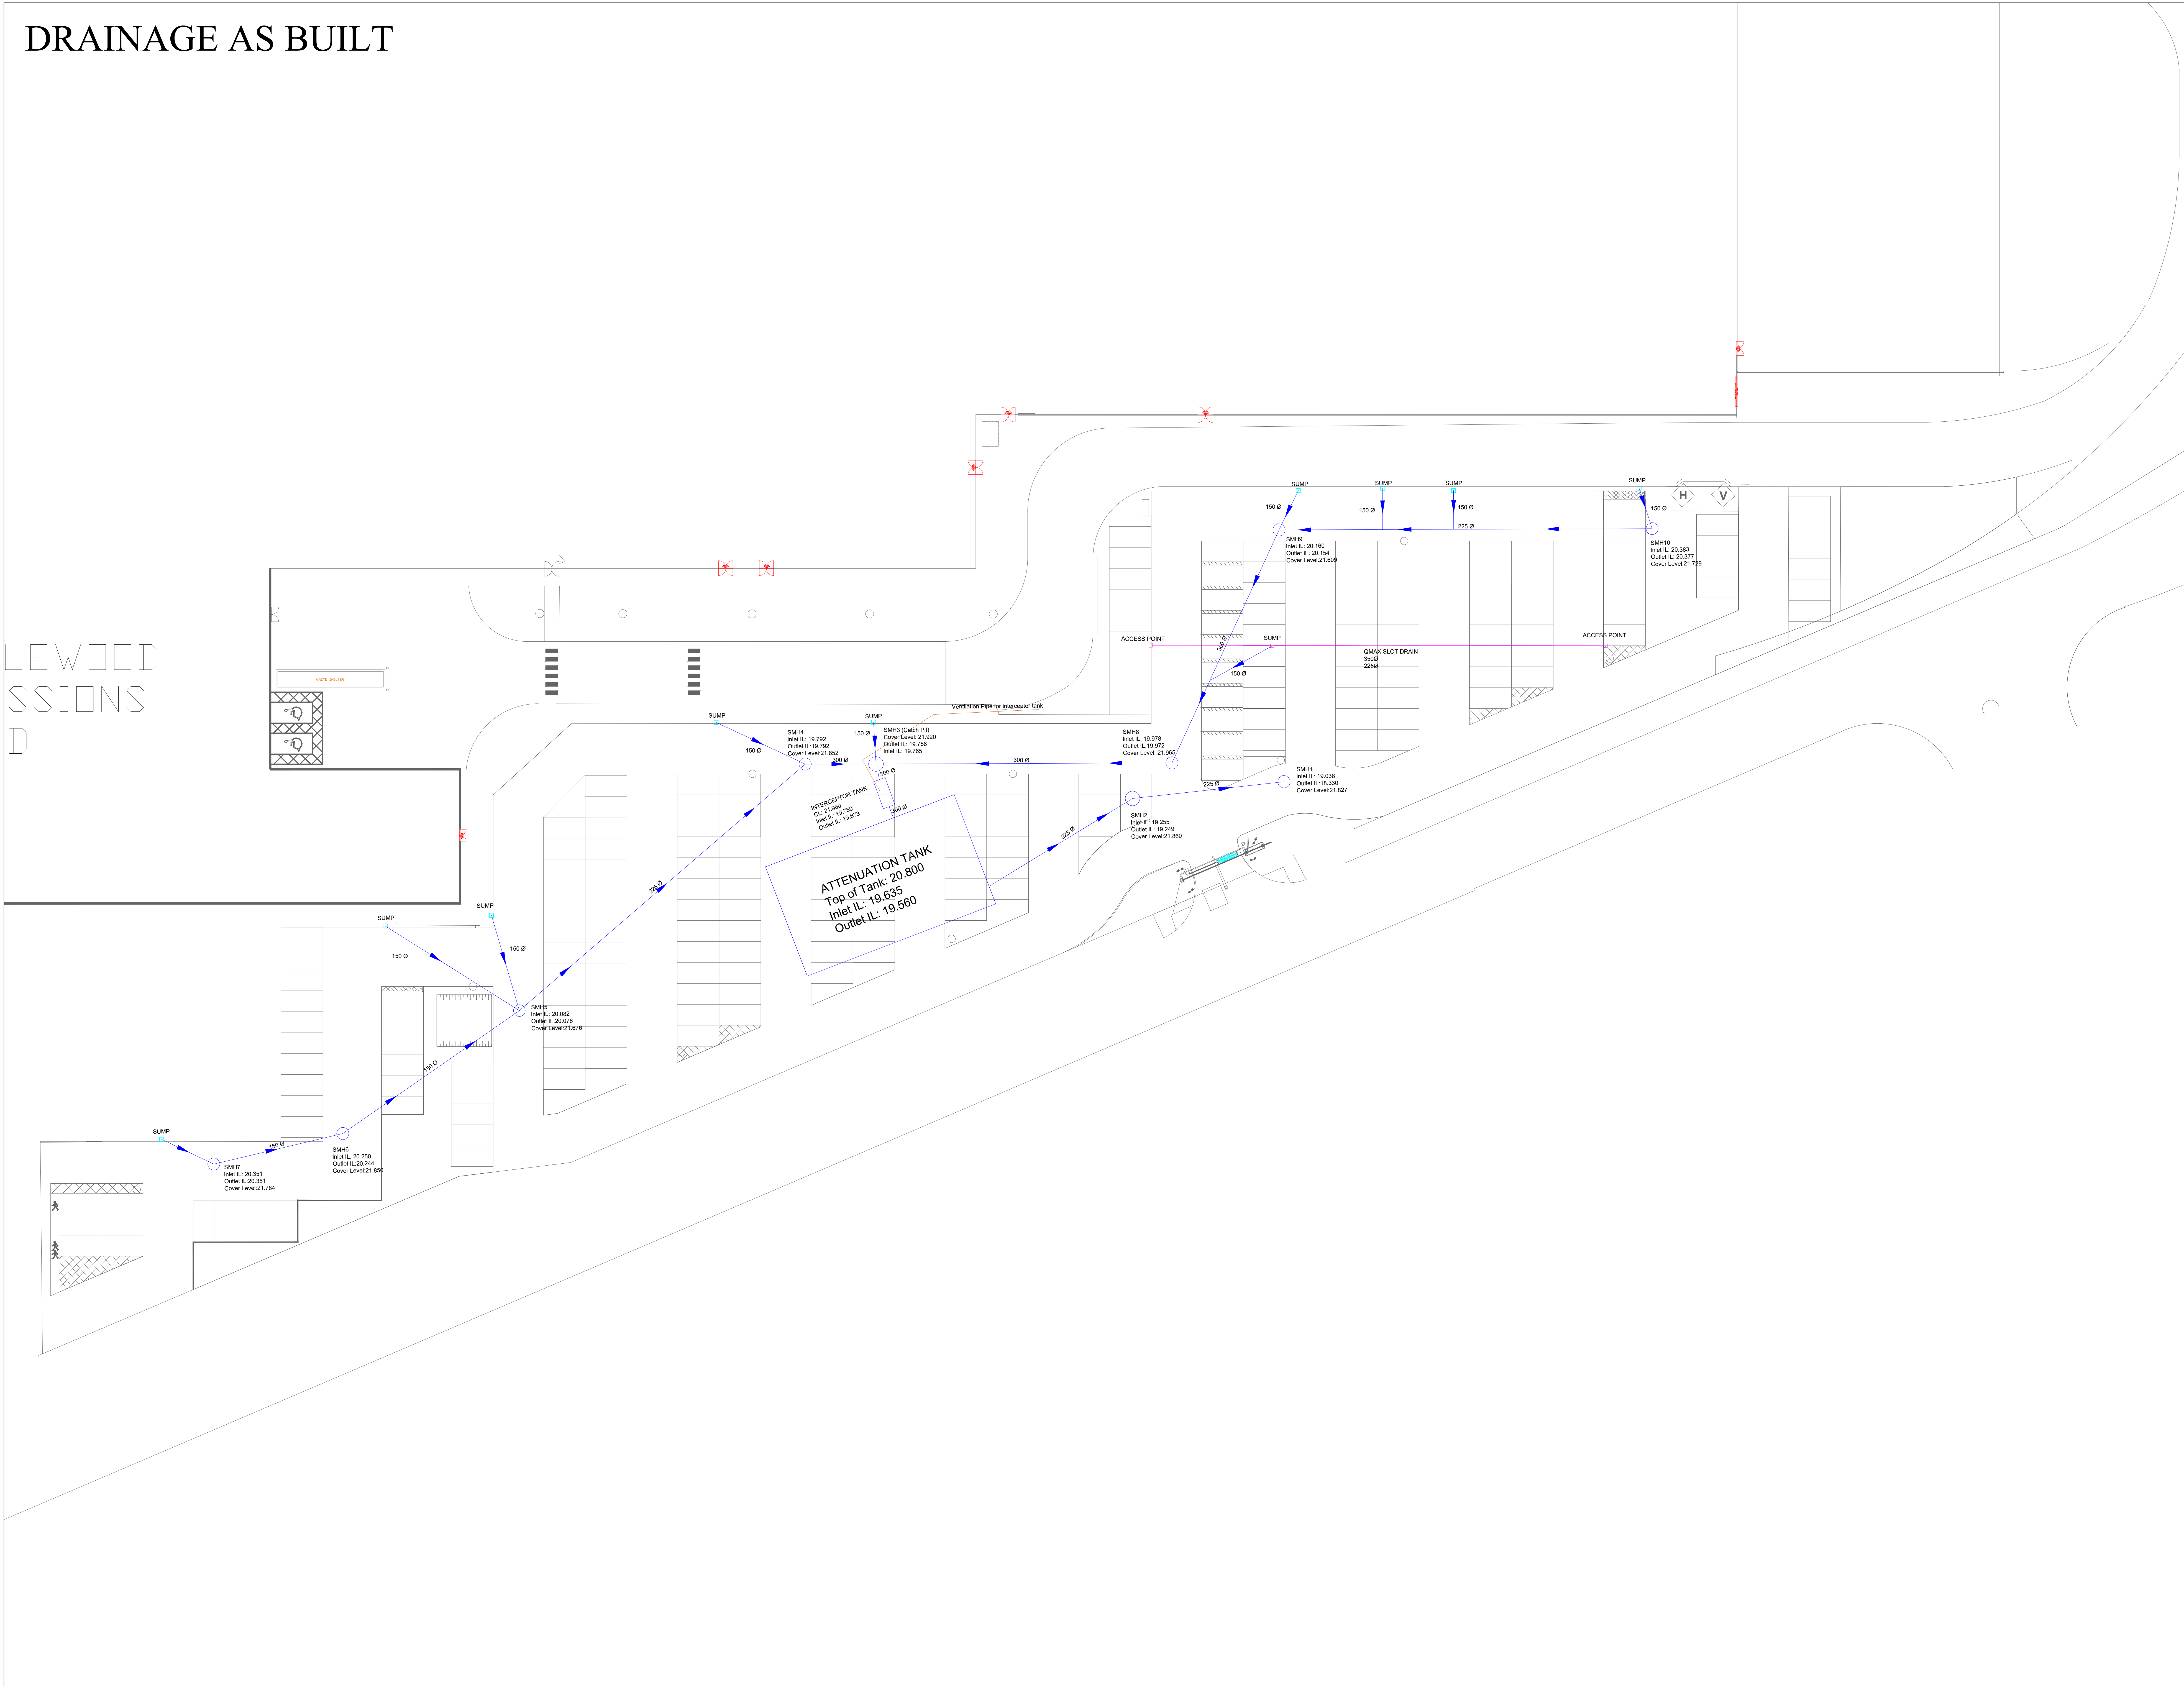

- KEY
- STORM DRAINAGE SHOWN IN BLUE
- = Surface water Manhole
  - = Kerb Sump
  - = QMax Slot Drain

|                                                                                                                                                                                                                                                                                              |                    |     |                         |     |      |
|----------------------------------------------------------------------------------------------------------------------------------------------------------------------------------------------------------------------------------------------------------------------------------------------|--------------------|-----|-------------------------|-----|------|
| Rev                                                                                                                                                                                                                                                                                          |                    | Rev |                         | Rev |      |
| <div><div>McDermotts<br/>Catherine Street<br/>Aston<br/>Birmingham<br/>B6 5ES<br/>Tel: 0121 129 6100<br/>Fax: 0121 129 6101<br/>Web: www.mcdermotts.co.uk<br/>E-mail: info@mcdermotts.co.uk</div></div> |                    |     |                         |     |      |
| DRAWING TITLE<br>DRAINAGE AS BUILT                                                                                                                                                                                                                                                           |                    |     |                         |     |      |
| SITE<br>FORD - CAR PARK<br>HALEWOOD                                                                                                                                                                                                                                                          |                    |     |                         |     |      |
| SCALE<br>A3@ 1:200                                                                                                                                                                                                                                                                           | DATE<br>19.07.2023 |     | DRAWING No.<br>C576-100 |     | REV. |
| DRAWN BY<br>Joseph Kenny                                                                                                                                                                                                                                                                     |                    |     |                         |     |      |