
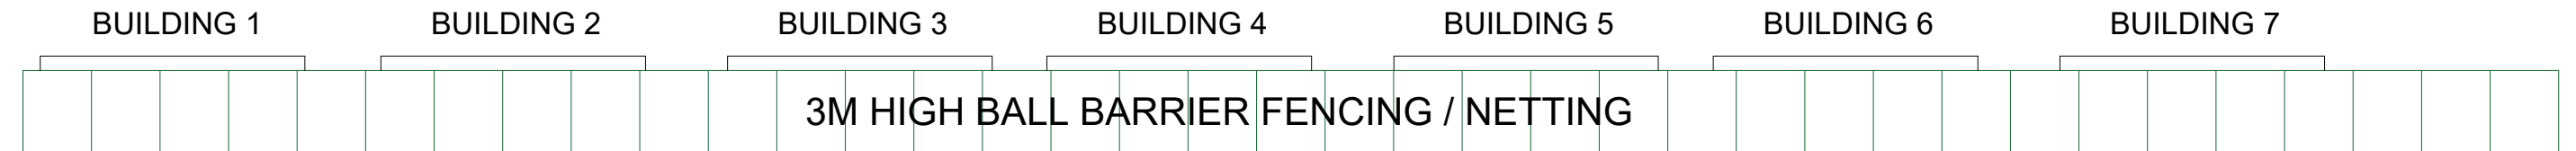
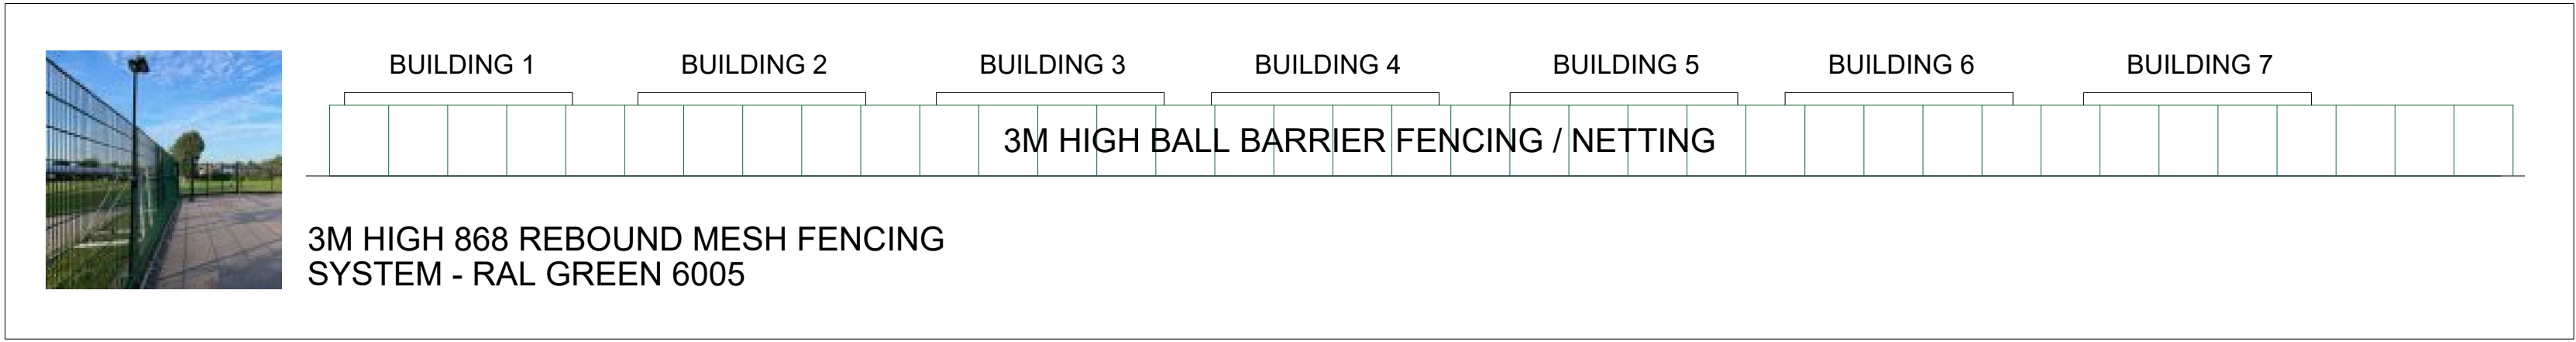



NOTE:
This drawing must not be reissued, loaned or copied without the written consent of
Department of Corporate Resources KMBC, (the originator).
All errors, omissions, discrepancies should be reported to the originator immediately.
All dimensions to be checked before site fabrication by the contractor, this is the
contractor's responsibility.
Any deviation from the drawing to be reported to the originator immediately.

Any mapped information depicted is based on Ordnance Survey material with the
permission of Ordnance Survey on behalf of the Controller of Her Majesty's Stationary
Office Crown Copyright.
Unauthorized reproduction infringes Crown Copyright and may lead to prosecution or
civil proceedings.
Knowsley MBC, LA 10007655
Ref: MAPREF

Drawing issue status:
☐ PRELIMINARY ☐ CLIENT APPROVAL ☐ PLANNING ☐
☐ BUILDING REGS ☐ TENDER ☐ CONSTRUCTION ☒ AS-BUILT

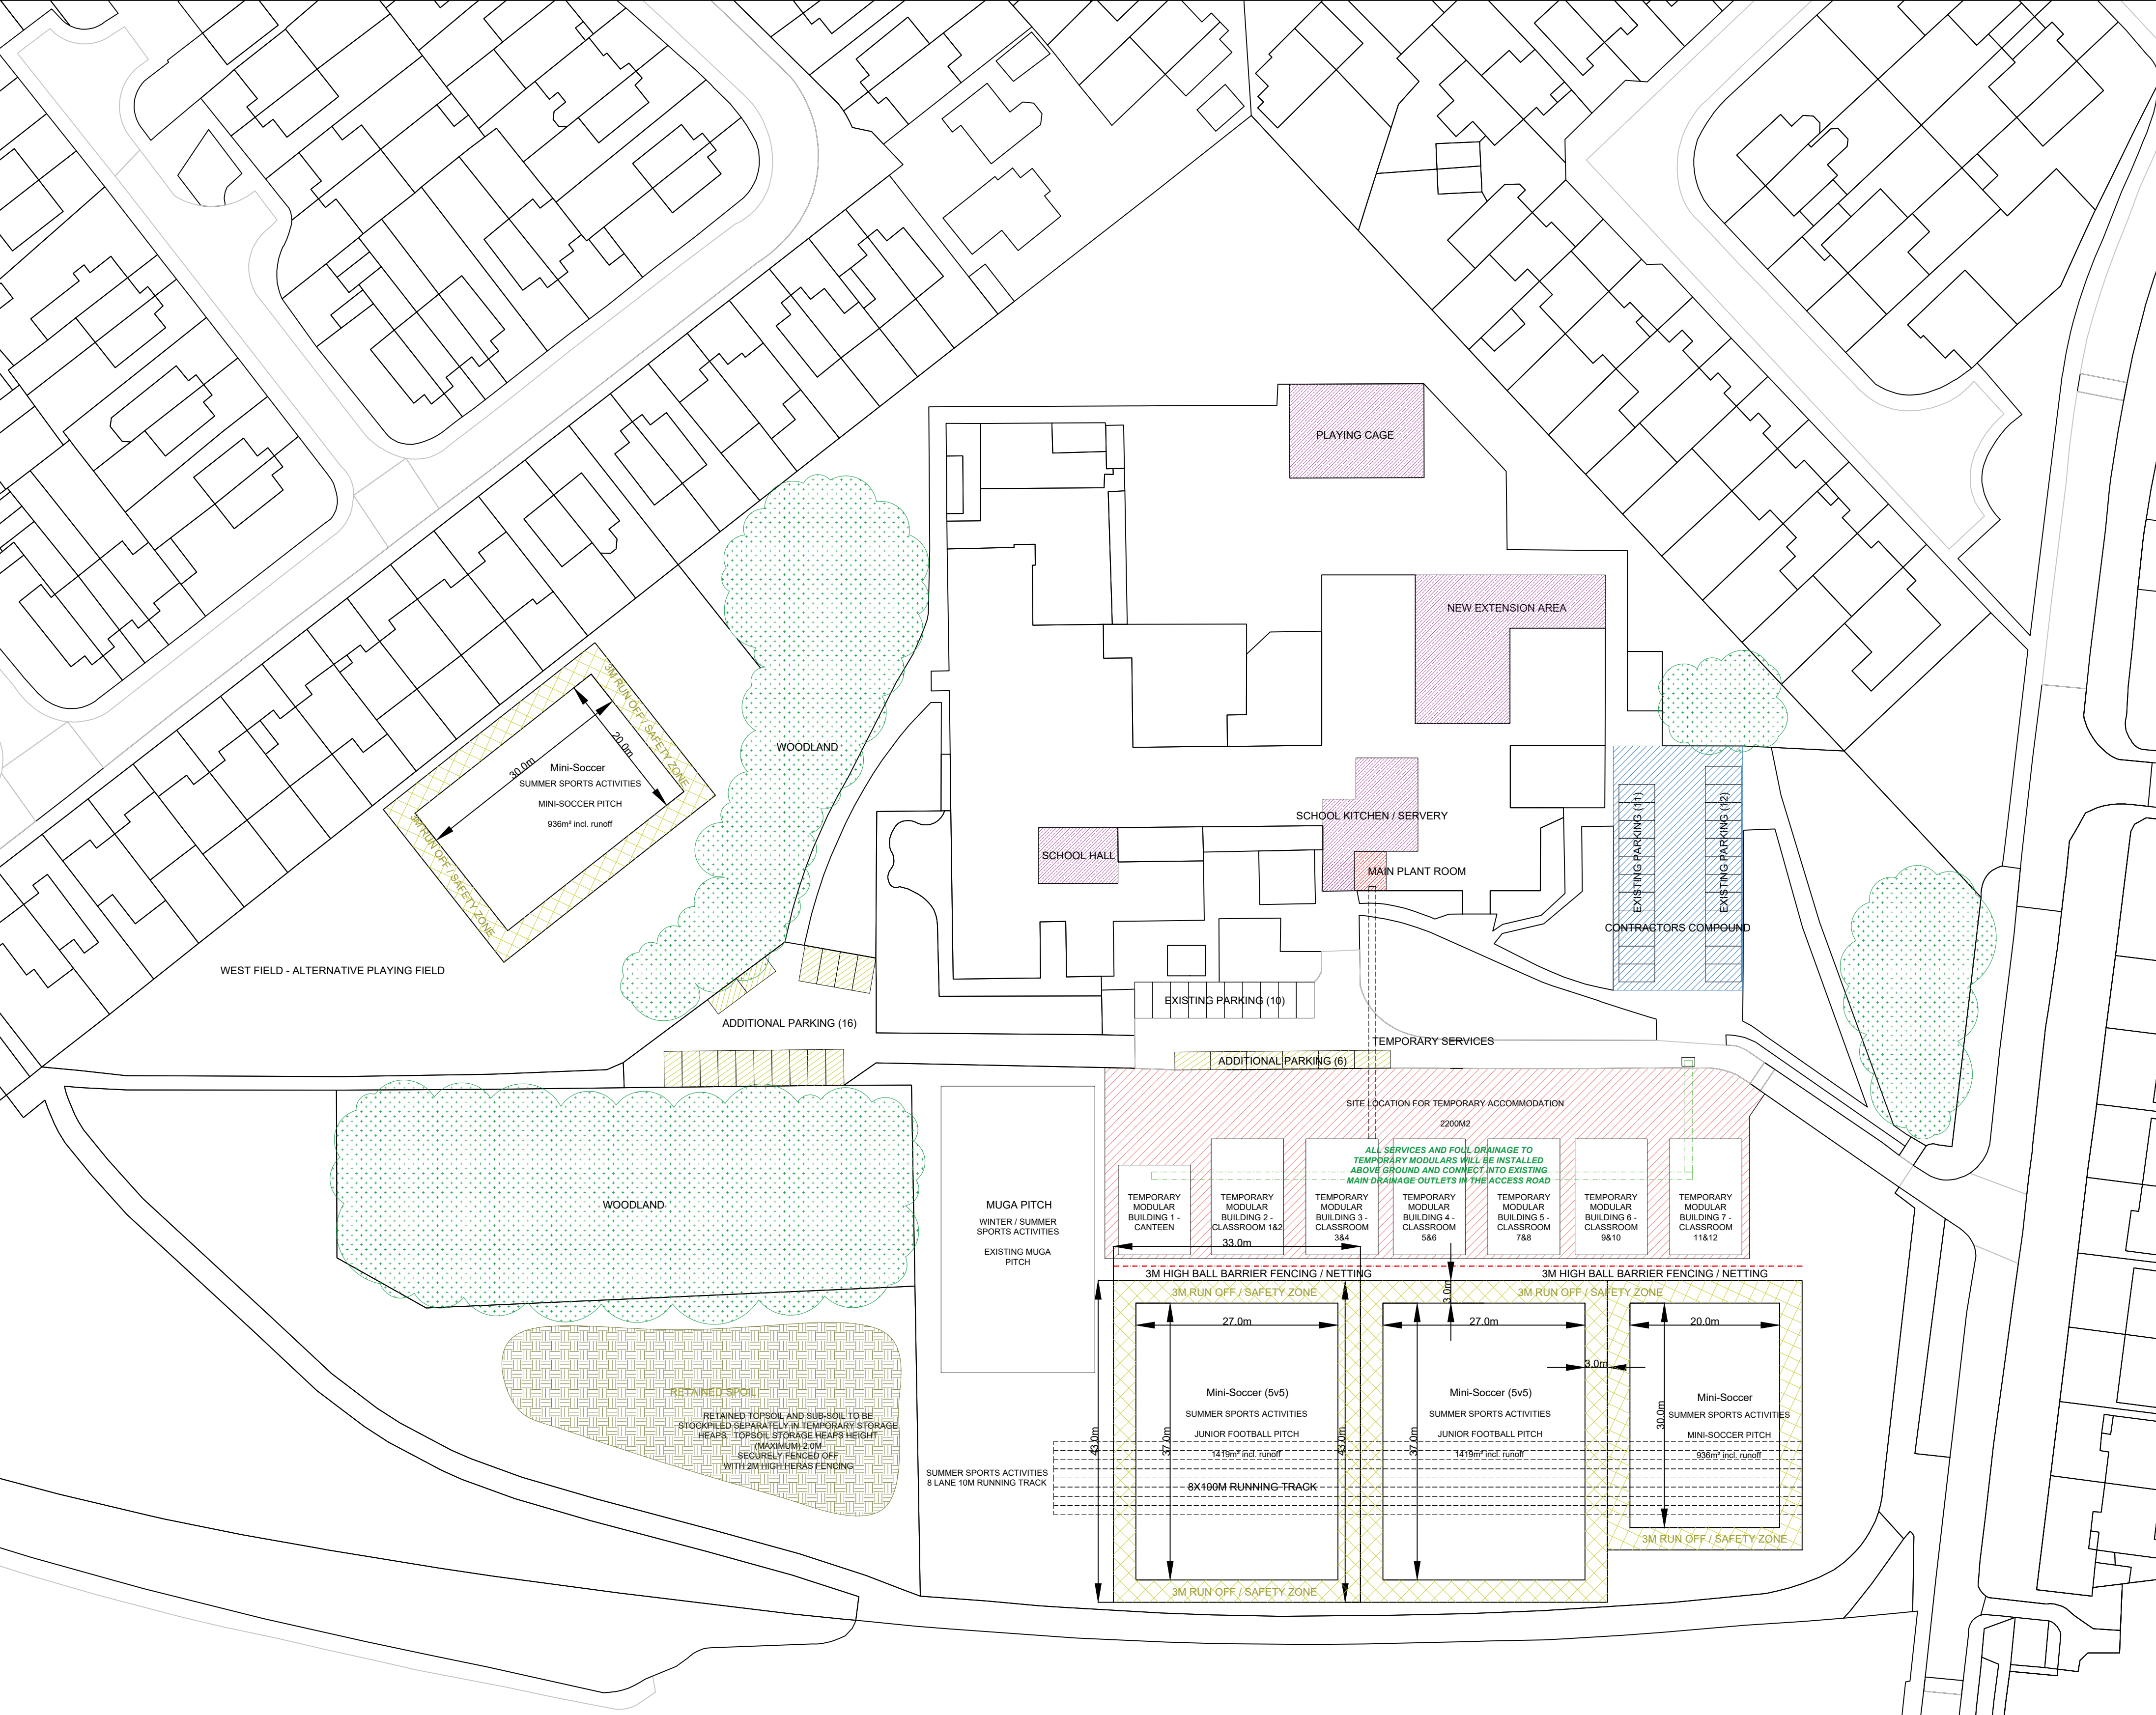

3M HIGH 868 REBOUND MESH FENCING
SYSTEM - RAL GREEN 6005

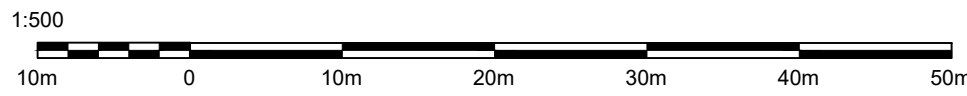

REV	DATE	DESCRIPTION
Directorate of Corporate Resources Asset Management 2nd Floor Yorkon Buildings Archway Road Merseyside, L36 9YU TEL: 0151 443 2611 FAX: 		
PROJECT PLANTATION SCHOOL REFURBISH		CLIENT CHILDREN'S SERVICES
SUBJECT PROPOSED TEMPORARY ACCOMMODATION		SHEET SIZE DATE 01.10.22 SCALE 1:500
PROJECT NR 2022/10/A	DRAWING NR 004	REV A DRAWN DW CHECKED DW