




Abbreviations:			
AR	Assumed Route	IL	Invert Level
BOL	Bollard	LP	Lamp Post
BrS	Bridge Support	Mrk	Marker
BH	Borehole	MH	Manhole
BT	British Telecom Cover	OSA	Off Survey Area
CG	Cattle Grid	RL	Ridge Level
CL	Cover Level	RS	Road Sign
Conc	Concrete	RWP	Rain Water Pipe
EC	Electricity Cover	SV	Stop Valve
EL	Eaves Level	ST	Stop Top
EOT	End of Trace	TFR	Taken From Records
Gu	Gully	TOW	Top of Wall Level
IC	Inspection Cover	TP	Telegraph Pole
		VP	Vent Pipe

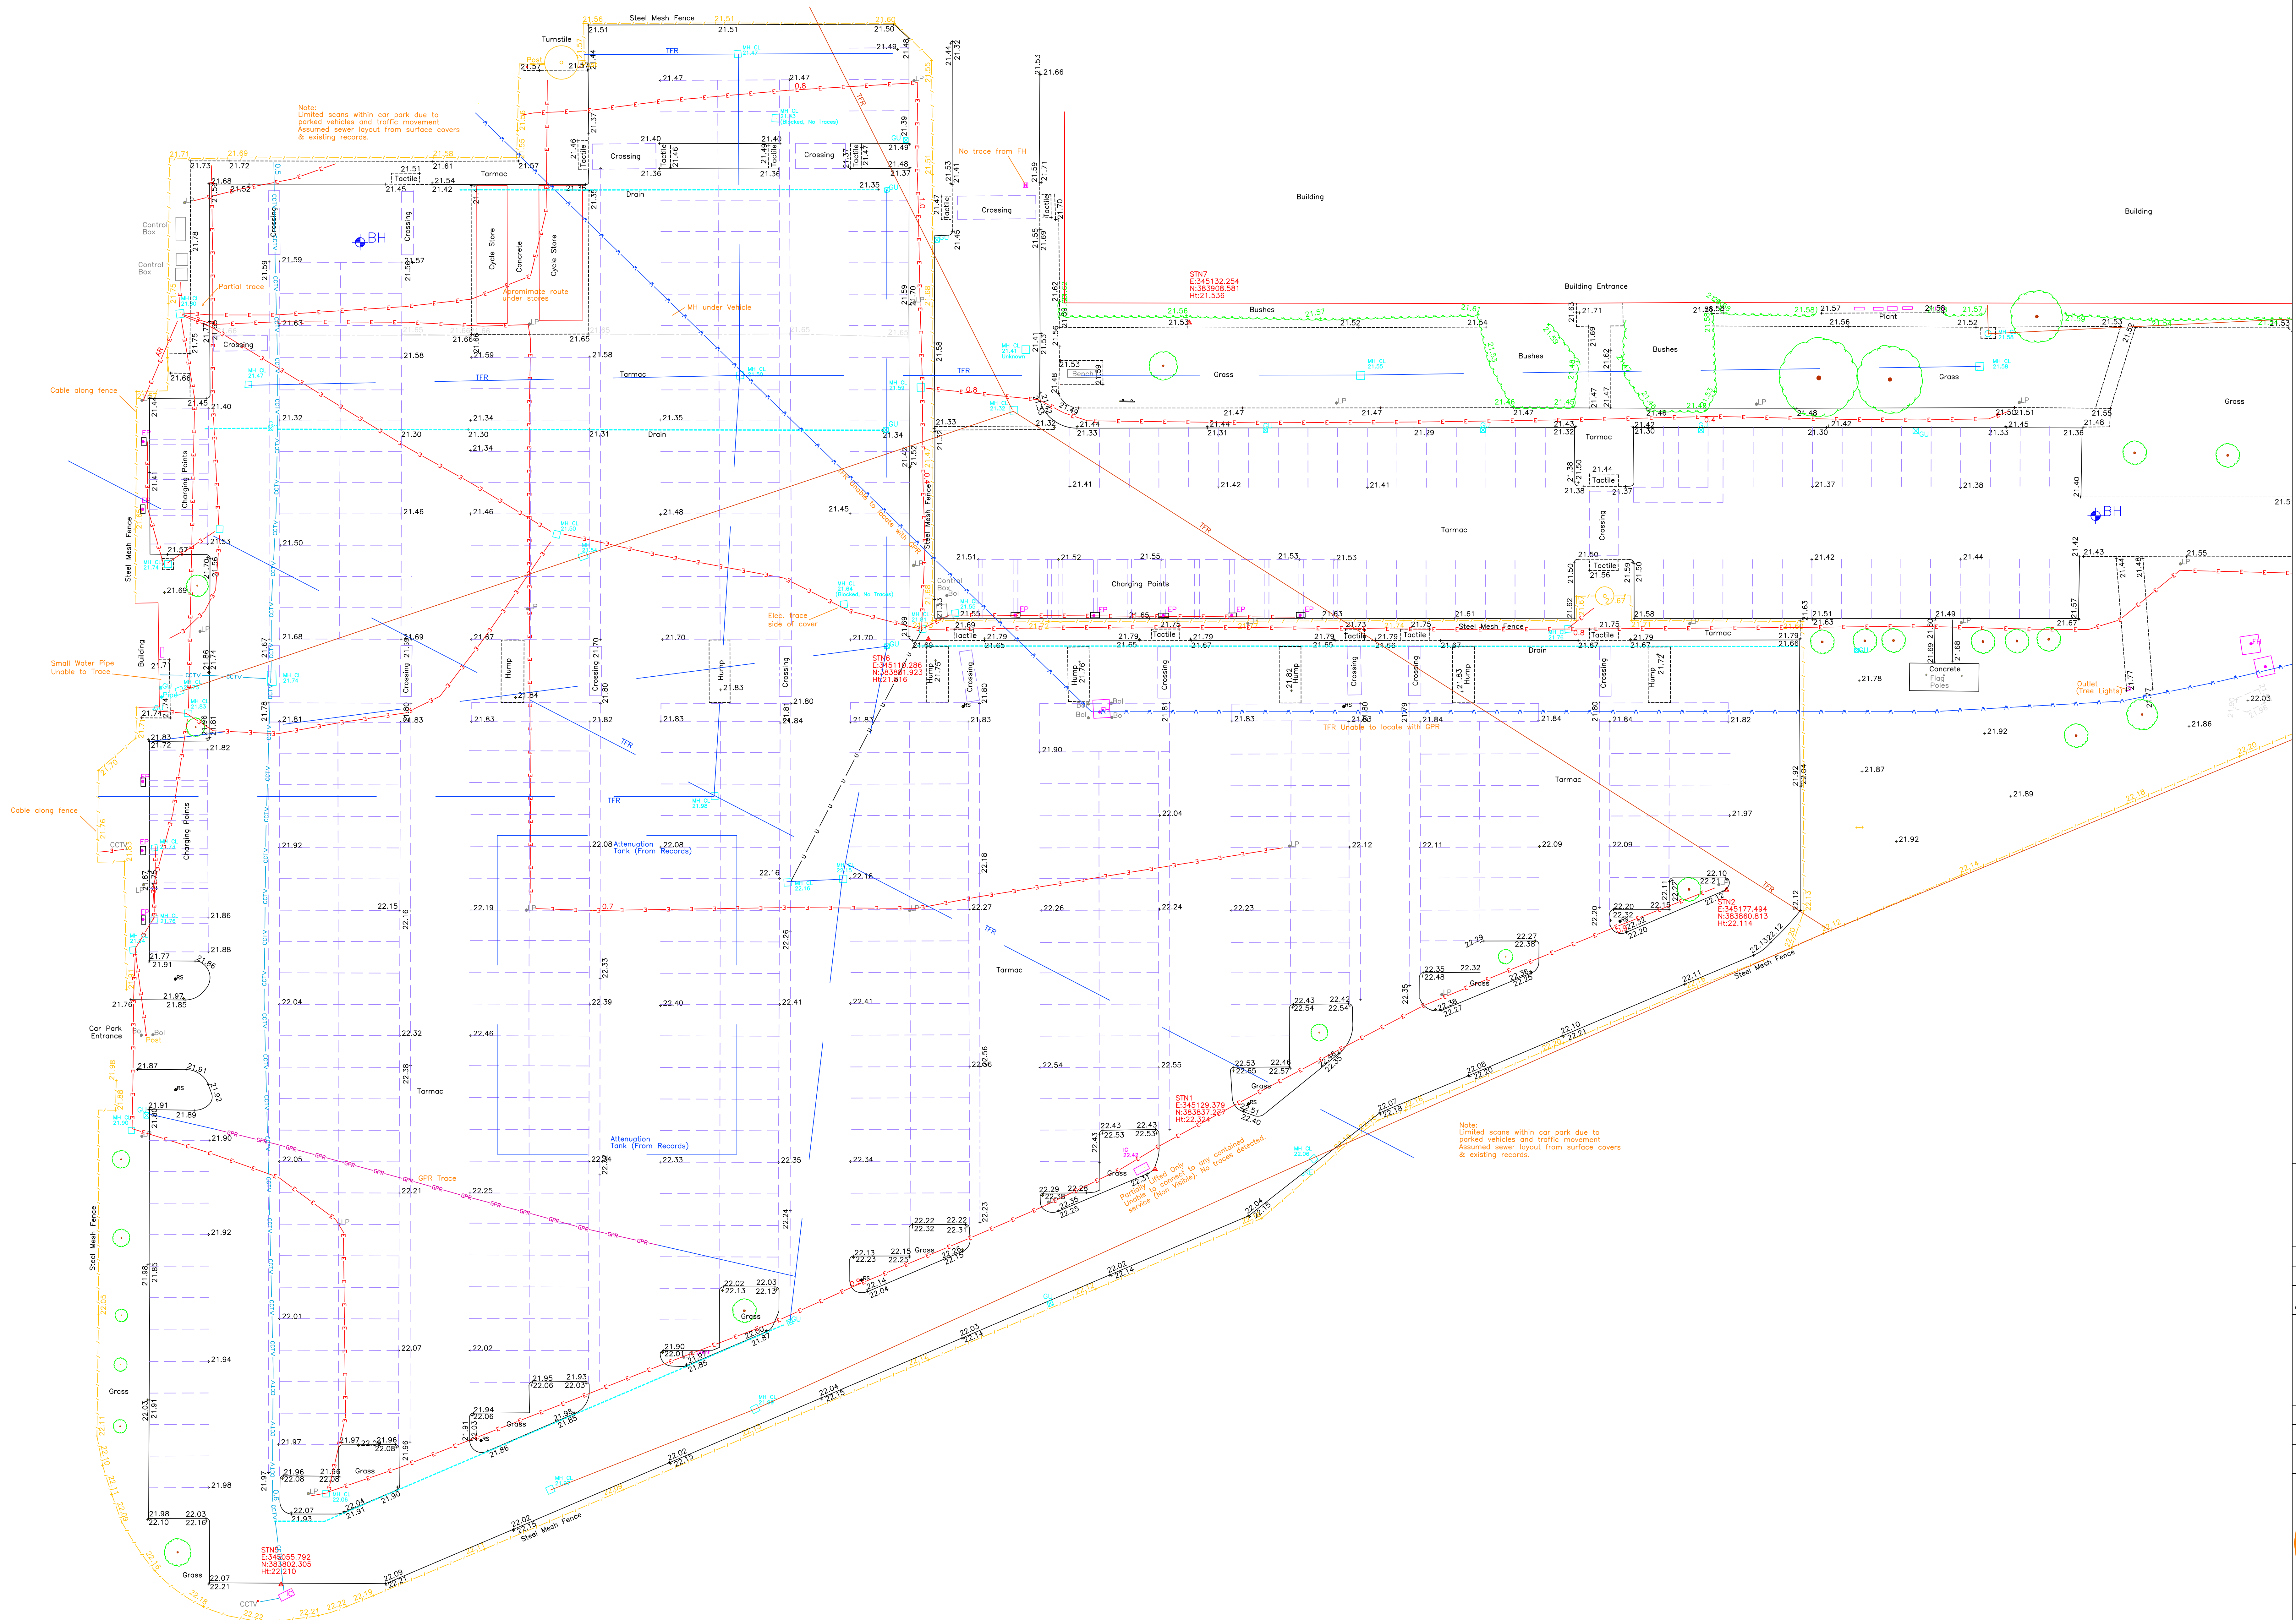

Legend:					
	Bank		Tree/Shrub Canopy		Drop Kerb/ Surface Boundary
	Fence		Survey Station		Level Position
	Retaining Wall		Tree		Gate
	Building		Tree		Tree Position
	Hedge		Gully		
	Contours 0.5m				
	100				
	100				
	100</				

A single line indicating a utility may indicate the presence of multiple services within close proximity to each other. Where a single line type is shown we recommend hand digging within 0.5m to expose hidden services.

OS Note:
If indicated below, this survey has been orientated to the Ordnance Survey (O.S.) National Grid (OSGB36) via Global Navigational Satellite Systems (GNSS) and the O.S. Active Network (OS Net). A true OSGB36 coordinate has been established near to the site centre via a transformation using the OSN15 & OSGM15 transformation models.
The survey has been correlated to this point and a further one or more OSGB36 points established to create a true O.S. bearing for angle orientation.
No scale factor has been applied to the survey therefore the coordinates shown are arbitrary & not true O.S. Coordinates which have a scale factor applied.
Visible features in the vicinity of boundaries as shown on this survey, may not represent the extent of legally conveyed ownership. Whilst every effort has been made to achieve accuracy on this plan, CRUCIAL clearance dimensions, levels & invert levels should be checked prior to design & construction.
Some services may have been omitted due to parked vehicles.

Title: Topographic/Utility Survey
Ford Halewood
Speke Boulevard
Liverpool

Drawing No: 10440_A0-1
File No: IS/0423/10440/OS6
Levels: Relative to Ordnance Datum
Grid: Newlyn, Cornwall
OSN15

Client: On Site Energy


Scale: 1:200@A0
Date: 25/04/2023
Sheet No: 1 of 5
Revision:
Surveyors: SH
Prepared By: SH
Checked By: SC

EST.1989

INITIAL SURVEYS

21 Longacre Close, Holbrook Ind. Estate
Sheffield S21 3FR
Tel. 08456 125666 Fax. 08456 125667
Mobile 07831 145199
Email office@initialsurveys.co.uk
www.initialsurveys.co.uk

DISCLAIMER: The location of under ground services shown on this drawing has been determined using electro-magnetic (and/or ground probing radar, where requested) techniques and visual observations. The limitations of this drawing should be realised and no guarantee can be given that all services have been identified. This drawing may not include the location of all public services that may cross the site and therefore the relevant service drawings should be obtained from the appropriate utility company and used in conjunction with this drawing. Additional services, structures or other below ground obstructions not indicated on this drawing may be present on site. Reference should be made to historical plans and as built drawings. Excavations in the vicinity of services should be carried out with due diligence ref. HSG47 document "avoiding dangers from underground services". Location accuracy is determined by referring to manufacturers guidelines for the systems deployed. Reference should be made to the latest version of IS Ltd site procedures document for utility location surveys.

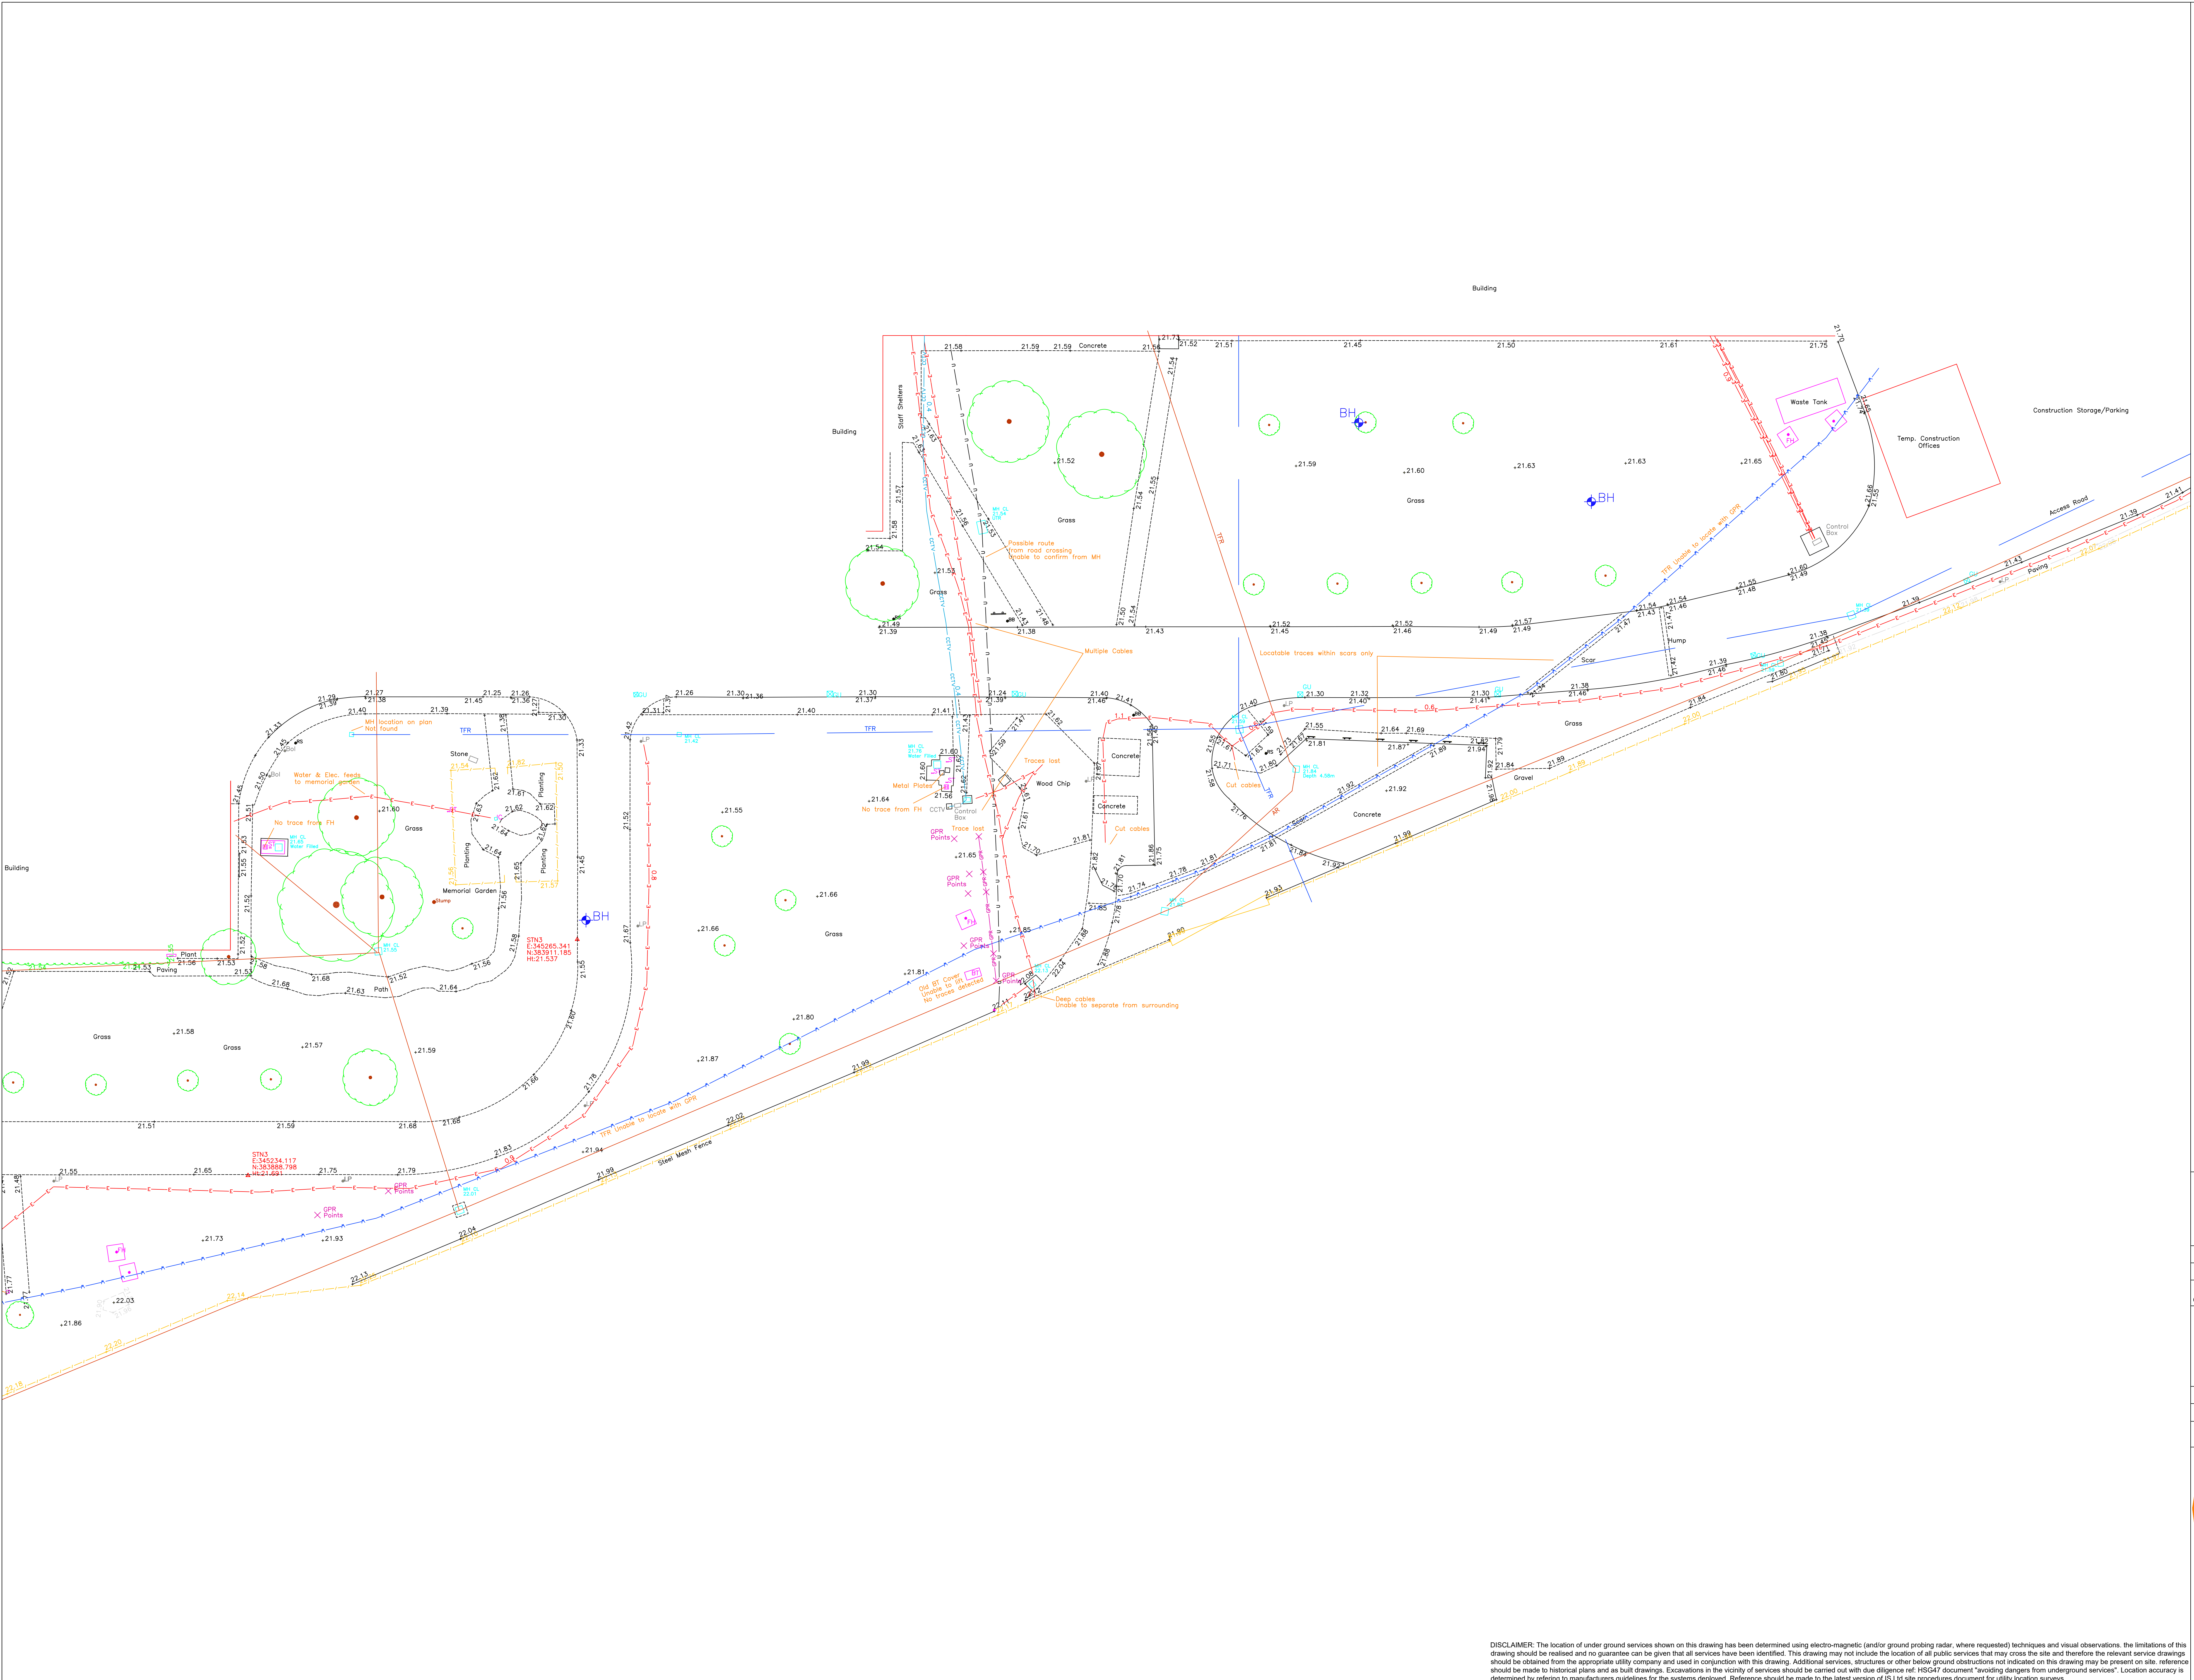

Abbreviations:

AR	Assumed Route	IL	Invert Level
BOL	Bollard	LP	Lamp Post
BrS	Bridge Support	Mrk	Marker
BH	Borehole	MH	Manhole
BT	British Telecom Cover	OSA	Off Survey Area
CG	Cattle Grid	RL	Ridge Level
CL	Cover Level	RS	Road Sign
Conc	Concrete	RWP	Rain Water Pipe
EC	Electricity Cover	SV	Stop Valve
EL	Eaves Level	ST	Stop Top
EOT	End of Trace	TFR	Taken From Records
Gu	Gully	TOW	Top of Wall Level
IC	Inspection Cover	TP	Telegraph Pole
		VP	Vent Pipe

Legend:

Bank	Drop Kerb/ Surface Boundary
Tree/Shrub Canopy	Level Position
Fence	Survey Station
Wall	Tree
Retaining Wall	Gate
Building	Tree Position
Hedge	Gully
Contours 0.5m	

Legend:

Foul Drainage	British Telecom
Surface Drainage	Compressed Air
Combined Drainage	Offset Fill-Line
Electricity	Pipe
High Voltage Electricity	Ventilation
Gas	Fuel Line
GPR	Vapour Recovery
Ground Probing Radar	Gauge Line
Water	Telemetry
Cable Television	Unknown
Close Circuit Television	

A single line indicating a utility may indicate the presence of multiple services within close proximity to each other. Where a single line type is shown we recommend hand digging within 0.5m to expose hidden services.

OS Note:
If indicated below, this survey has been orientated to the Ordnance Survey (O.S.) National Grid (OSGB36) via Global Navigational Satellite Systems (GNSS) and the O.S. Active Network (OS Net). A true OSGB36 coordinate has been established near to the site centre via a transformation using the OSN15 & OSGM15 transformation models.
The survey has been correlated to this point and a further one or more OSGB36 points established to create a true O.S. bearing for angle orientation.
No scale factor has been applied to the survey therefore the coordinates shown are arbitrary & not true O.S. Coordinates which have a scale factor applied.

Visible features in the vicinity of boundaries as shown on this survey, may not represent the extent of legally conveyed ownership. Whilst every effort has been made to achieve accuracy on this plan, CRUCIAL clearance dimensions, levels & invert levels should be checked prior to design & construction.
Some services may have been omitted due to parked vehicles.


Title:
Topographic/Utility Survey
Ford Halewood
Speke Boulevard
Liverpool

Drawing No: 10440_A0-2
File No: IS/0423/10440/OS6
Levels: Relative to Ordnance Datum
Newlyn, Cornwall
OSN15
Grid: OSN15
Client: On Site Energy

Scale: 1:200@A0
Sheet No: 2 of 5
Surveyors: SH
Prepared By: SH
Checked By: SC
Date: 25/04/2023
Revision:
EST.1989

INITIAL SURVEYS
21 Longacre Close, Holbrook Ind. Estate
Sheffield S21 3FR
Tel. 08456 125666 Fax. 08456 125667
Mobile 07831 145199
Email office@initialandsurveys.co.uk
www.initialandsurveys.co.uk

DISCLAIMER: The location of under ground services shown on this drawing has been determined using electro-magnetic (and/or ground probing radar, where requested) techniques and visual observations. The limitations of this drawing should be realised and no guarantee can be given that all services have been identified. This drawing may not include the location of all public services that may cross the site and therefore the relevant service drawings should be obtained from the appropriate utility company and used in conjunction with this drawing. Additional services, structures or other below ground obstructions not indicated on this drawing may be present on site. Reference should be made to historical plans and as built drawings. Excavations in the vicinity of services should be carried out with due diligence ref: HSC47 document "avoiding dangers from underground services". Location accuracy is determined by referring to manufacturers guidelines for the systems deployed. Reference should be made to the latest version of IS Ltd site procedures document for utility location surveys.

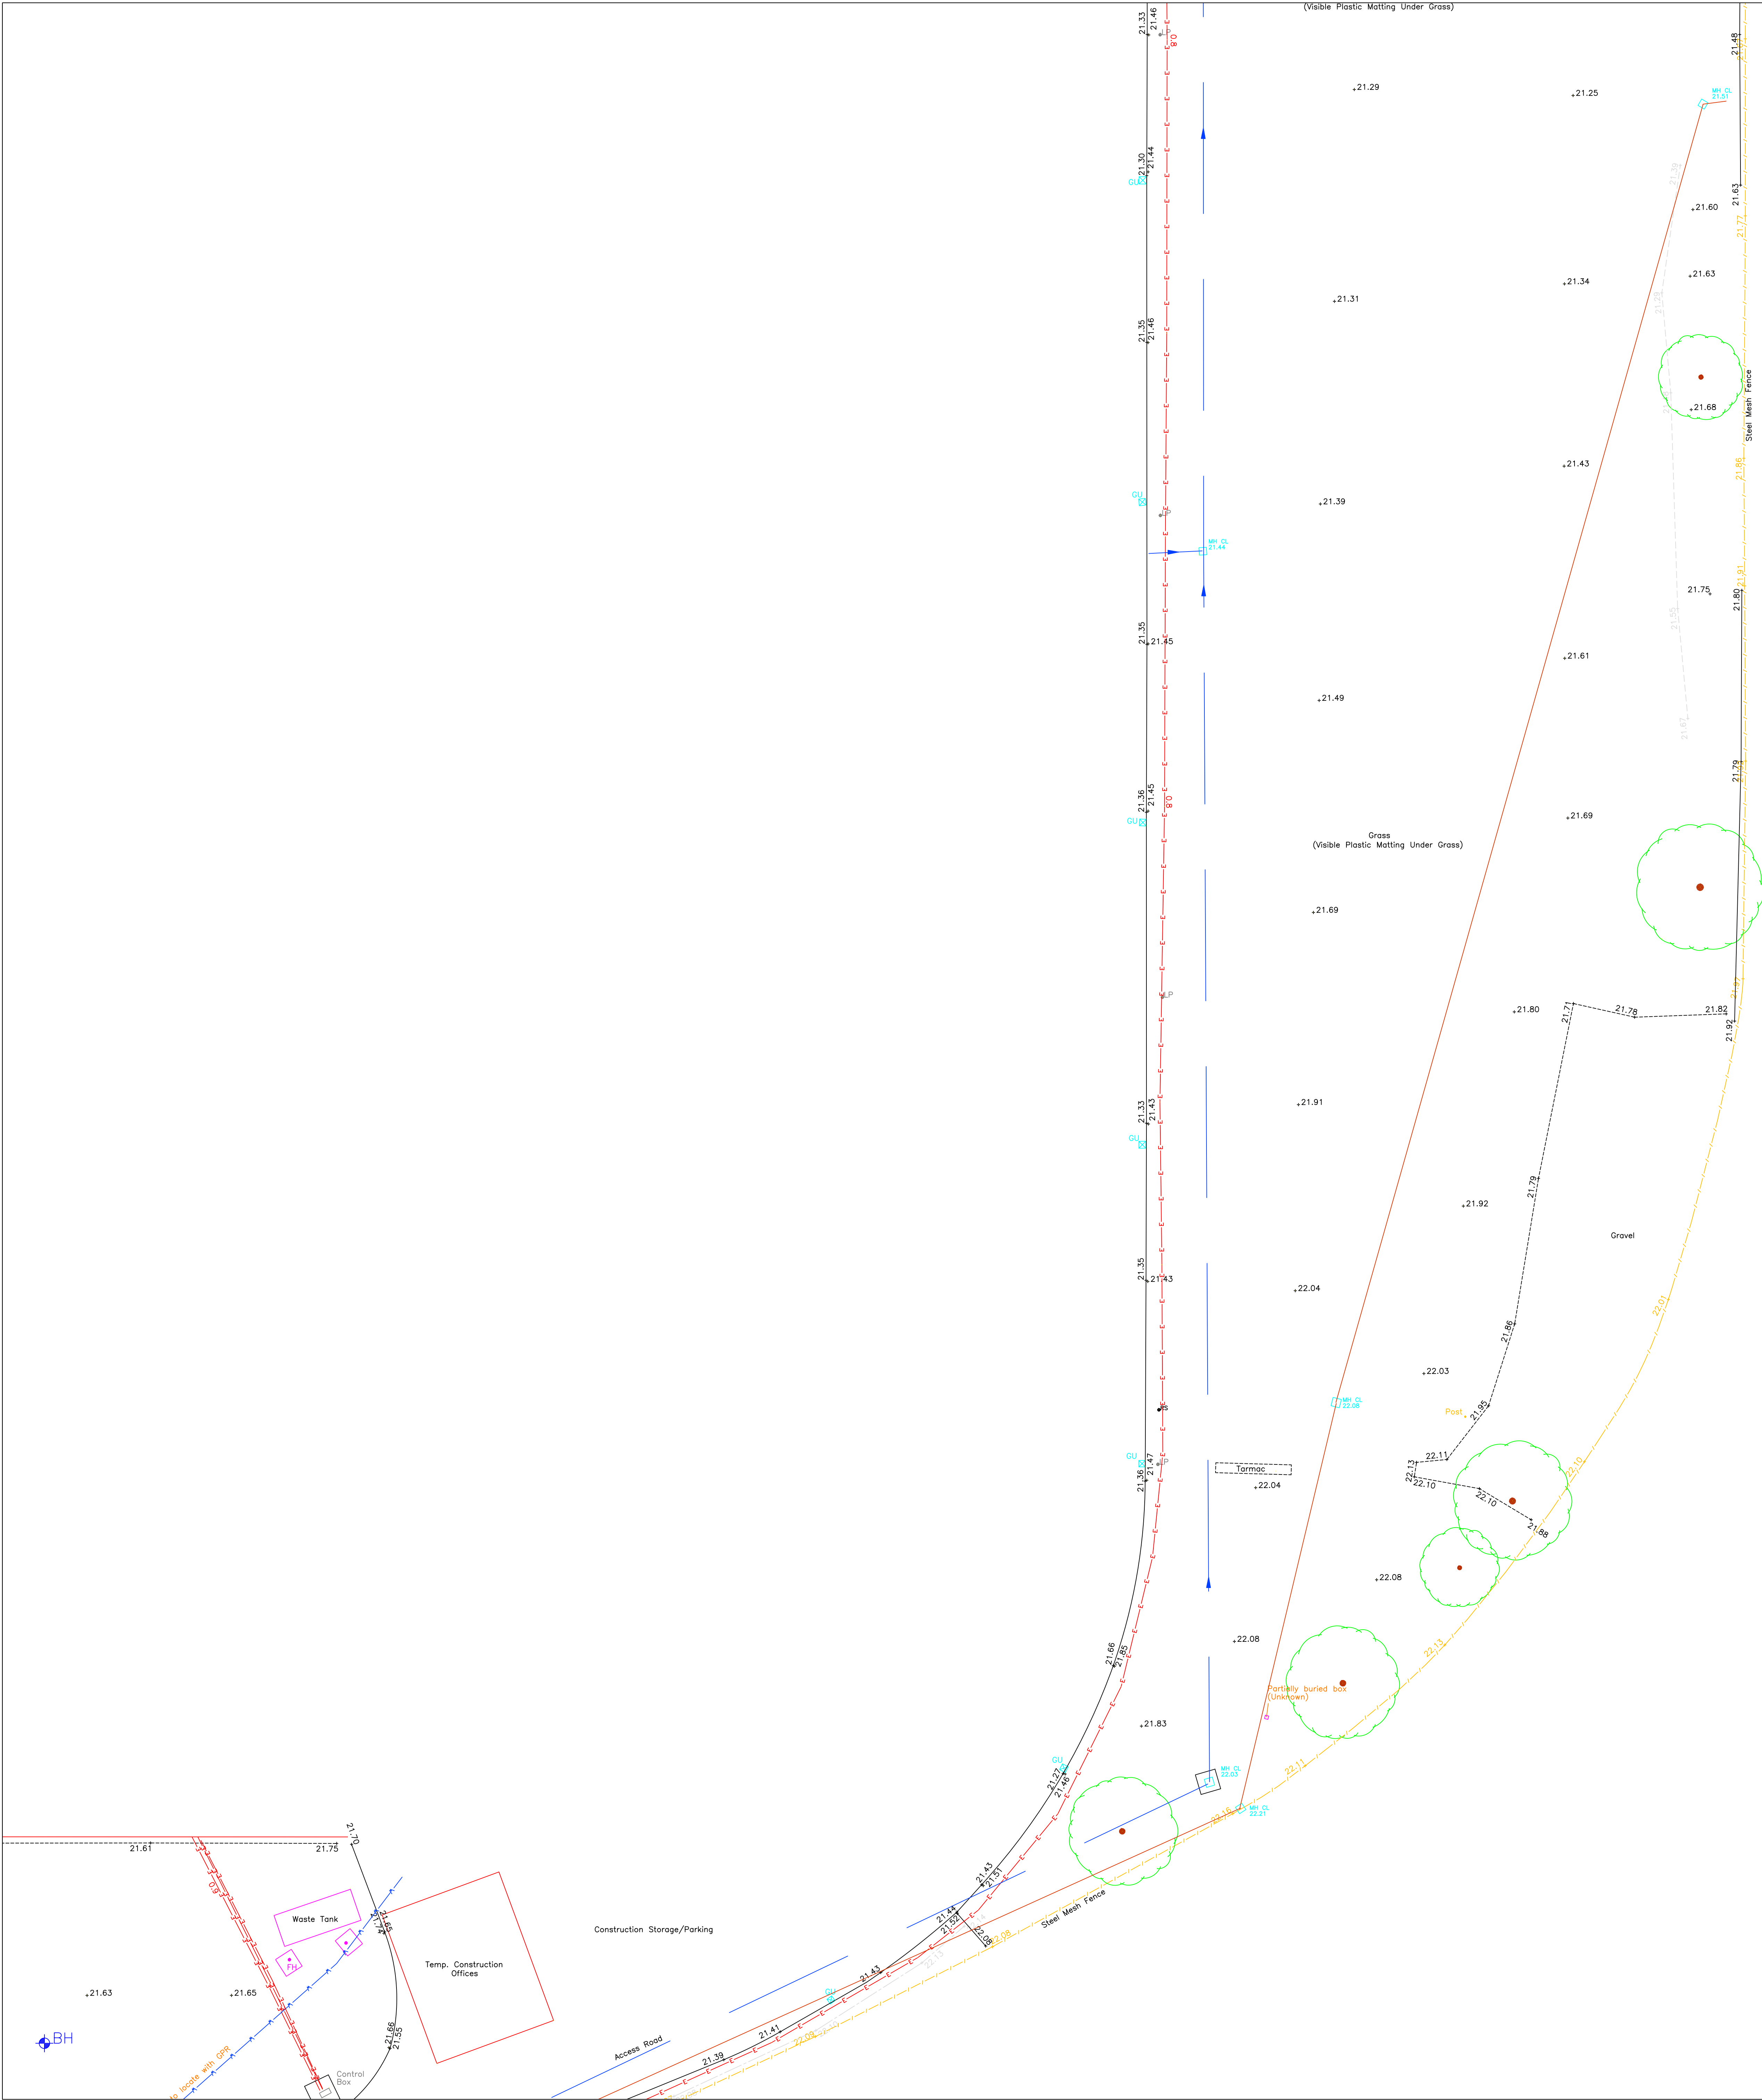

Abbreviations:

AR	Assumed Route	IL	Invert Level
BOL	Bollard	LP	Lamp Post
BrS	Bridge Support	Mrk	Marker
BH	Borehole	MH	Manhole
BT	British Telecom Cover	OSA	Off Survey Area
CG	Cattle Grid	RL	Ridge Level
CL	Cover Level	RS	Road Sign
Conc	Concrete	RWP	Rain Water Pipe
EC	Electricity Cover	SV	Stop Valve
EL	Eaves Level	ST	Stop Top
EOT	End of Trace	TFR	Taken From Records
Gu	Gully	TOW	Top of Wall Level
IC	Inspection Cover	TP	Telegraph Pole
		VP	Vent Pipe




SURVEYOR'S OFFICE

Legend:	
Bank	Drop Kerb/ Surface Boundary
Tree/Shrub Canopy	Level Position
Fence	Survey Station
Wall	Tree
Retaining Wall	Gate
Building	Tree Position
Hedge	Gully
Contours 0.5m	

Foul Drainage	British Telecom
Surface Drainage	Compressed Air
Combined Drainage	Offset Fill-Line
Electricity	Pipe
High Voltage Electricity	Ventilation
Gas	Fuel Line
Ground Probing Radar	Vapour Recovery
Water	Gauge Line
Cable Television	Telemetry
Close Circuit Television	Unknown

A single line indicating a utility may indicate the presence of multiple services within close proximity to each other. Where a single line type is shown we recommend hand digging within 0.5m to expose hidden services.

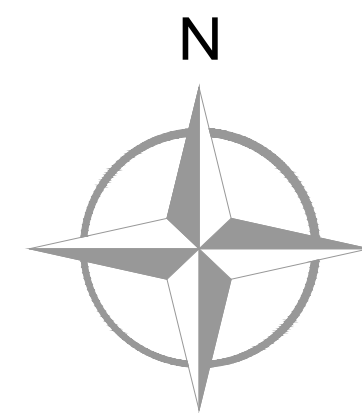

OS Note:
If indicated below, this survey has been orientated to the Ordnance Survey (O.S.) National Grid (OSGB36) via Global Navigational Satellite Systems (GNSS) and the O.S. Active Network (OS Net). A true OSGB36 coordinate has been established near to the site centre via a transformation using the OSN15 & OSGM15 transformation models.
The survey has been correlated to this point and a further one or more OSGB36 points established to create a true O.S. bearing for angle orientation.
No scale factor has been applied to the survey therefore the coordinates shown are arbitrary & not true O.S. Coordinates which have a scale factor applied.

Visible features in the vicinity of boundaries as shown on this survey, may not represent the extent of legally conveyed ownership. Whilst every effort has been made to achieve accuracy on this plan, CRUCIAL clearance dimensions, levels & invert levels should be checked prior to design & construction.
Some services may have been omitted due to parked vehicles.

Title:
Topographic/Utility Survey
Ford Halewood
Speke Boulevard
Liverpool

Drawing No: 10440_A0-3
File No: IS/0423/10440/OS6

Levels: Relative to Ordnance Datum
Height, Cornhill
OSN15

Client:
On Site Energy

Scale: 1:200@A0
Date: 25/04/2023

Sheet No. 3 of 5
Revised:

Surveyors: SH
Prepared By: SH
Checked By: SC

EST.1989




21 Longacre Close, Holbrook Ind. Estate
Sheffield S21 3FR
Tel. 08456 125666 Fax. 08456 125667
Mobile 07831 145199
Email office@initialandsurveys.co.uk
www.initialandsurveys.co.uk

DISCLAIMER: The location of under ground services shown on this drawing has been determined using electro-magnetic (and/or ground probing radar, where requested) techniques and visual observations. The limitations of this drawing should be realised and no guarantee can be given that all services have been identified. This drawing may not include the location of all public services that may cross the site and therefore the relevant service drawings should be obtained from the appropriate utility company and used in conjunction with this drawing. Additional services, structures or other below ground obstructions not indicated on this drawing may be present on site. Reference should be made to historical plans and as built drawings. Excavations in the vicinity of services should be carried out with due diligence ref: HSG47 document "avoiding dangers from underground services". Location accuracy is determined by referring to manufacturers guidelines for the systems deployed. Reference should be made to the latest version of IS Ltd site procedures document for utility location surveys.

Legend:


	Bank		Drop Kerb / Surface Boundary
	Tree/Shrub Canopy		Level Position
	Fence		Survey Station
	Wall		Tree
	Retaining Wall		Gate
	Building		Tree Position
	Hedge		Gully
	Contours 0.5m		
	Foul Drainage		BT
	Surface Drainage		British Telecom
	Combined Drainage		Compressed Air
	Electricity		Offset Fill-Line
	High Voltage Electricity		Pipe
	Gas		Ventilation
	Ground Probing Radar		Fuel Line
	Water		Vapour Recovery
	Cable Television		Grave Line
	Cable Circuit Television		Telemetry
			Unknown

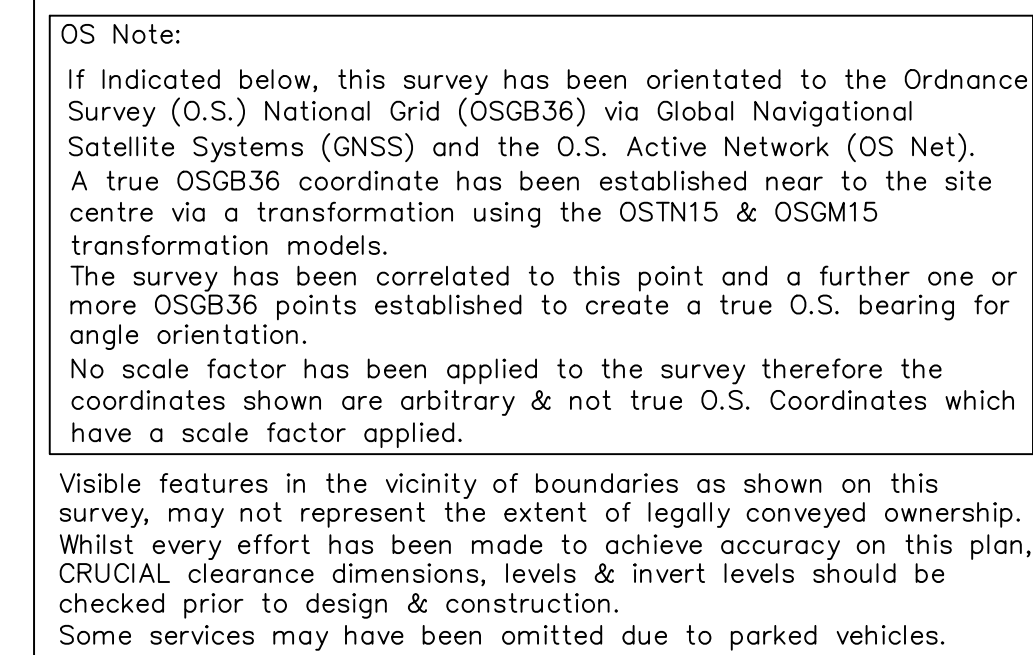

Drawing No:	10440_A0-4
File No:	IS/0423/10440/OS6
Levels:	Relative to Ordnance Datum
Grid:	- Newlyn, Cornwall OSTN15

Scale : 1:200@A0	Date : 25/04/2023
Sheet No. 4 of 5	Revision.

 EST.1989

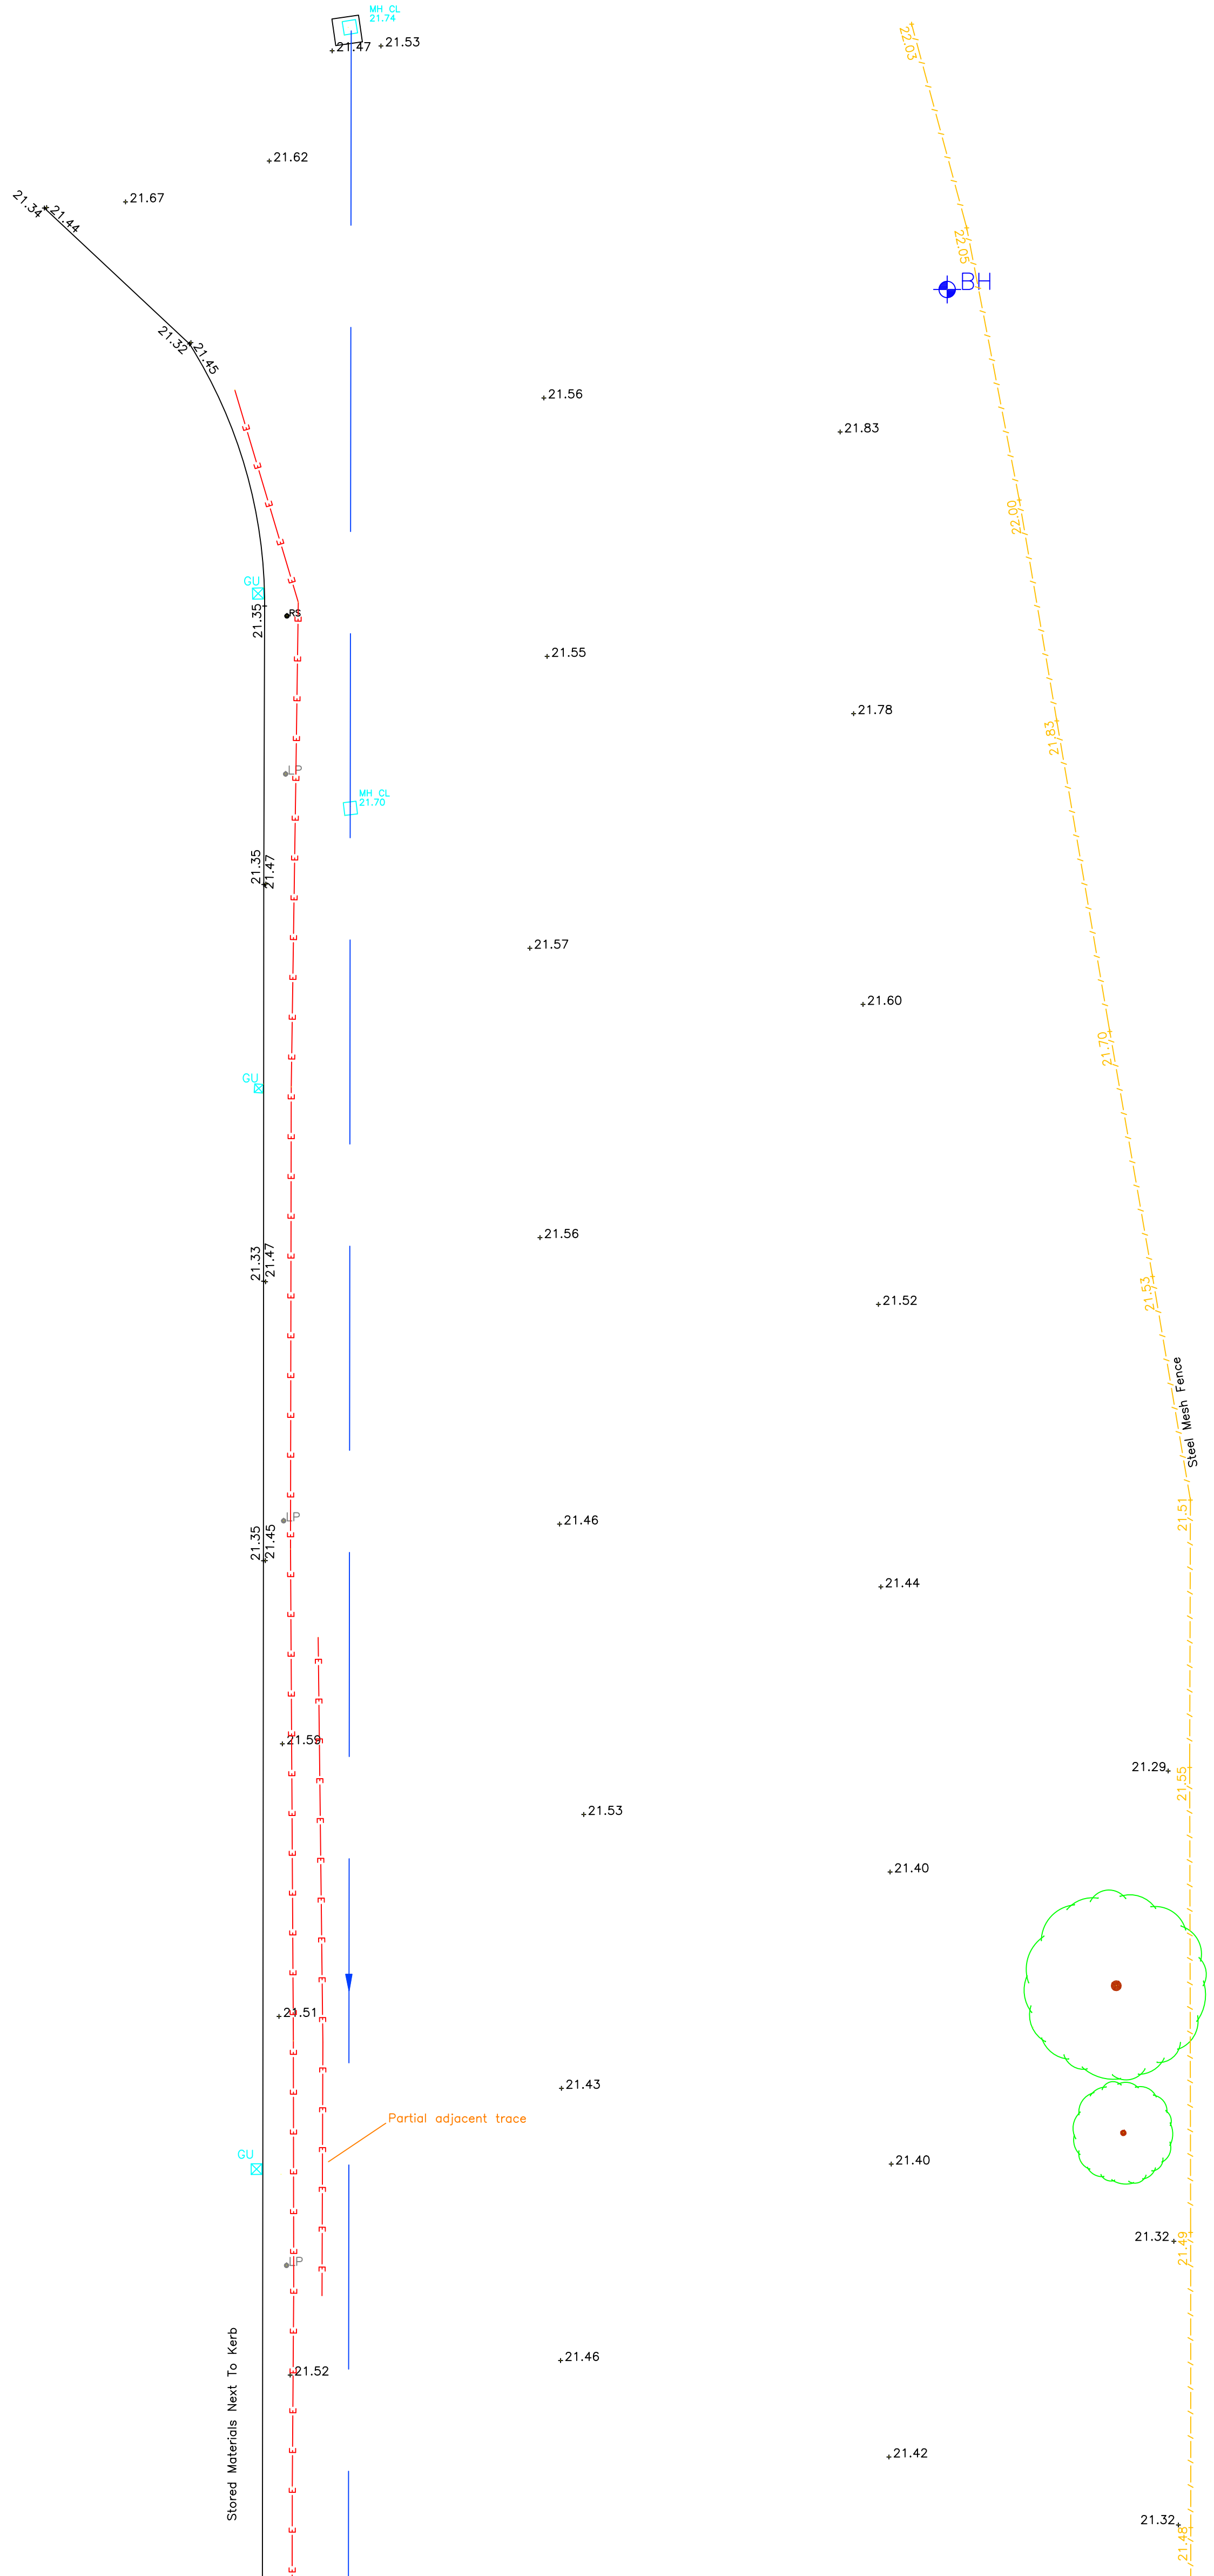


Abbreviations:			
AR	Assumed Route	IL	Invert Level
BOL	Bollard	LP	Lamp Post
BrS	Bridge Support	Mrk	Marker
BH	Borehole	MH	Manhole
BT	British Telecom Cover	OSA	Off Survey Area
CG	Cattle Grid	RL	Ridge Level
CL	Cover Level	RS	Road Sign
Conc	Concrete	RWP	Rain Water Pipe
EC	Electricity Cover	SV	Stop Valve
EL	Eaves Level	ST	Stop Top
EOT	End of Trace	TFR	Taken From Records
Gu	Gully	TOW	Top of Wall Level
IC	Inspection Cover	TP	Telegraph Pole
		VP	Vent Pipe

Legend:	
Bank	Drop Kerb/ Surface Boundary
Tree/Shrub Canopy	Level Position
Fence	Survey Station
Wall	Tree
Retaining Wall	Gate
Building	Tree Position
Hedge	Gully
Contours 0.5m	

Foul Drainage	British Telecom
Surface Drainage	Compressed Air
Combined Drainage	Offset Fill-Line
Electricity	Pipe
High Voltage Electricity	Ventilation
Gas	Fuel Line
Ground Probing Radar	Vapour Recovery
Water	Gauge Line
Cable Television	Telemetry
Close Circuit Television	Unknown

A single line indicating a utility may indicate the presence of multiple services within close proximity to each other. Where a single line type is shown we recommend hand digging within 0.5m to expose hidden services.

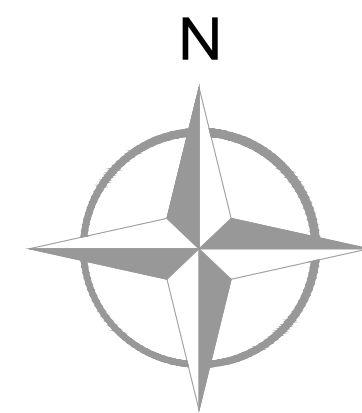

OS Note:
If indicated below, this survey has been orientated to the Ordnance Survey (O.S.) National Grid (OSGB36) via Global Navigational Satellite Systems (GNSS) and the O.S. Active Network (OS Net). A true OSGB36 coordinate has been established near to the site centre via a transformation using the OSN15 & OSGM15 transformation models.
The survey has been correlated to this point and a further one or more OSGB36 points established to create a true O.S. bearing for angle orientation.
No scale factor has been applied to the survey therefore the coordinates shown are arbitrary & not true O.S. Coordinates which have a scale factor applied.

Visible features in the vicinity of boundaries as shown on this survey, may not represent the extent of legally conveyed ownership. Whilst every effort has been made to achieve accuracy on this plan, CRUCIAL clearance dimensions, levels & invert levels should be checked prior to design & construction.
Some services may have been omitted due to parked vehicles.

Title:
Topographic/Utility Survey
Ford Halewood
Speke Boulevard
Liverpool


Drawing No: 10440_A0-5
File No: IS/0423/10440/OS6

Levels: Relative to Ordnance Datum
Grid: Newlyn, Cornwall
OSN15

Client:
On Site Energy

Scale: 1:200@A0	Date: 25/04/2023
Sheet No. 5 of 5	Revision:
Surveyors: SH	Prepared By: SH
	Checked By: SC

EST.1989

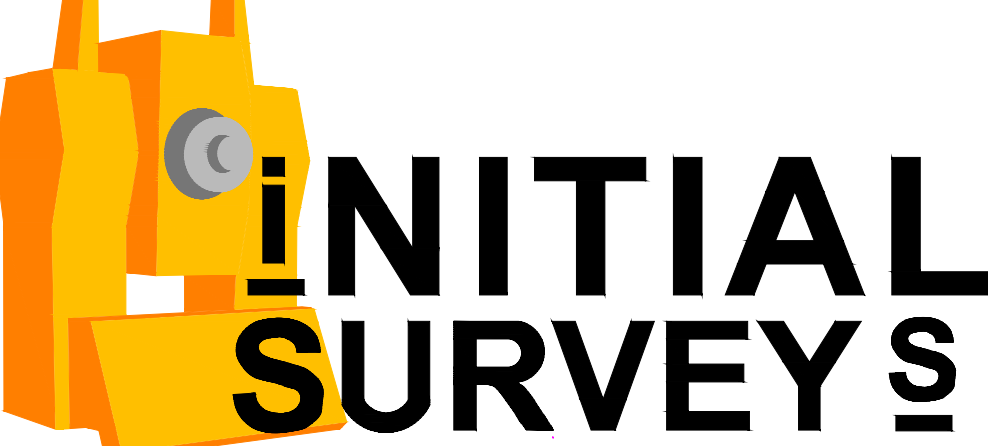

21 Longacre Close, Holbrook Ind. Estate
Sheffield S21 3FR
Tel. 08456 125666 Fax. 08456 125667
Mobile 07831 145199
Email office@initialandsurveys.co.uk
www.initialandsurveys.co.uk

DISCLAIMER: The location of under ground services shown on this drawing has been determined using electro-magnetic (and/or ground probing radar, where requested) techniques and visual observations. The limitations of this drawing should be realised and no guarantee can be given that all services have been identified. This drawing may not include the location of all public services that may cross the site and therefore the relevant service drawings should be obtained from the appropriate utility company and used in conjunction with this drawing. Additional services, structures or other below ground obstructions not indicated on this drawing may be present on site. Reference should be made to historical plans and as built drawings. Excavations in the vicinity of services should be carried out with due diligence ref: HSG47 document "avoiding dangers from underground services". Location accuracy is determined by referring to manufacturers guidelines for the systems deployed. Reference should be made to the latest version of IS Ltd site procedures document for utility location surveys.