




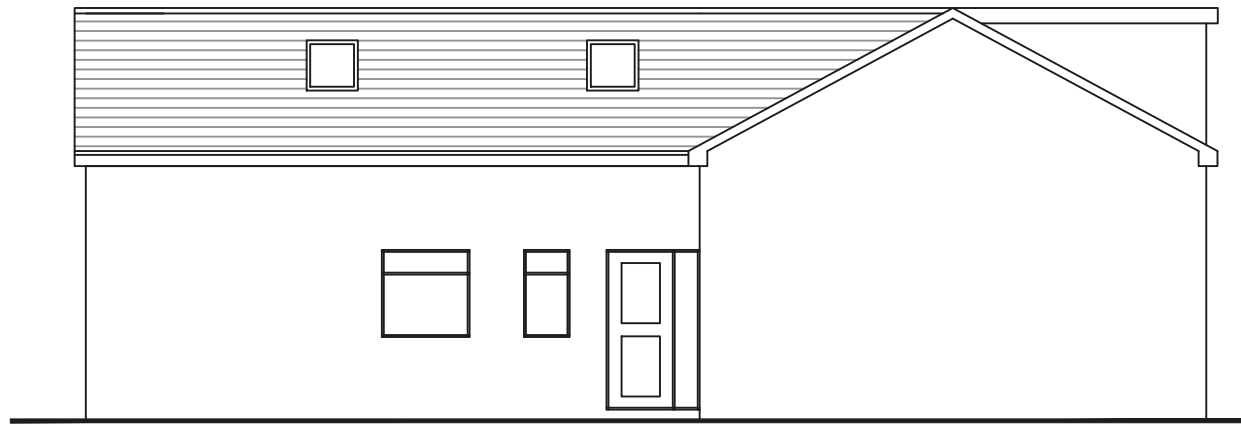


As-Built Side Elevation

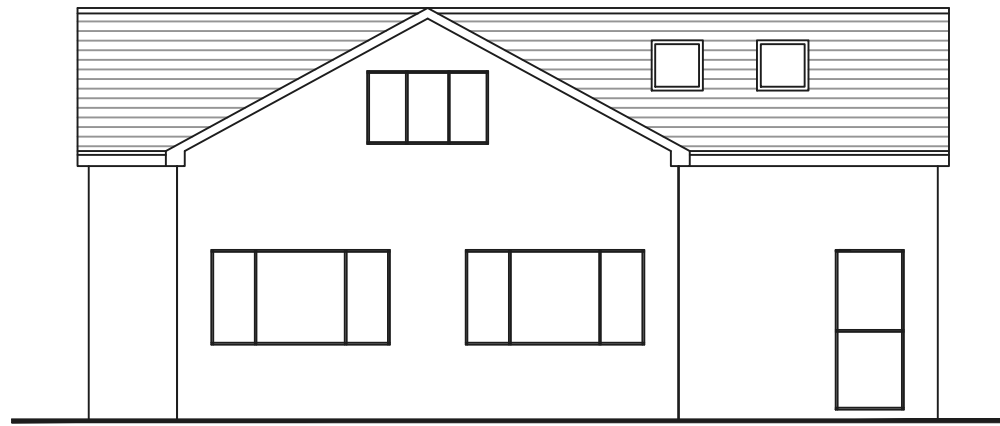


As-Built Front Elevation

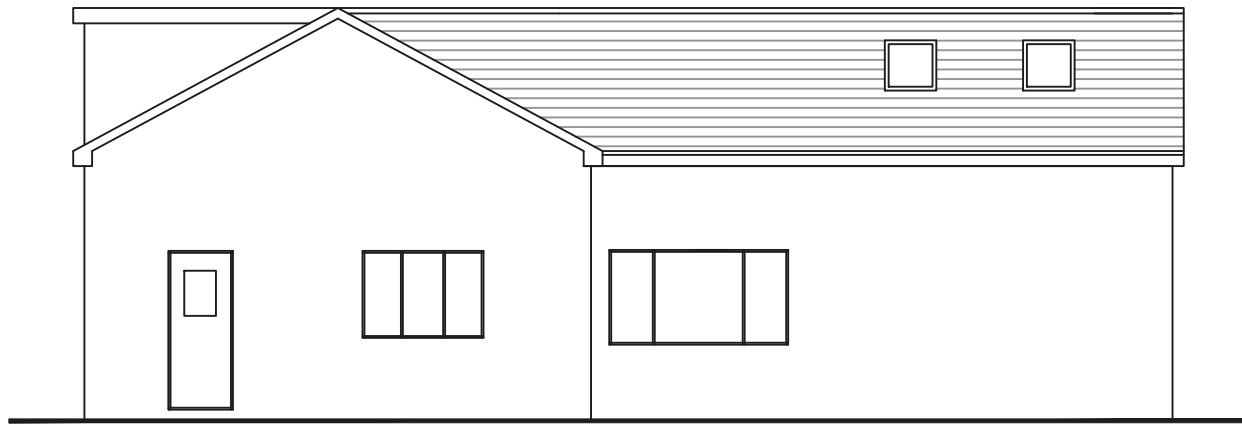


As-Built Side Elevation

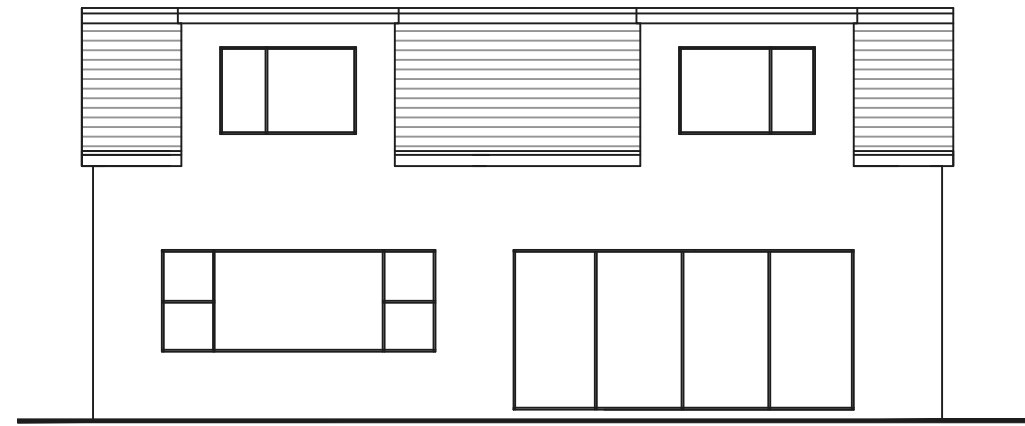

As-Built Rear Elevation

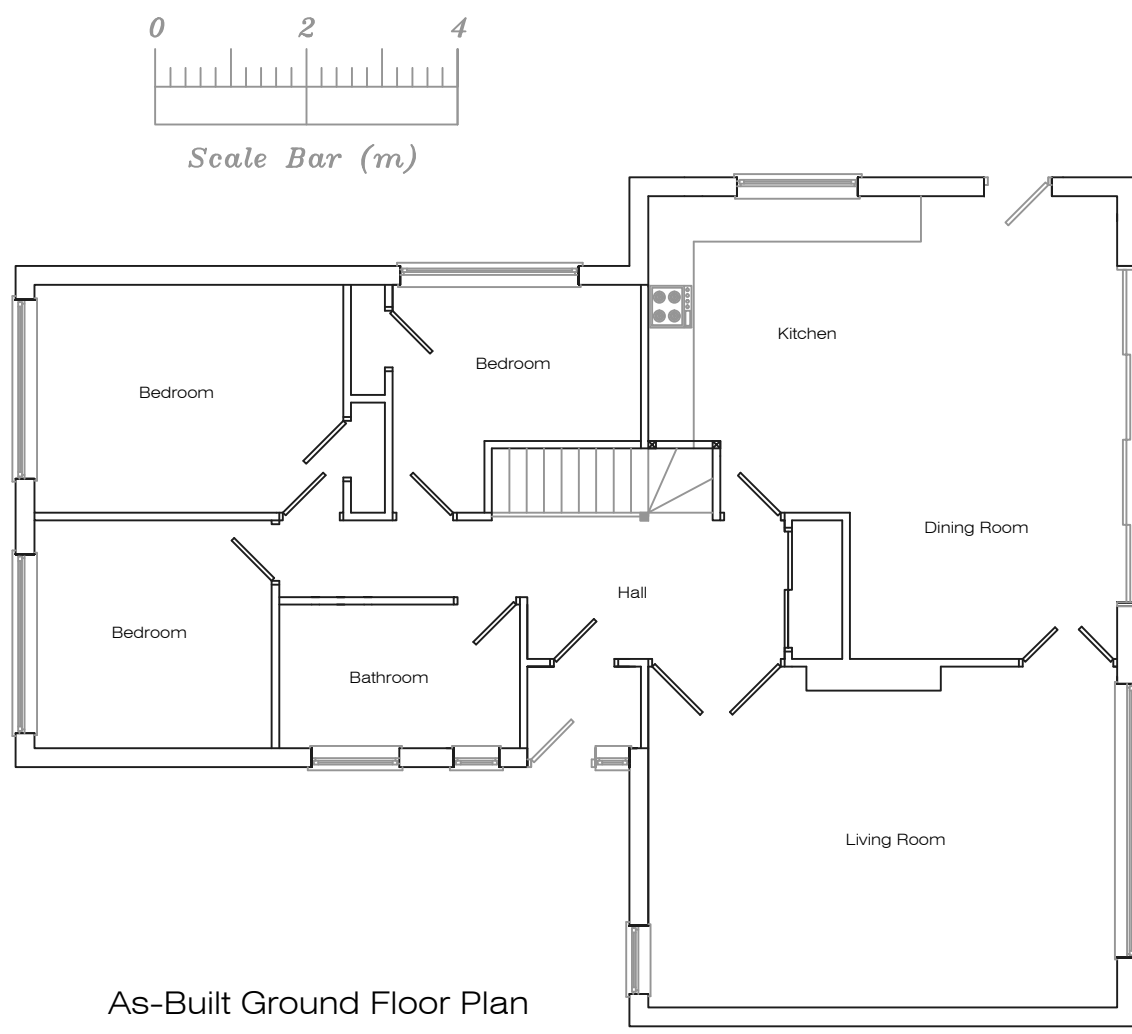

As-Built Ground Floor Plan

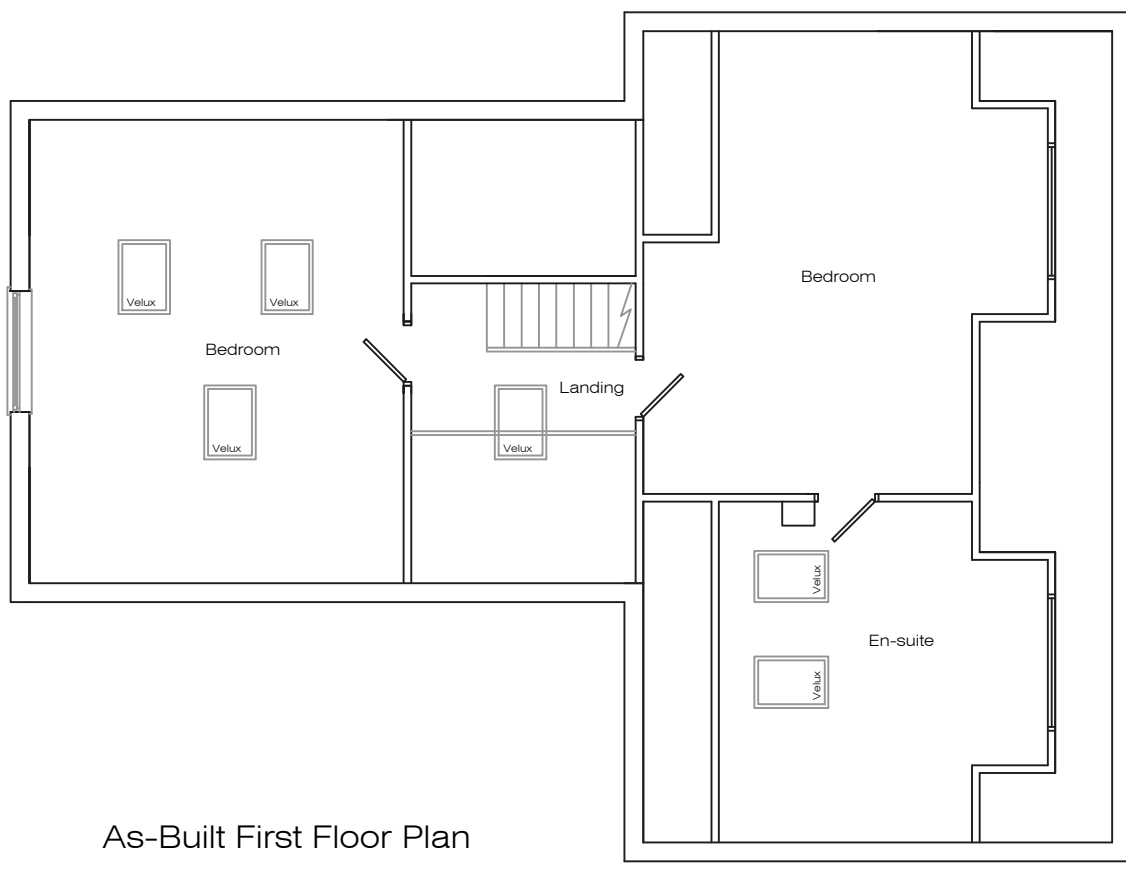

As-Built First Floor Plan

Address 13 Deerbolt Crescent, L32		
Job Title First floor extension with raising of roof and rear dormers		
Drawing title As-Built Plans		
date May '24	scale 1:100 @ A1	Dwg No. 001