


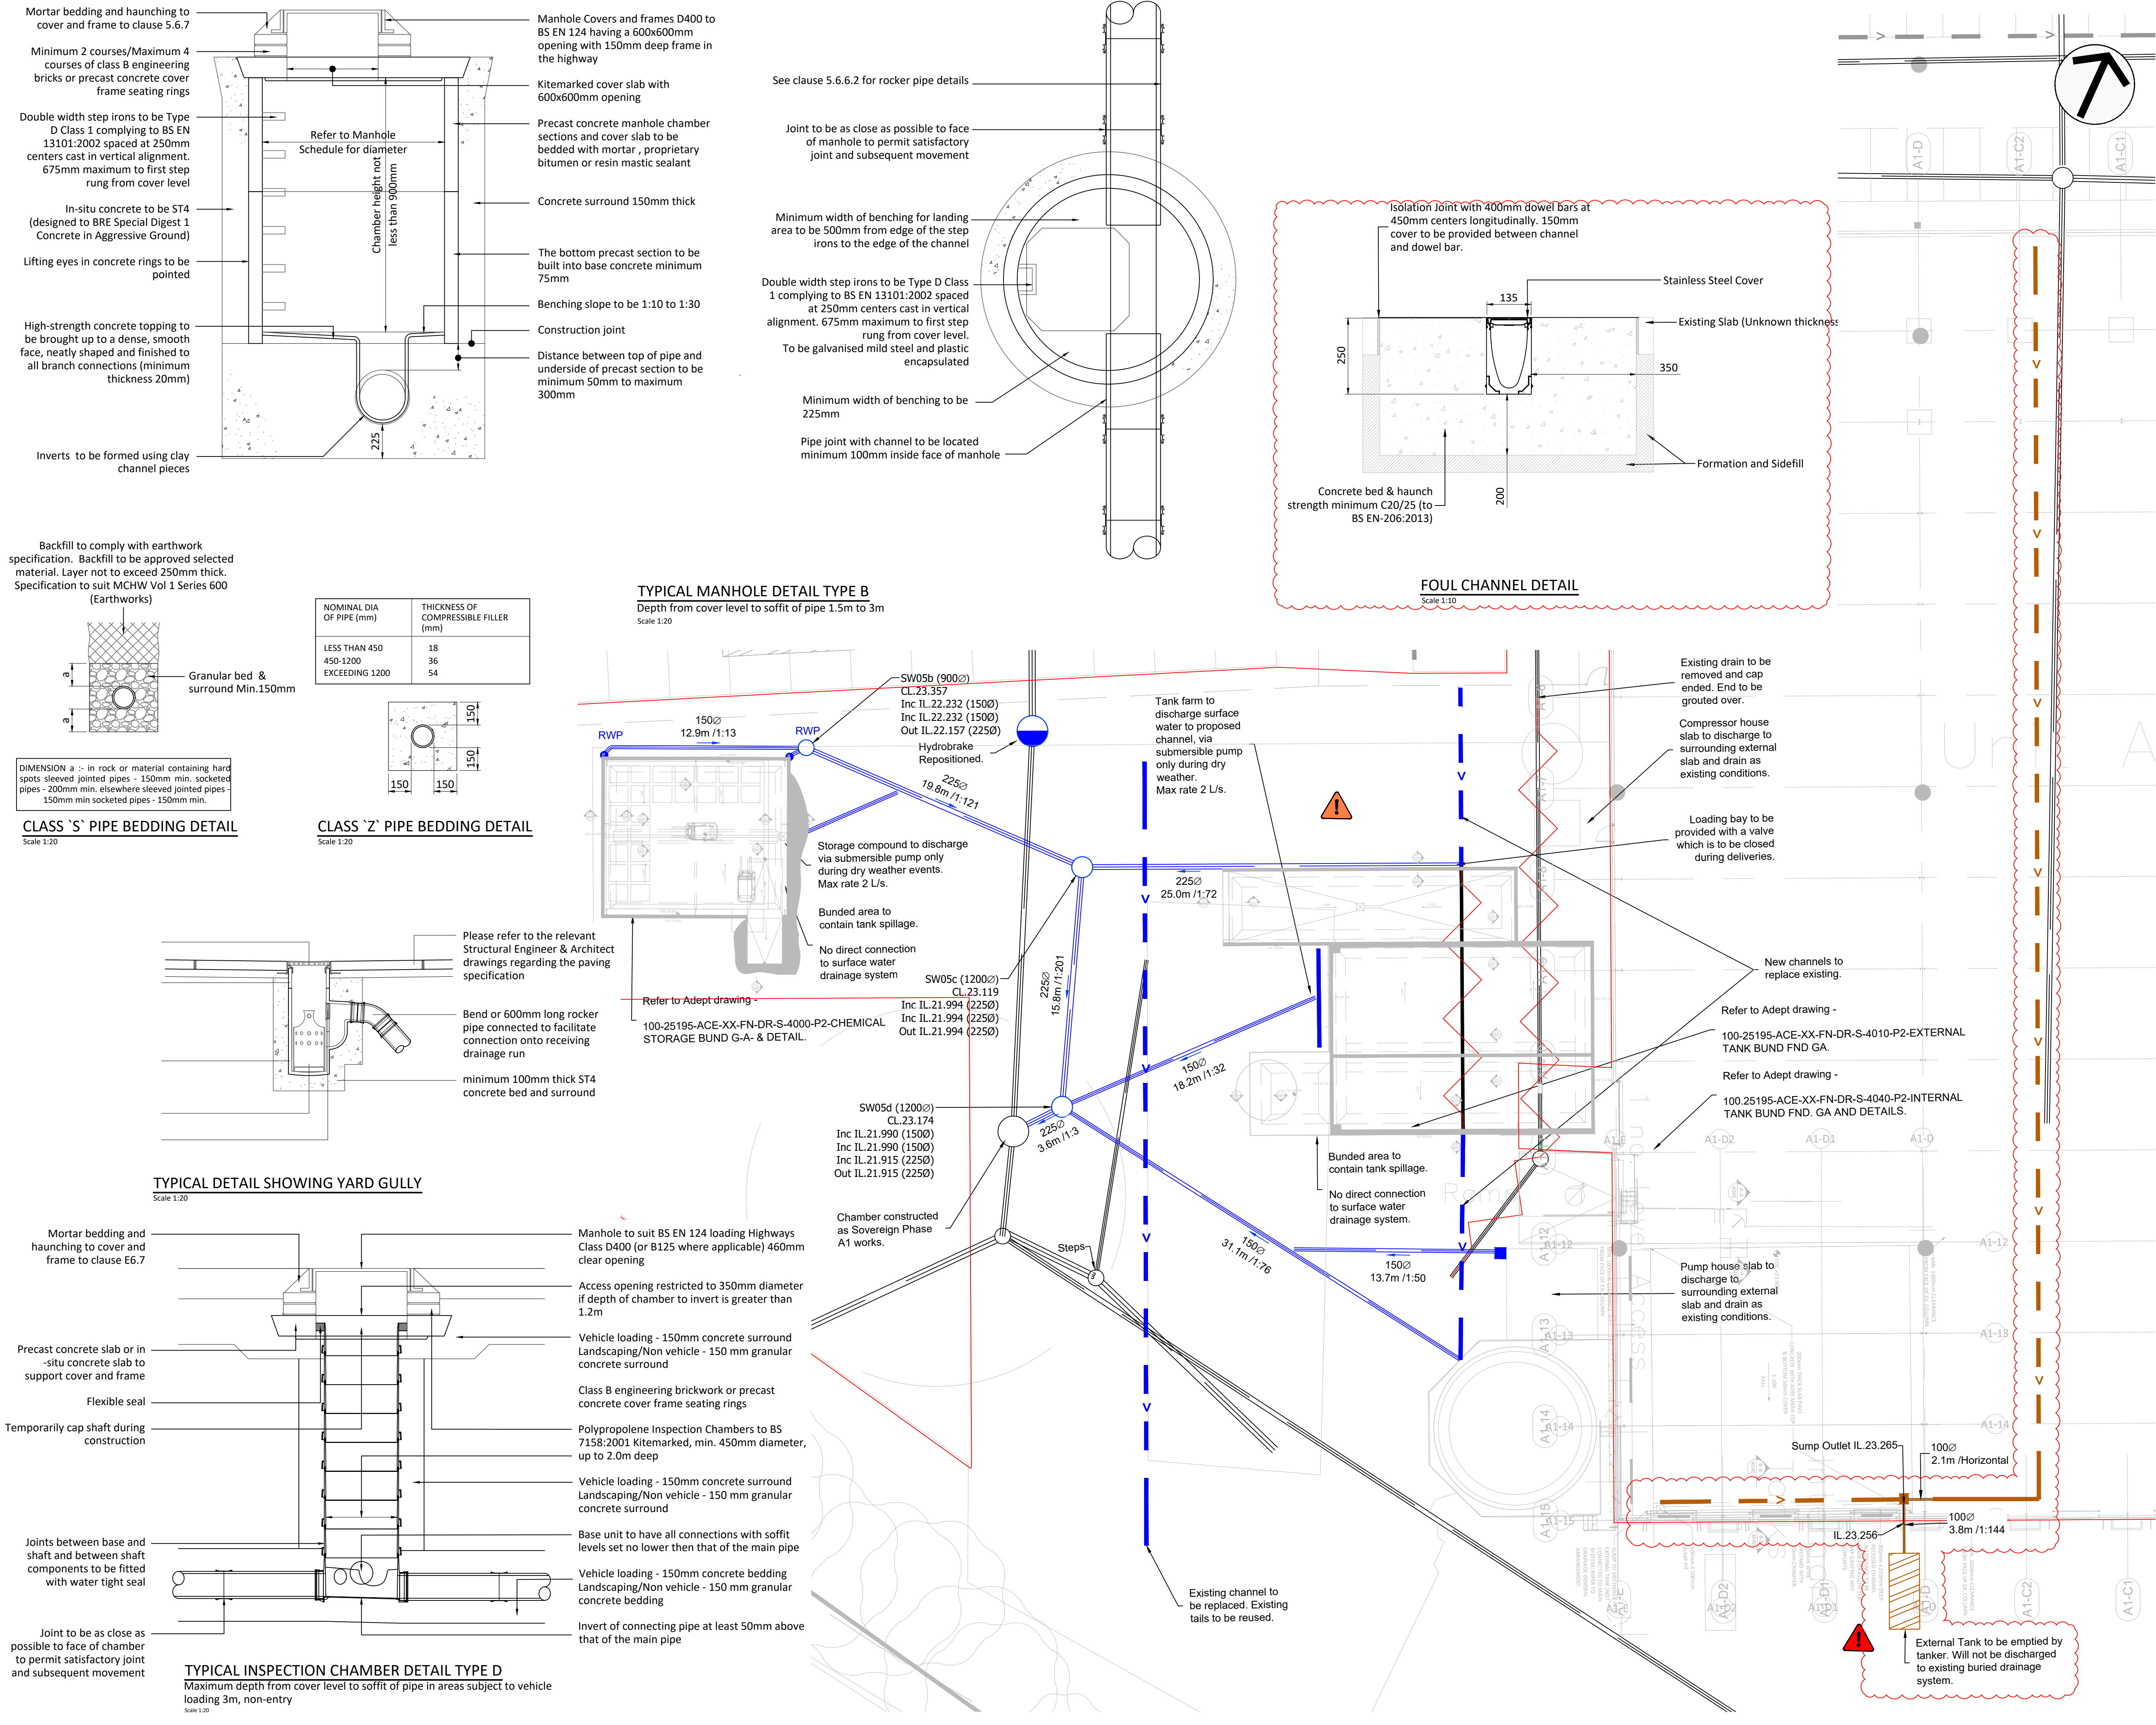

Do Not Scale

Drawing Notes

Drawing & schedule based on the following information:
Architect's drawing/model: **AJA Architects - Site Plan - 7182-401- Rev C01**
Revision: **REV C01**
Received: -
Topographic Survey: -
Revision: -
Received: -

Health, Safety & Environmental Notes

⚠

Depicts Low Residual Risk

⚠

Depicts Medium Residual Risk

⚠

Depicts High Residual Risk

Refer to Designer's Risk Assessment for Control Measures

Key:

○

Proposed Surface Water Network

●

Proposed Foul Water Network

■

Proposed Gully

■

Wash Down Gully

□

Proposed Oil Interceptor

≡

Existing Sewer Combined Network

○

Existing Sewer Surface Network

●

Existing Private Surface Network

≡

Existing Culvert

●

Adept Site Survey RWP Position (Full connectivity not known)

Hauraton M100D 20.0 Channel Drain

Monotec Type 450 Channel Drain

●

Flow Control Chamber

~~~~~

Drain To Be Removed

▨

Proposed FW Tank

General Notes:

1) Drainage layout is shown indicative and is subject to planning to confirm SW strategy.

2) Surface water strategy does not increase the impermeable area proposed as part of the wider site planning application - already approved.

3) Drainage for the wider site assumed as constructed for these plans

4) Surface water discharge does not increase.

5) Drainage to be removed entirely where possible. If not removed entirely then pipework to be jet washed prior to filling with cement grout (class G3 1:10 cement sand using the minimum quantity of water to ensure necessary fluidity and to render a capable of penetrating the pipe. Cement shall be used within 1 hour of mixing plug and with concrete plug brought up to a smooth dense finish with retained manholes.

6) All pipes to be HDPE.

7) All drainage works to be carried out in accordance with Sewer Sector Guidance British Standards and building Regulations.

8) All connections to private drains. No S106 required.

10) Coordination required with existing building foundations.

|          |                           |    |    |     |
|----------|---------------------------|----|----|-----|
| 10.03.26 | New Channel Internally    | AH | RR | P03 |
| 25.02.26 | Updated WPL Comments      | AH | RR | P02 |
| 20.01.26 | Unit A1 Internal Drainage | AH | RR | P01 |

| Date | Description | By | Chk | Rev |
|------|-------------|----|-----|-----|
|      |             |    |     |     |

ADEPT

Web

www.adeptcsce.com

Email

inbox@adeptcsce.com

Tel

0161 974 0291

Office Address

7 St James Square, 4th Floor, Manchester, M2 6DN

Project

Sovereign Phase 2, Unit A1 Tenant

Title

Proposed Drainage

Client

Barnfeild

|                                                                                  |                     |                                |             |                      |
|----------------------------------------------------------------------------------|---------------------|--------------------------------|-------------|----------------------|
| Scale @ A1 1:200                                                                 | Initial author AH   | Initial checker RR             | Approver NB | Initial Date Jan '26 |
| Status S1                                                                        | Purpose Preliminary | Adept Project Number 100.25195 |             |                      |
| Project Originator-Functional Breakdown-Spatial Breakdown-Form-Discipline-Number |                     |                                |             | Rev.                 |
| 100.25195-ACE-ZZ-ZZ-DR-C-1008                                                    |                     |                                |             | P03                  |