
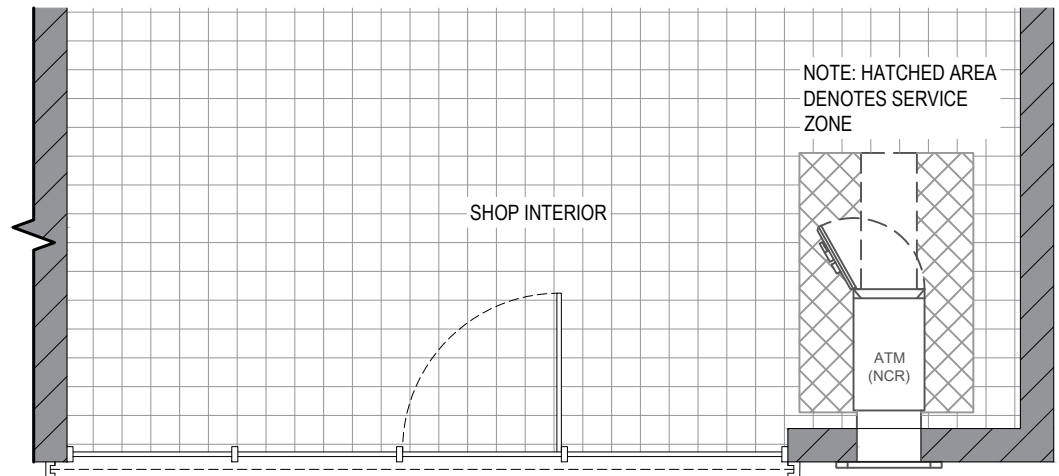


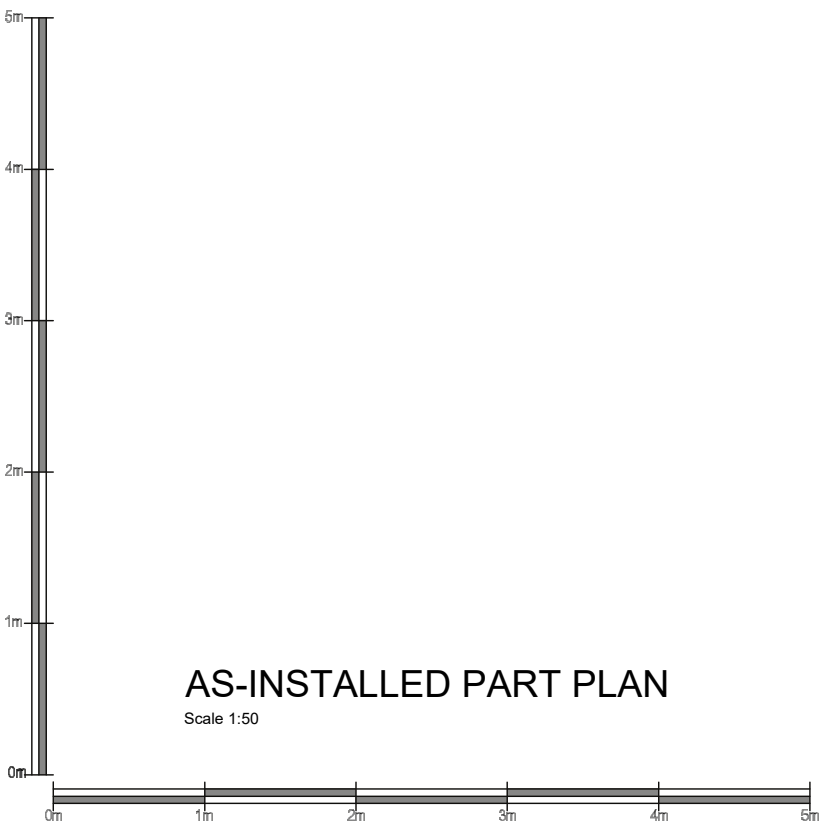

Date: Comments: By:

GENERAL NOTES:
1) All dimensions in millimeters unless otherwise stated.

Site:
Adisco Convenience,
90 PAGE MOSS LANE,
LIVERPOOL,
L14 0LX

Drawing Title:
As-Installed Plan and Elevation

Ref: T020761_AI	Date: 10/01/2022	Rev:
Scale: 1:50	Paper: A3	Date Rev: