



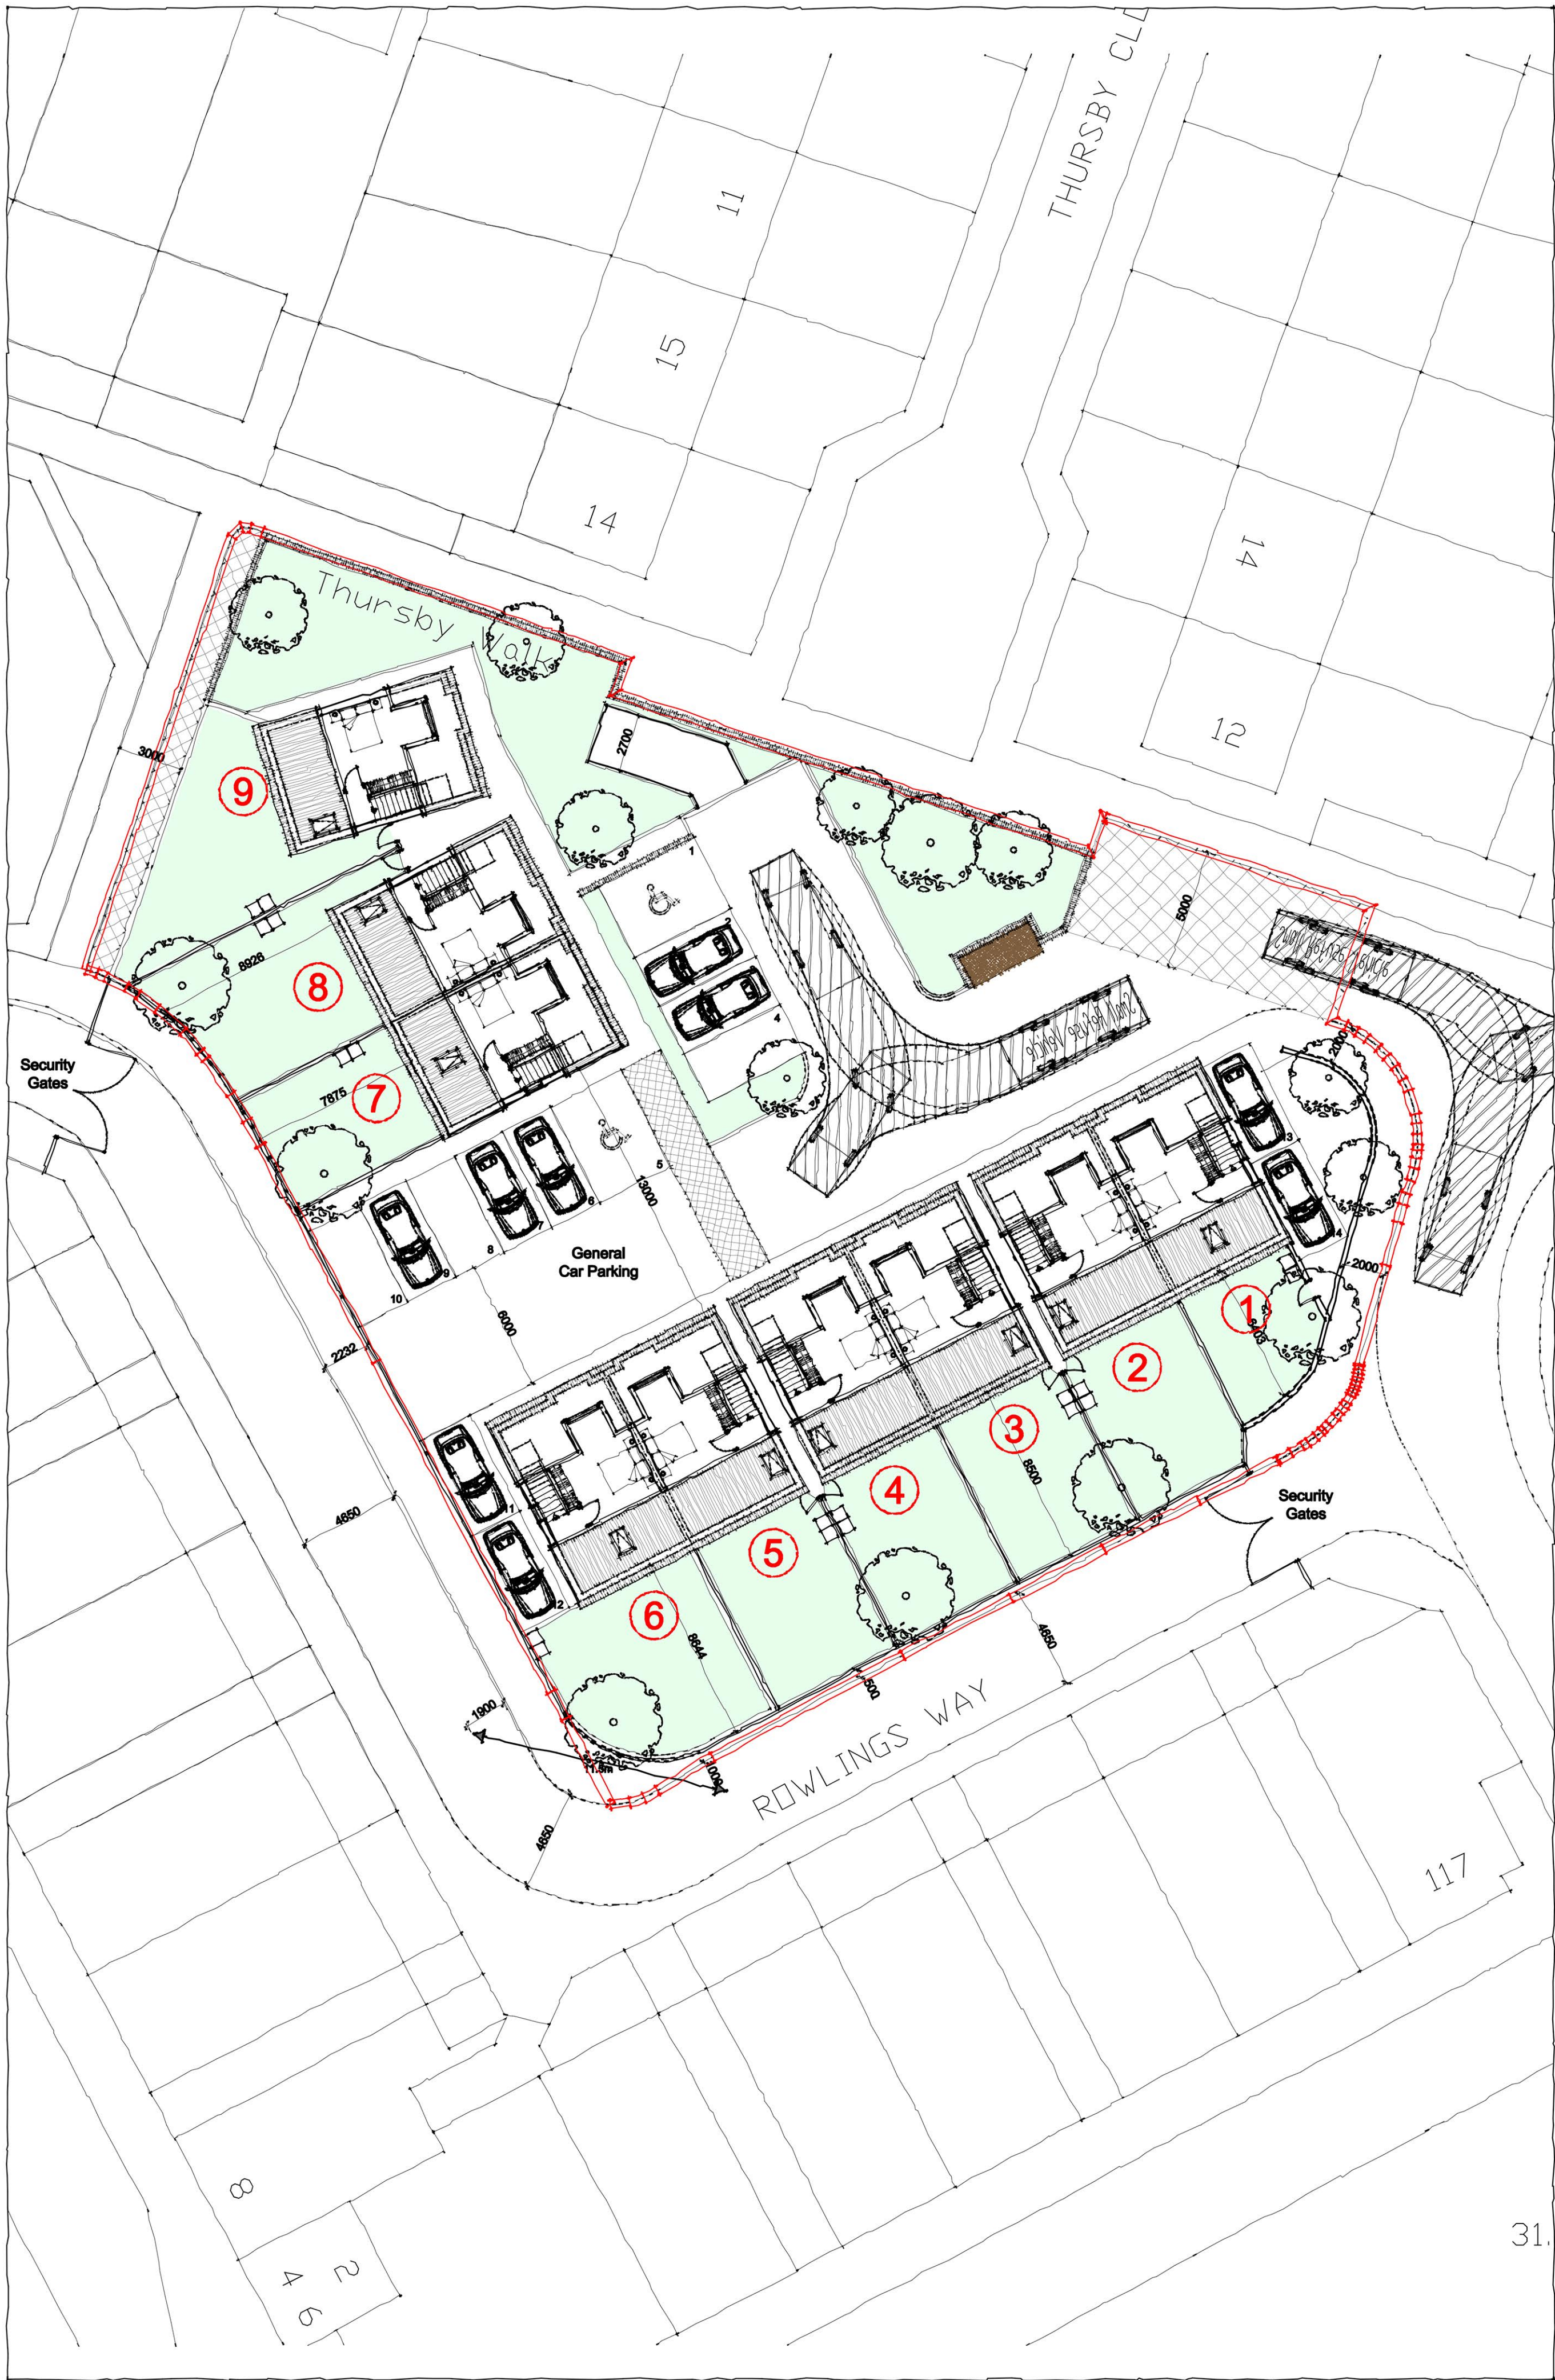

Approved Site Plan - FIRST FLOOR
Scale 1:200

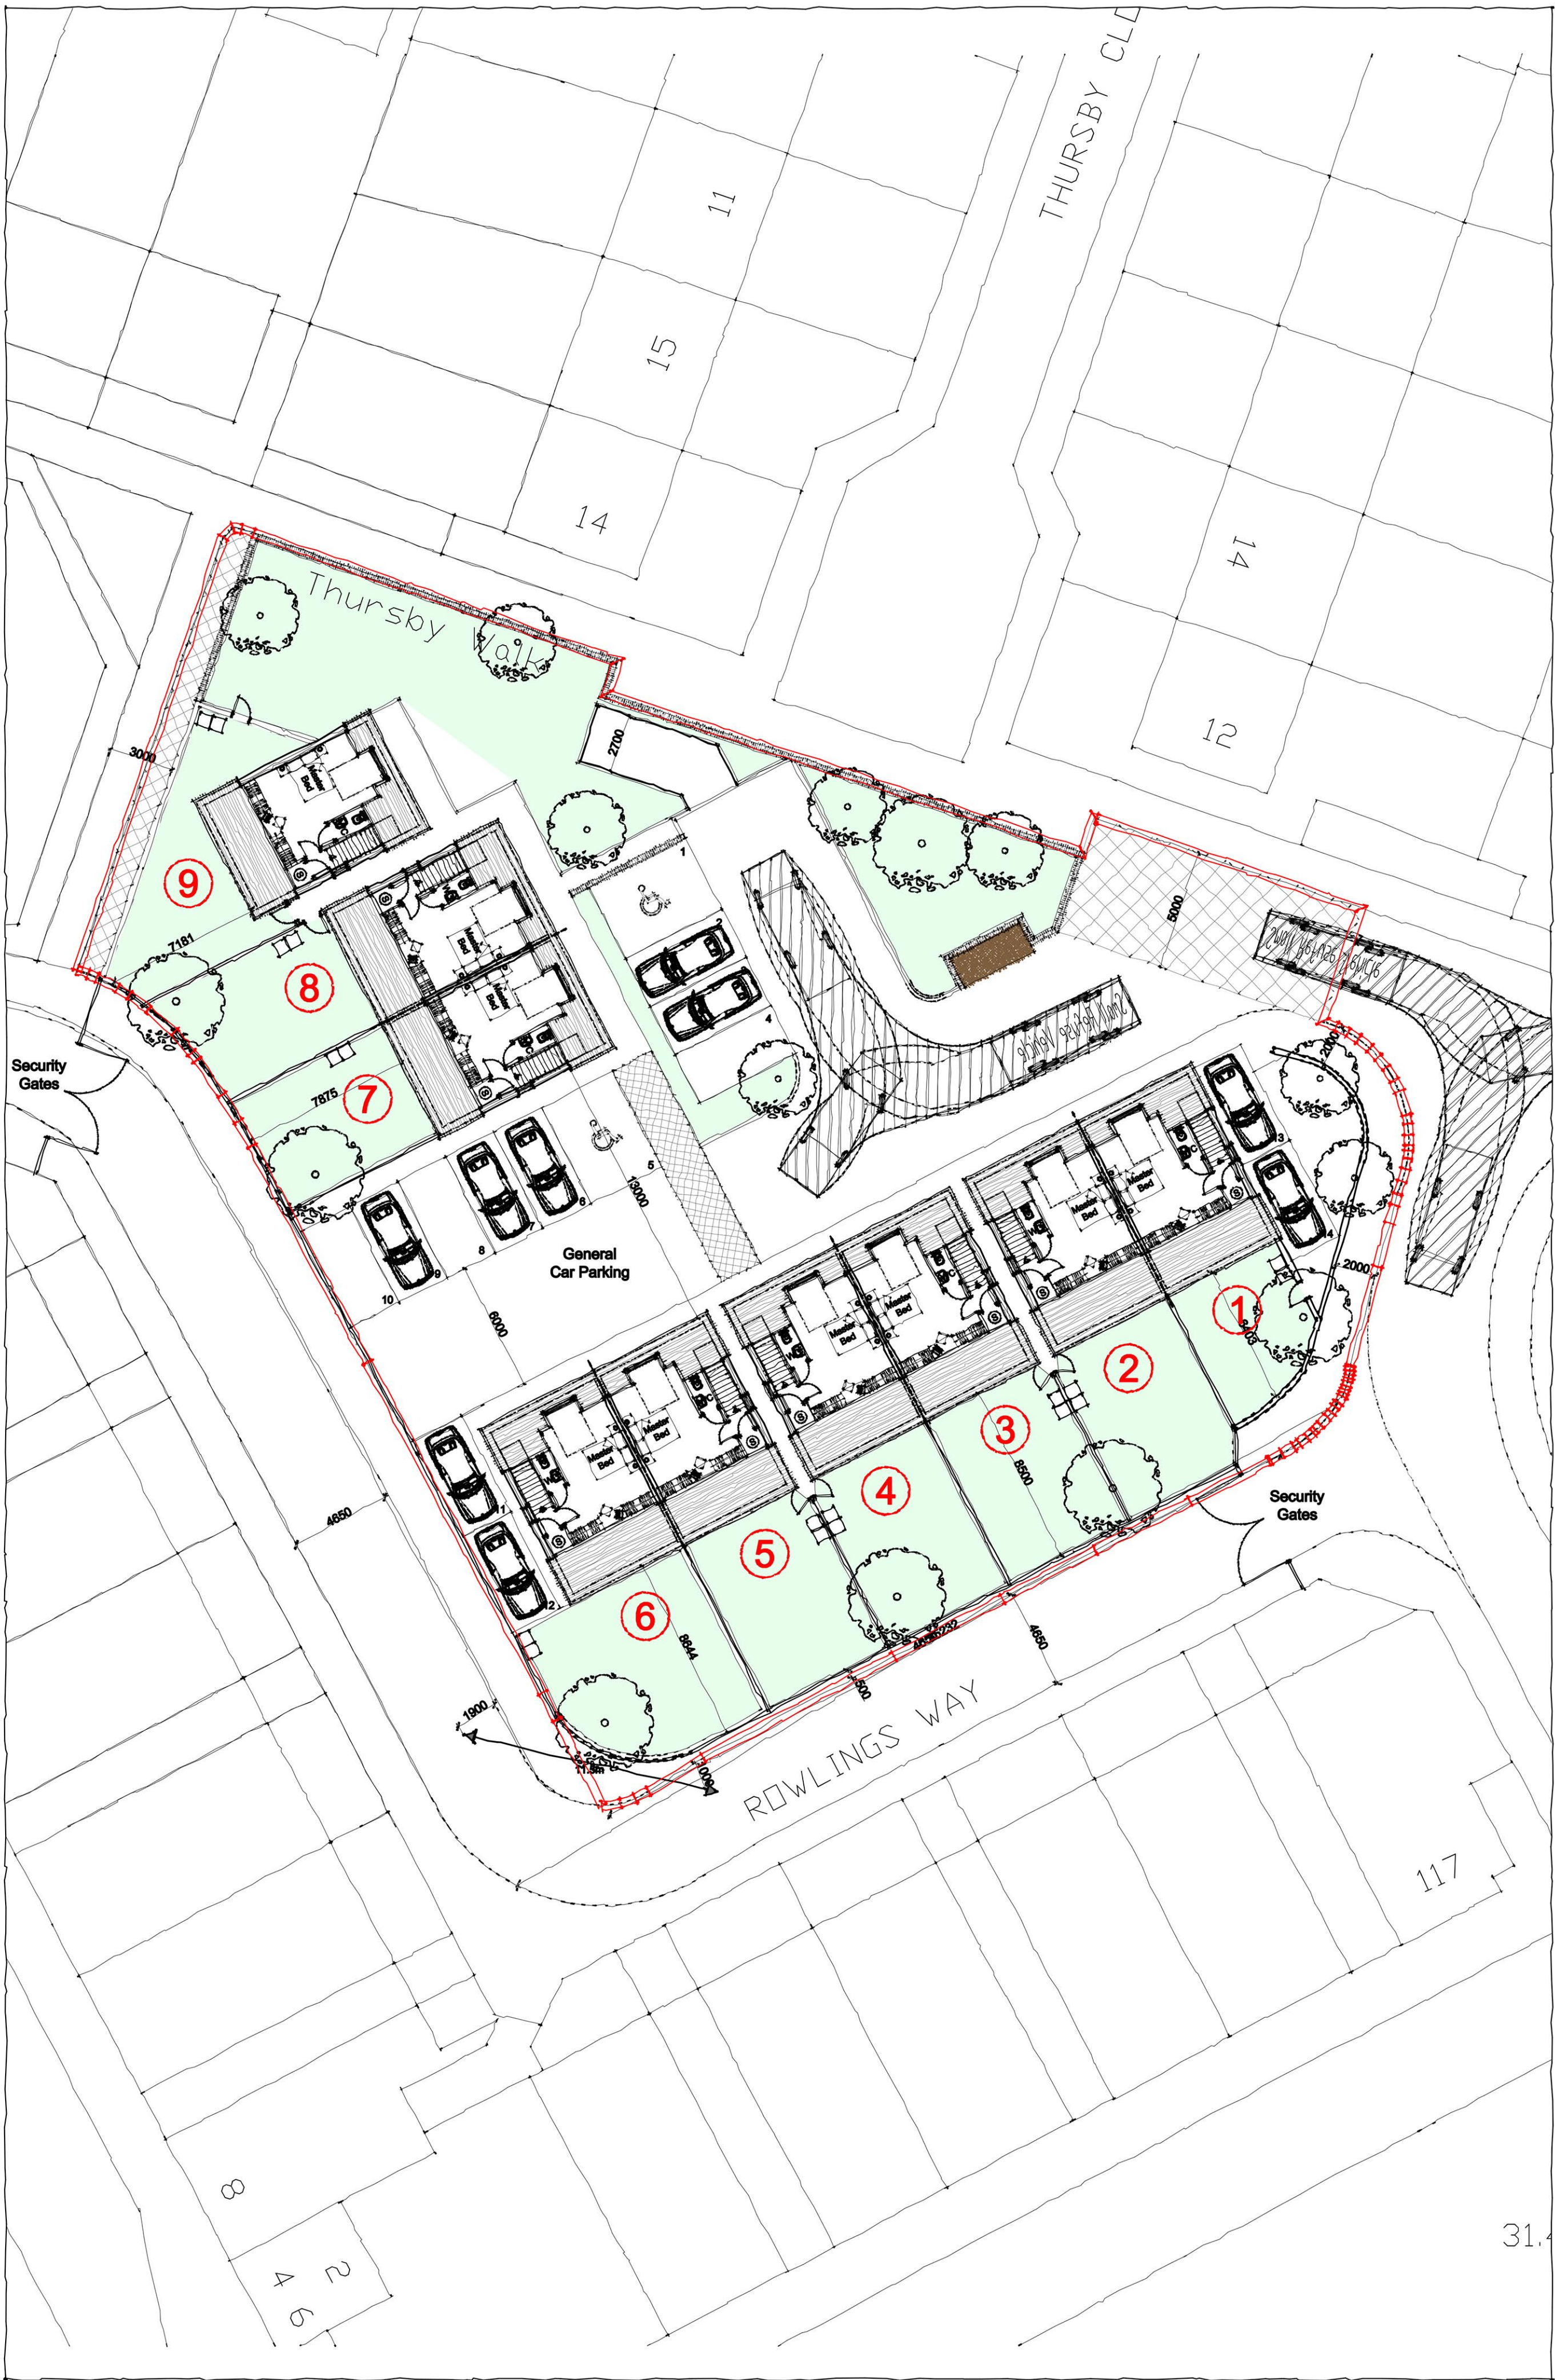

As-Built Site Plan - FIRST FLOOR
Scale 1:200

NOTES
All dimensions to be checked on site. Figured dimensions to be read in preference to scaled. Architect accepts no responsibility for any unauthorised amendments to the drawing and does not permit unauthorised copying of the drawing. This drawing is copyright and remains the property of Architect unless otherwise agreed.



1:200 Scale Bar
0 5 10 METRES



Photo 1 - Side View from Unit 8



Photo 2 - End Gable of Unit 9



Photo 3 - Front View of Unit 8 & 9



Photo 4 - Corner View of Unit 9

Version	Amendment	Drawn & Date	Checked & Date	Approved & Date
Client	TBC			
Project Name	9 No. Retirement Bungalows, Thursby Walk, Kirby			
Drawing Title	Approved & As-Built Site Plan - FIRST FLOOR			
Scale	Original Size	Planning		
1:200	A1	Drawn	Checked	Approved
Date	20.02.23			
Drawing Number	501			
				Status
				Revision