




BLOCK A (3 No. Units)

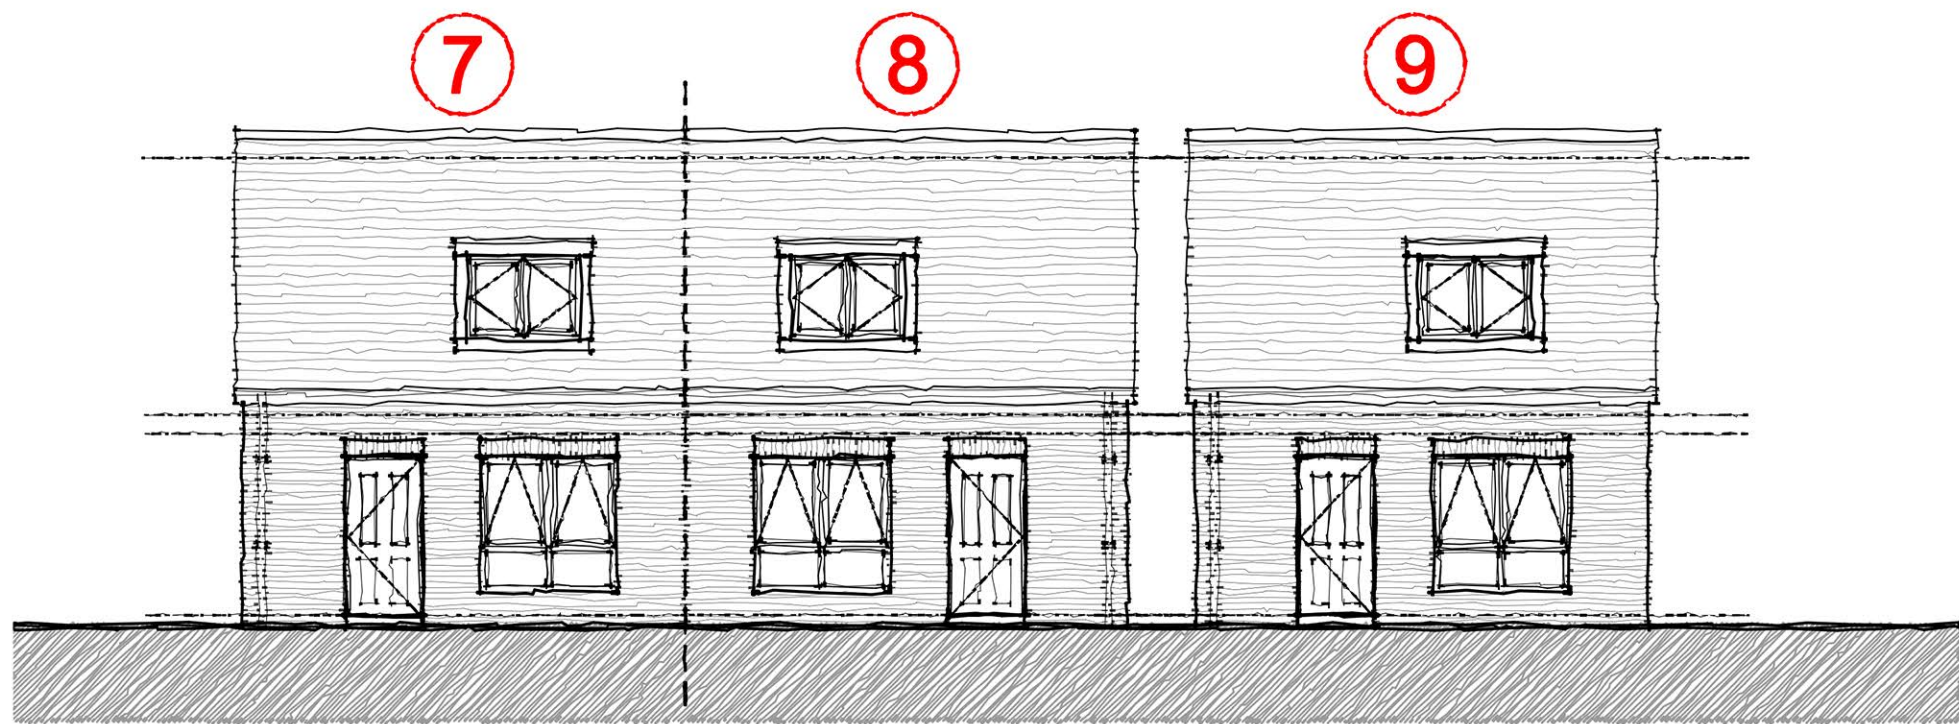


As-Built Front Elevation
Scale 1:100

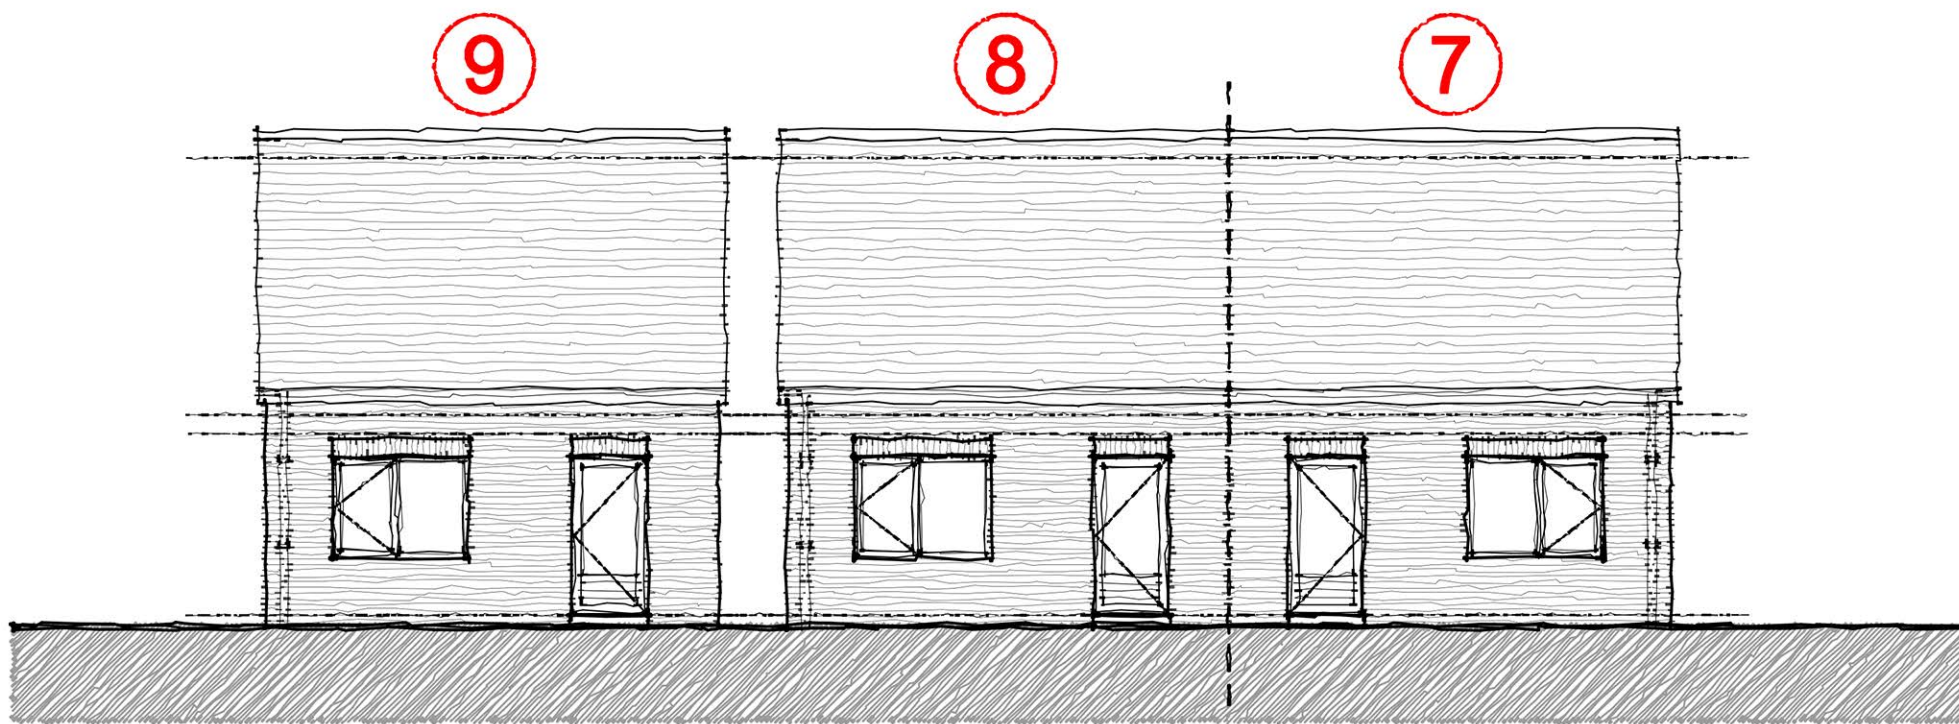


As-Built Rear Elevation
Scale 1:100

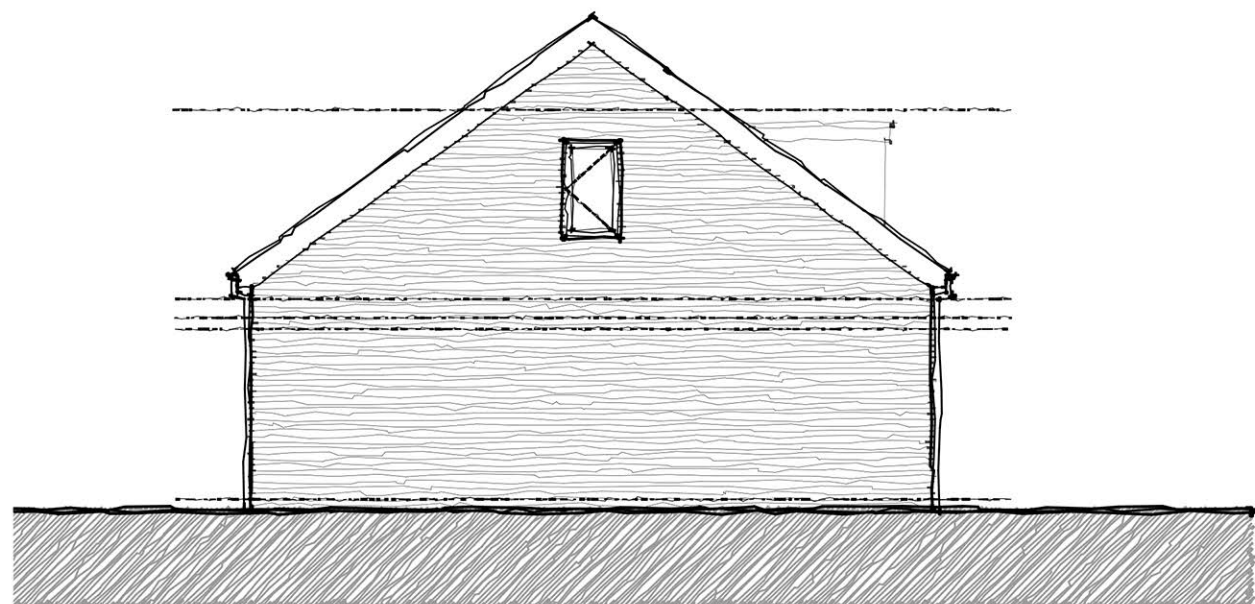

As-Built Side Elevation
Scale 1:100

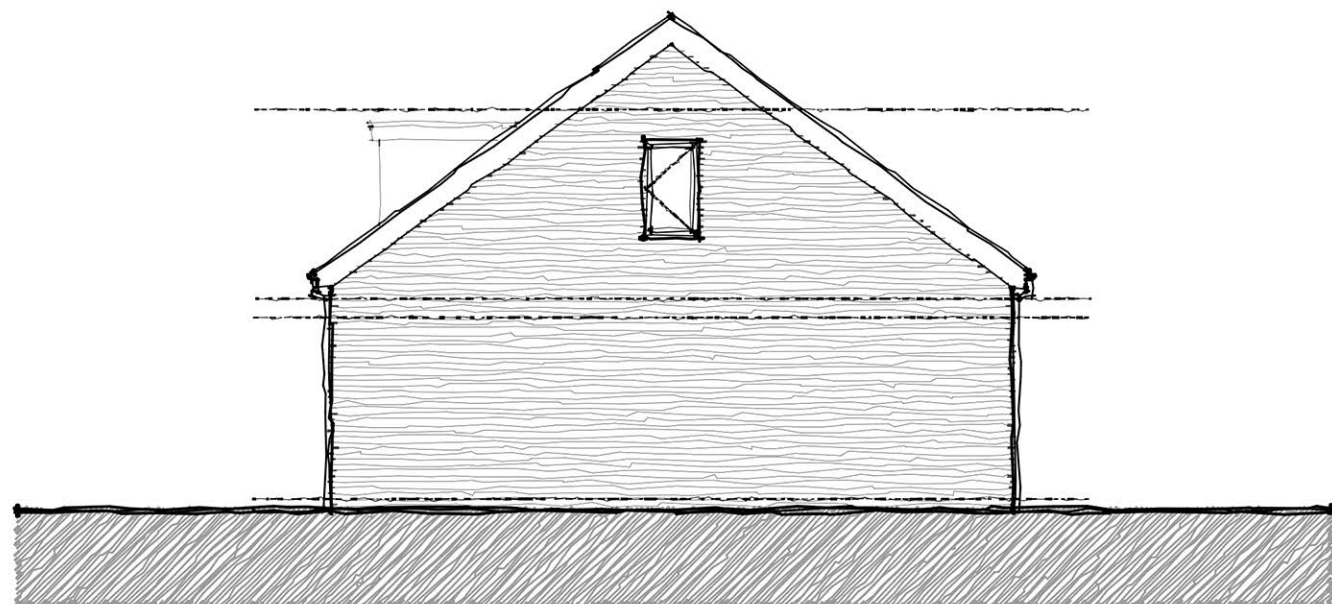


As-Built Side Elevation (Unit 2)
Scale 1:100

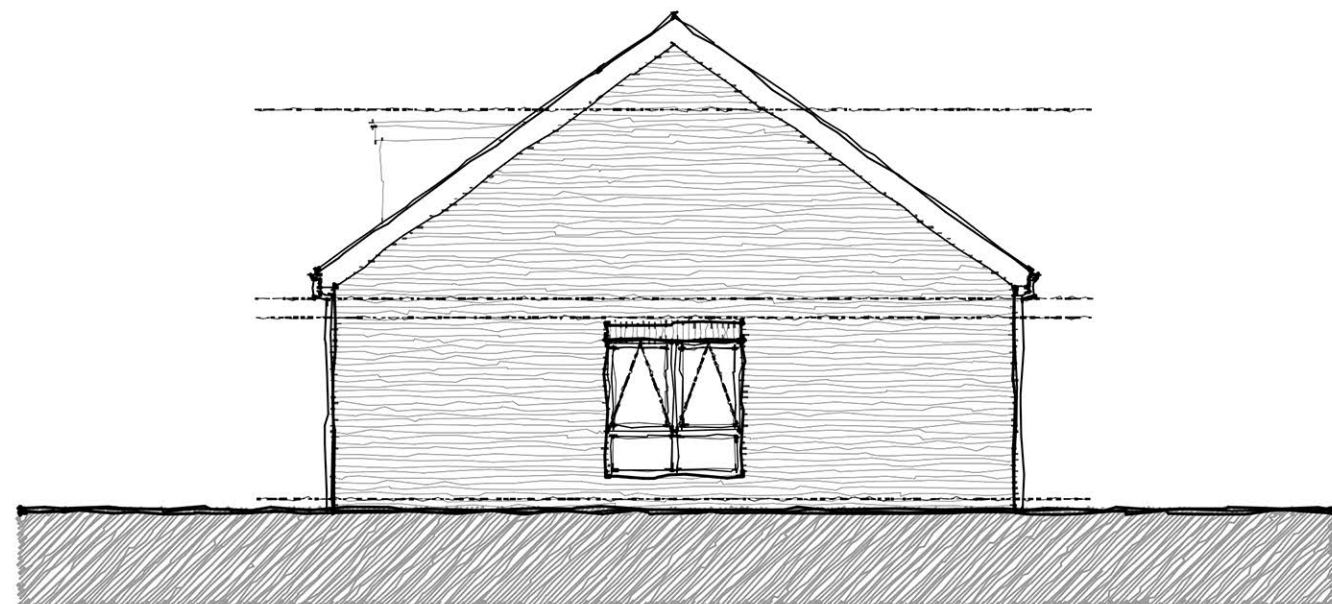


As-Built Side Elevation (Unit 1)
Scale 1:100


BLOCK B (6 No. Units)

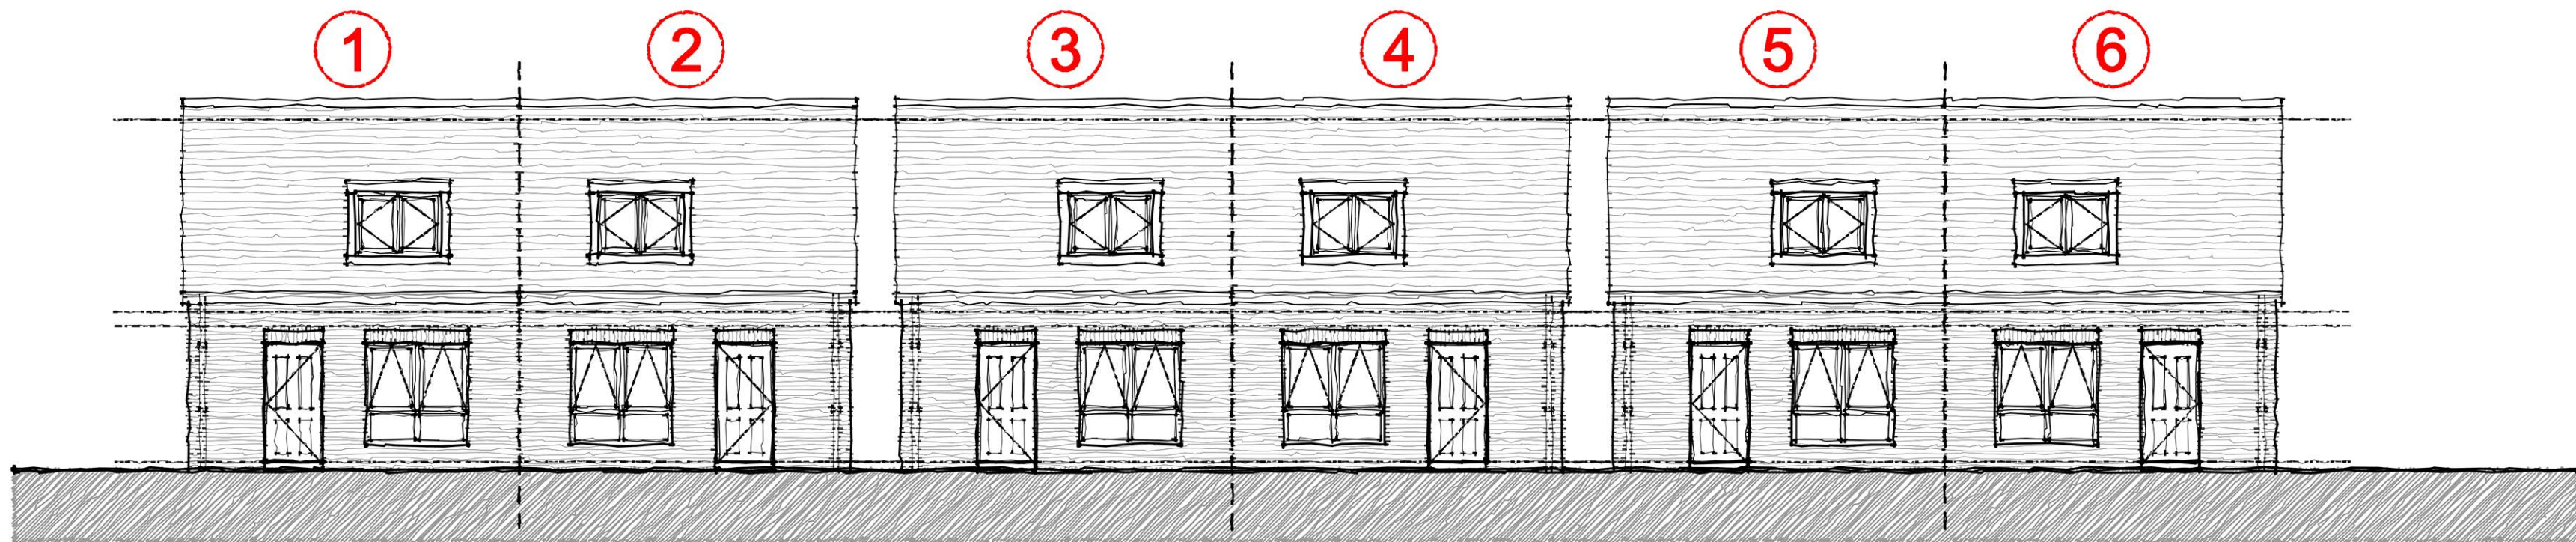


As-Built Front Elevation
Scale 1:100

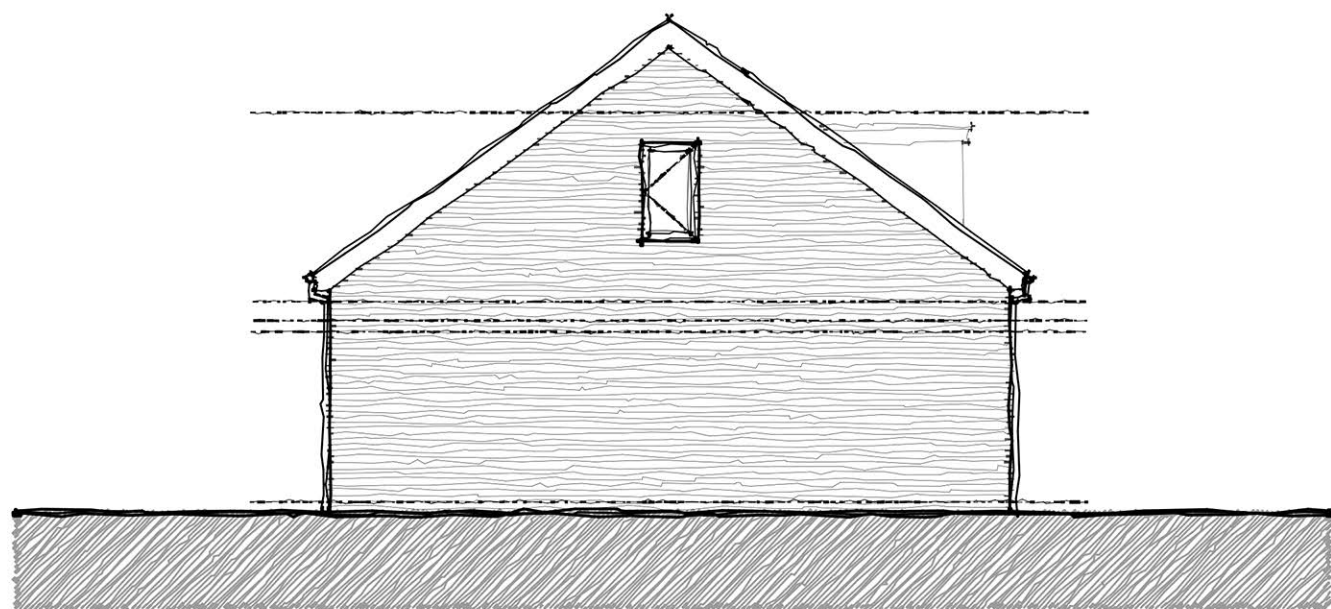

As-Built Side Elevation
Scale 1:100

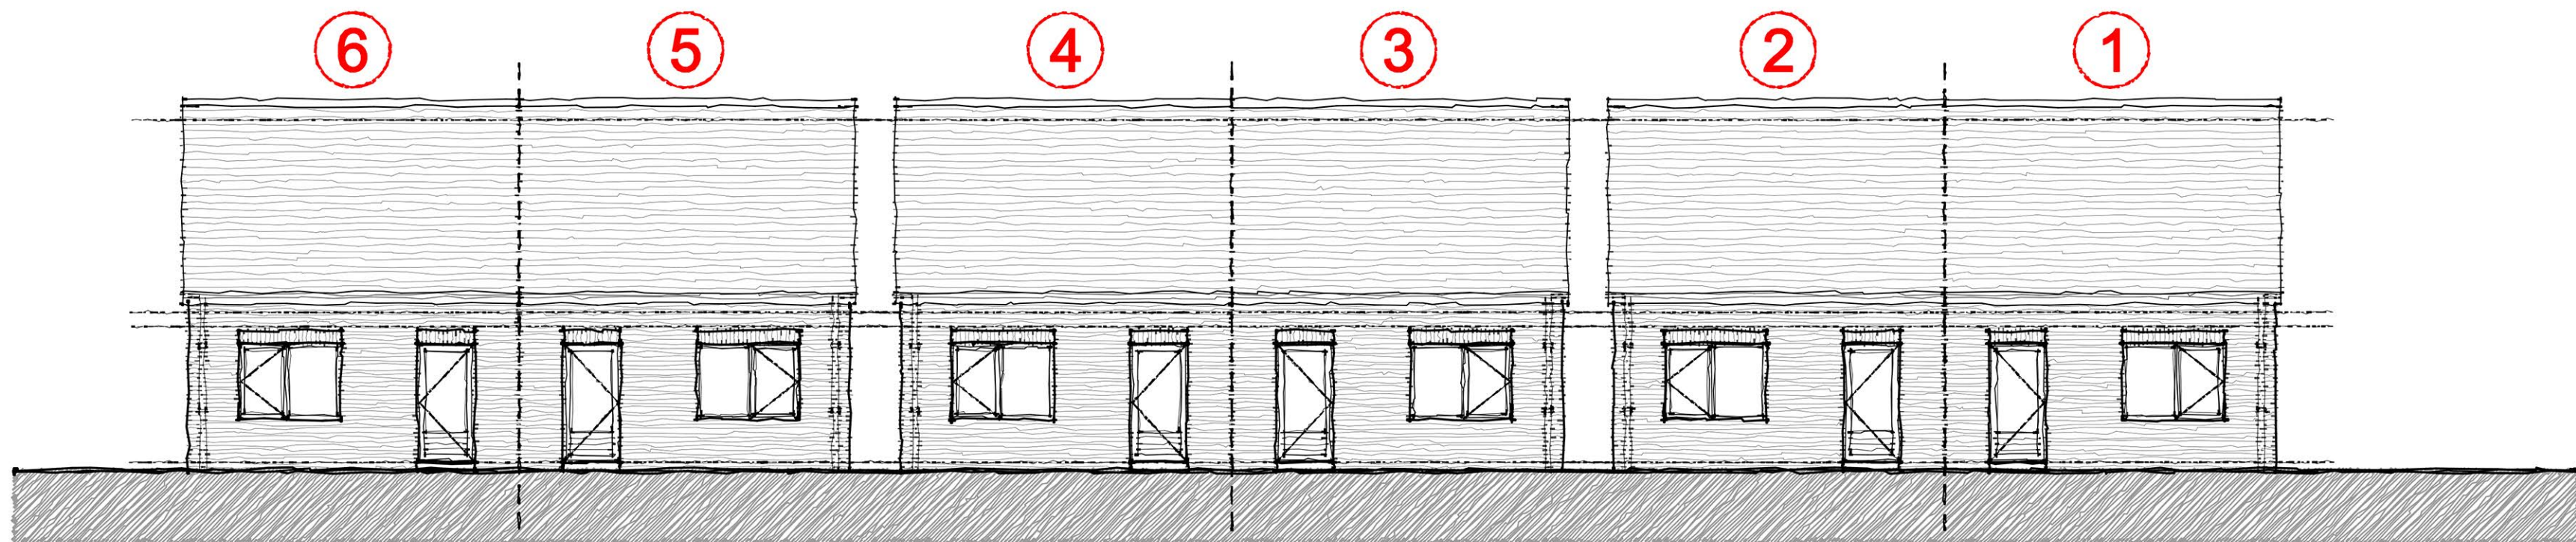

As-Built Rear Elevation
Scale 1:100

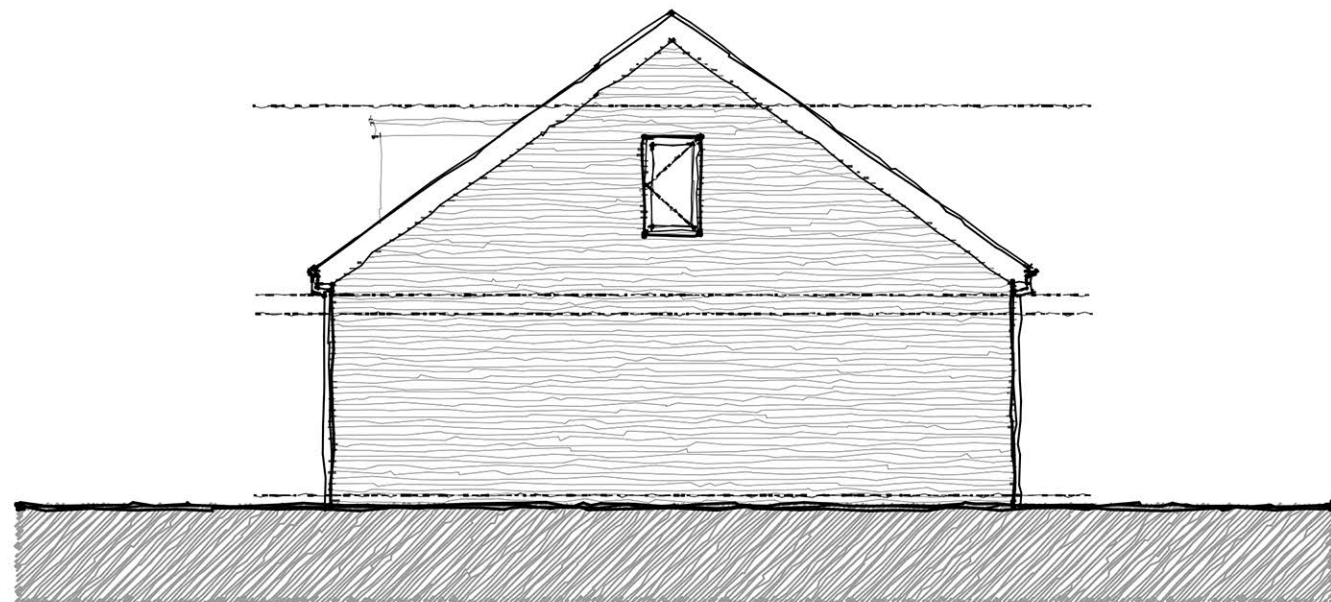

As-Built Side Elevation
Scale 1:100

NOTES

All dimensions to be checked on site. Figured dimensions to be read in preference to scaled. Architect accepts no responsibility for any unauthorised amendments to the drawing and does not permit unauthorised copying of the drawing. This drawing is copyright and remains the property of Architect unless otherwise agreed.

1:100 Scale Bar



Version	Amendment	Drawn & Date	Checked & Date	Approved & Date
Client				
TBC				
Project Name				
9 No. Retirement Bungalows, Thursby Walk, Kirkby				
Drawing Title				
As-Built Elevations				
Scale 1:100	Original Size A1	Planning		
Date 20.02.23	Drawn *	Checked *	Approved *	Status *
Drawing Number 503				Revision *