






proposed - as built
rear elevation

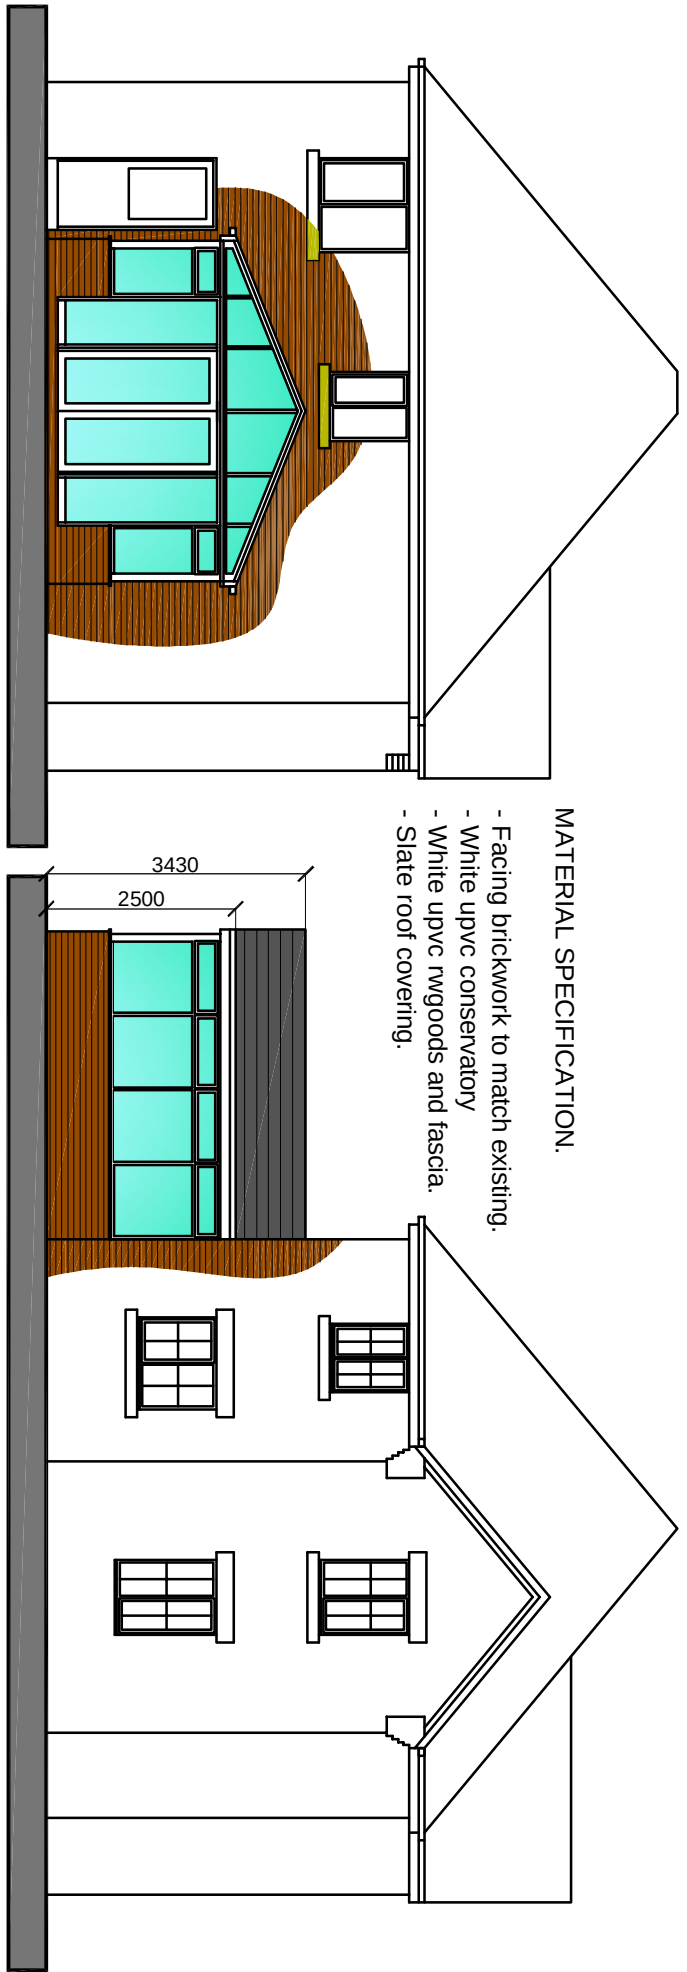


proposed - as built
side / street elevation

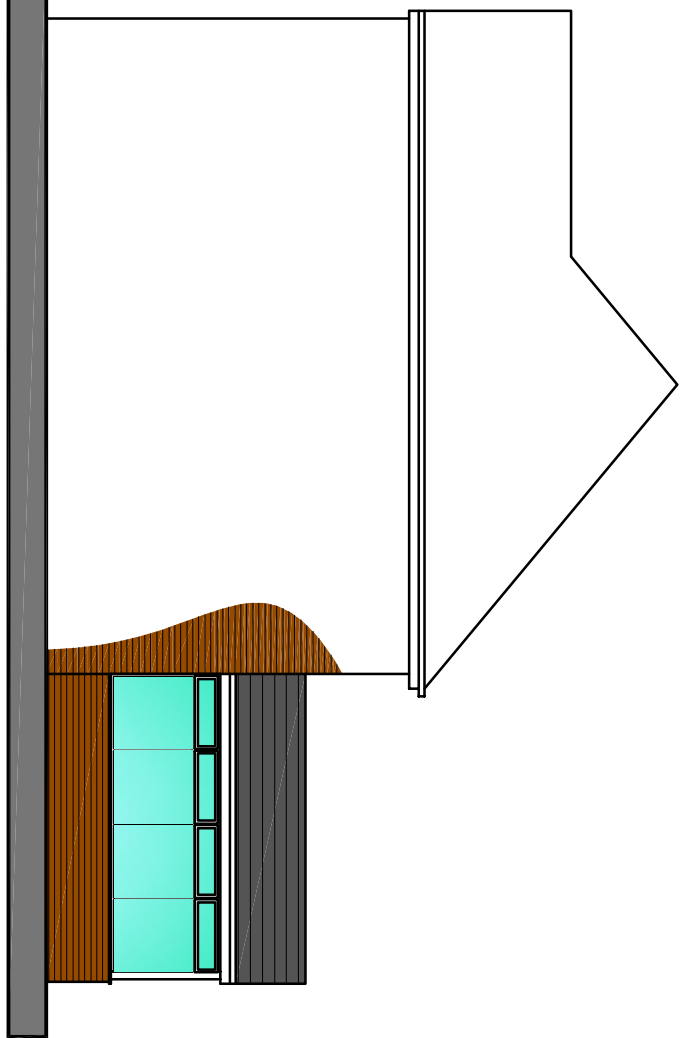


proposed - as built - 1:100
side / driveway elevation

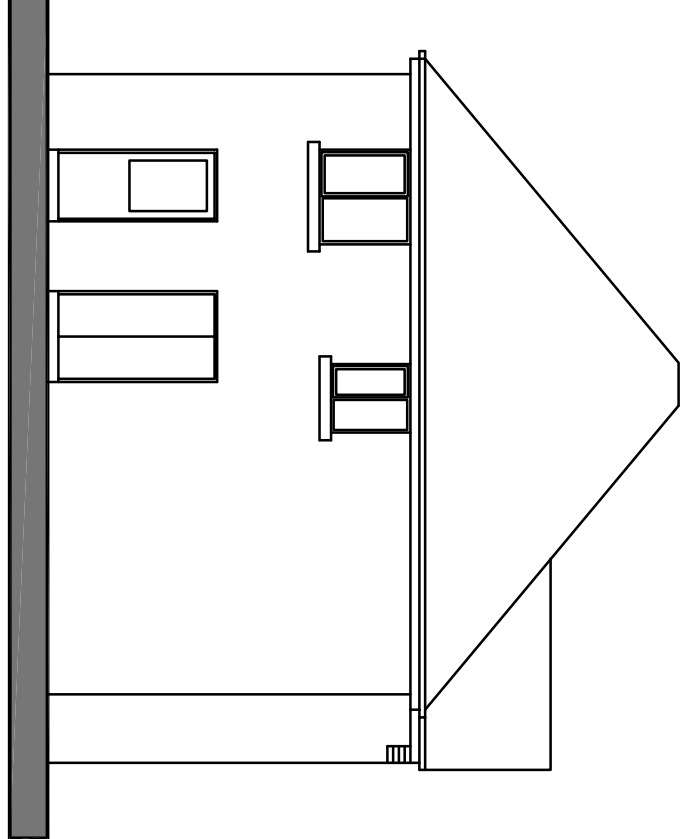

existing
rear elevation

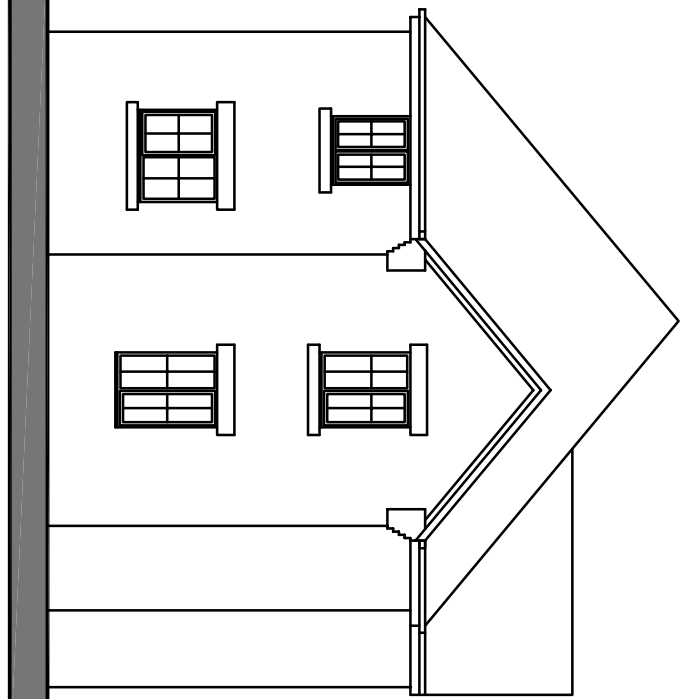


existing
side / street elevation

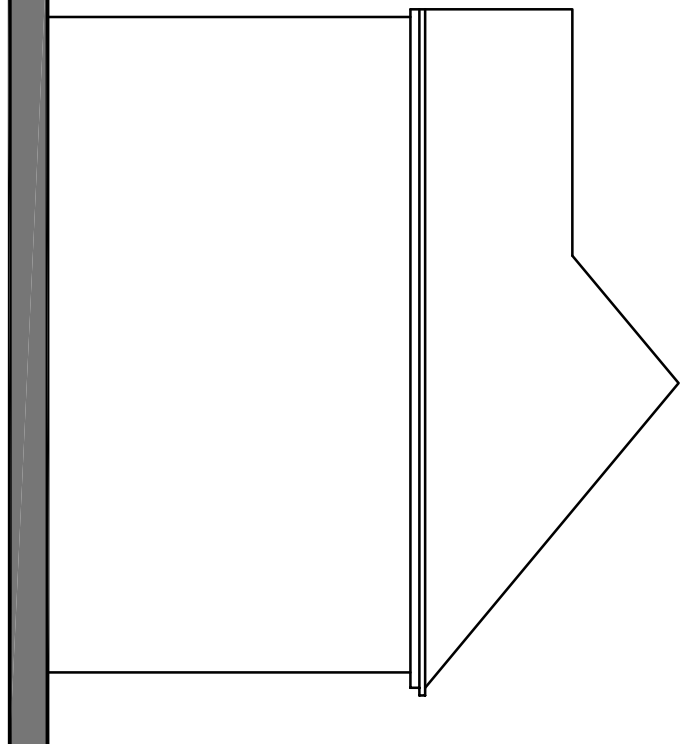


existing
side / driveway elevation

MATERIAL SPECIFICATION.



- Facing brickwork to match existing.
- White upvc conservatory
- Slate roof covering.

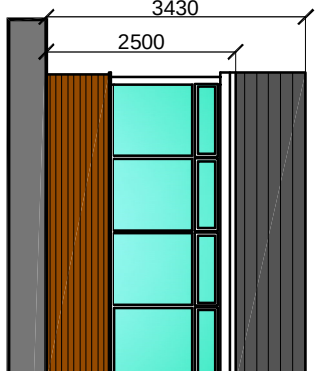


Note:-
Existing floor finish and underfloor heating is to be removed to allow the installation of a gas proof membrane, 0.5mm thick low density polyethylene "Radbar Amber 1" gas membrane manufactured by Capital Valley Plastics Limited. This low permeability membrane is approved for use in BS8485:2015 and NHBC applications up to 'amber 1'.
Membrane is to be laid over the slab and tucked into raked out mortar joints. Use compatible sealing tape where necessary.
Underfloor heating to be laid over membrane and screed over.
All works are to be overseen by the Local Authority Inspector.

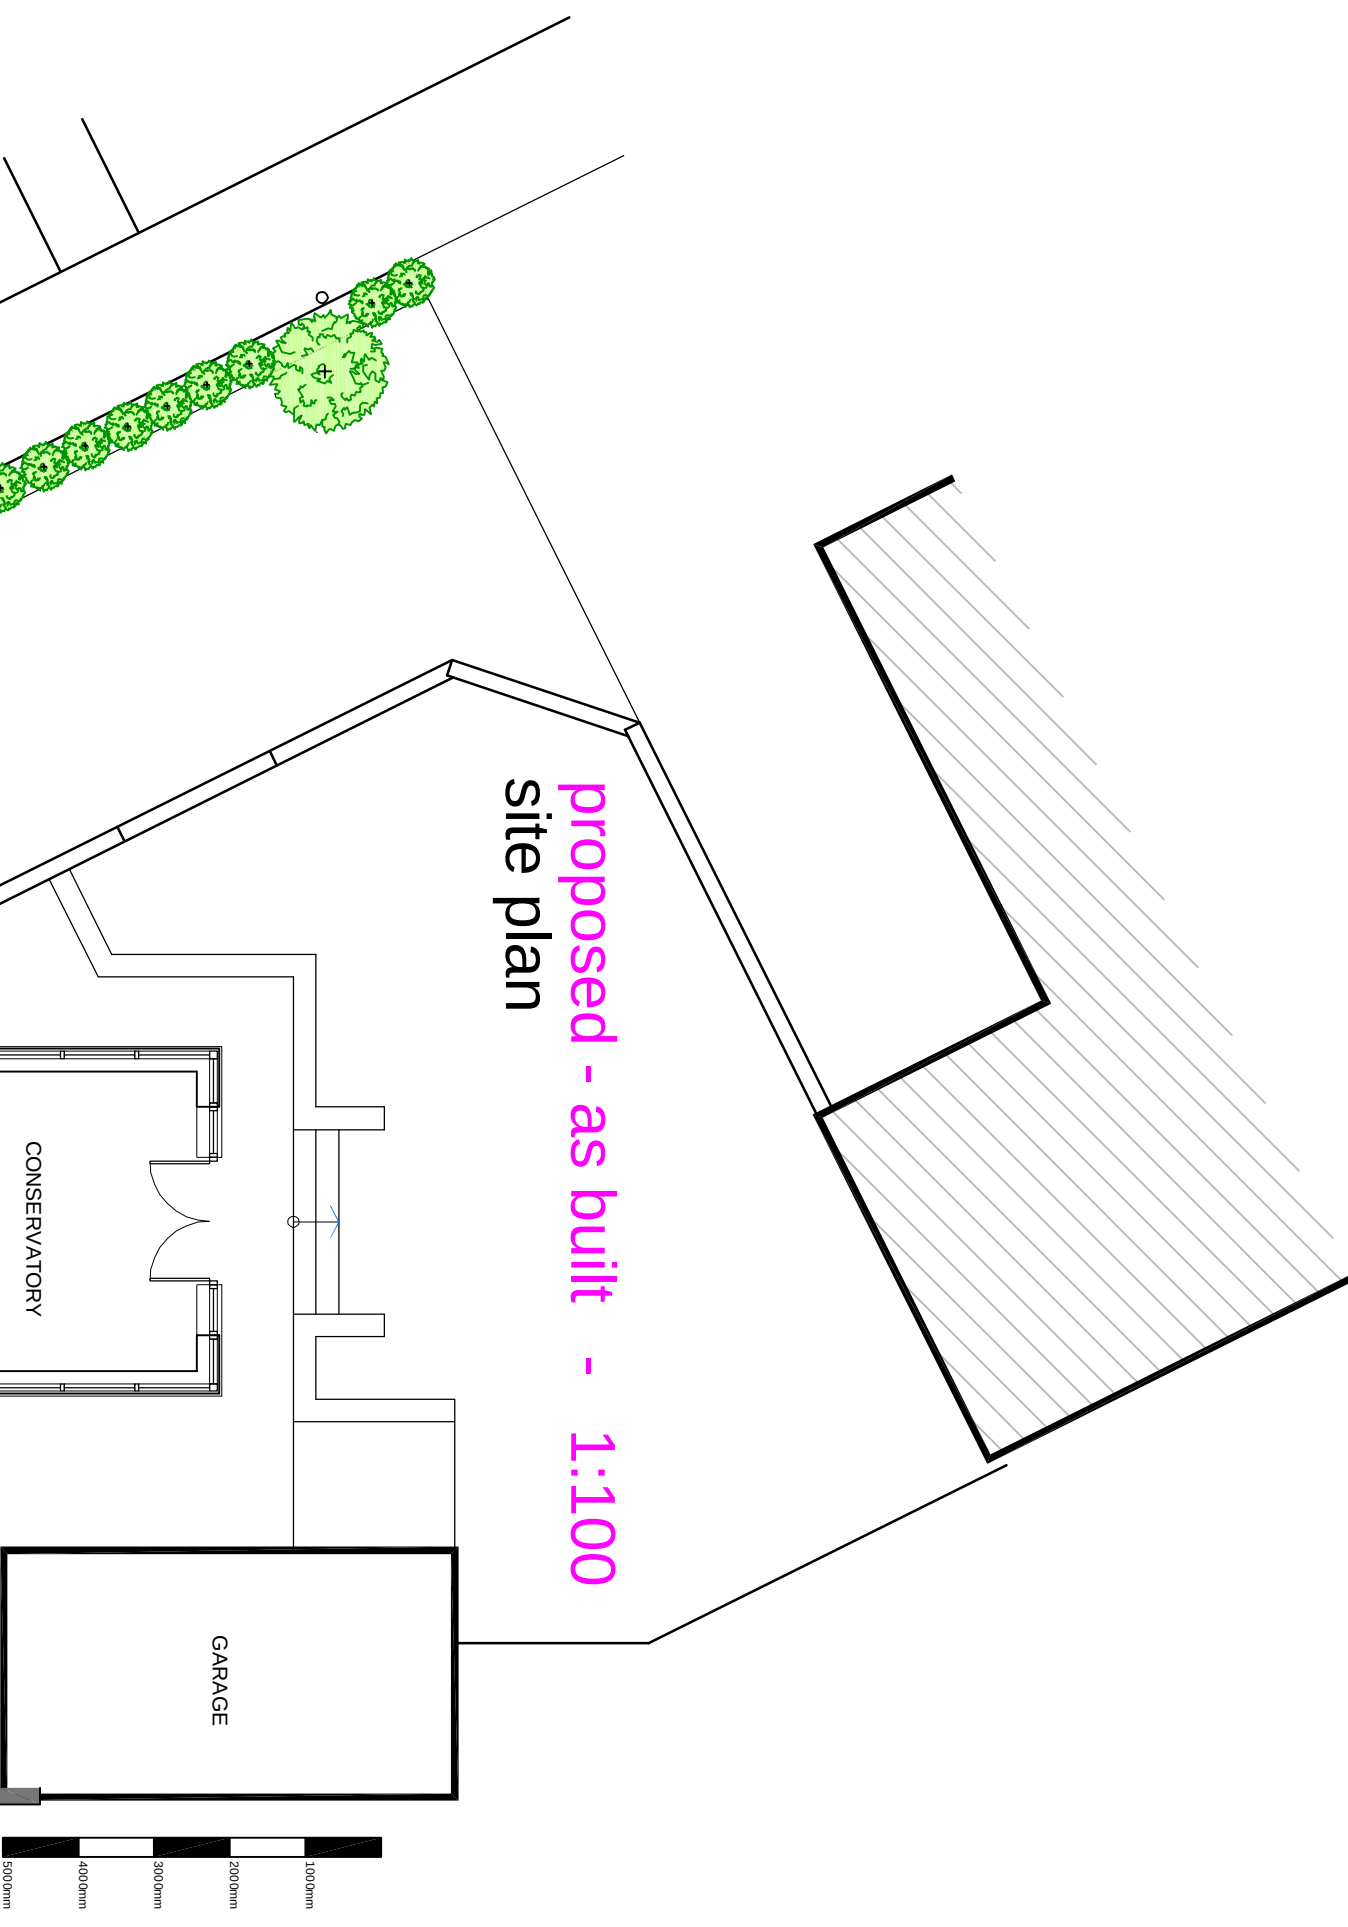

proposed - as built - 1:100
site plan

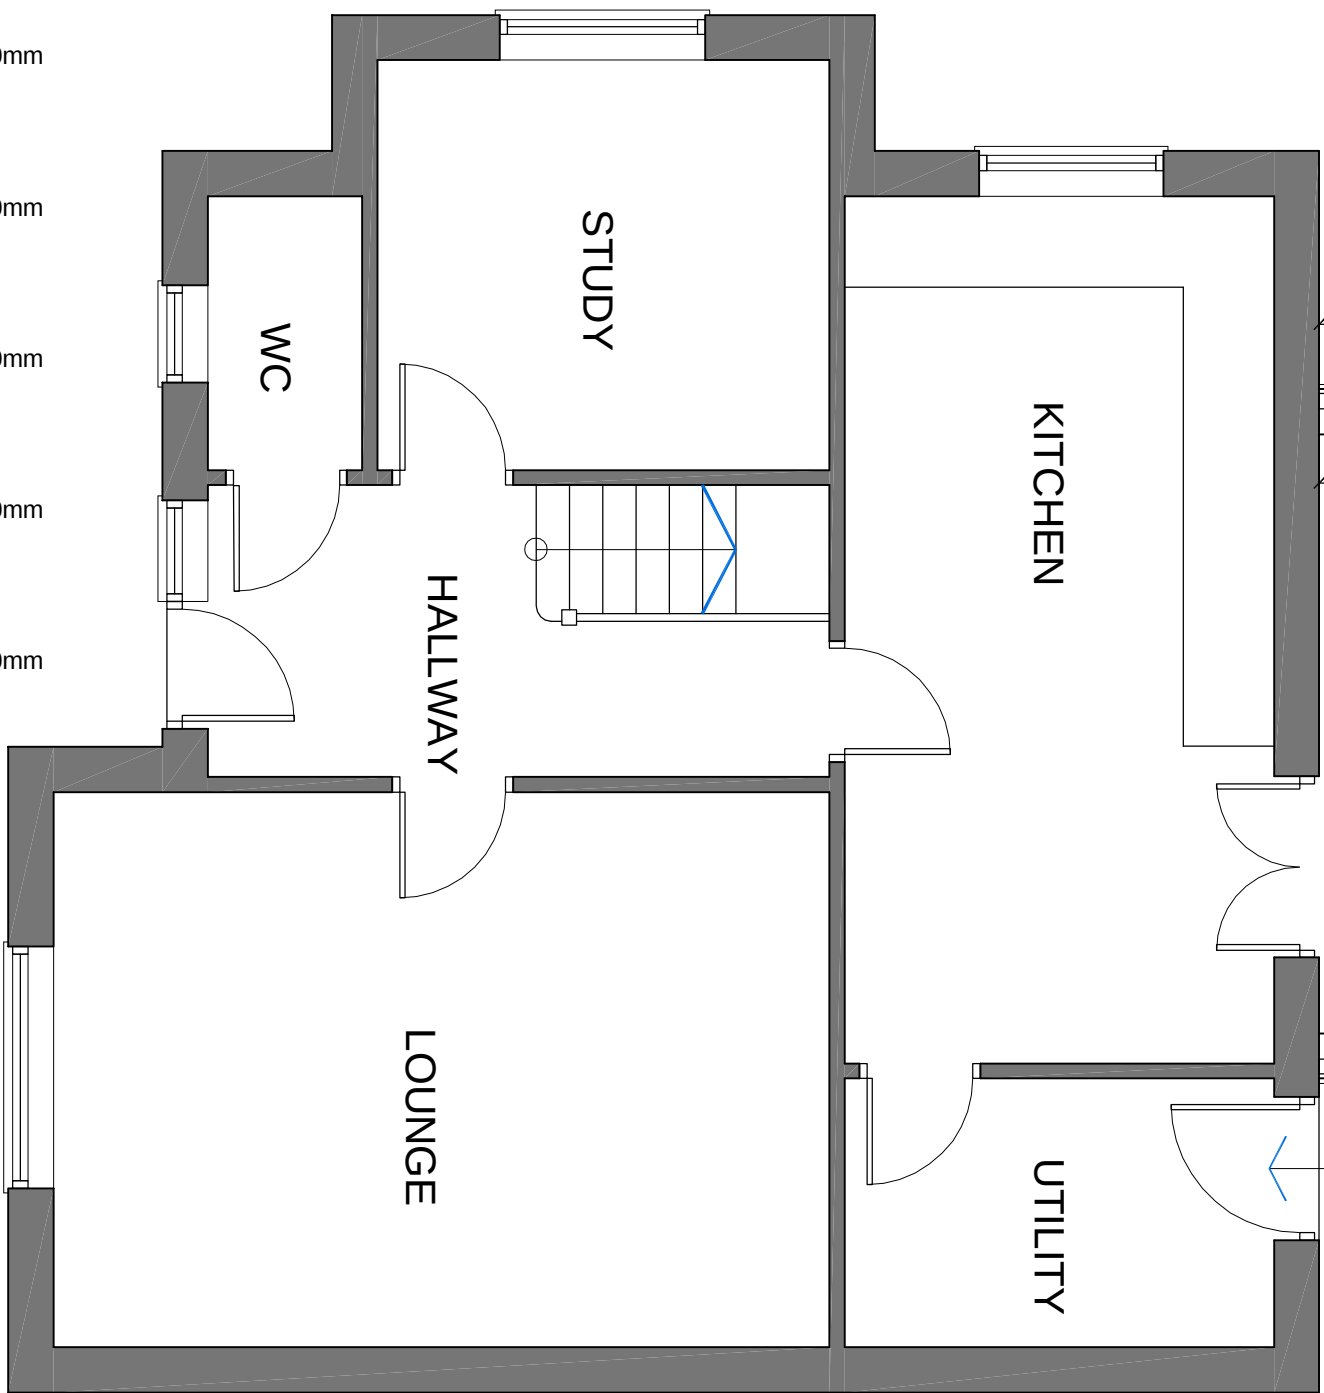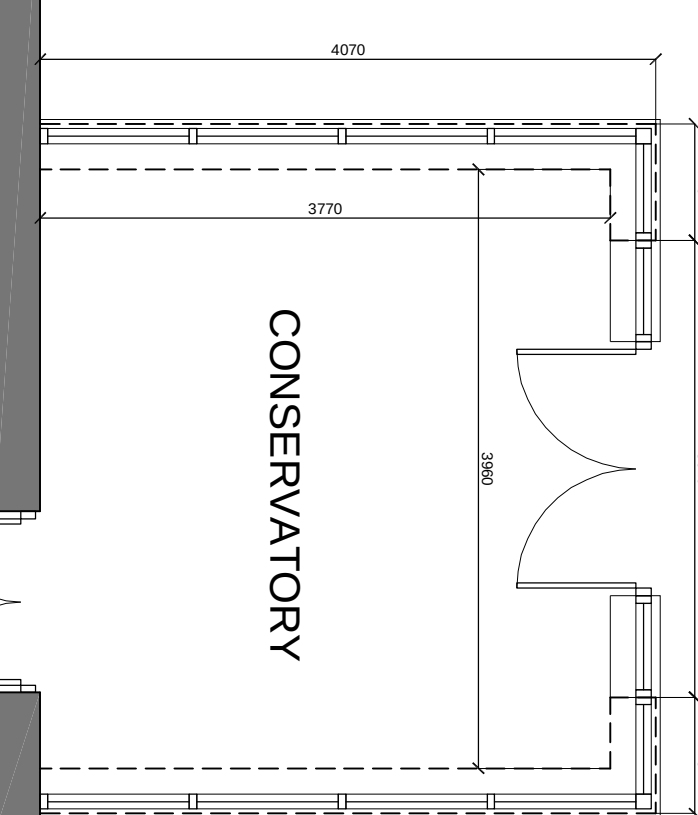

proposed - as built
ground floor plan 1:50

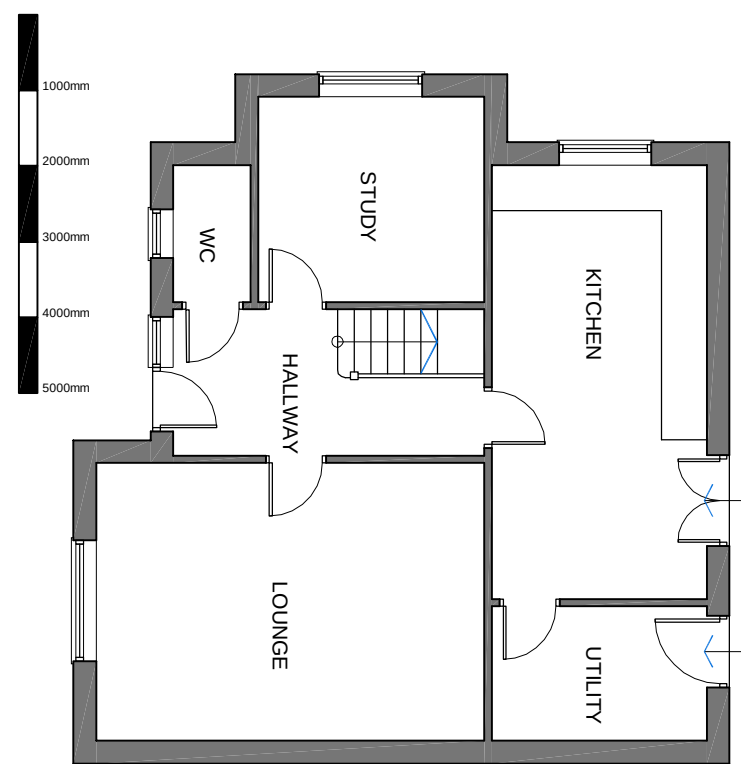



existing
ground floor plan 1:100



01855 888 022
www.ukplanningmaps.com



proposed
location plan 1:1250

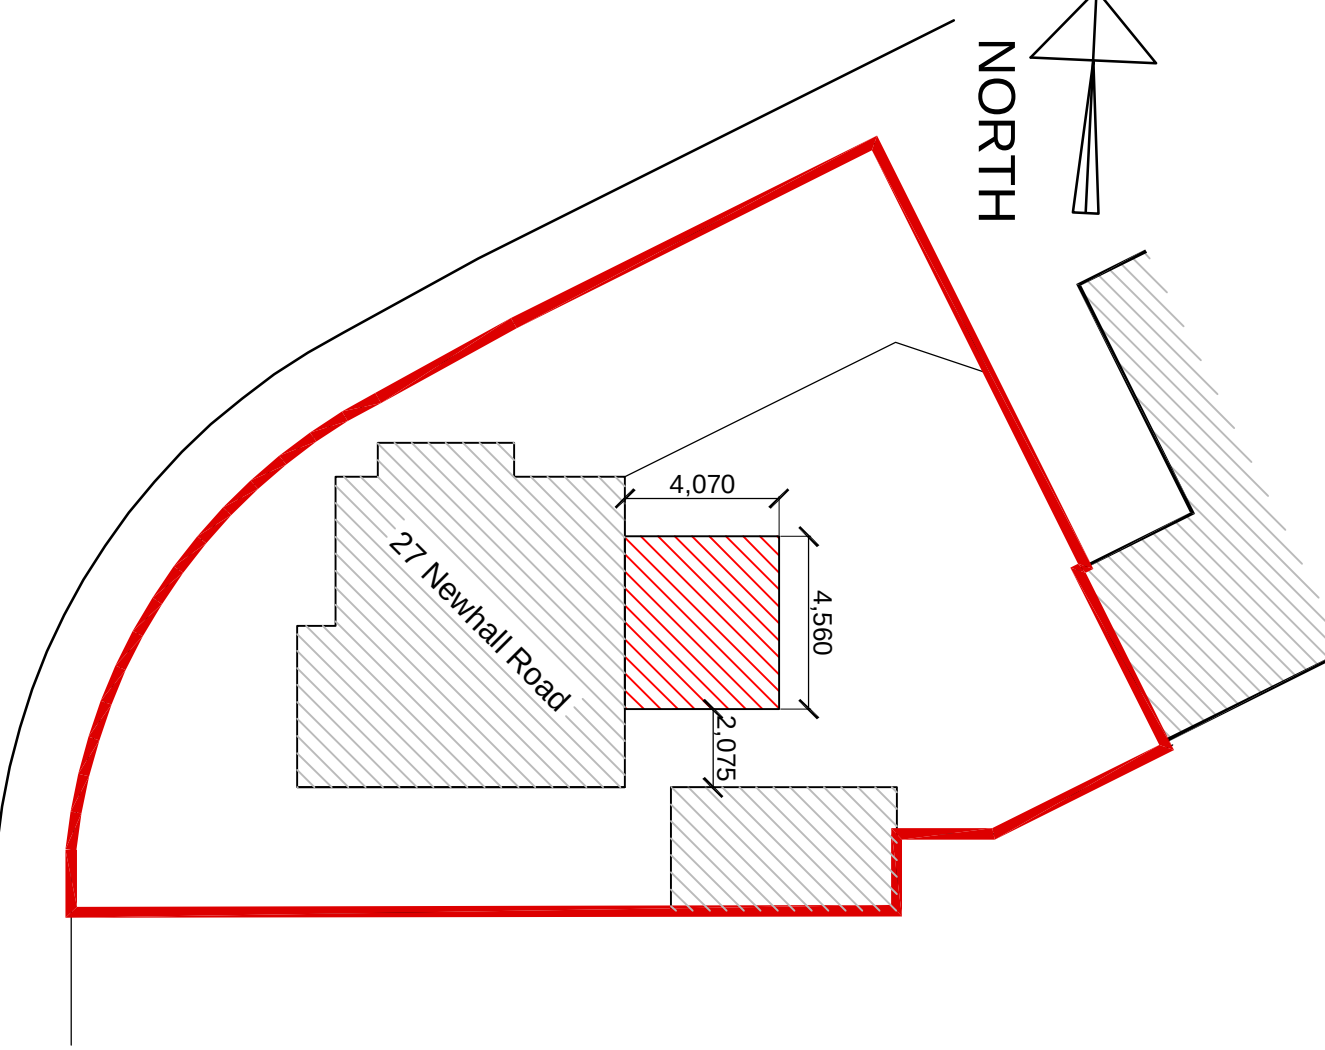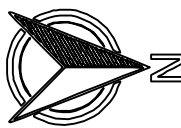

proposed
block plan - 1:200

Client	Mt & Mrs Brian Doyle	Rev	Date	Description
Job Ref	27 Newhall Road, Prescot, Merseyside, L34 4Q	A	30.04.26	Introduction of Gas Membrane to conservatory.
Drawing Title	Existing / As Built Floor Plans, Elevations & Site Plan	B	23.03.26	Scale bar indicated to location plan & amended scale bar to existing floor plan.
Job No	Studio-2026-388-001-PL			
Scale	1:50 / 1:100 / 1:200			
Revision	Revision		B	
Date	March 26	Drawn	Date H	

STUDIO ARCHITECTURE

75 St. Helens Road
L39 4QW
07730 599509
studio.architecture@vodafone.com

Project reference: 2026-388-001-PL