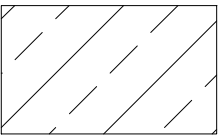
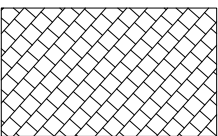
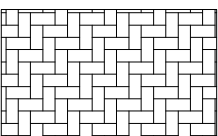


Legend


- 

Brushed Concrete surfacing to service areas,
service access road and non frontage footpaths
- 


Concrete block paviors laid in 90 degree
herringbone pattern car park


Colour: Brindle
- 

Concrete block paviors laid in 90 degree
herringbone pattern car park

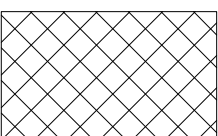Colour: Charcoal
- 


Concrete block paviors laid in 90 degree
herringbone pattern car park

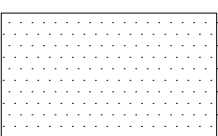Colour: Natural
- 

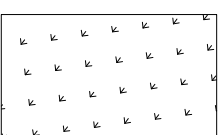Tarmacadam finish to Estate Road, estate
road footpaths & car park bays with
bitumastic white lining
- 

Landscaping areas to Landscape Architects details


2.4m high PPC green paladin fencing
with matching gates

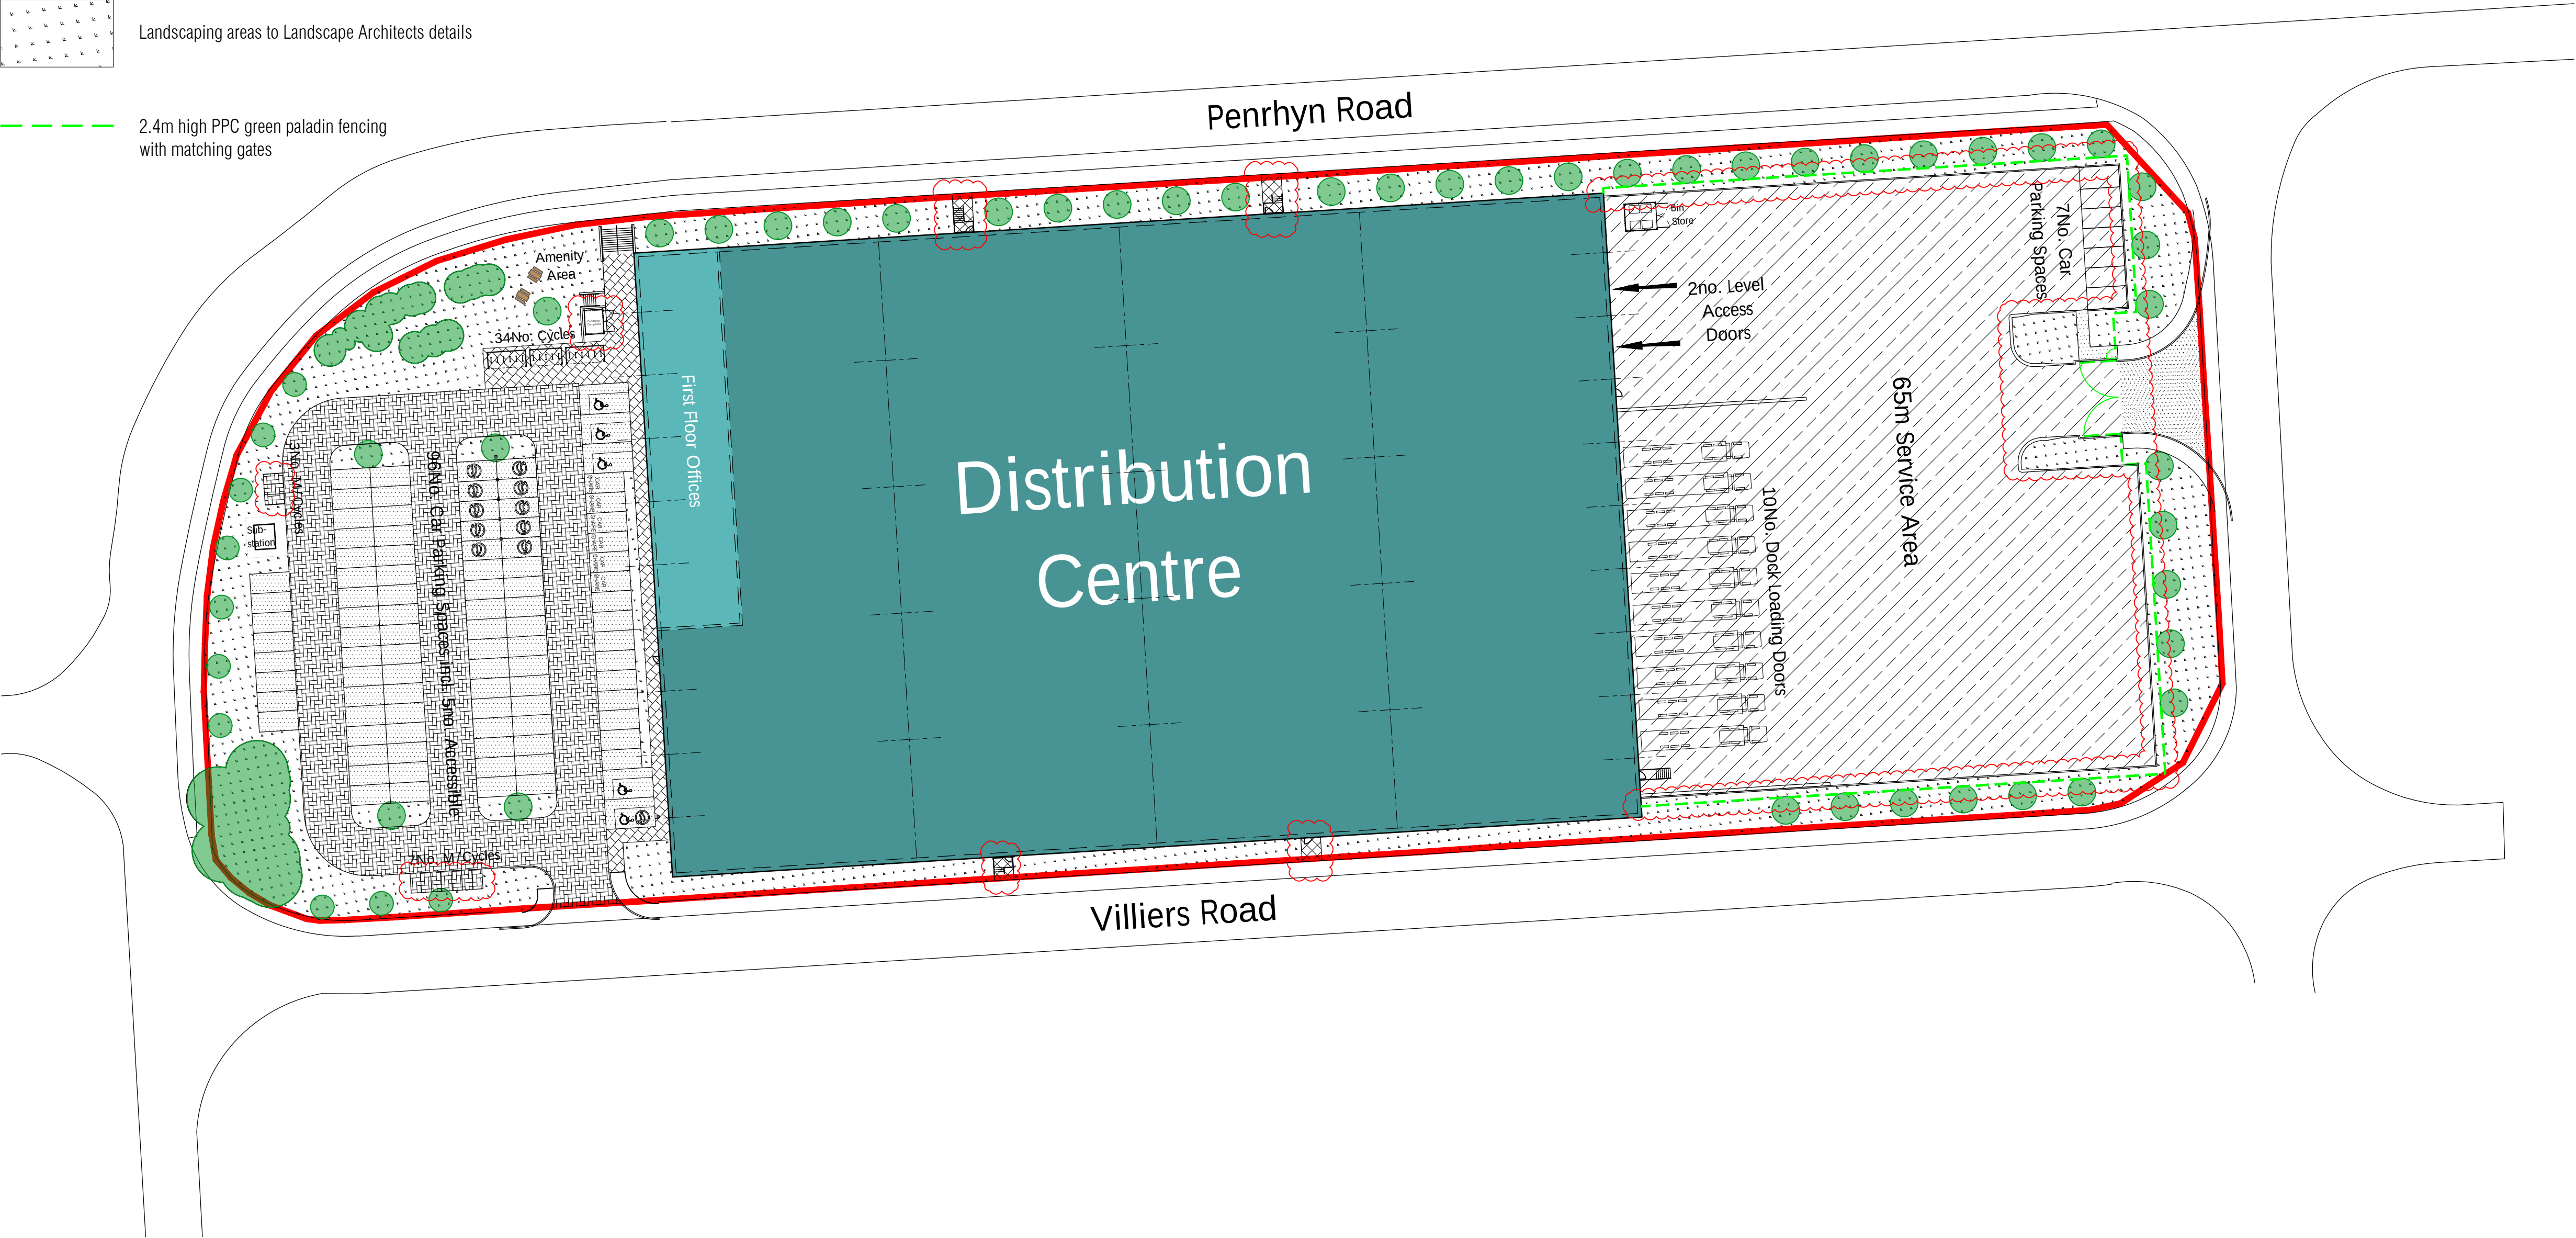

notes

this drawing and design is the copyright of aja architects llp and must not be reproduced in part or in whole without prior written consent. contractors must verify all dimensions on site before commencing work or preparing shop drawings if in doubt ASK.

Where this drawing contains any Ordnance Survey mapping material, it has been reproduced under license number 100052278.
Ordnance Survey © Crown copyright

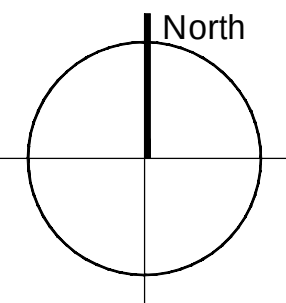

- L

04/01/23

Block paving added to m/cycle spaces and warehouse personnel escape routes. Line of security fencing revised. External condenser compound added. Entrance to service yard revised in accordance with s278 approved drawings.

sih
- K

6/7/22

Building footprint adjusted to provide greater landscaping to northern boundary, m/cycles relocated and amenity area adjusted.

mjl
- J

05/07/22

Building footprint revised

mjl
- H

27/05/22

Cycle and M/cycles added

mjl
- G

16/02/22

Red line boundary amended.

sih
- F

14/02/22

Red line boundary added.

sih
- E

10/02/22

Indicative trees revised in accordance with proposed landscape scheme.

sih
- D

08/02/22

Titleblock amended. Substation indicated. Bin store added. External ramp omitted. Retaining wall added to service yard dock.

sih
- C

01/02/22

Car parking amended.

sih
- B

31/01/22

Roof protection zone indicated. 4no. car park spaces relocated to service yard. External fire escape stairs, office stair and ramp added.

sih
- A

21/01/22

Building proportions reverted to original scheme. Building moved eastward to provide more landscaping along west boundary.

sih

no.	date	revision	by
-----	------	----------	----



aja architects llp
1170 Elliott Court
Herald Avenue
Coventry Business Park
COVENTRY CV5 6UB

T: 024 7625 3200
F: 024 7625 3210
E: aja@aja-architects.com
W: www.aja-architects.com

aja architects llp is a limited liability partnership registered in England No. OC326721
client

Pembury Developments Ltd.

project

Penrhyn Road
Knowsley

drawing

Proposed External
Finishes Plan

scale 1:500 @ a1 drawn sih

checked mjl date 19/01/22

no

6982 - 11 Rev L

PLANNING

