




East Elevation Setting Out
1 : 50



West Elevation Setting Out
1 : 50

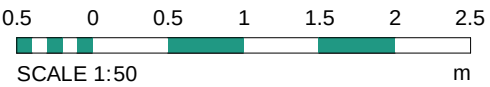

C	27.01.22	LT	Drawing status changed to Construction
B	28.05.21	LT	Position of gas and elec meter boxes amended following contractor mark up
A	31.03.21	HP	Amended BWF and KWF position. OG and EG windows annotated
1	24.02.23	LB	GRP canopy added to drawings
Rev	Date	Int	Description



CLIENT:

Torus / HMS

PROJECT:

Brookside Close, Prescott

DESCRIPTION:

Block A Elevations 02 - Setting Out

PURPOSE OF ISSUE:

Information

DRAWN BY:	CHECKED	DATE:	SCALE @ A1:
AP	VS	06/07/20	1 : 50

JOB NO:	STATUS CODE:	DRAWING NO:	REV
3347	S2	214	1

FILE IDENTIFIER:
BC-BTP-01-E-DR-A-3347_214.1