


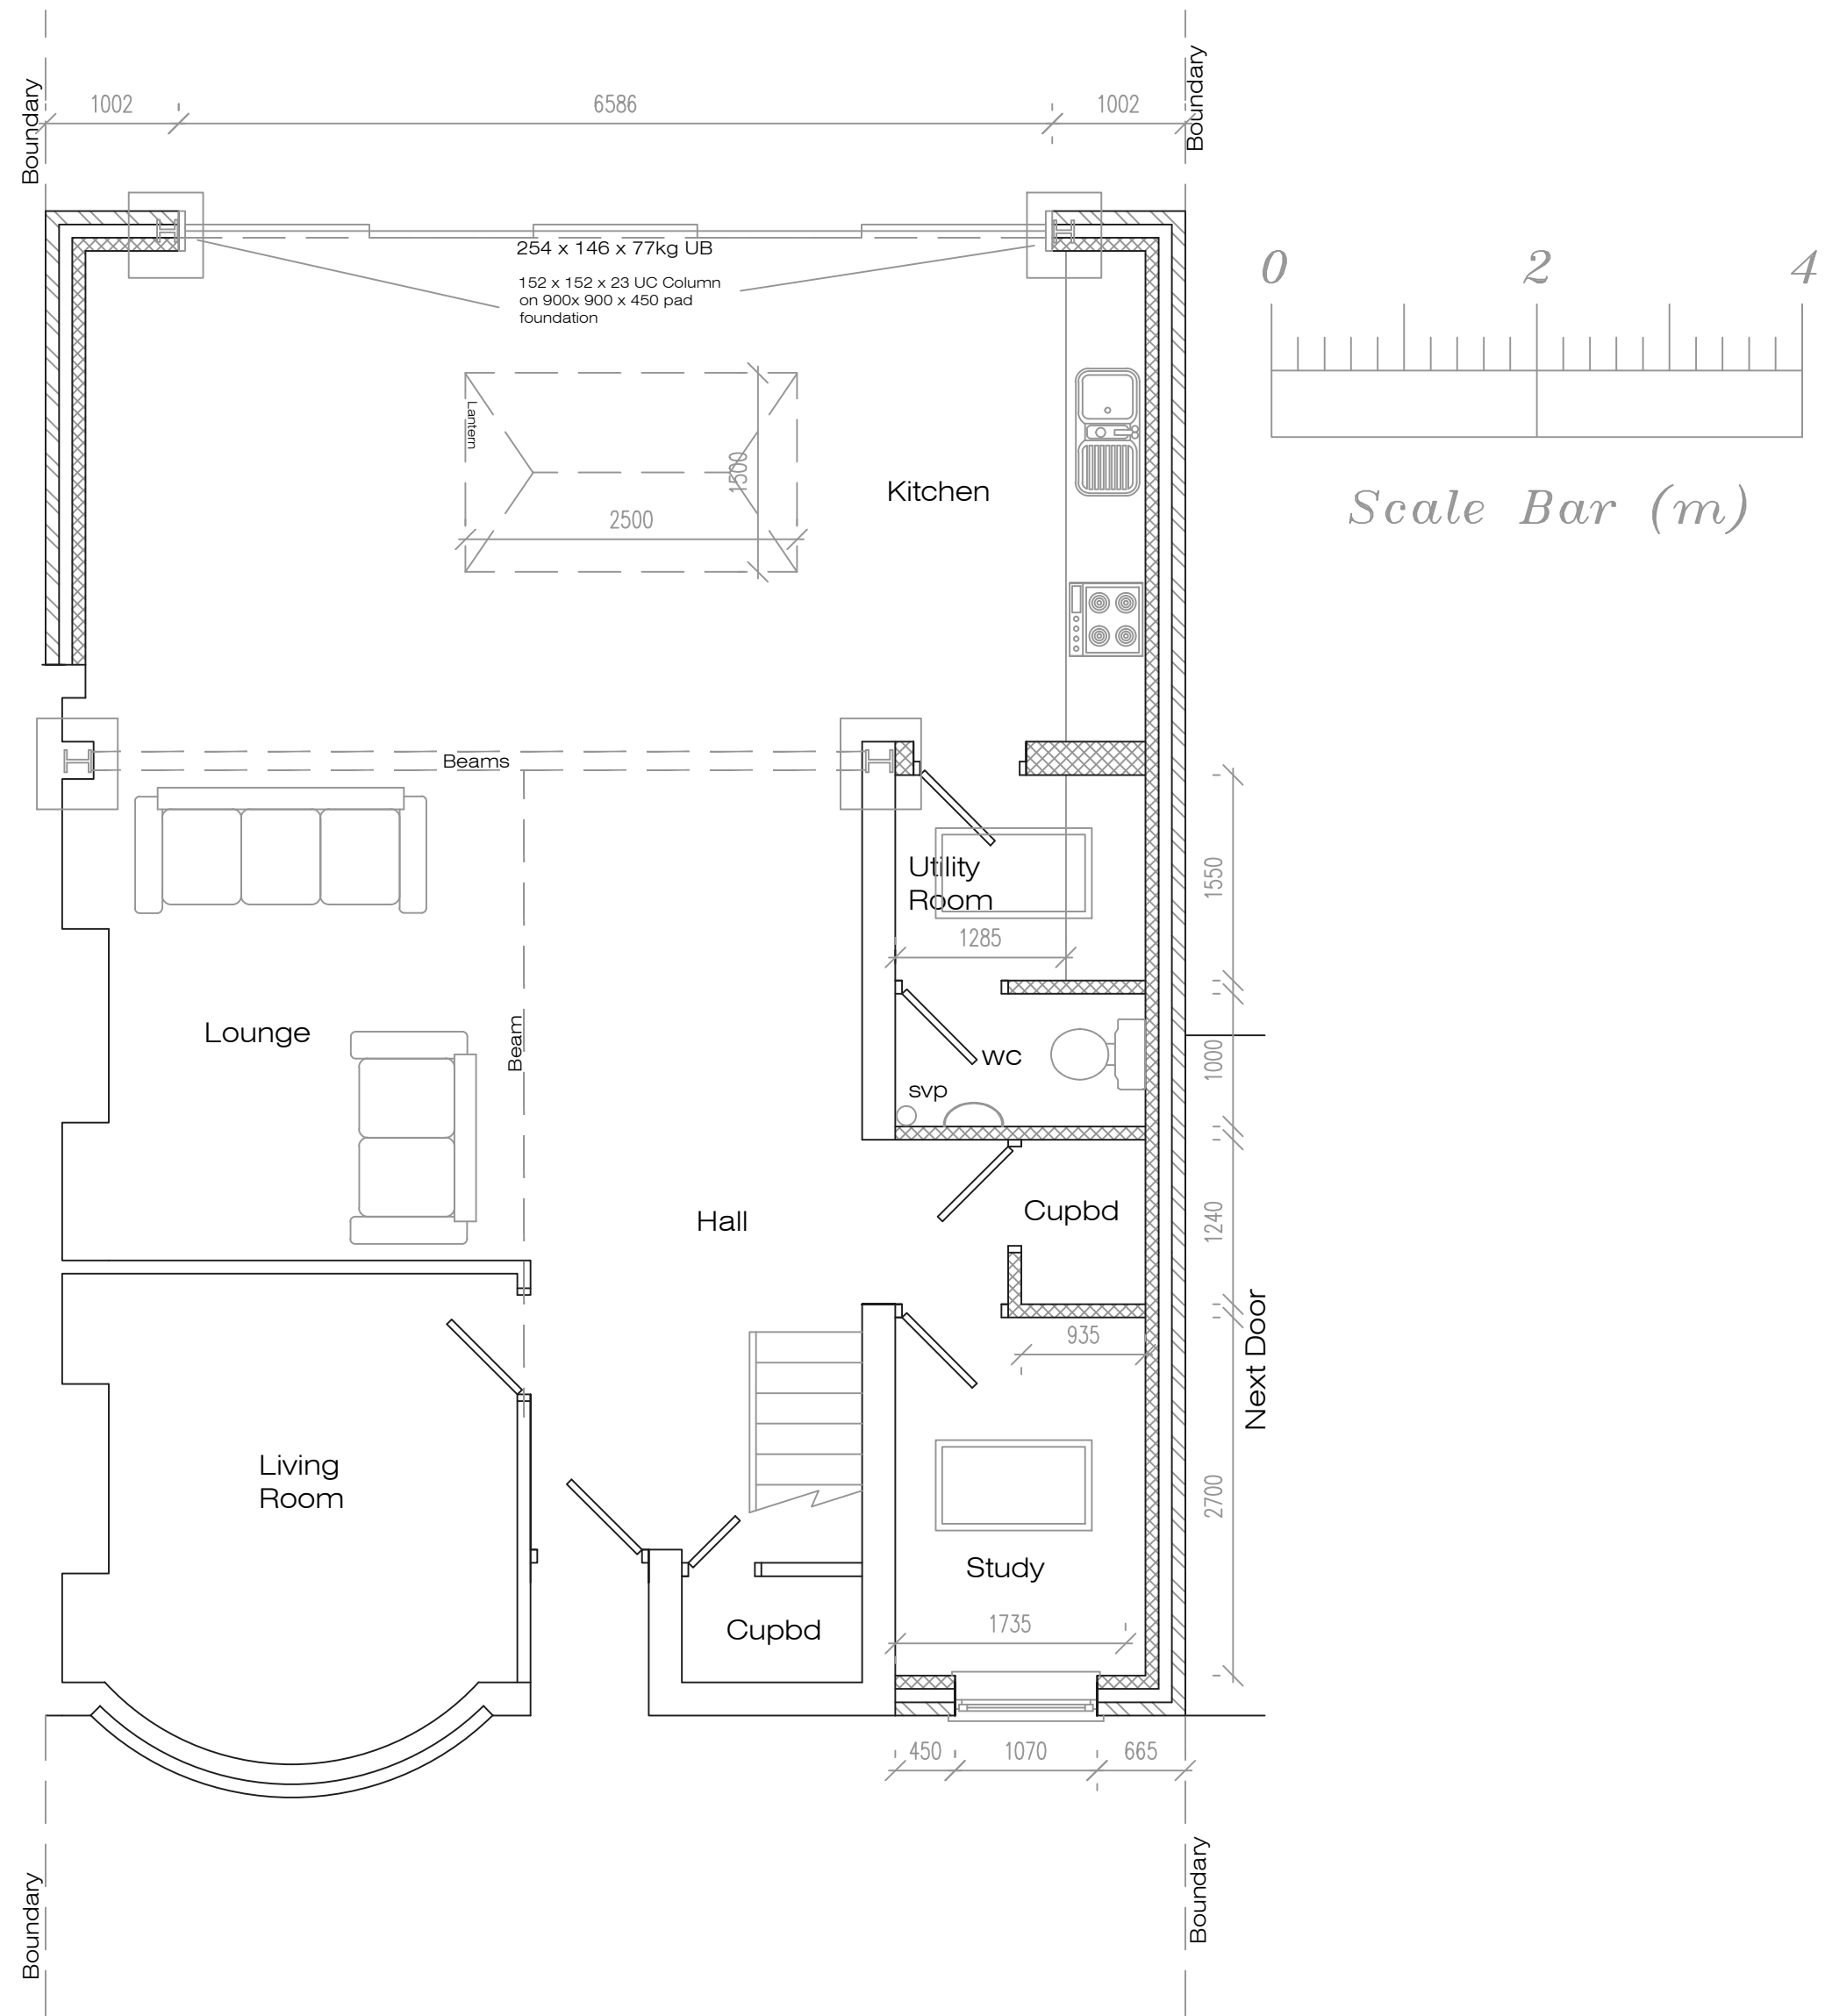

Proposed Ground Floor Plan

Address				
31 Yew Tree Road, L25				
Job Title				
Single storey side and rear extension (Alterations to approved scheme)				
Drawing title				
Proposed Floor Plan (As built)				
Chkd	Appvd	date	scale	Dwg No.
		Nov '23	1:50 @ A2	002