



ASHTON PARK
2nd Floor and 3rd Floor Layout

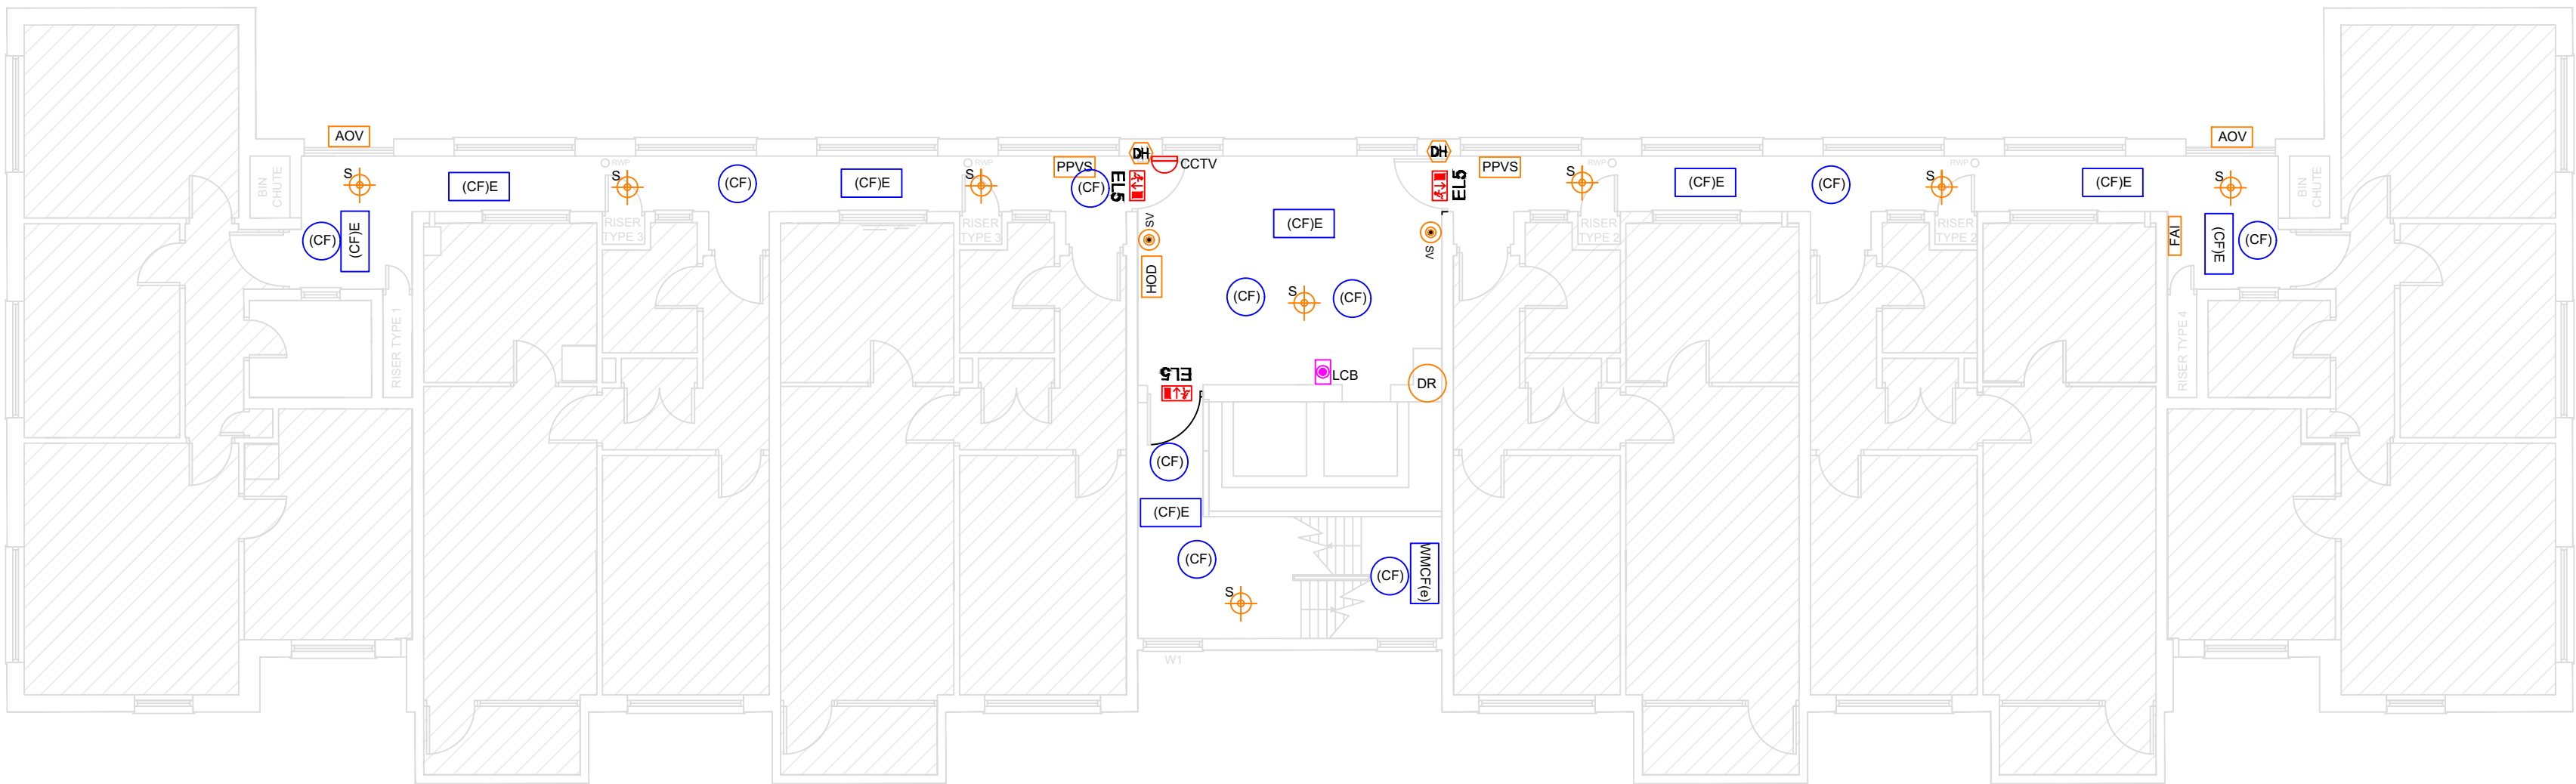


2nd Floor

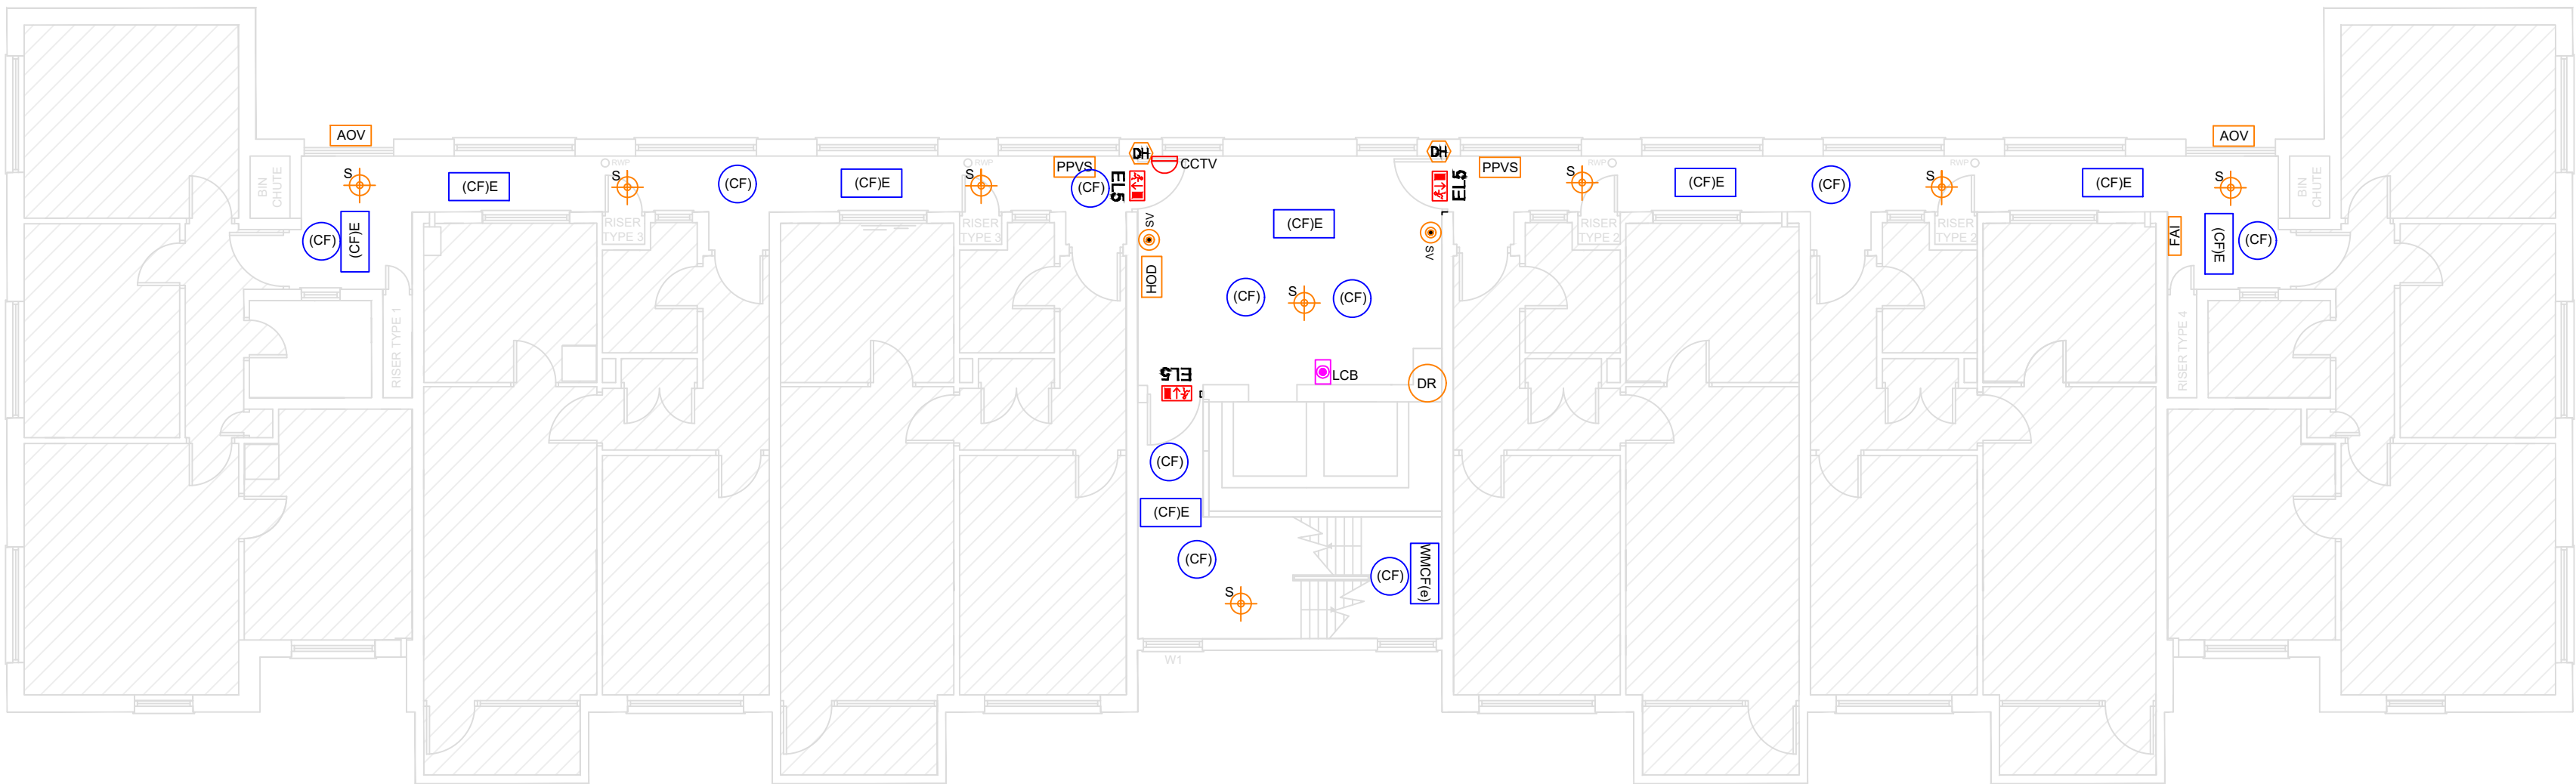

3rd Floor

Risers

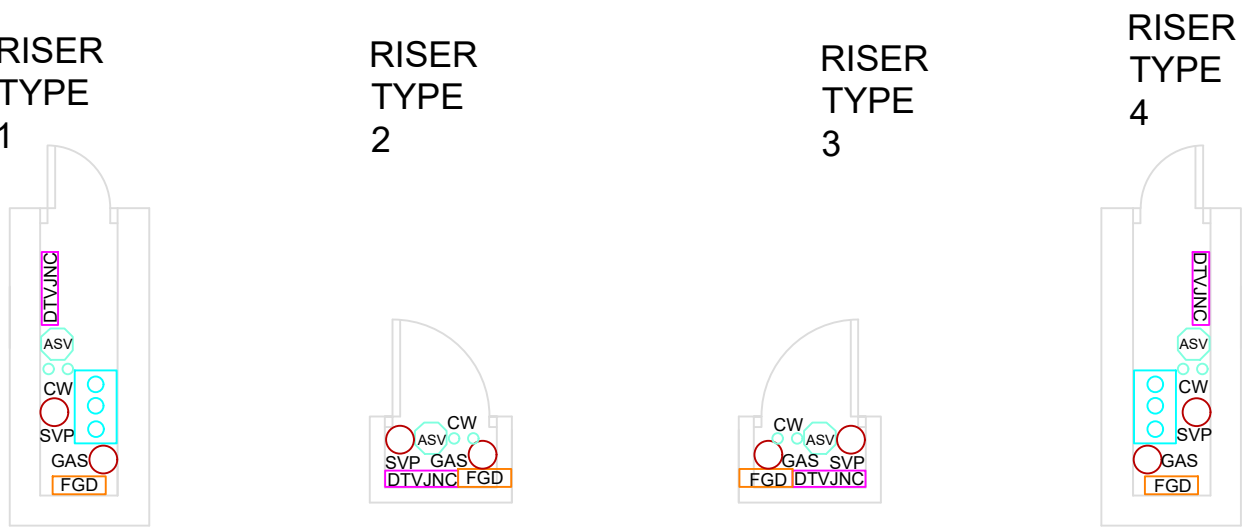

Key

LIGHTING	
EL5	WALL MOUNTED DIRECTIONAL ESCAPE MAINTAINED LIGHT FITTING WITH LEGEND
(CF)	INTERNAL LIGHT FITTING- BULKHEAD MAINTAINED- COMPACT FLUORESCENT - CIRCULAR TYPE
(CFJE)	INTERNAL LIGHT FITTING- BULKHEAD (NON-MAINTAINED- EMERGENCY COMPACT FLUORESCENT - STANDARD TYPE)

ELECTRICAL MAINS DISTRIBUTION
MAINS ELECTRIC FEED

FIRE	
DR	DRY RISER
S	SMOKE DETECTOR HEAD
FAL	FIRE ALARM INTERFACE
SV	SMOKE VENT CONTROL ACTIVATION POINT
PPVS	POSITIVE PRESSURE VENTILATION SYSTEM
DH	ELECTROMAGNETIC DOOR HOLD-OPEN
FGD	FLAMMABLE GAS DETECTOR
HOD	DOOR HOLD-OPEN DEVICE INTERFACE
AOV	AUTOMATIC OPENING VENT

SECURITY AND ACCESS CONTROL SYSTEMS	
	CCTV CAMERA CEILING MOUNTED (DOME)

SERVICES	
 GAS	GAS RISING MAIN
 RWP	RAINWATER PIPE
 SVP	SOIL VENT PIPE

HOT AND COLD WATER DISTRIBUTION AND HEATING	
ASV	ANTI-SHOCK VALVE
CW	COLD WATER SUPPLY

COMMUNICATIONS	
	LCB LIFT CALL BUTTON
	DIGITAL TELEVISION JUNCTION BOX

- NOTES:
- DRAWINGS TO BE READ IN CONJUNCTION WITH ALL SERVICES AND STRUCTURAL ENGINEERS DRAWINGS & SPECIFICATIONS.
 - © COPYRIGHT. DRAWINGS NOT TO BE REPRODUCED OR USED WITHOUT PRIOR WRITTEN CONSENT.

SCALE @A1 DATE DRAWN BY CHECKED BY
1:100 OCT14 JW BM

DRAWING
Ashton Park- Mechanical and Electrical
Installations- Second and Third Floors

PROJECT
KHT Mechanical and Electrical Record Drawings

CLIENT
Knowsley Housing Trust

RIDGE

8TH FLOOR
HORTON HOUSE
EXCHANGE FLAGS
LIVERPOOL
L2 3YL
TEL: 01512433526
FAX: TBFAX
www.ridge.co.uk

DRG NO
142528/AP/2F3F
REV
-

FILE REFERENCE:
Ashton Park

XREF FILE REFERENCE:

1 0 1 2 3 4 5
SCALE 1:100 m