



ASHTON PARK

4th Floor and 5th Floor Layout

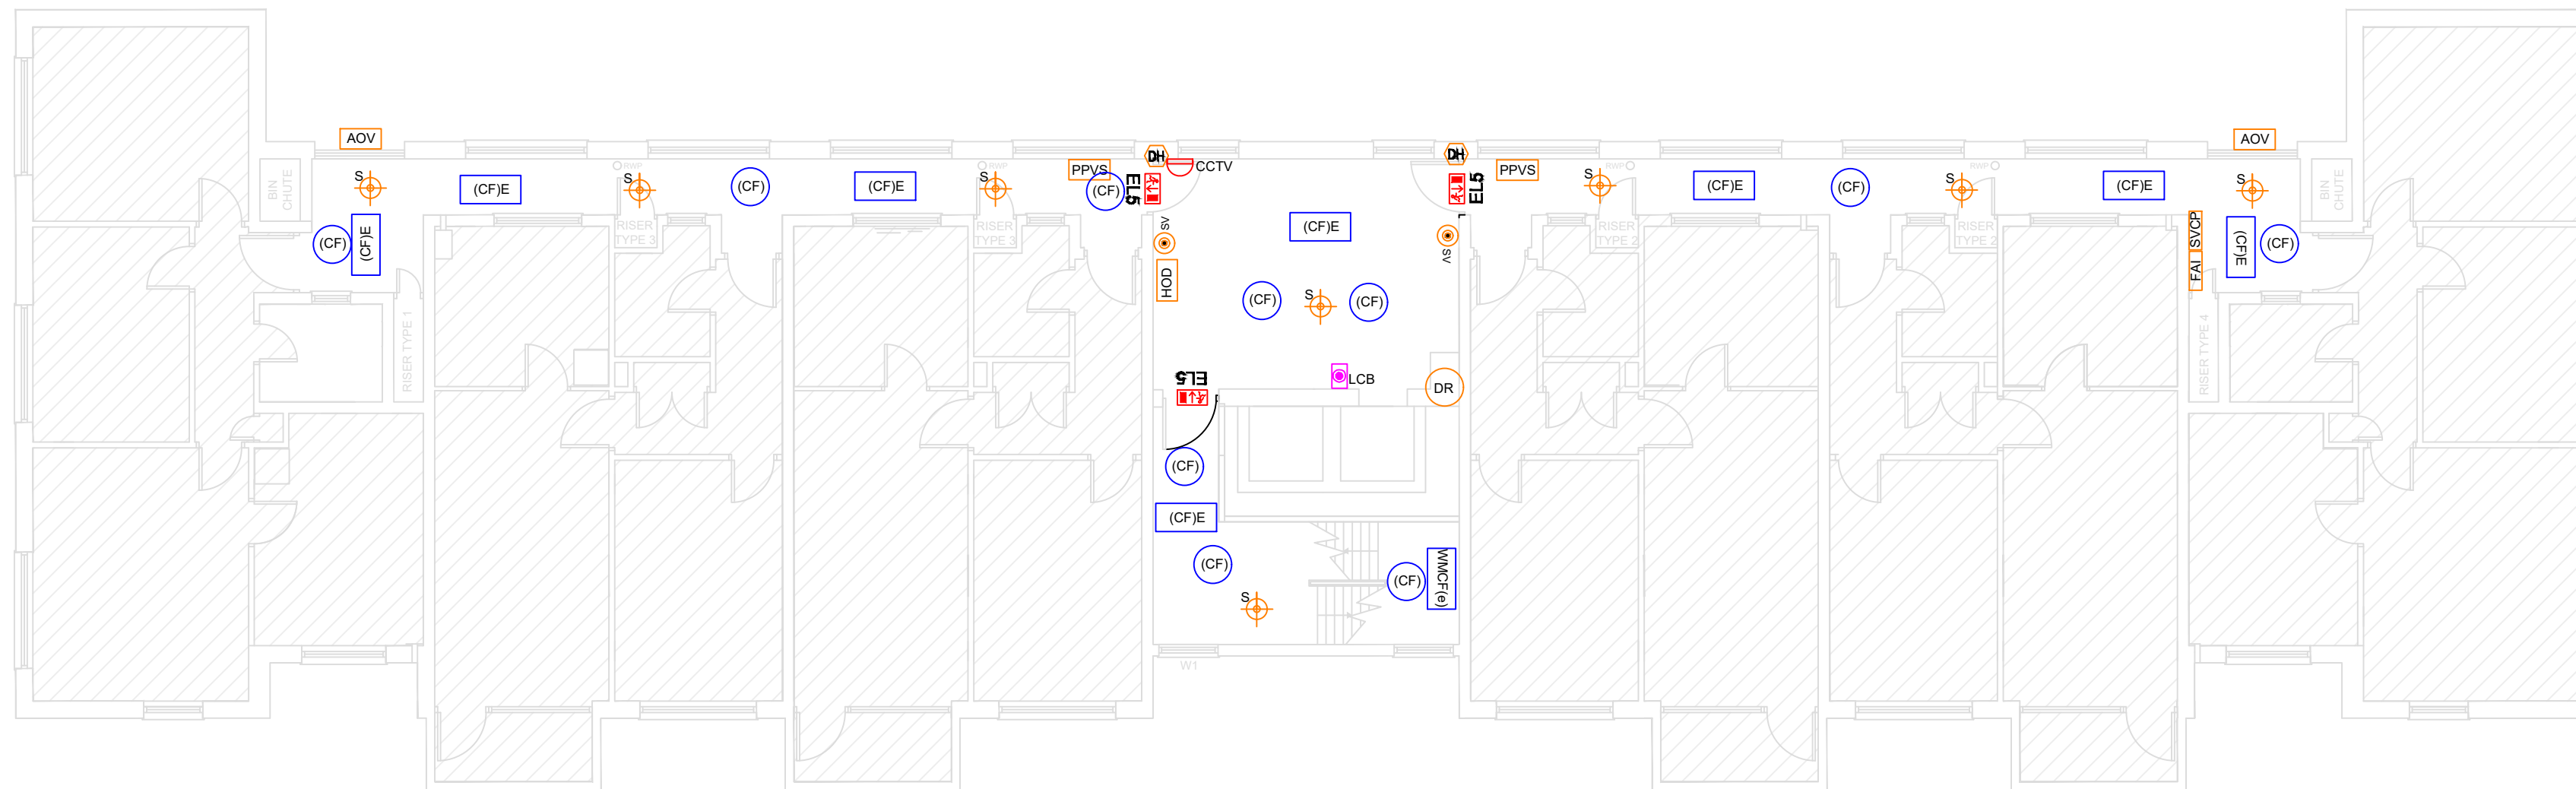


4th Floor

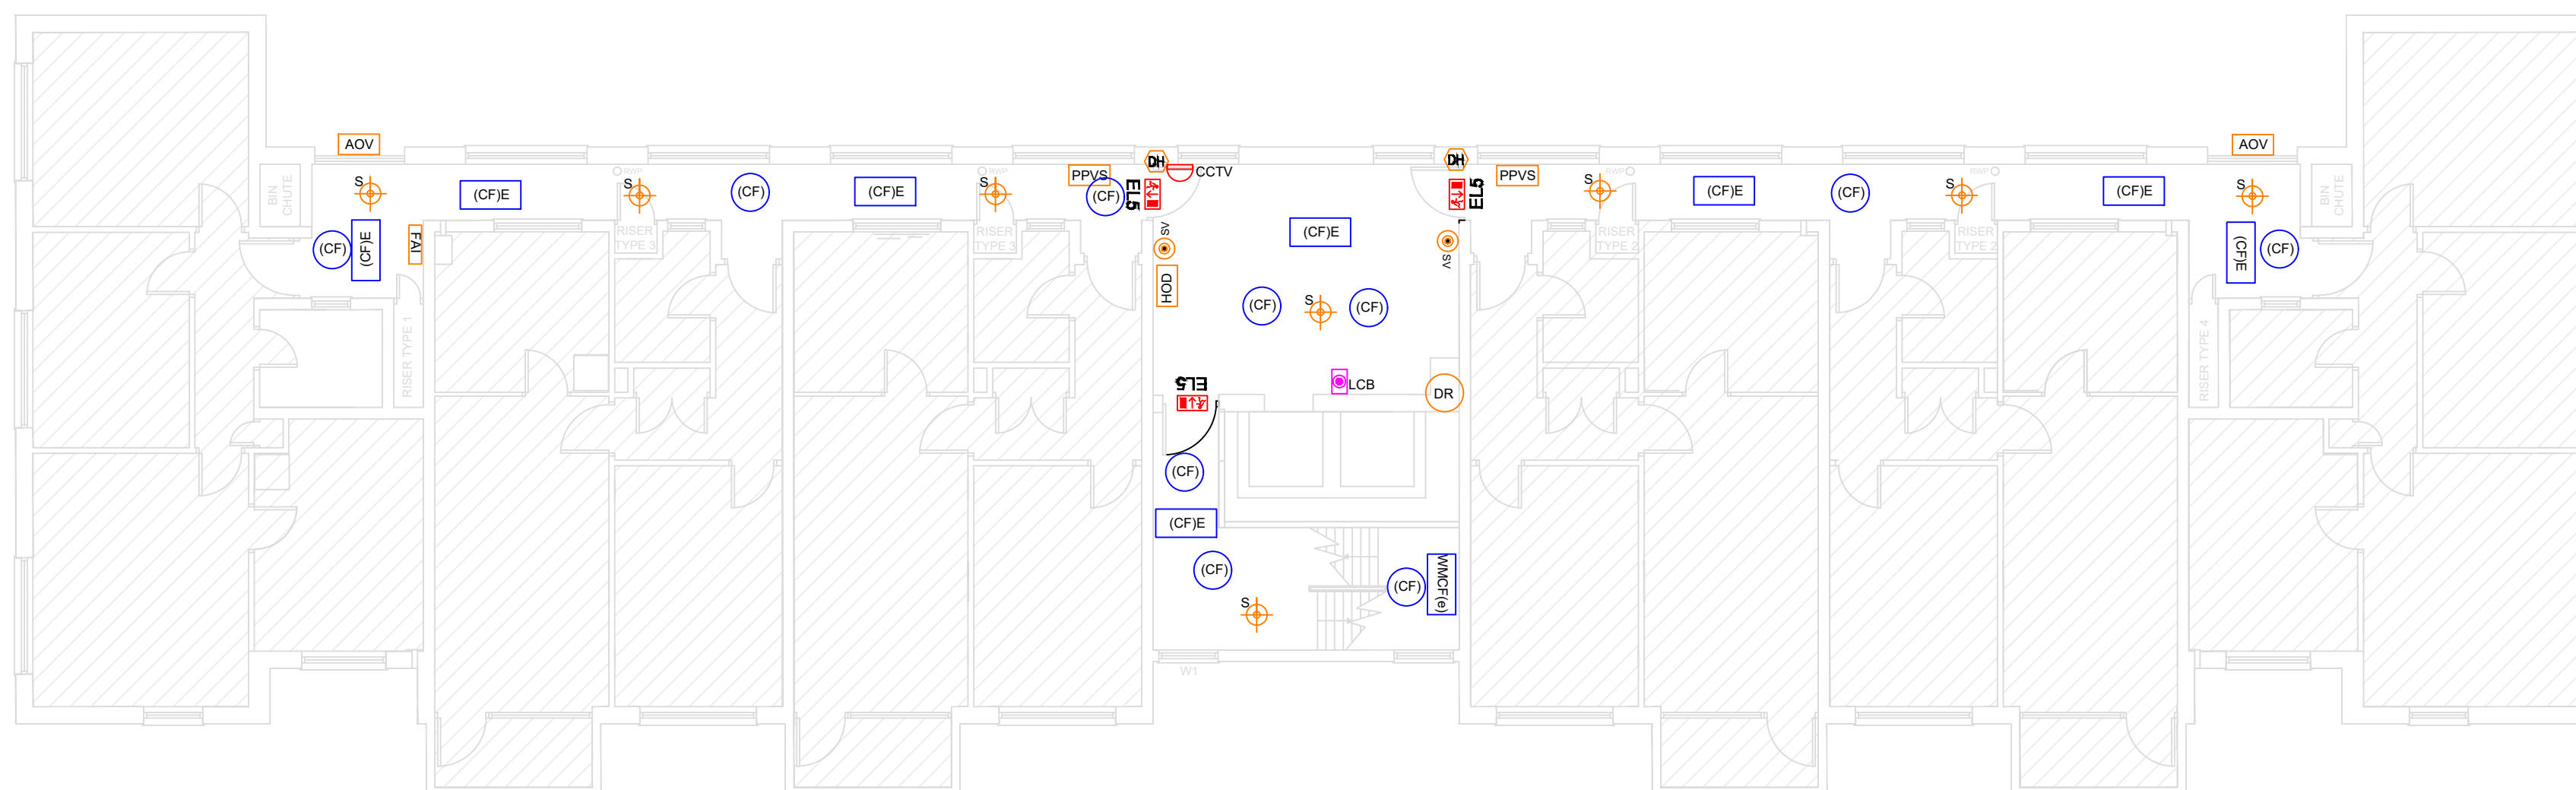

5th Floor

Risers

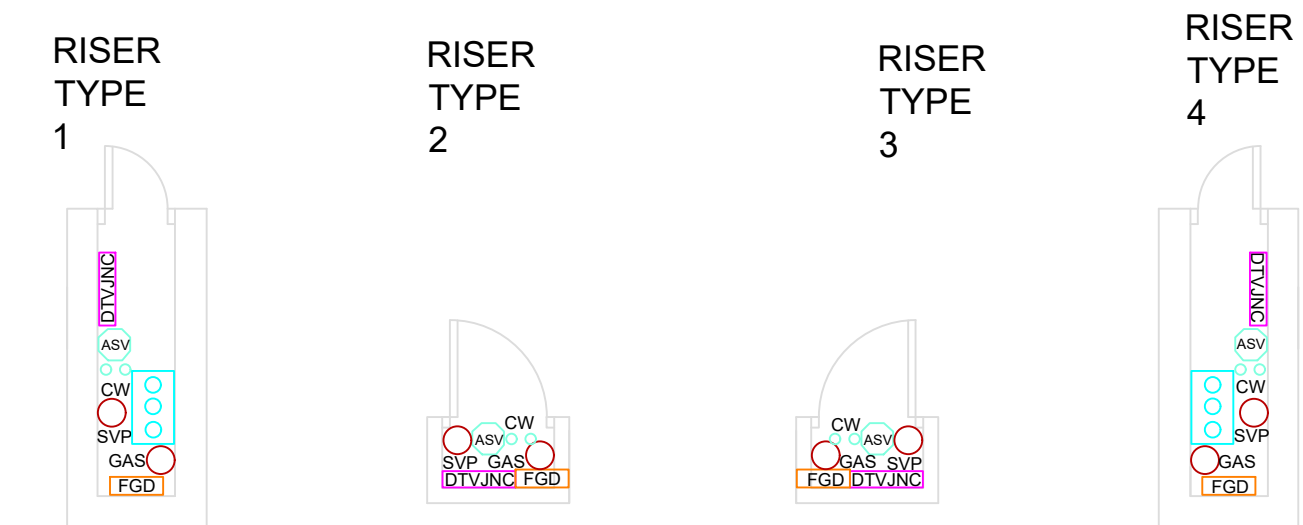

Key

LIGHTING	
 EL5	WALL MOUNTED DIRECTIONAL ESCAPE MAINTAINED LIGHT FITTING WITH LEGEND
 (CF)	INTERNAL LIGHT FITTING- BULKHEAD MAINTAINED- COMPACT FLUORESCENT - CIRCULAR TYPE
 (CF)E	INTERNAL LIGHT FITTING- BULKHEAD (NON-MAINTAINED- EMERGENCY COMPACT FLUORESCENT - STANDARD TYPE)

ELECTRICAL MAINS DISTRIBUTION

	MAINS ELECTRIC FEED
---	---------------------

FIRE

	DRY RISER
	SMOKE DETECTOR HEAD
	FIRE ALARM INTERFACE
	SMOKE VENT CONTROL ACTIVATION POINT
	POSITIVE PRESSURE VENTILATION SYSTEM
	ELECTROMAGNETIC DOOR HOLD-OPEN
	FLAMMABLE GAS DETECTOR
	DOOR HOLD-OPEN DEFENSE INTERFACE
	AUTOMATIC OPENING VENT

SECURITY AND ACCESS CONTROL SYSTEMS

 CCTV CCTV CAMERA CEILING MOUNTED (DOME)

SERVICES

	GAS	GAS RISING MAIN
	RWP	RAINWATER PIPE
	SVP	SOIL VENT PIPE

HOT AND COLD WATER DISTRIBUTION AND HEATING

	ANTI-SHOCK VALVE
	COLD WATER SUPPLY

COMMUNICATIONS

DTV JNC DIGITAL TELEVISION JUNCTION BOX

NOTES:

1. DRAWINGS TO BE READ IN CONJUNCTION WITH ALL SERVICES AND STRUCTURAL ENGINEERS DRAWINGS & SPECIFICATIONS.
2. © COPYRIGHT. DRAWINGS NOT TO BE REPRODUCED OR USED WITHOUT PRIOR WRITTEN CONSENT.

SCALE @A1	DATE	DRAWN BY	CHECKED BY
1:100	OCT14	JW	BM

DRAWING
Ashton Park- Mechanical and Electrical
Installations- Fourth and Fifth Floors

PROJECT
KHT Mechanical and Electrical Record Drawings

CLIENT
Knowsley Housing Trust

RIDGE

8TH FLOOR
HORTON HOUSE
EXCHANGE FLAGS
LIVERPOOL
L2 3YL

TEL: 01512433526
FAX: TBFAX

www.ridge.co.uk

DRG NO 142529/AP/4F5F	REV -
--------------------------	----------

FILE REFERENCE:
Ashton Park

XREF FILE REFERENCE:

