



ASHTON PARK
6th Floor and 7th Floor Layout

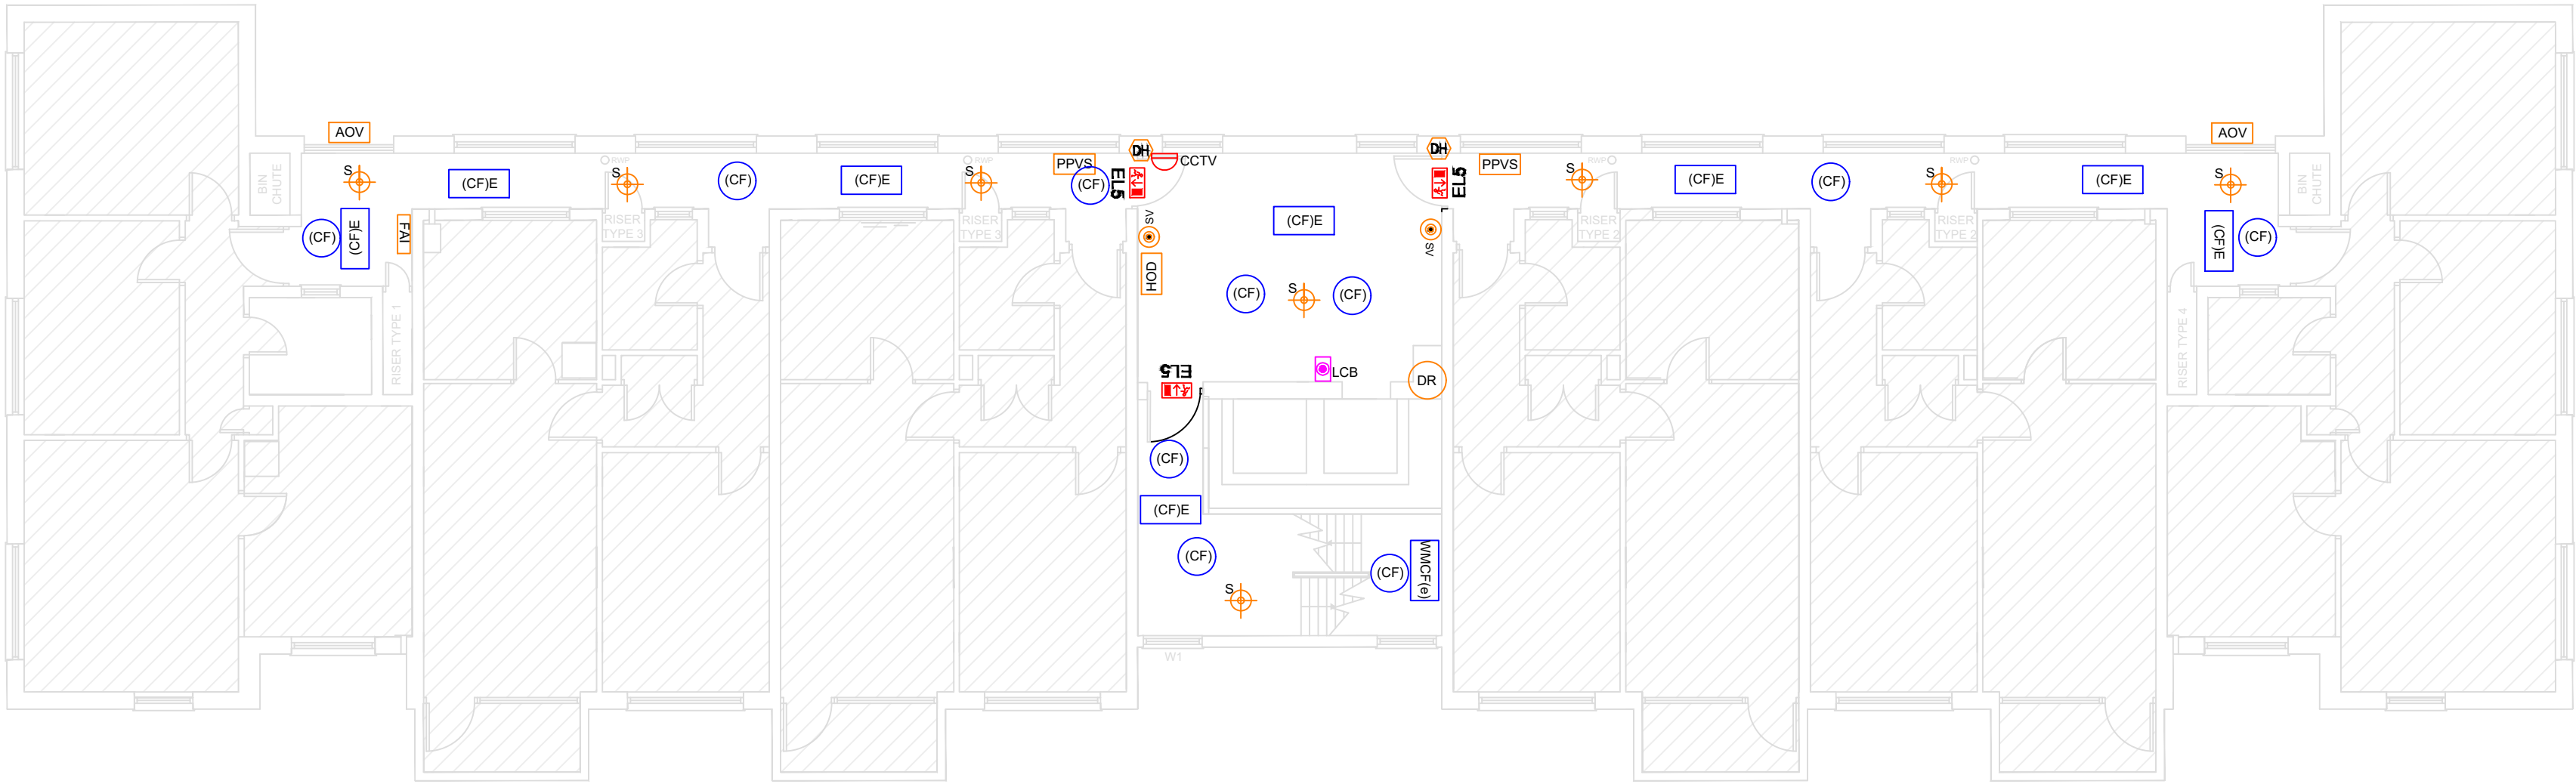


6th Floor

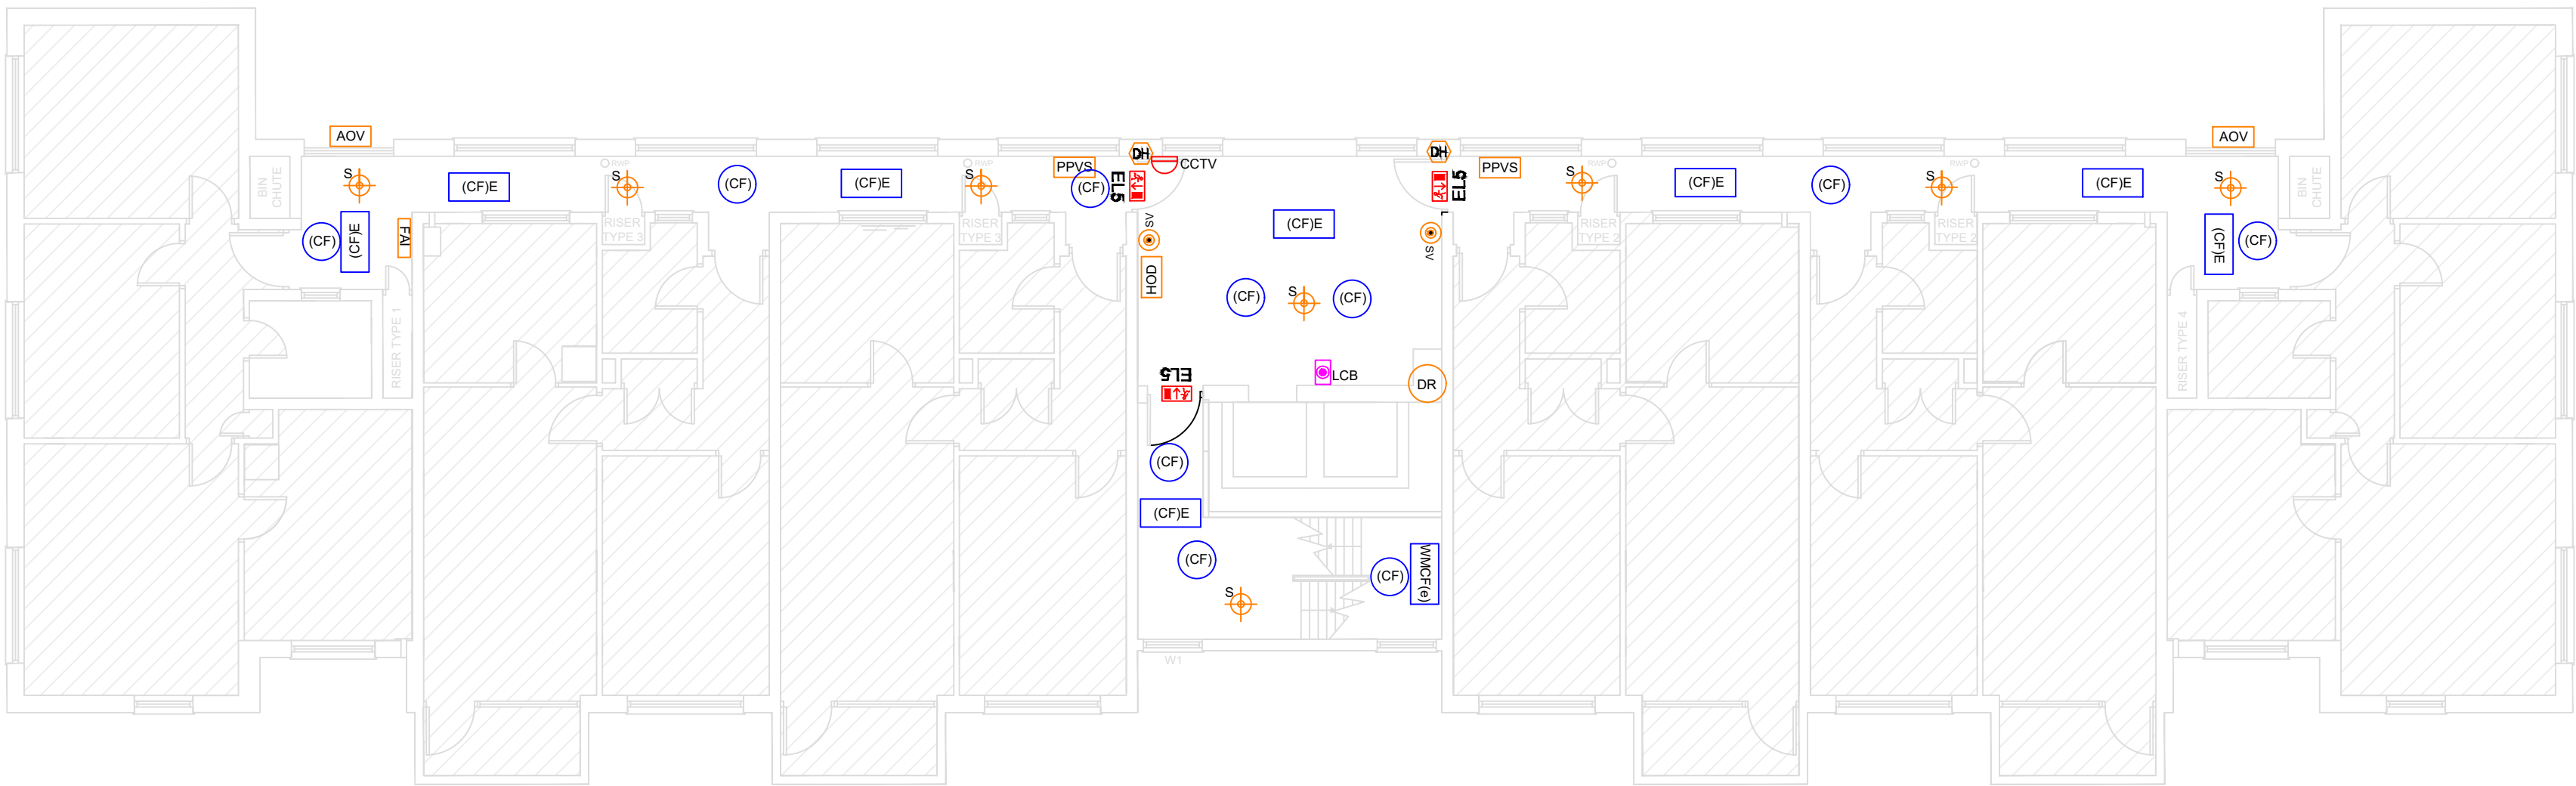

7th Floor

Risers

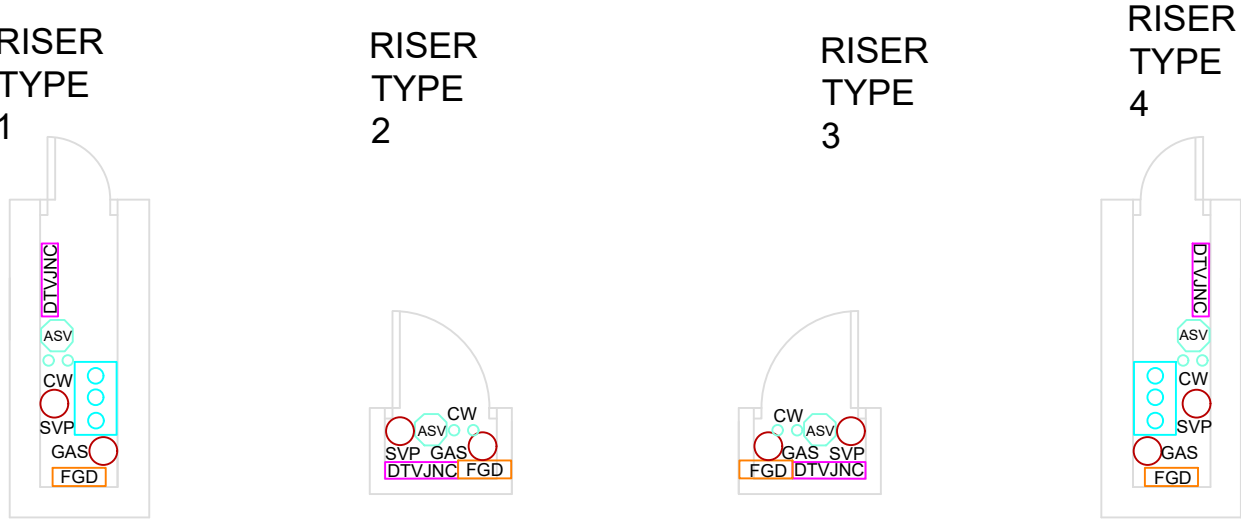

Key

LIGHTING	
WALL MOUNTED DIRECTIONAL ESCAPE MAINTAINED LIGHT FITTING WITH LEGEND	
INTERNAL LIGHT FITTING- BULKHEAD MAINTAINED- COMPACT FLUORESCENT - CIRCULAR TYPE	
INTERNAL LIGHT FITTING- BULKHEAD (NON-MAINTAINED- EMERGENCY COMPACT FLUORESCENT - STANDARD TYPE)	

ELECTRICAL MAINS DISTRIBUTION	
MAINS ELECTRIC FEED	

FIRE	
DRY RISER	
SMOKE DETECTOR HEAD	
FIRE ALARM INTERFACE	
SMOKE VENT CONTROL ACTIVATION POINT	
POSITIVE PRESSURE VENTILATION SYSTEM	
ELECTROMAGNETIC DOOR HOLD-OPEN	
FLAMMABLE GAS DETECTOR	
DOOR HOLD-OPEN DEVICE INTERFACE	
AUTOMATIC OPENING VENT	

SECURITY AND ACCESS CONTROL SYSTEMS	
CCTV CAMERA CEILING MOUNTED (DOME)	

SERVICES	
GAS RISING MAIN	
RAINWATER PIPE	
SOIL VENT PIPE	

HOT AND COLD WATER DISTRIBUTION AND HEATING	
ANTI-SHOCK VALVE	
COLD WATER SUPPLY	

COMMUNICATIONS	
LIFT CALL BUTTON	
DIGITAL TELEVISION JUNCTION BOX	

- NOTES:
- DRAWINGS TO BE READ IN CONJUNCTION WITH ALL SERVICES AND STRUCTURAL ENGINEERS DRAWINGS & SPECIFICATIONS.
 - © COPYRIGHT. DRAWINGS NOT TO BE REPRODUCED OR USED WITHOUT PRIOR WRITTEN CONSENT.

SCALE @A1 DATE DRAWN BY CHECKED BY
1:100 OCT14 JW BM

DRAWING
Ashton Park- Mechanical and Electrical
Installations- Sixth and Seventh Floors

PROJECT
KHT Mechanical and Electrical Record Drawings

CLIENT
Knowsley Housing Trust

RIDGE

8TH FLOOR
HORTON HOUSE
EXCHANGE FLAGS
LIVERPOOL
L2 3YL
TEL: 01512433526
FAX: TBFAX
www.ridge.co.uk

DRG NO
142528/AP/67F

REV
-

FILE REFERENCE:
Ashton Park

XREF FILE REFERENCE:

1 0 1 2 3 4 5
SCALE 1:100 m