


ASHTON PARK
8th Floor Layout

Risers

RISER
TYPE
1

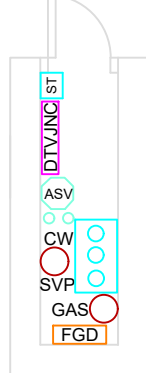



RISER
TYPE
2



RISER
TYPE
3



RISER
TYPE
4

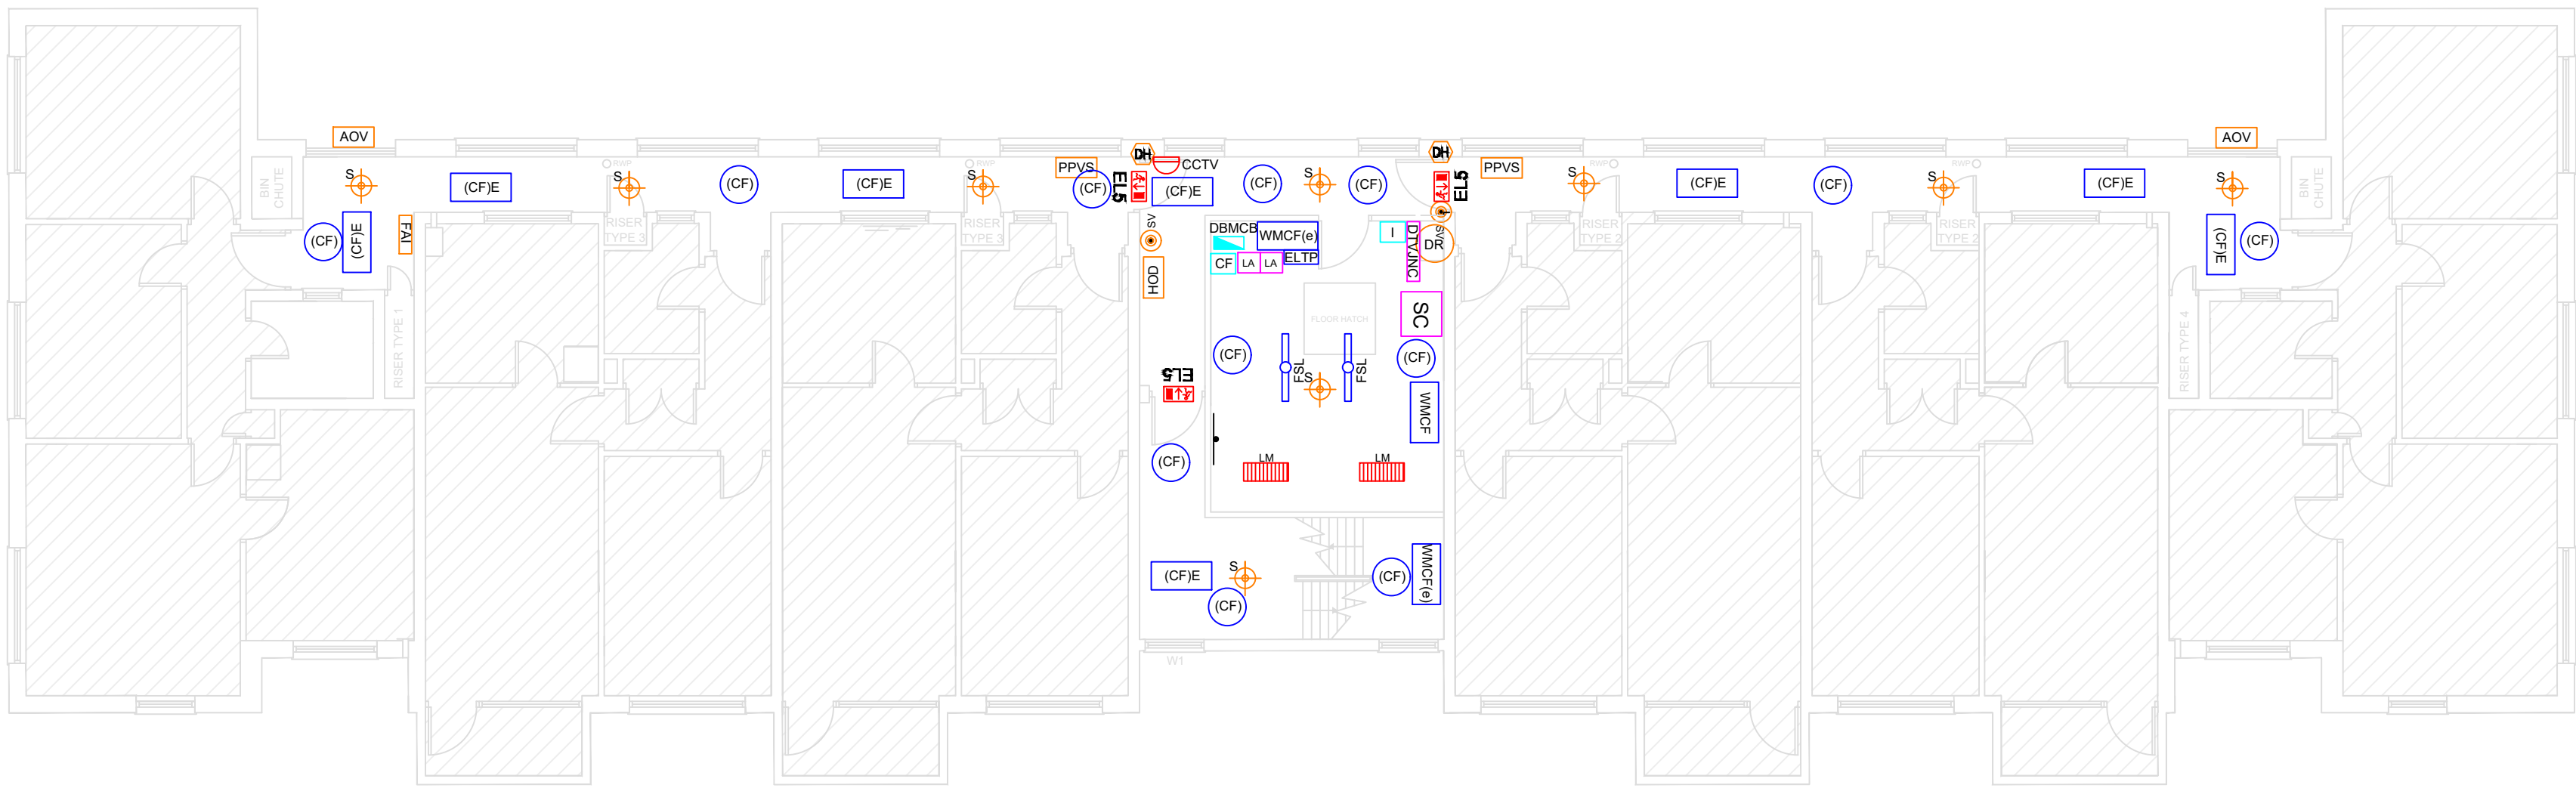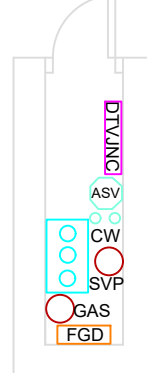

8th Floor

Key

LIGHTING	
ELB	WALL MOUNTED DIRECTIONAL ESCAPE MAINTAINED LIGHT FITTING WITH LEGEND
(CF)	INTERNAL LIGHT FITTING- BULKHEAD MAINTAINED- COMPACT FLUORESCENT - CIRCULAR TYPE
(CFIE)	INTERNAL LIGHT FITTING- BULKHEAD (NON-MAINTAINED- EMERGENCY COMPACT FLUORESCENT - STANDARD TYPE)
FSL	INTERNAL LIGHT FITTING- FLUORESCENT STRIP LIGHT (NON-MAINTAINED - STANDARD TYPE)
(WMCF)	INTERNAL LIGHT FITTING- WALL MOUNTED FLUORESCENT) BULKHEAD (NON-MAINTAINED- COMPACT
(WMCF)	INTERNAL LIGHT FITTING- WALL MOUNTED EMERGENCY COMPACT FLUORESCENT BULKHEAD NON MAINTAINED
ELTP	EMERGENCY LIGHTING TEST POINT

ELECTRICAL MAINS DISTRIBUTION

MEF	MAINS ELECTRIC FEED
CF	CARTRIDGE FUSE
DBMCB	DISTRIBUTION BOARD- MCB PROTECTION
I	ISOLATOR SWITCH
ST	SOLAR TRACKER INTERFACE

FIRE

DR	DRY RISER
SDH	SMOKE DETECTOR HEAD
FAL	FIRE ALARM INTERFACE
SV	SMOKE VENT CONTROL ACTIVATION POINT
PPVS	POSITIVE PRESSURE VENTILATION SYSTEM
EH	ELECTROMAGNETIC DOOR HOLD-OPEN
FGD	FLAMMABLE GAS DETECTOR
HOD	DOOR HOLD-OPEN DEVICE INTERFACE
AOV	AUTOMATIC OPENING VENT

LIFTS

LM	LIFT MOTOR
----	------------

SECURITY AND ACCESS CONTROL SYSTEMS

CCTV	CCTV CAMERA CEILING MOUNTED (DOME)
------	------------------------------------

SERVICES

GAS	GAS RISING MAIN
RWP	RAINWATER PIPE
SVP	SOIL VENT PIPE

HOT AND COLD WATER DISTRIBUTION AND HEATING

ASV	ANTI-SHOCK VALVE
CW	COLD WATER SUPPLY
T	THERMOSTAT

COMMUNICATIONS

LCB	LIFT CALL BUTTON
DTVJNC	DIGITAL TELEVISION JUNCTION BOX
LA	LIFT ALARM

NOTES:

- DRAWINGS TO BE READ IN CONJUNCTION WITH ALL SERVICES AND STRUCTURAL ENGINEERS DRAWINGS & SPECIFICATIONS
- © COPYRIGHT. DRAWINGS NOT TO BE REPRODUCED OR USED WITHOUT PRIOR WRITTEN CONSENT.

SCALE @A1 DATE DRAWN BY CHECKED BY
1:100 OCT14 JW BM

DRAWING
Ashton Park- Mechanical and Electrical
Installations- Eighth Floor

PROJECT
KHT Mechanical and Electrical Record Drawings

CLIENT
Knowsley Housing Trust

RIDGE

8TH FLOOR
HORTON HOUSE
EXCHANGE FLAGS
LIVERPOOL
L2 3YL
TEL: 01512433526
FAX: TBFAX
www.ridge.co.uk

DRG NO
142528/AP/8F

REV
-

FILE REFERENCE:
Ashton Park

XREF FILE REFERENCE:

1 0 1 2 3 4 5
SCALE 1:100 m