

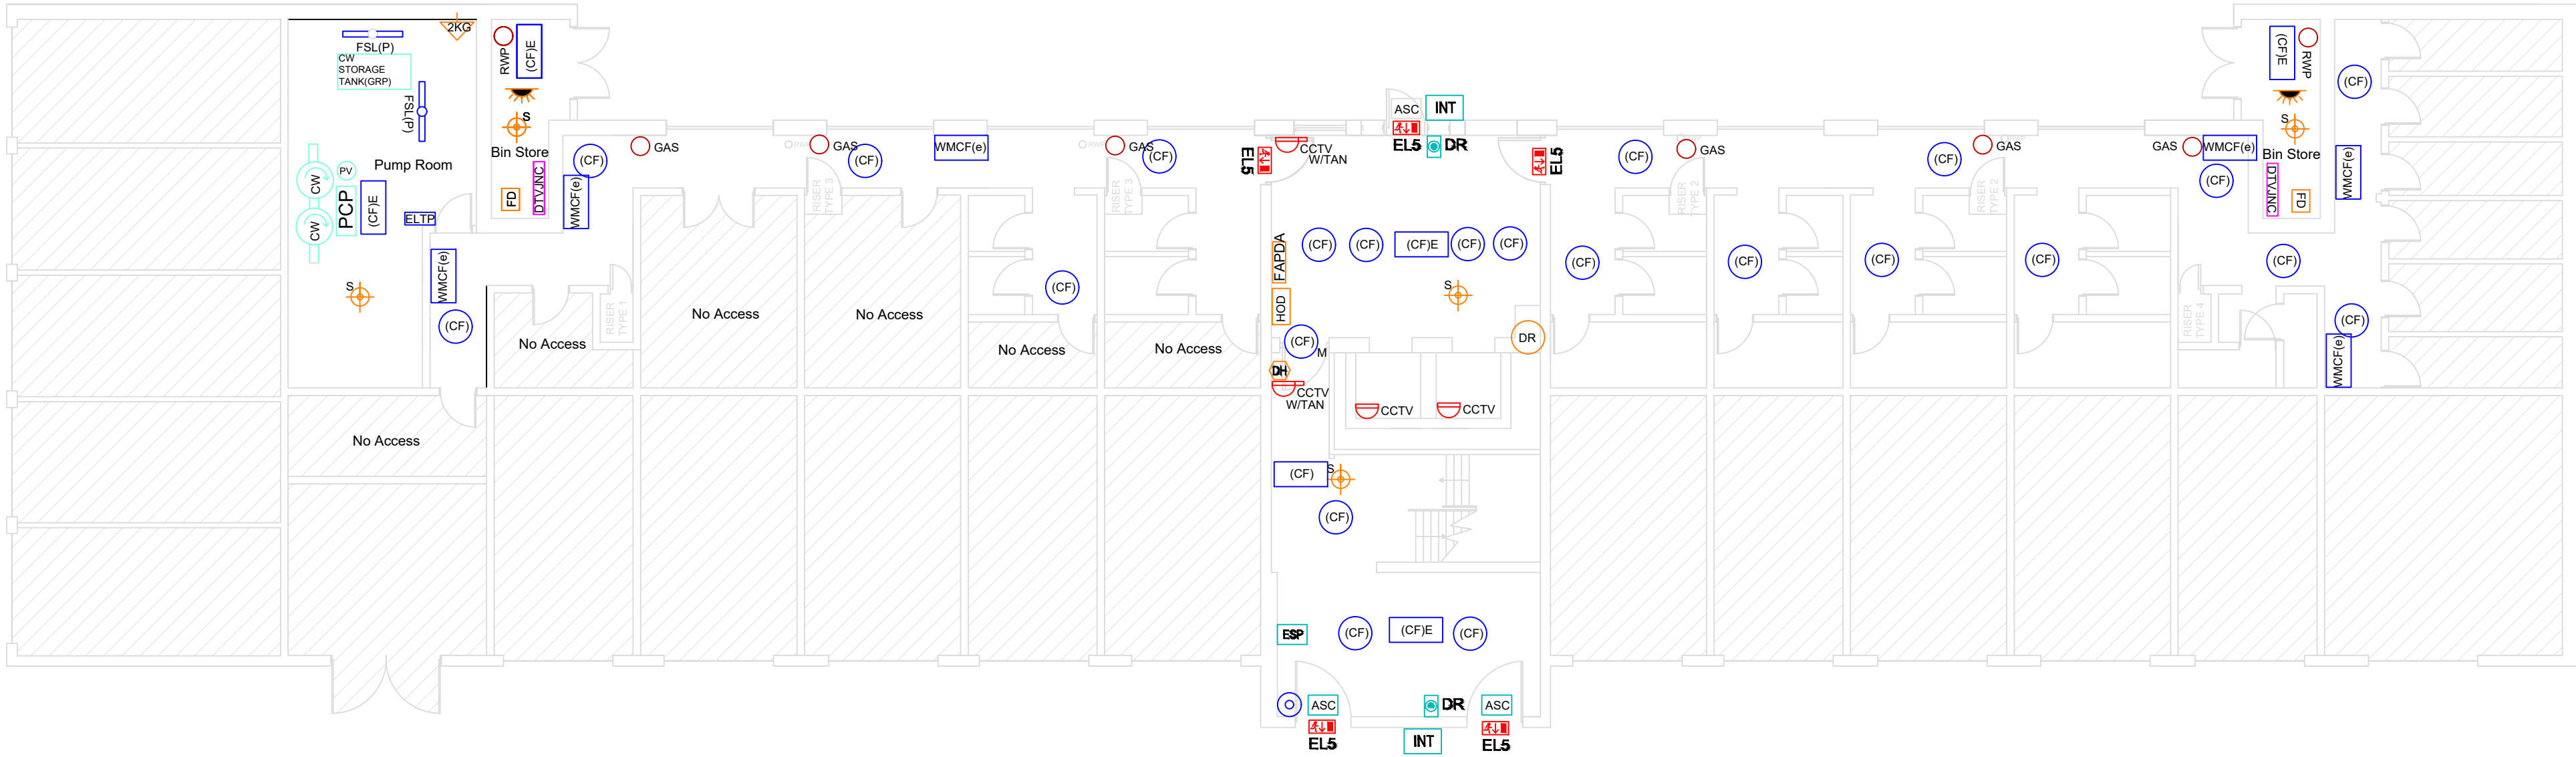


ASHTON PARK
Ground Floor and 1st Floor Layout

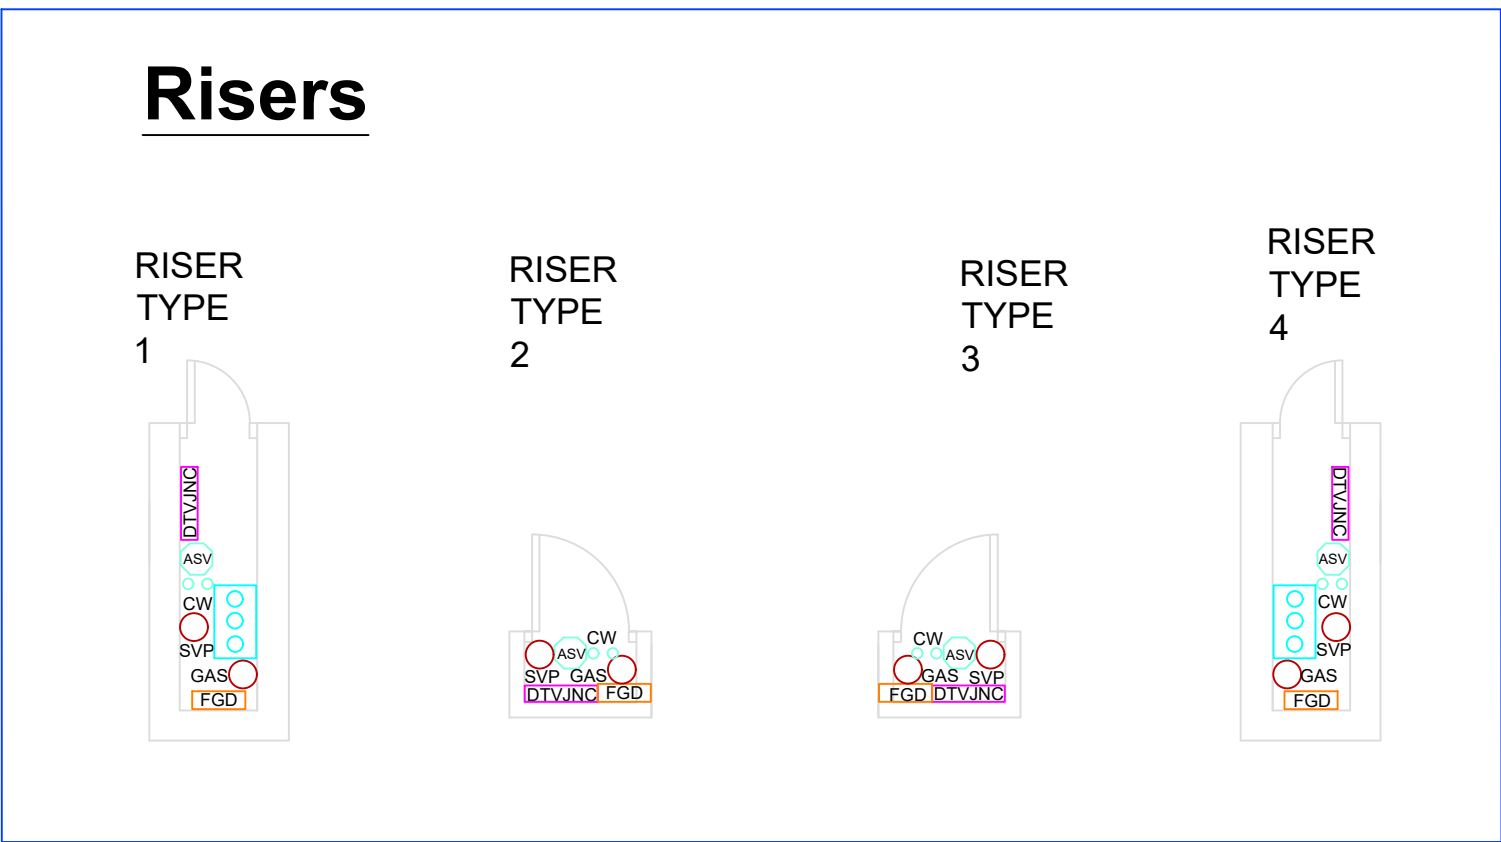

Ground Floor

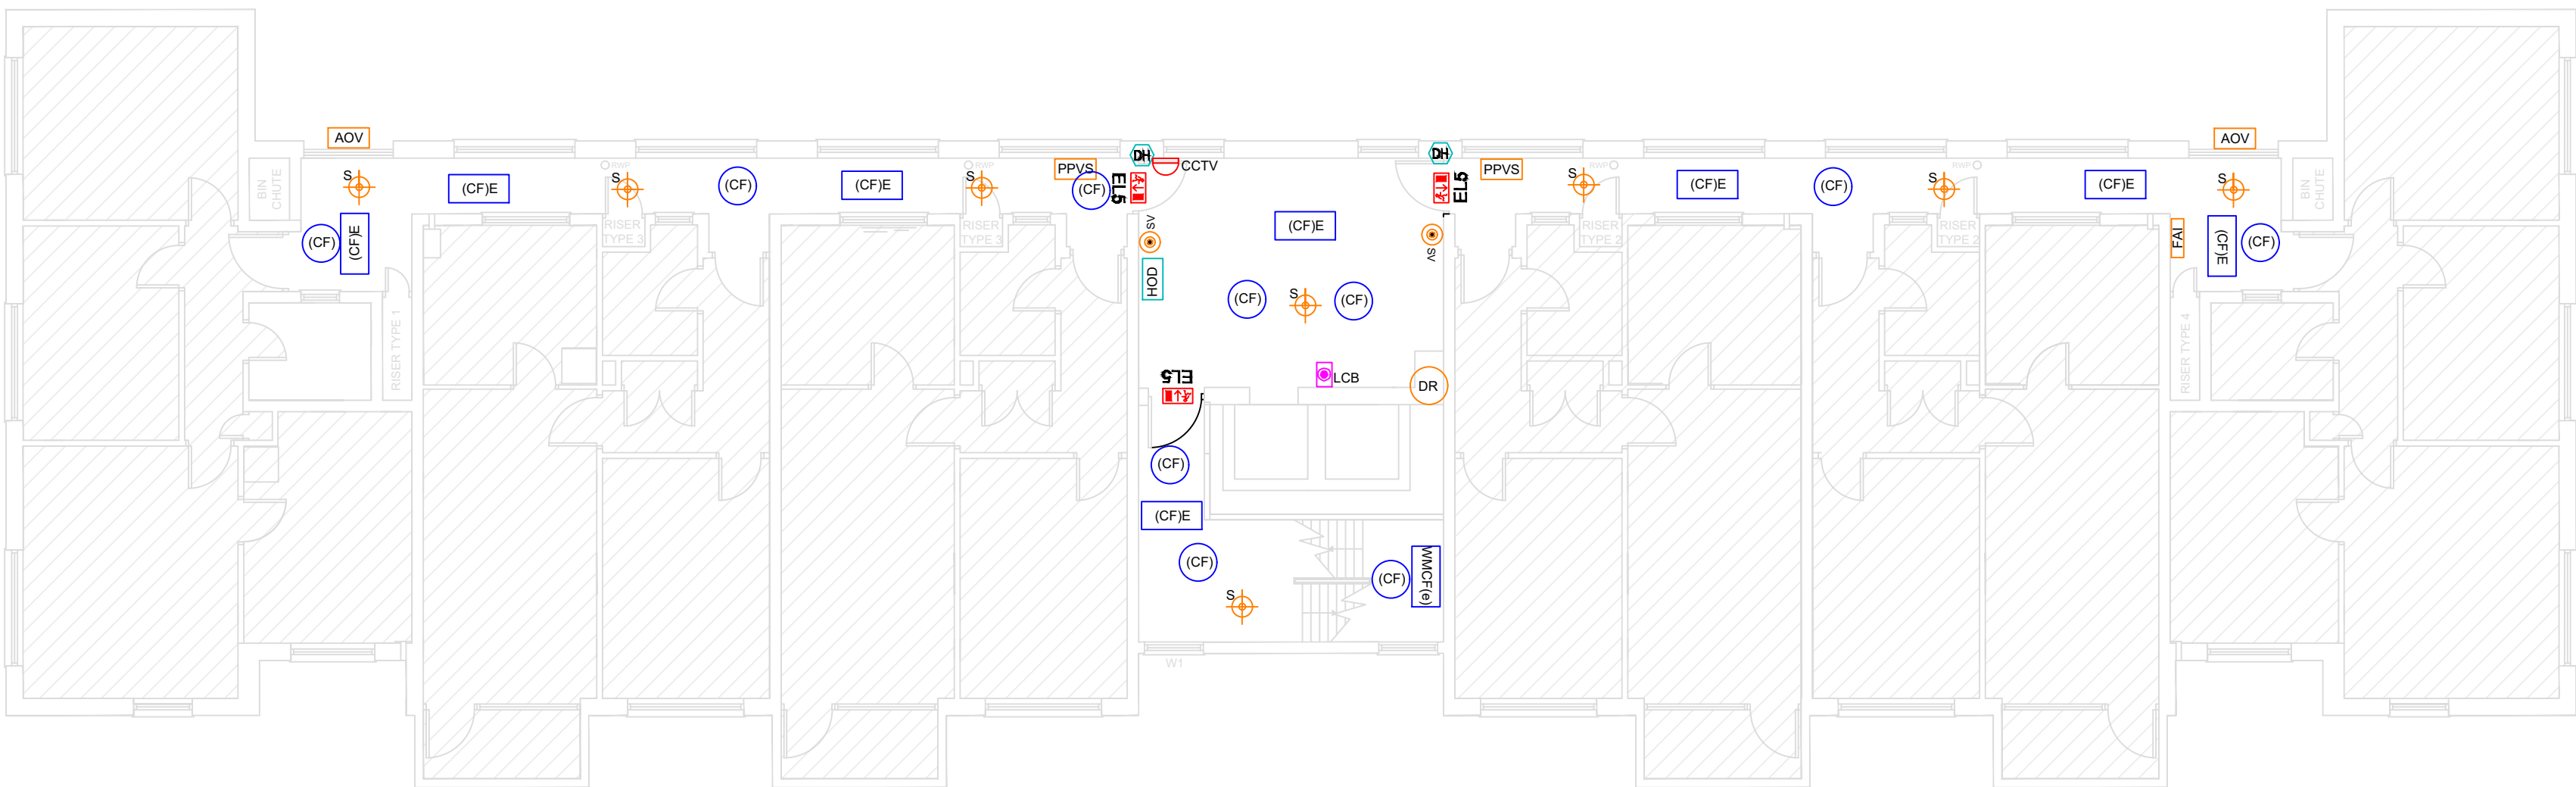

1st Floor

Key

	LIGHTING
	WALL MOUNTED DIRECTIONAL ESCAPE MAINTAINED FITTING WITH LEGEND
	INTERNAL LIGHT FITTING- BULKHEAD MAINTAINED- COMPACT FLUORESCENT - CIRCULAR TYPE
	INTERNAL LIGHT FITTING- BULKHEAD (NON-MAINTAINED)- EMERGENCY COMPACT FLUORESCENT - STANDARD TYPE
	INTERNAL LIGHT FITTING- FLUORESCENT STRIP LIGHT (NON-MAINTAINED - STANDARD TYPE WITH POLYCARBONATE DIFFUSER)
	EMERGENCY LIGHTING TEST POINT
	INTERNAL LIGHT FITTING- WALL MOUNTED FLUORESCENT) BULKHEAD (NON-MAINTAINED- COMPACT
	SAFETY PIR SENSOR

LIGHTNING PROTECTION

	CONDUCTORS/DOWNTAPES
--	----------------------

ELECTRICAL MAINS DISTRIBUTION

	MAINS ELECTRIC FEED
--	---------------------

FIRE

	DRY RISER
	SMOKE DETECTOR HEAD
	FIRE ALARM CONTROL PANEL (CONVENTIONAL)
	PORTABLE FIRE EXTINGUISHER (CO2)
	FIRE ALARM INTERFACE
	SMOKE VENT CONTROL ACTIVATION POINT
	SPRINKLER HEAD
	FIRE DAMPER
	POSITIVE PRESSURE VENTILATION SYSTEM
	ELECTROMAGNETIC DOOR HOLD-OPEN
	FLAMMABLE GAS DETECTOR
	DOOR HOLD-OPEN DEVICE INTERFACE
	AUTOMATIC OPENING VENT

SECURITY AND ACCESS CONTROL SYSTEMS

	CCTV CAMERA CEILING MOUNTED (DOME)
	CCTV CAMERA WITH TANOY
	DOOR RELEASE BUTTON
	INTERCOM- 2 WAY SPEECH CW KEYPAD AND FOB READER
	AUTOMATIC SELF CLOSER
	ELECTRIC STRIKE PLATE

SERVICES

	GAS RISING MAIN
	RAINWATER PIPE
	SOIL VENT PIPE

HOT AND COLD WATER DISTRIBUTION AND HEATING

	CW BOOSTER PUMP SET
	CW STORAGE TANK (GRP)
	ANTI-SHOCK VALVE
	PRESSURE VESSEL
	PUMP CONTROL PANEL
	COLD WATER SUPPLY

COMMUNICATIONS

	LIFT CALL BUTTON
	DIGITAL TELEVISION JUNCTION BOX

NOTES:

1. DRAWINGS TO BE READ IN CONJUNCTION WITH ALL SERVICES AND STRUCTURAL ENGINEERS DRAWINGS & SPECIFICATIONS.

2. © COPYRIGHT. DRAWINGS NOT TO BE REPRODUCED OR USED WITHOUT PRIOR WRITTEN CONSENT.

SCALE @A1 DATE DRAWN BY CHECKED BY
1:100 OCT14 JW BM

DRAWING
Ashton Park- Mechanical and Electrical
Installations- Ground and First Floors

PROJECT
KHT Mechanical and Electrical Record Drawings

CLIENT
Knowsley Housing Trust

RIDGE

8TH FLOOR
HORTON HOUSE
EXCHANGE FLAGS
LIVERPOOL
L2 3YL

TEL: 01512433526
FAX: TBFAX
www.ridge.co.uk

DRG NO
142528/AP/GF1F

FILE REFERENCE:
Ashton Park

XREF FILE REFERENCE:

