


ASHTON PARK
Roof Plan

Key

 COMMUNAL TV AERIEL

- NOTES:
- 1. DRAWINGS TO BE READ IN CONJUNCTION WITH ALL SERVICES AND STRUCTURAL ENGINEERS DRAWINGS & SPECIFICATIONS.
 - 2. © COPYRIGHT. DRAWINGS NOT TO BE REPRODUCED OR USED WITHOUT PRIOR WRITTEN CONSENT.

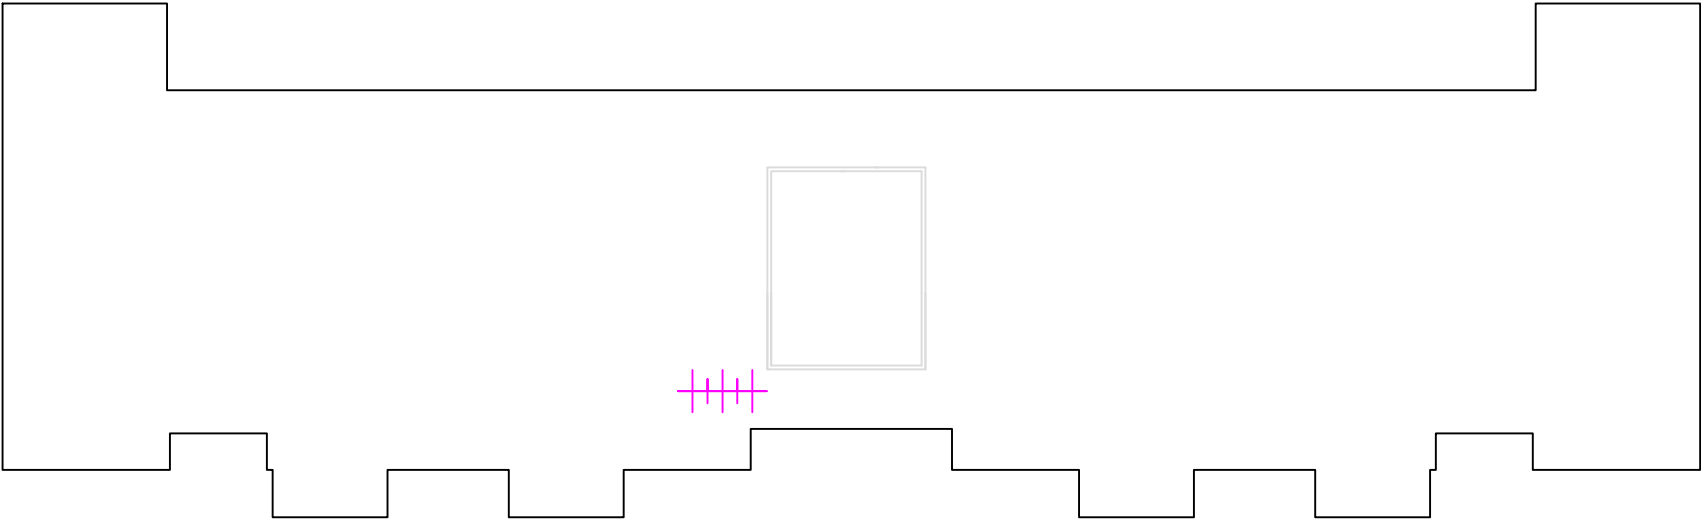

SCALE @A3	DATE	DRAWN BY	CHECKED BY
1:200	OCT14	JW	BM

DRAWING
Ashton Park- Mechanical and Electrical
Installations- Roof Plan

PROJECT
KHT Mechanical and Electrical Record Drawings

CLIENT
Knowsley Housing Trust

RIDGE

8TH FLOOR
HORTON HOUSE
EXCHANGE FLAGS
LIVERPOOL
L2 3YL

TEL: 01512433526
FAX: TBFAX
www.ridge.co.uk

DRG NO	REV
142529/AP/RP	-

FILE REFERENCE:
The Fairways

XREF FILE REFERENCE:

