



THE FAIRWAYS
4th Floor and 5th Floor Layout

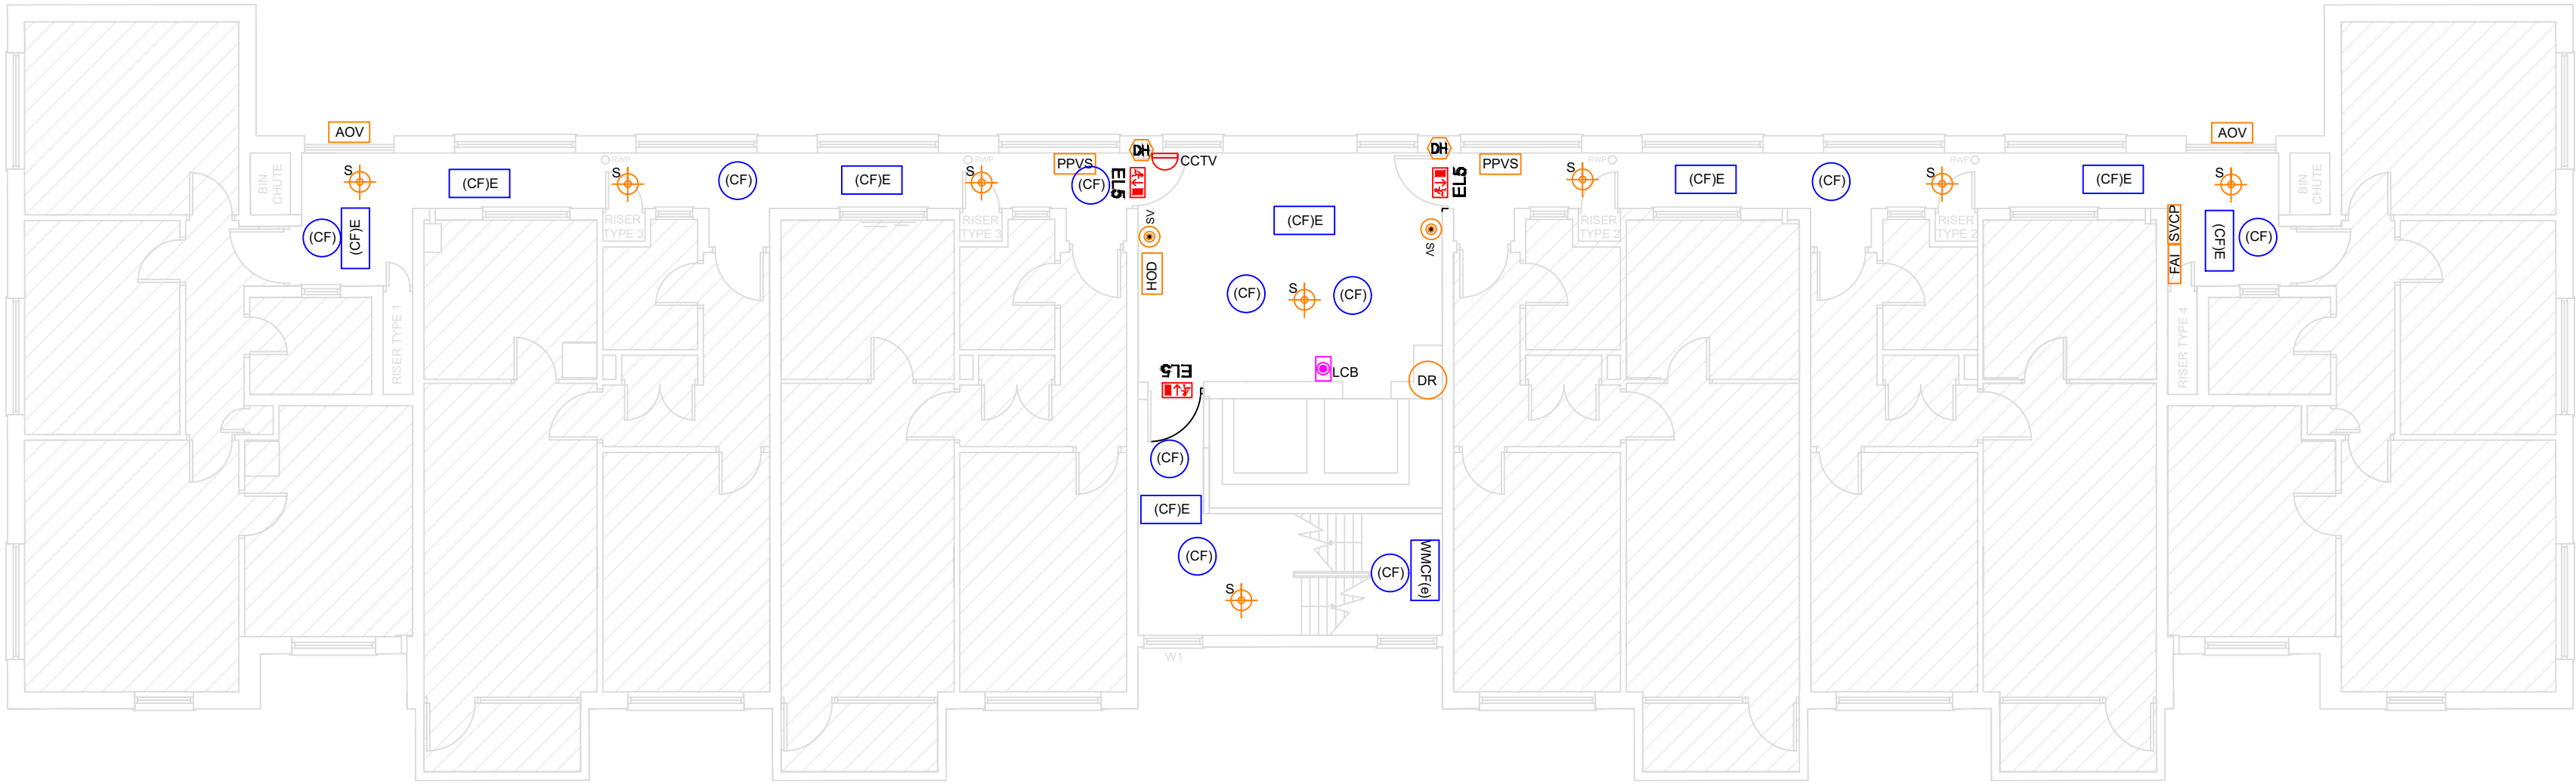


4th Floor

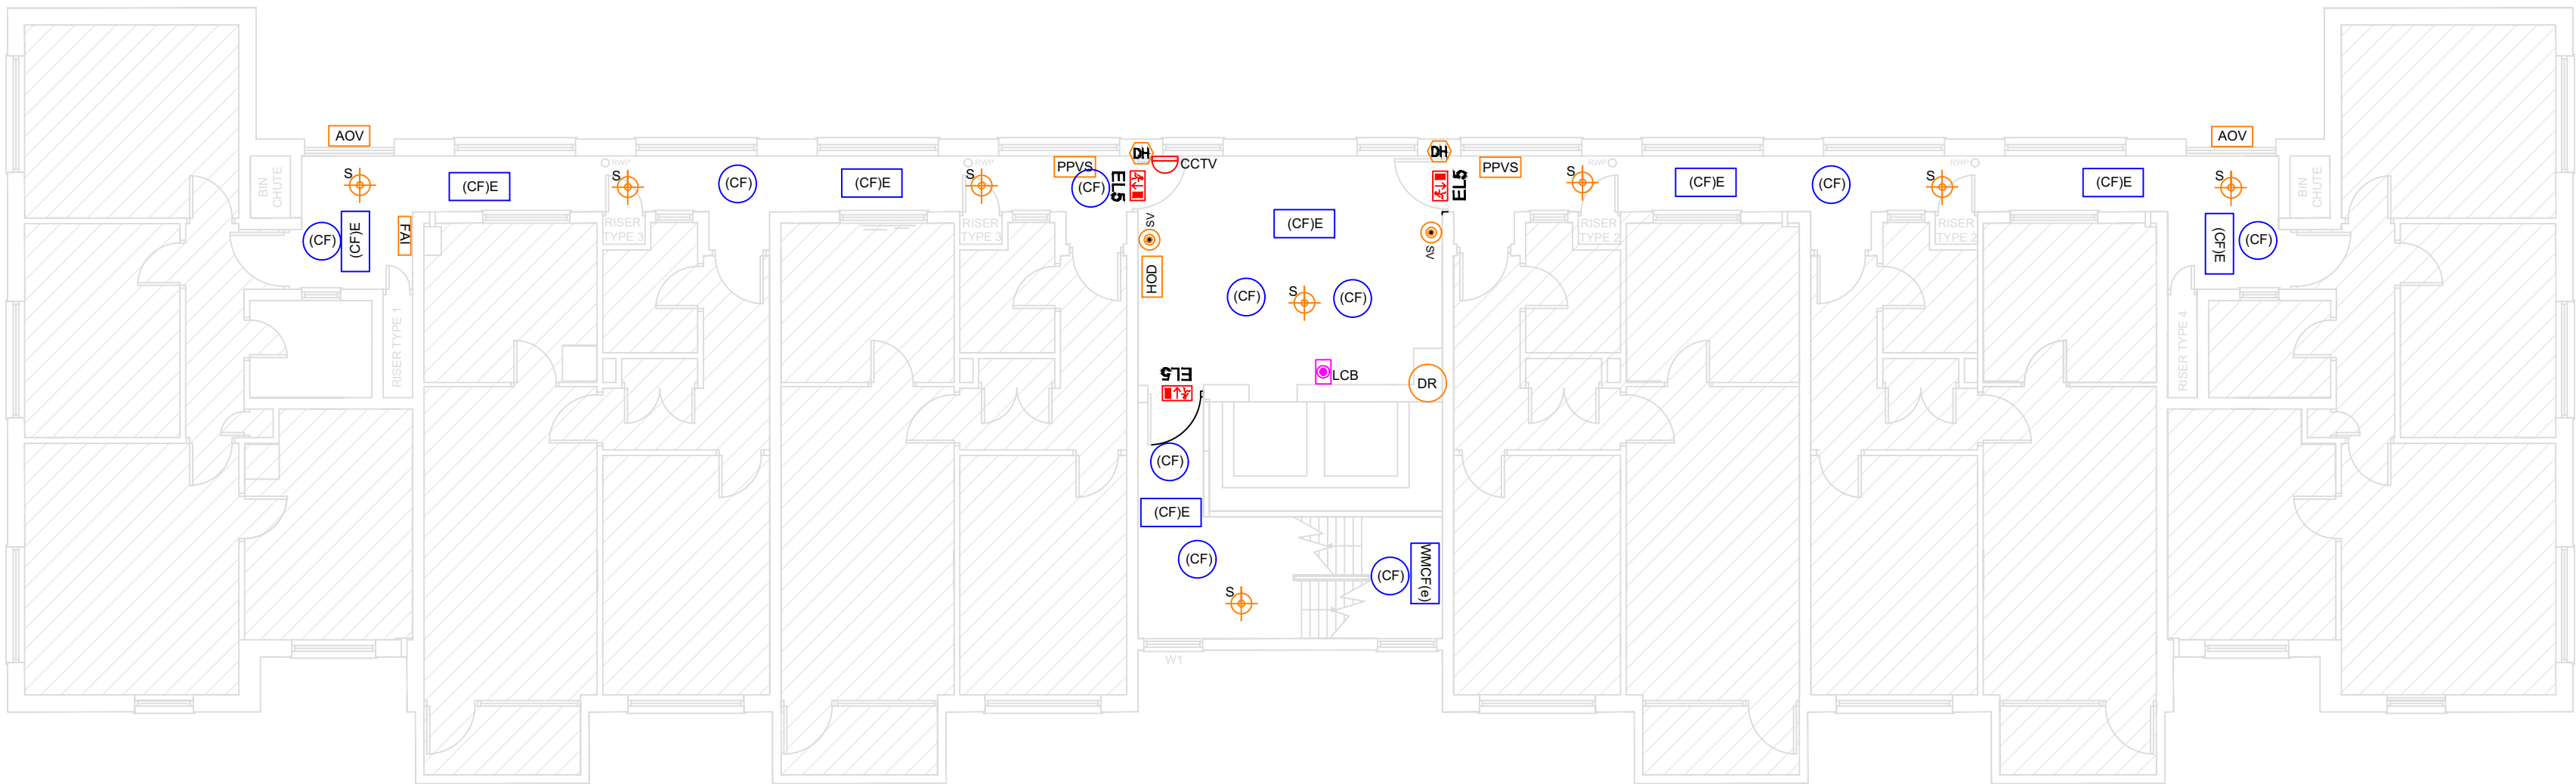

5th Floor

Risers

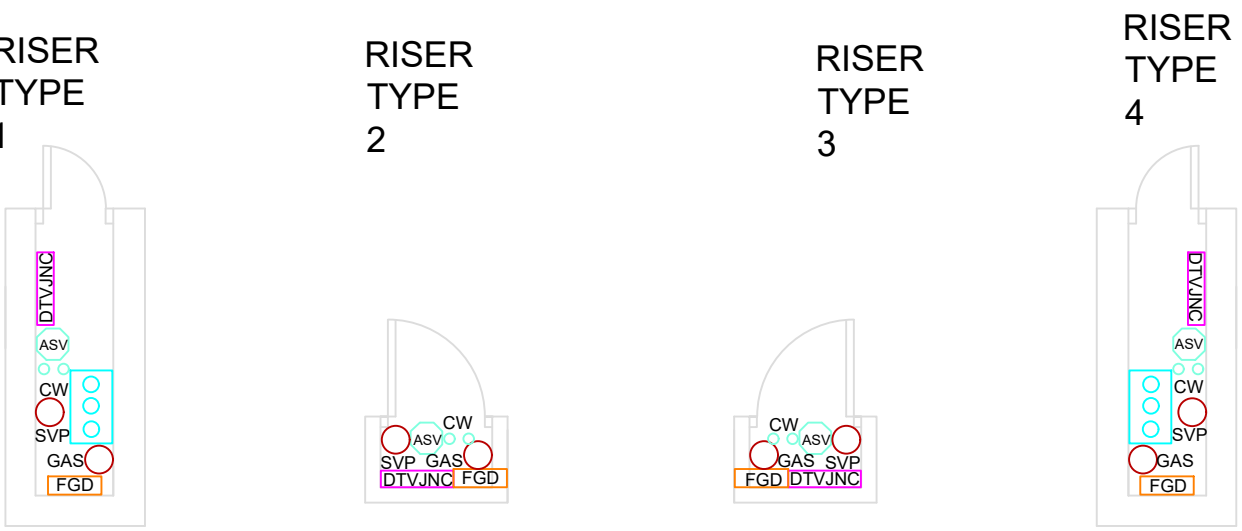

Key	
LIGHTING	
	WALL MOUNTED DIRECTIONAL ESCAPE MAINTAINED LIGHT FITTING WITH LEGEND
	INTERNAL LIGHT FITTING- BULKHEAD MAINTAINED- COMPACT FLUORESCENT - CIRCULAR TYPE
	INTERNAL LIGHT FITTING- BULKHEAD (NON-MAINTAINED- EMERGENCY COMPACT FLUORESCENT - STANDARD TYPE)
ELECTRICAL MAINS DISTRIBUTION	
	MAINS ELECTRIC FEED
FIRE	
	DRY RISER
	SMOKE DETECTOR HEAD
	FIRE ALARM INTERFACE
	SMOKE VENT CONTROL ACTIVATION POINT
	POSITIVE PRESSURE VENTILATION SYSTEM
	ELECTROMAGNETIC DOOR HOLD-OPEN
	FLAMMABLE GAS DETECTOR
	DOOR HOLD-OPEN DEVICE INTERFACE
	AUTOMATIC OPENING VENT
SECURITY AND ACCESS CONTROL SYSTEMS	
	CCTV CAMERA CEILING MOUNTED (DOME)
SERVICES	
	GAS RISING MAIN
	RAINWATER PIPE
	SOIL VENT PIPE
HOT AND COLD WATER DISTRIBUTION AND HEATING	
	ANTI-SHOCK VALVE
	COLD WATER SUPPLY
COMMUNICATIONS	
	LIFT CALL BUTTON
	DIGITAL TELEVISION JUNCTION BOX

- NOTES:
- DRAWINGS TO BE READ IN CONJUNCTION WITH ALL SERVICES AND STRUCTURAL ENGINEERS DRAWINGS & SPECIFICATIONS.
 - © COPYRIGHT. DRAWINGS NOT TO BE REPRODUCED OR USED WITHOUT PRIOR WRITTEN CONSENT.

SCALE @A1 1:100 DATE OCT14 DRAWN BY JW CHECKED BY BM

DRAWING
The Fairways- Mechanical and Electrical Installations- Fourth and Fifth Floors

PROJECT
KHT Mechanical and Electrical Record Drawings

CLIENT
Knowsley Housing Trust

RIDGE

8TH FLOOR
HORTON HOUSE
EXCHANGE FLAGS
LIVERPOOL
L2 3YL
TEL: 01512433526
FAX: TBFAX
www.ridge.co.uk

DRG NO. 142529/TF4H5F REV -

FILE REFERENCE:
The Fairways

XREF FILE REFERENCE:

1 0 1 2 3 4 5
SCALE 1:100 m