



THE FAIRWAYS
6th Floor and 7th Floor Layout

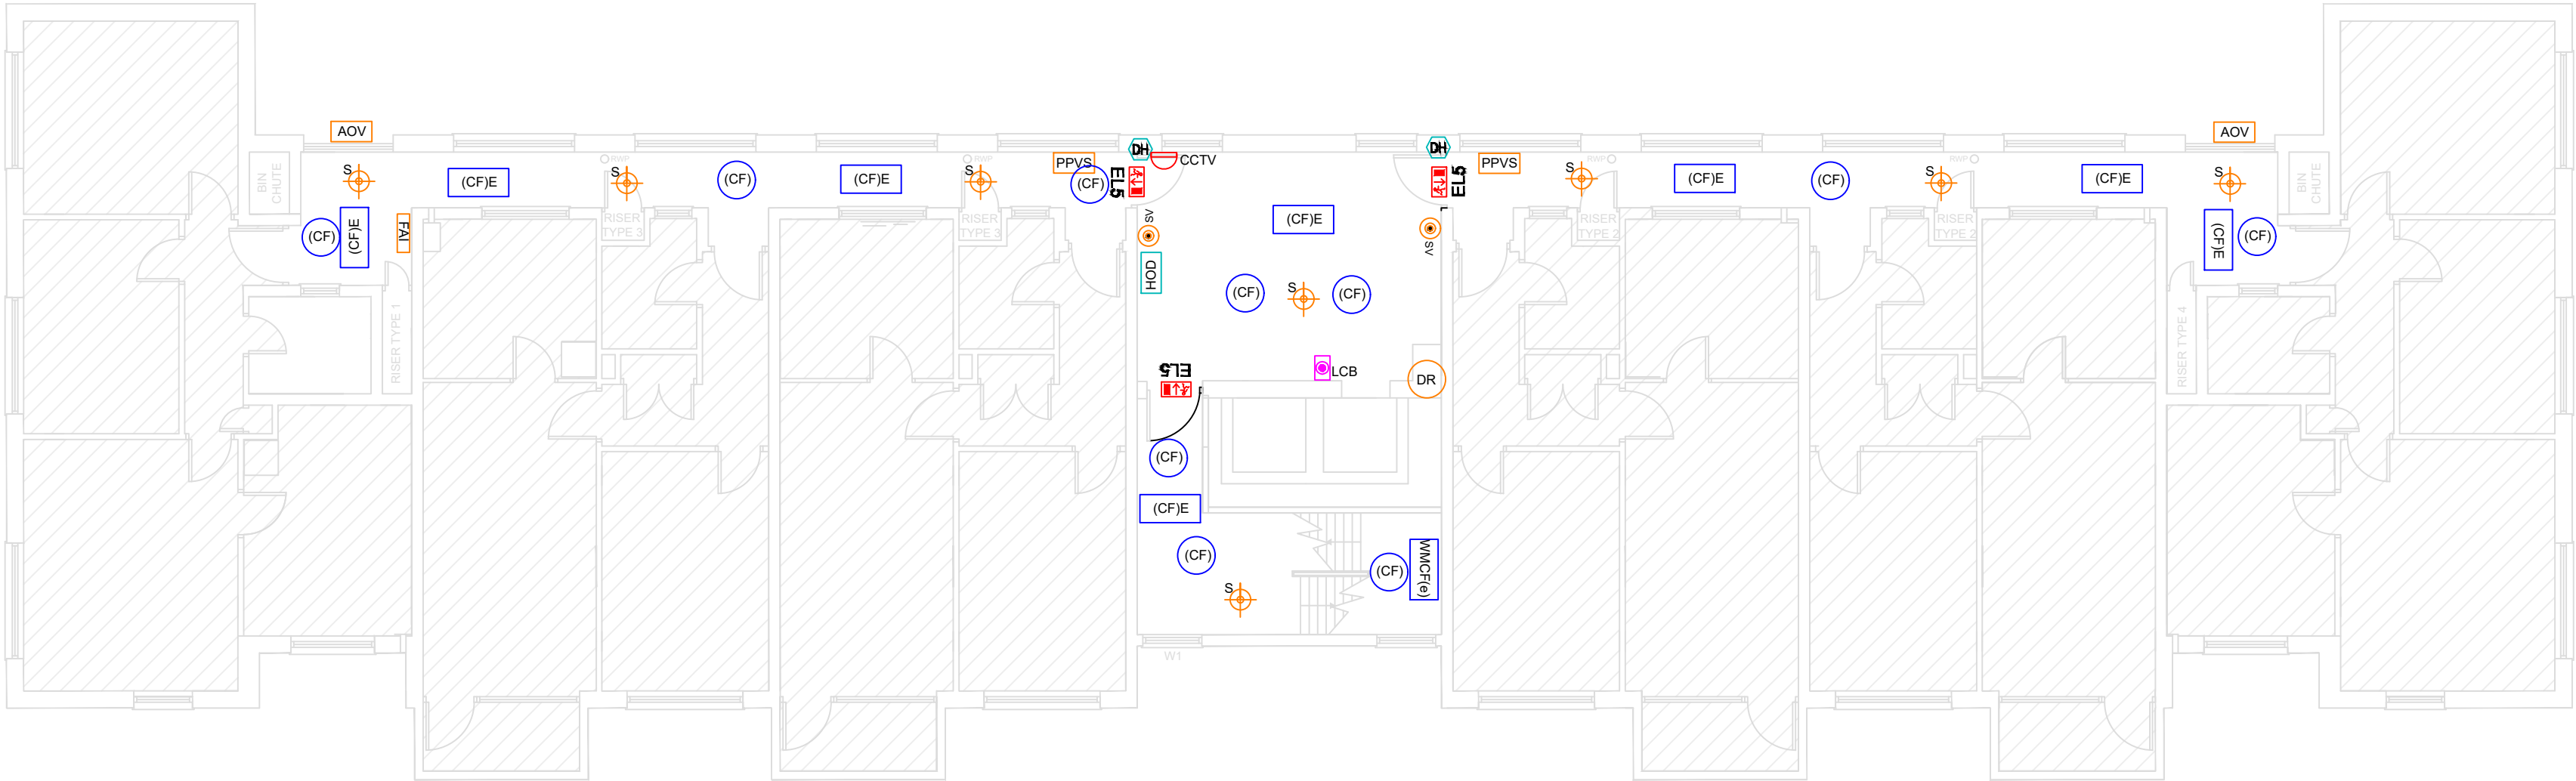


6th Floor

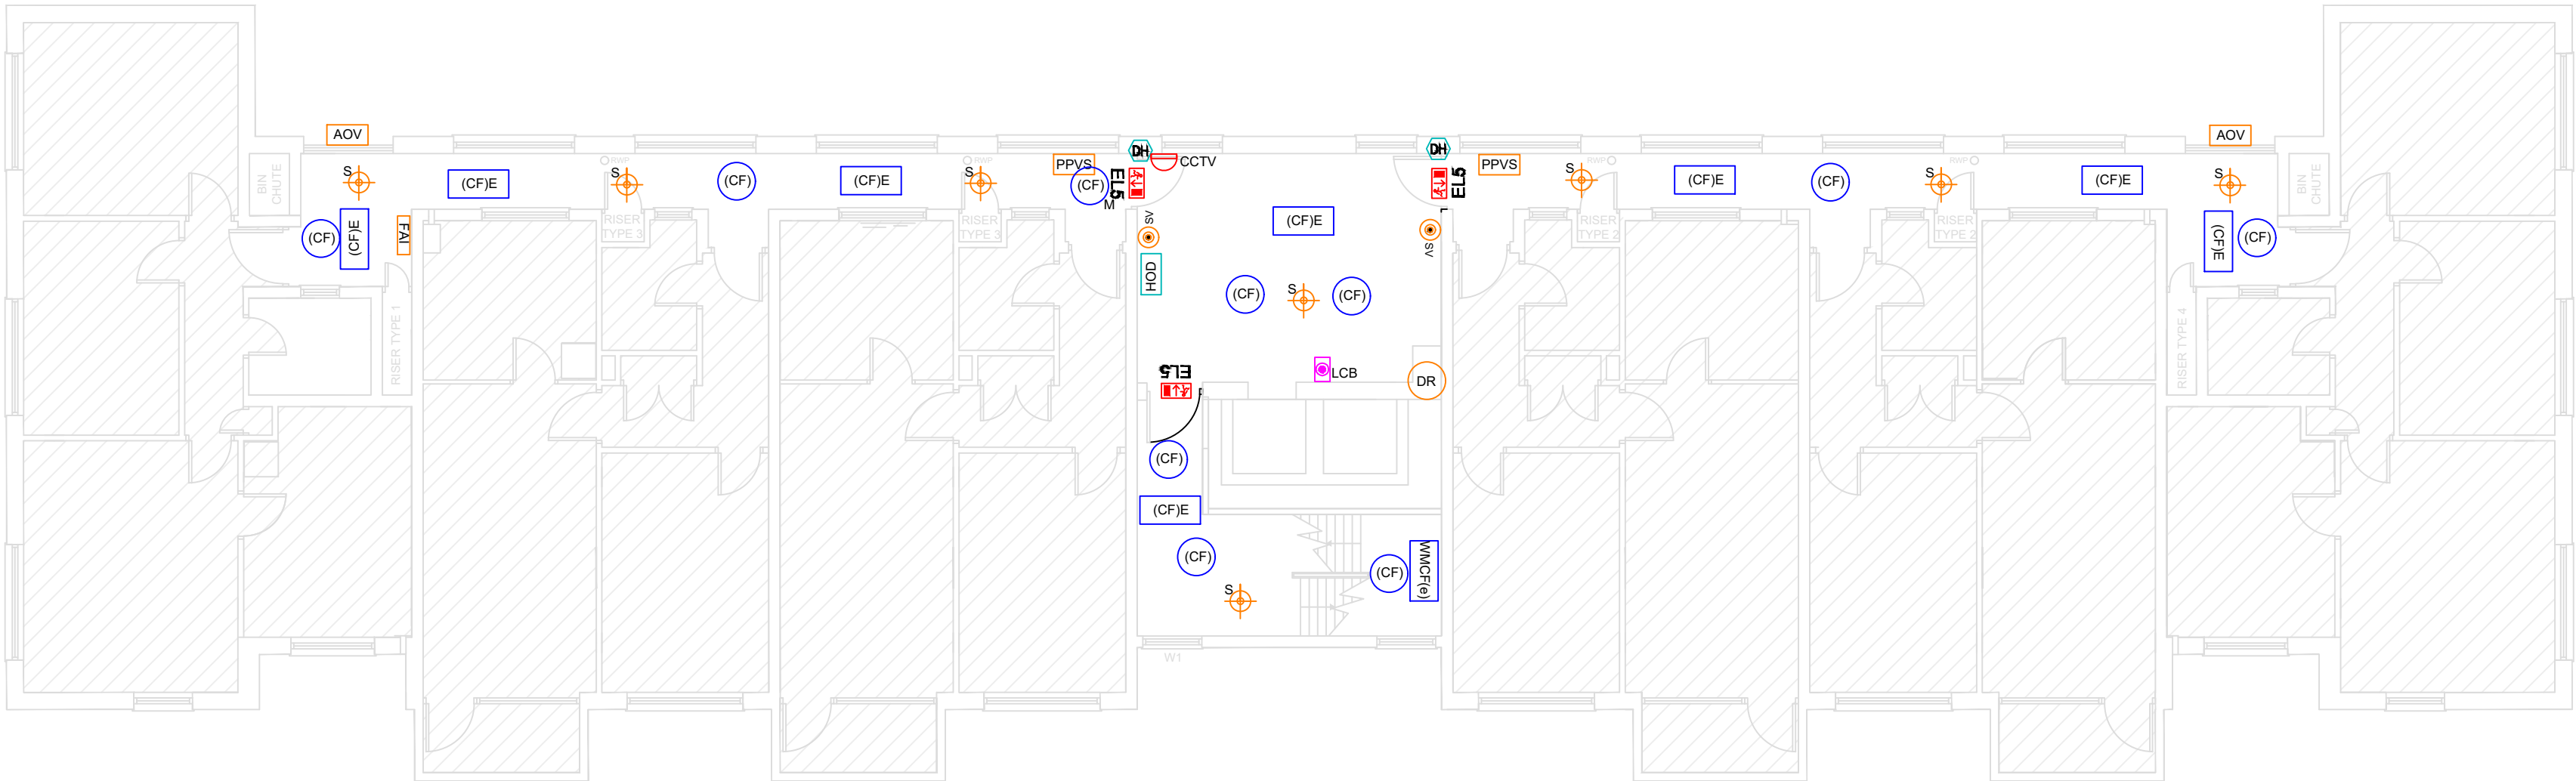

7th Floor

Risers

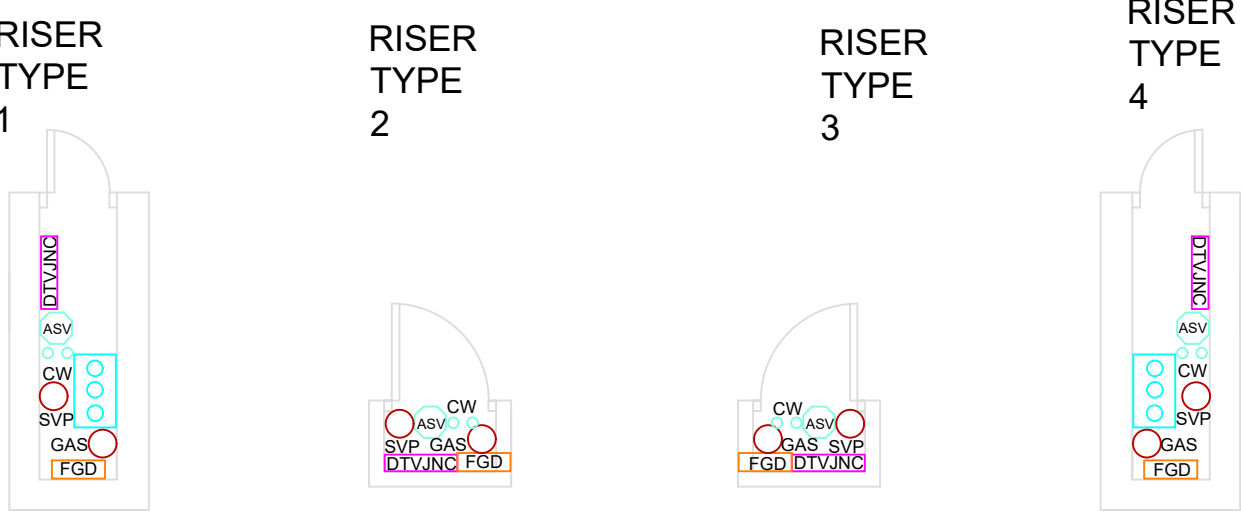

Key

LIGHTING	
	WALL MOUNTED DIRECTIONAL ESCAPE MAINTAINED LIGHT FITTING WITH LEGEND
	INTERNAL LIGHT FITTING- BULKHEAD MAINTAINED- COMPACT FLUORESCENT - CIRCULAR TYPE
	INTERNAL LIGHT FITTING- BULKHEAD (NON-MAINTAINED- EMERGENCY COMPACT FLUORESCENT - STANDARD TYPE)

ELECTRICAL MAINS DISTRIBUTION	
	MAINS ELECTRIC FEED

FIRE	
	DRY RISER
	SMOKE DETECTOR HEAD
	FIRE ALARM INTERFACE
	SMOKE VENT CONTROL ACTIVATION POINT
	POSITIVE PRESSURE VENTILATION SYSTEM
	ELECTROMAGNETIC DOOR HOLD-OPEN
	FLAMMABLE GAS DETECTOR
	DOOR HOLD-OPEN DEVICE INTERFACE
	AUTOMATIC OPENING VENT

SECURITY AND ACCESS CONTROL SYSTEMS	
	CCTV CAMERA CEILING MOUNTED (DOME)

SERVICES	
	GAS RISING MAIN
	RAINWATER PIPE
	SOIL VENT PIPE

HOT AND COLD WATER DISTRIBUTION AND HEATING	
	ANTI-SHOCK VALVE
	COLD WATER SUPPLY

COMMUNICATIONS	
	LIFT CALL BUTTON
	DIGITAL TELEVISION JUNCTION BOX

- NOTES:
- DRAWINGS TO BE READ IN CONJUNCTION WITH ALL SERVICES AND STRUCTURAL ENGINEERS DRAWINGS & SPECIFICATIONS.
 - © COPYRIGHT. DRAWINGS NOT TO BE REPRODUCED OR USED WITHOUT PRIOR WRITTEN CONSENT.

SCALE @A1 DATE DRAWN BY CHECKED BY
1:100 OCT14 JW BM

DRAWING
The Fairways- Mechanical and Electrical
Installations- Sixth and Seventh Floors

PROJECT
KHT Mechanical and Electrical Record Drawings

CLIENT
Knowsley Housing Trust

RIDGE

8TH FLOOR
HORTON HOUSE
EXCHANGE FLAGS
LIVERPOOL
L2 3YL
TEL: 01512433526
FAX: TBFAX
www.ridge.co.uk

DRG NO
142529/TF/87F
REV
-

FILE REFERENCE:
The Fairways

XREF FILE REFERENCE:

1 0 1 2 3 4 5
SCALE 1:100 m