


THE FAIRWAYS
8th Floor Layout

Risers

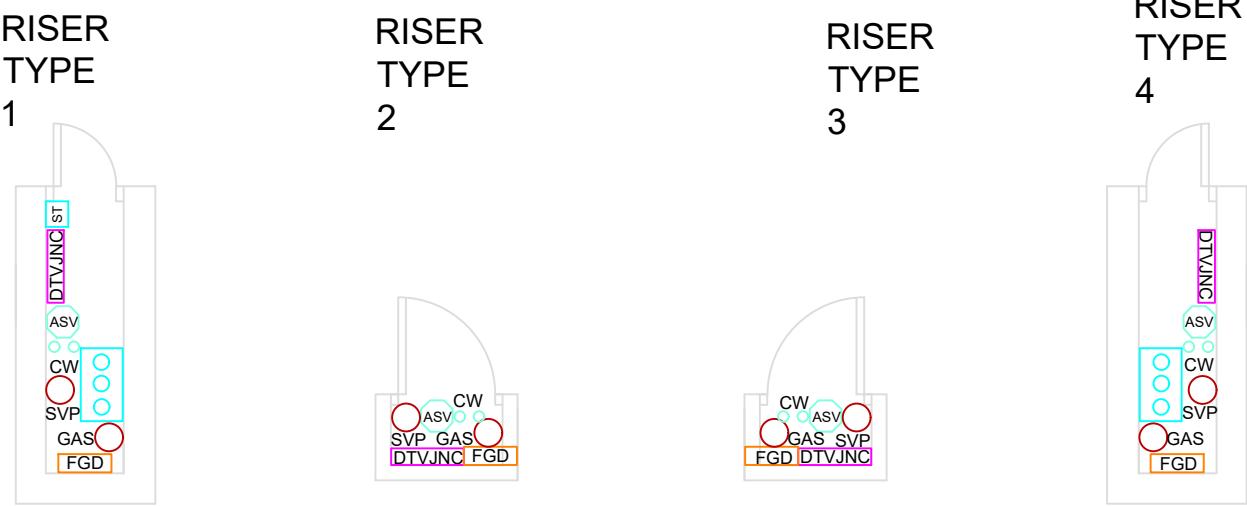

Key	
LIGHTING	
	WALL MOUNTED DIRECTIONAL ESCAPE MAINTAINED LIGHT FITTING WITH LEGEND
	INTERNAL LIGHT FITTING- BULKHEAD MAINTAINED- COMPACT FLUORESCENT - CIRCULAR TYPE
	INTERNAL LIGHT FITTING- BULKHEAD (NON-MAINTAINED- EMERGENCY COMPACT FLUORESCENT - STANDARD TYPE)
	INTERNAL LIGHT FITTING- FLUORESCENT STRIP LIGHT (NON-MAINTAINED - STANDARD TYPE)
	INTERNAL LIGHT FITTING- WALL MOUNTED FLUORESCENT) BULKHEAD (NON-MAINTAINED- COMPACT
	INTERNAL LIGHT FITTING- WALL MOUNTED EMERGENCY COMPACT FLUORESCENT BULKHEAD NON MAINTAINED
	EMERGENCY LIGHTING TEST POINT

ELECTRICAL MAINS DISTRIBUTION	
	MAINS ELECTRIC FEED
	CARTRIDGE FUSE
	DISTRIBUTION BOARD- MCB PROTECTION
	ISOLATOR SWITCH
	SOLAR TRACKER INTERFACE

FIRE	
	DRY RISER
	SMOKE DETECTOR HEAD
	FIRE ALARM INTERFACE
	SMOKE VENT CONTROL ACTIVATION POINT
	POSITIVE PRESSURE VENTILATION SYSTEM
	ELECTROMAGNETIC DOOR HOLD-OPEN
	FLAMMABLE GAS DETECTOR
	DOOR HOLD-OPEN DEVICE INTERFACE
	AUTOMATIC OPENING VENT


LIFTS	
	LIFT MOTOR

SECURITY AND ACCESS CONTROL SYSTEMS	
	CCTV CAMERA CEILING MOUNTED (DOME)

SERVICES	
	GAS RISING MAIN
	RAINWATER PIPE
	SOIL VENT PIPE

HOT AND COLD WATER DISTRIBUTION AND HEATING	
	ANTI-SHOCK VALVE
	COLD WATER SUPPLY
	THERMOSTAT

COMMUNICATIONS	
	LCB LIFT CALL BUTTON
	DIGITAL TELEVISION JUNCTION BOX
	LIFT ALARM

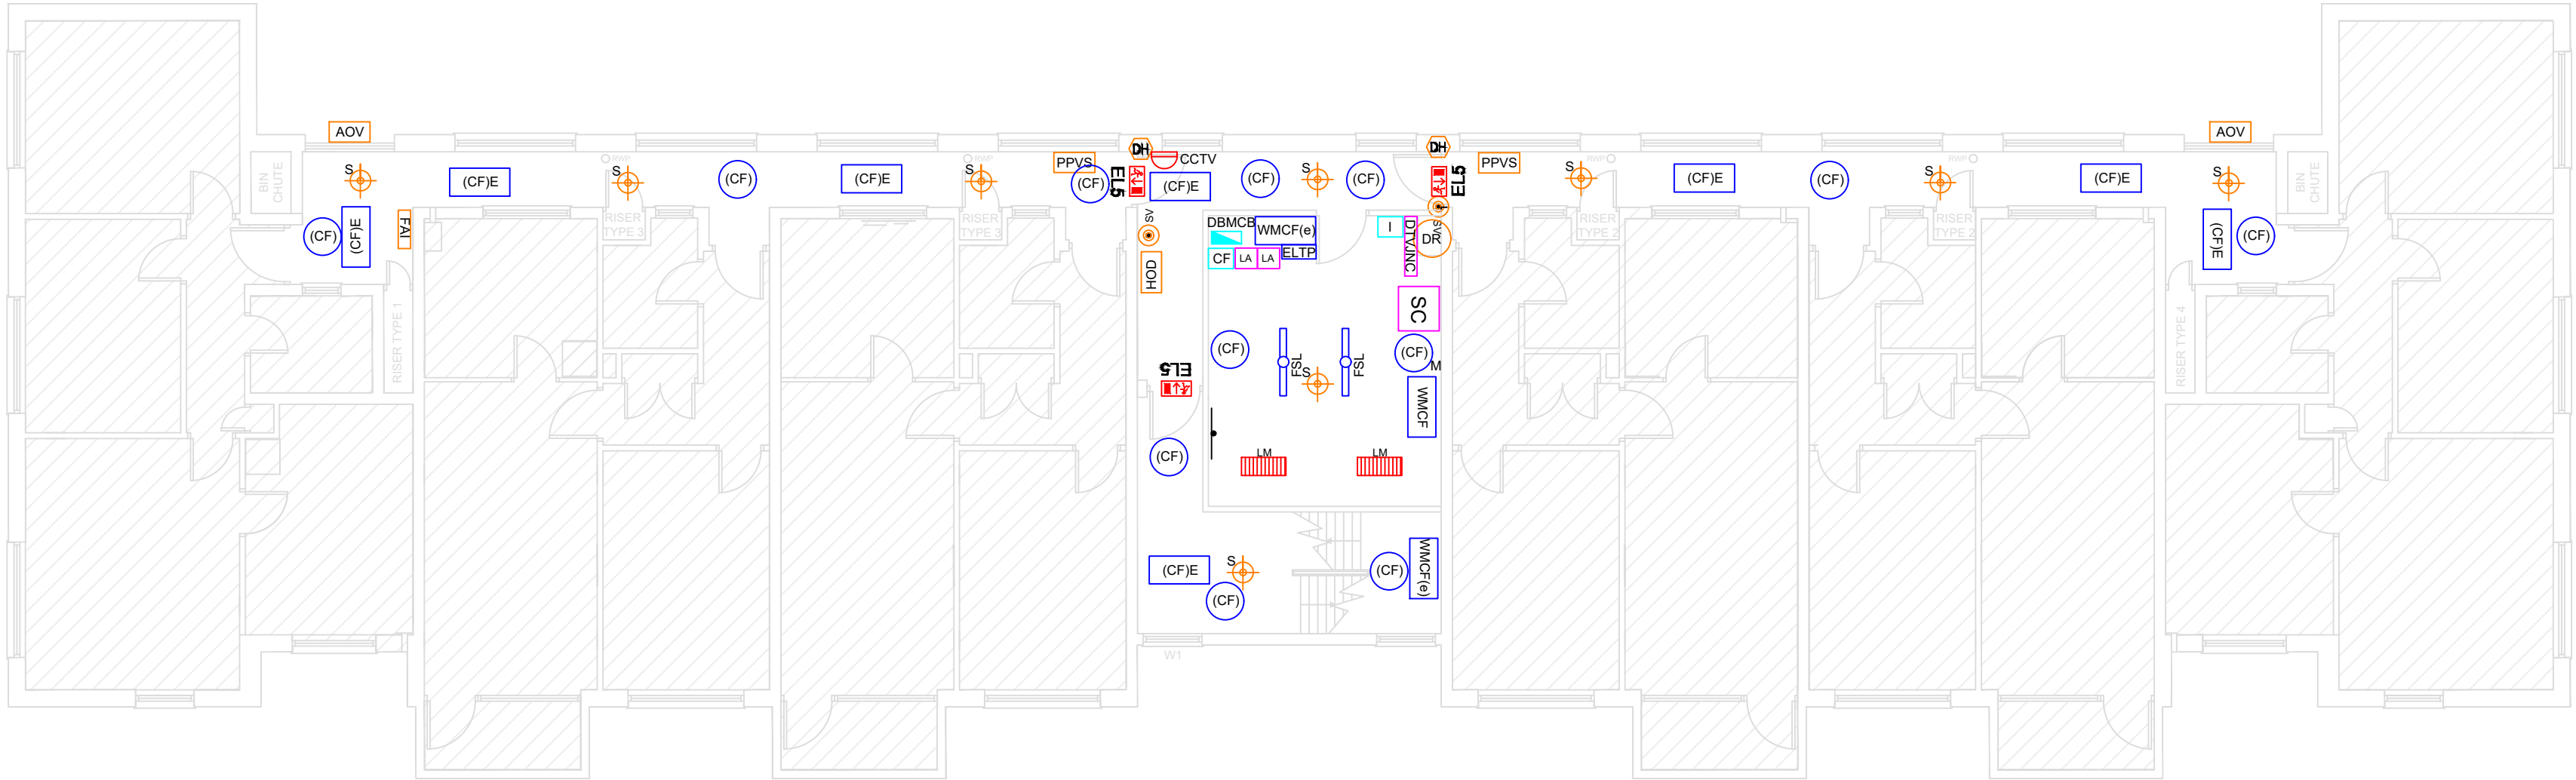

8th Floor

- NOTES:
- DRAWINGS TO BE READ IN CONJUNCTION WITH ALL SERVICES AND STRUCTURAL ENGINEERS DRAWINGS & SPECIFICATIONS
 - © COPYRIGHT. DRAWINGS NOT TO BE REPRODUCED OR USED WITHOUT PRIOR WRITTEN CONSENT.

SCALE @A1 DATE DRAWN BY CHECKED BY
1:100 OCT14 JW BM

DRAWING
The Fairways- Mechanical and Electrical
Installations- Eighth Floor

PROJECT
KHT Mechanical and Electrical Record Drawings

CLIENT
Knowsley Housing Trust

RIDGE
8TH FLOOR
HORTON HOUSE
EXCHANGE FLAGS
LIVERPOOL
L2 3YL
TEL: 01512433526
FAX: TBFAX
www.ridge.co.uk

DRG NO. 142529/TF/8F REV -

FILE REFERENCE:
Quarry Green

XREF FILE REFERENCE:

1 0 1 2 3 4 5
SCALE 1:100 m