

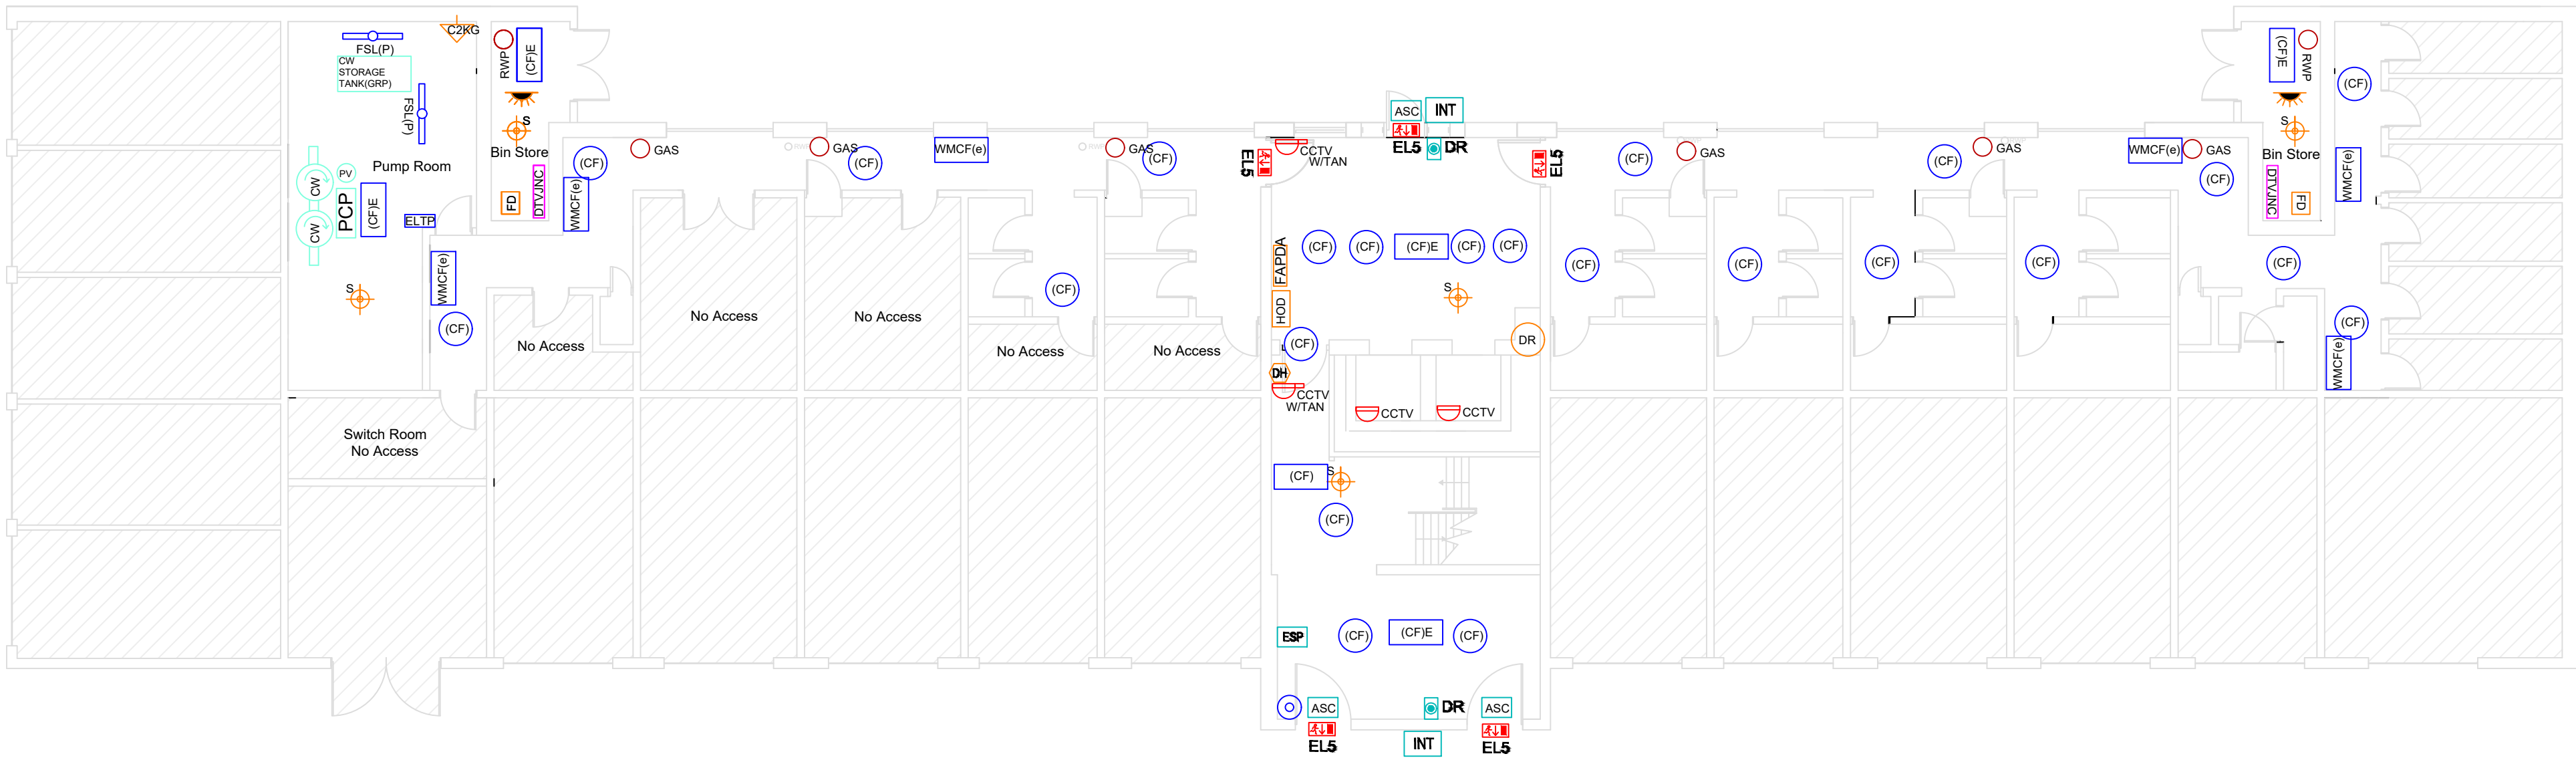


THE FAIRWAYS

Ground Floor and 1st Floor Layout

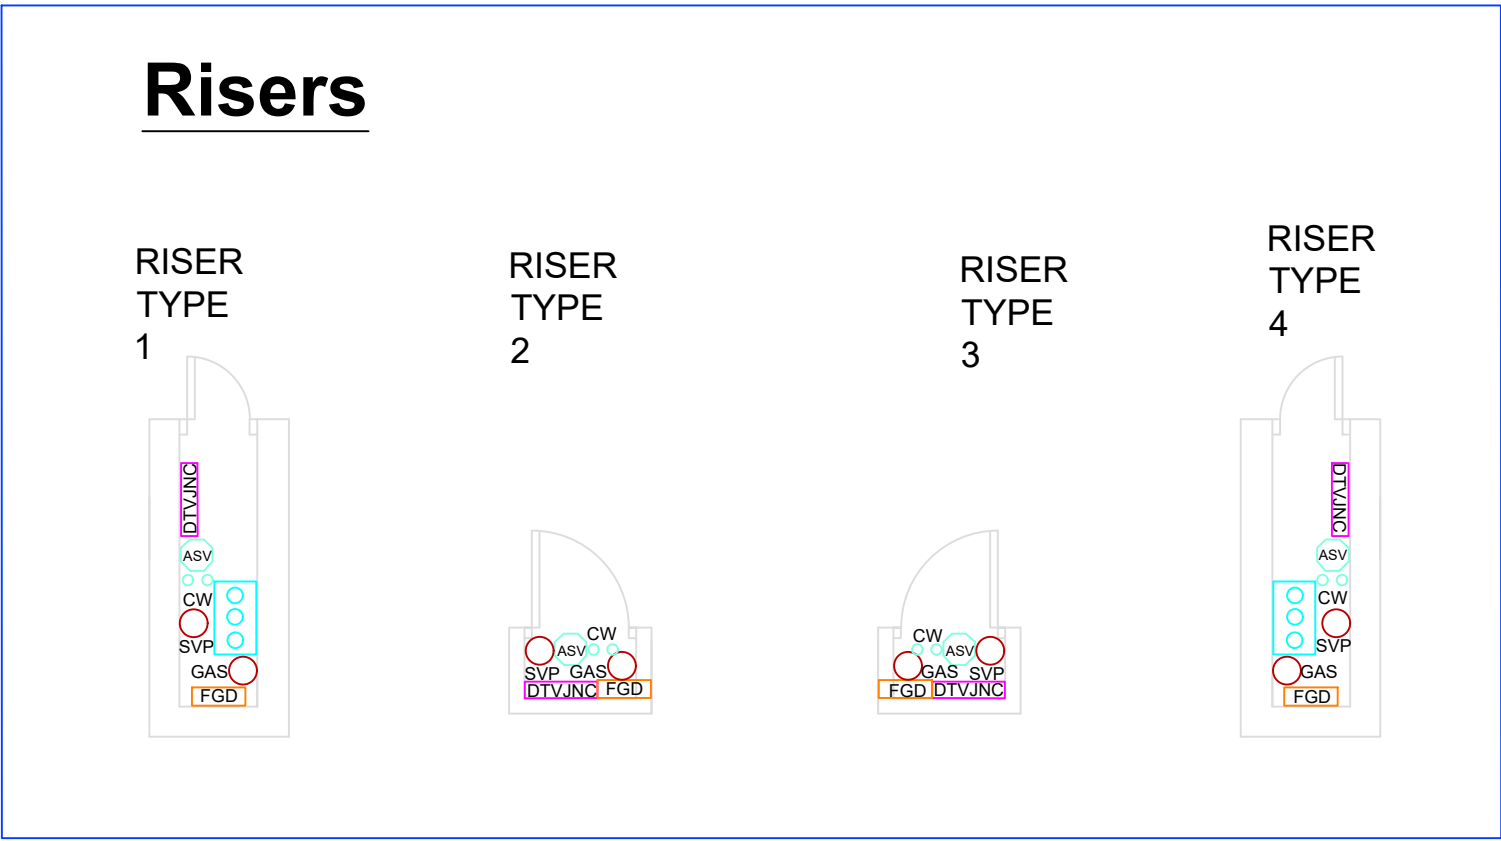

Ground Floor

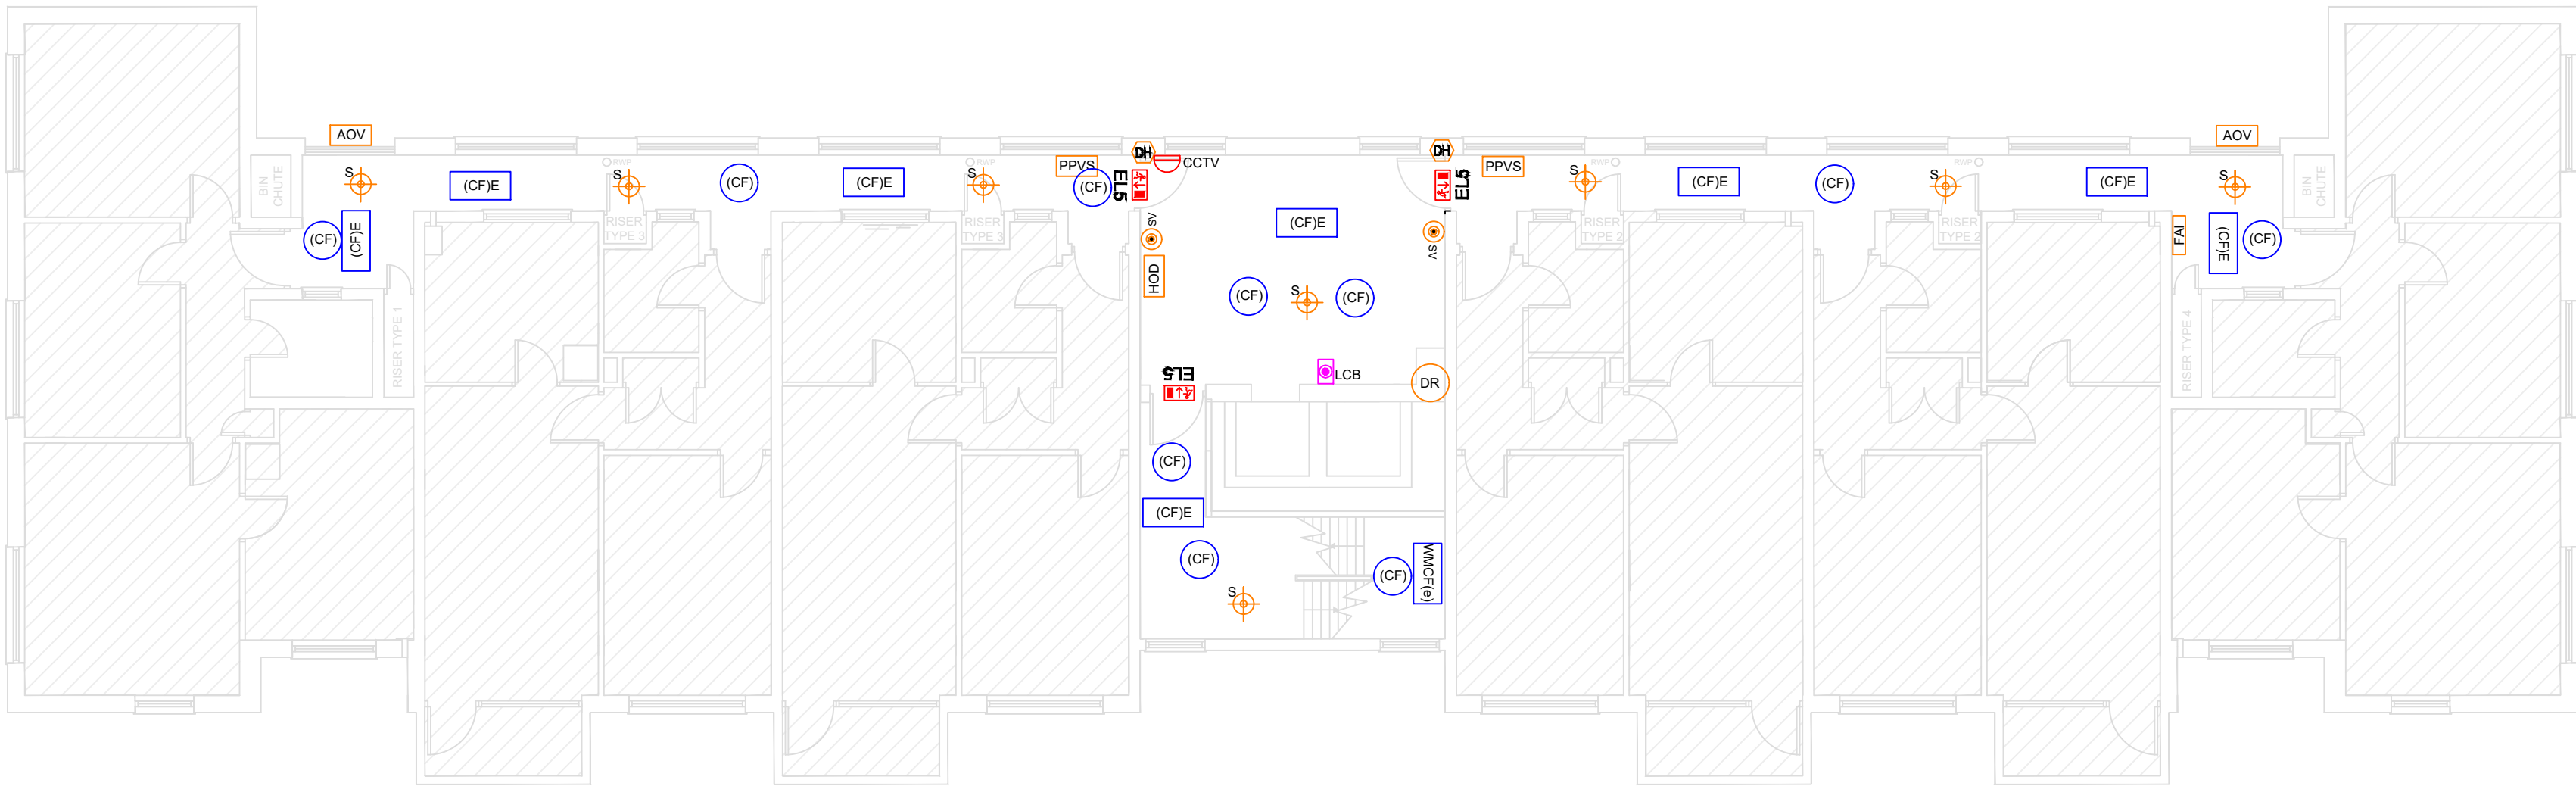

1st Floor

Key

EL5	WALL MOUNTED DIRECTIONAL ESCAPE MAINTAINED LIGHT FITTING WITH LEGEND
(CF)	INTERNAL LIGHT FITTING- BULKHEAD MAINTAINED- COMPACT FLUORESCENT - CIRCULAR TYPE
(CFIE)	INTERNAL LIGHT FITTING- BULKHEAD (NON-MAINTAINED- EMERGENCY COMPACT FLUORESCENT - STANDARD TYPE)
FSL(P)	INTERNAL LIGHT FITTING- FLUORESCENT STRIP LIGHT (NON-MAINTAINED - STANDARD TYPE WITH POLYCARBONATE DIFFUSER)
ELTB	EMERGENCY LIGHTING TEST POINT
(WMCf)	INTERNAL LIGHT FITTING- WALL MOUNTED FLUORESCENT) BULKHEAD (NON-MAINTAINED- COMPACT
PIR	SAFETY PIR SENSOR

LIGHTNING PROTECTION

LC	CONDUCTORS/DOWNTAPES
----	----------------------

ELECTRICAL MAINS DISTRIBUTION

	MAINS ELECTRIC FEED
--	---------------------

FIRE

DR	DRY RISER
S	SMOKE DETECTOR HEAD
FACP	FIRE ALARM CONTROL PANEL (CONVENTIONAL)
PF	PORTABLE FIRE EXTINGUISHER (CO2)
FAL	FIRE ALARM INTERFACE
SV	SMOKE VENT CONTROL ACTIVATION POINT
SPR	SPRINKLER HEAD
FD	FIRE DAMPER
PPVS	POSITIVE PRESSURE VENTILATION SYSTEM
DH	ELECTROMAGNETIC DOOR HOLD-OPEN
FGD	FLAMMABLE GAS DETECTOR
HOD	DOOR HOLD-OPEN DEVICE INTERFACE
AOV	AUTOMATIC OPENING VENT

SECURITY AND ACCESS CONTROL SYSTEMS

CCTV	CCTV CAMERA CEILING MOUNTED (DOME)
CCTV W/TAN	CCTV CAMERA WITH TANYO
DR	DOOR RELEASE BUTTON
INT	INTERCOM- 2 WAY SPEECH C/W KEYPAD AND FOB READER
ASC	AUTOMATIC SELF CLOSER
ESP	ELECTRIC STRIKE PLATE

SERVICES

GAS	GAS RISING MAIN
RWP	RAINWATER PIPE
SVP	SOIL VENT PIPE

HOT AND COLD WATER DISTRIBUTION AND HEATING

CW	CW BOOSTER PUMP SET
CW STORAGE TANK (GRP)	CW STORAGE TANK (GRP)
ASV	ANTI-SHOCK VALVE
PV	PRESSURE VESSEL
PCP	PUMP CONTROL PANEL
CW	COLD WATER SUPPLY

COMMUNICATIONS

LCB	LIFT CALL BUTTON
DTV(JNC)	DIGITAL TELEVISION JUNCTION BOX

NOTES:

1. DRAWINGS TO BE READ IN CONJUNCTION WITH ALL SERVICES AND STRUCTURAL ENGINEERS DRAWINGS & SPECIFICATIONS.

2. © COPYRIGHT. DRAWINGS NOT TO BE REPRODUCED OR USED WITHOUT PRIOR WRITTEN CONSENT.

SCALE @A1	DATE	DRAWN BY	CHECKED BY
1:100	OCT14	JW	BM

DRAWING

The Fairways- Mechanical and Electrical Installations- Ground and First Floors

PROJECT

KHT Mechanical and Electrical Record Drawings

CLIENT

Knowsley Housing Trust

RIDGE

8TH FLOOR
HORTON HOUSE
EXCHANGE FLAGS
LIVERPOOL
L2 3YL

TEL: 01512433526
FAX: TBFAX
www.ridge.co.uk

DRG NO	REV
142529/TF/GF1F	-

FILE REFERENCE:

The Fairways

XREF FILE REFERENCE:

