


THE FAIRWAYS
Roof Plan

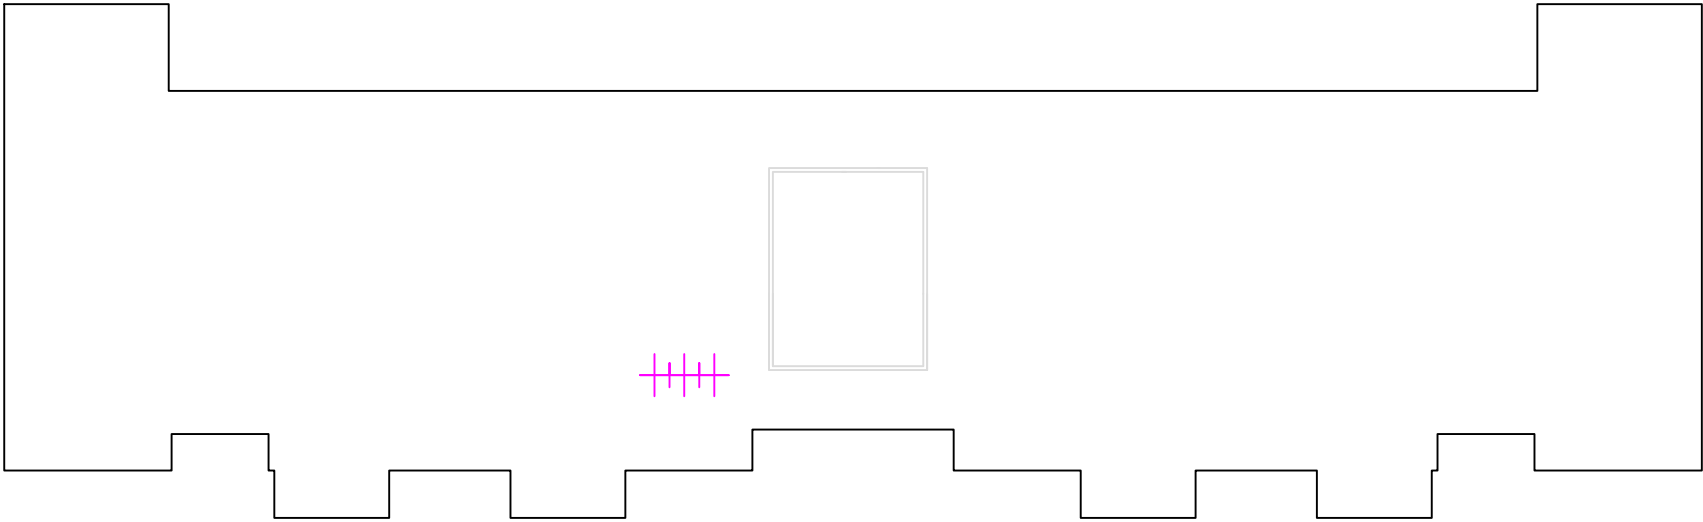

Key

 COMMUNAL TV AERIEL

NOTES:

1. DRAWINGS TO BE READ IN CONJUNCTION WITH ALL SERVICES AND STRUCTURAL ENGINEERS DRAWINGS & SPECIFICATIONS.
2. © COPYRIGHT. DRAWINGS NOT TO BE REPRODUCED OR USED WITHOUT PRIOR WRITTEN CONSENT.

SCALE @A3 1:200	DATE OCT14	DRAWN BY JW	CHECKED BY BM
DRAWING The Fairways- Mechanical and Electrical Installations- Roof Plan			
PROJECT KHT Mechanical and Electrical Record Drawings			
CLIENT Knowsley Housing Trust			
RIDGE 8TH FLOOR HORTON HOUSE EXCHANGE FLAGS LIVERPOOL L2 3YL TEL: 01512433526 FAX: TBFAX www.ridge.co.uk			
DRG NO 142529/TF/RP		REV -	
FILE REFERENCE: The Fairways			
XREF FILE REFERENCE:			

