



WOOLTON VIEWSD
2nd Floor and 3rd Floor Layout

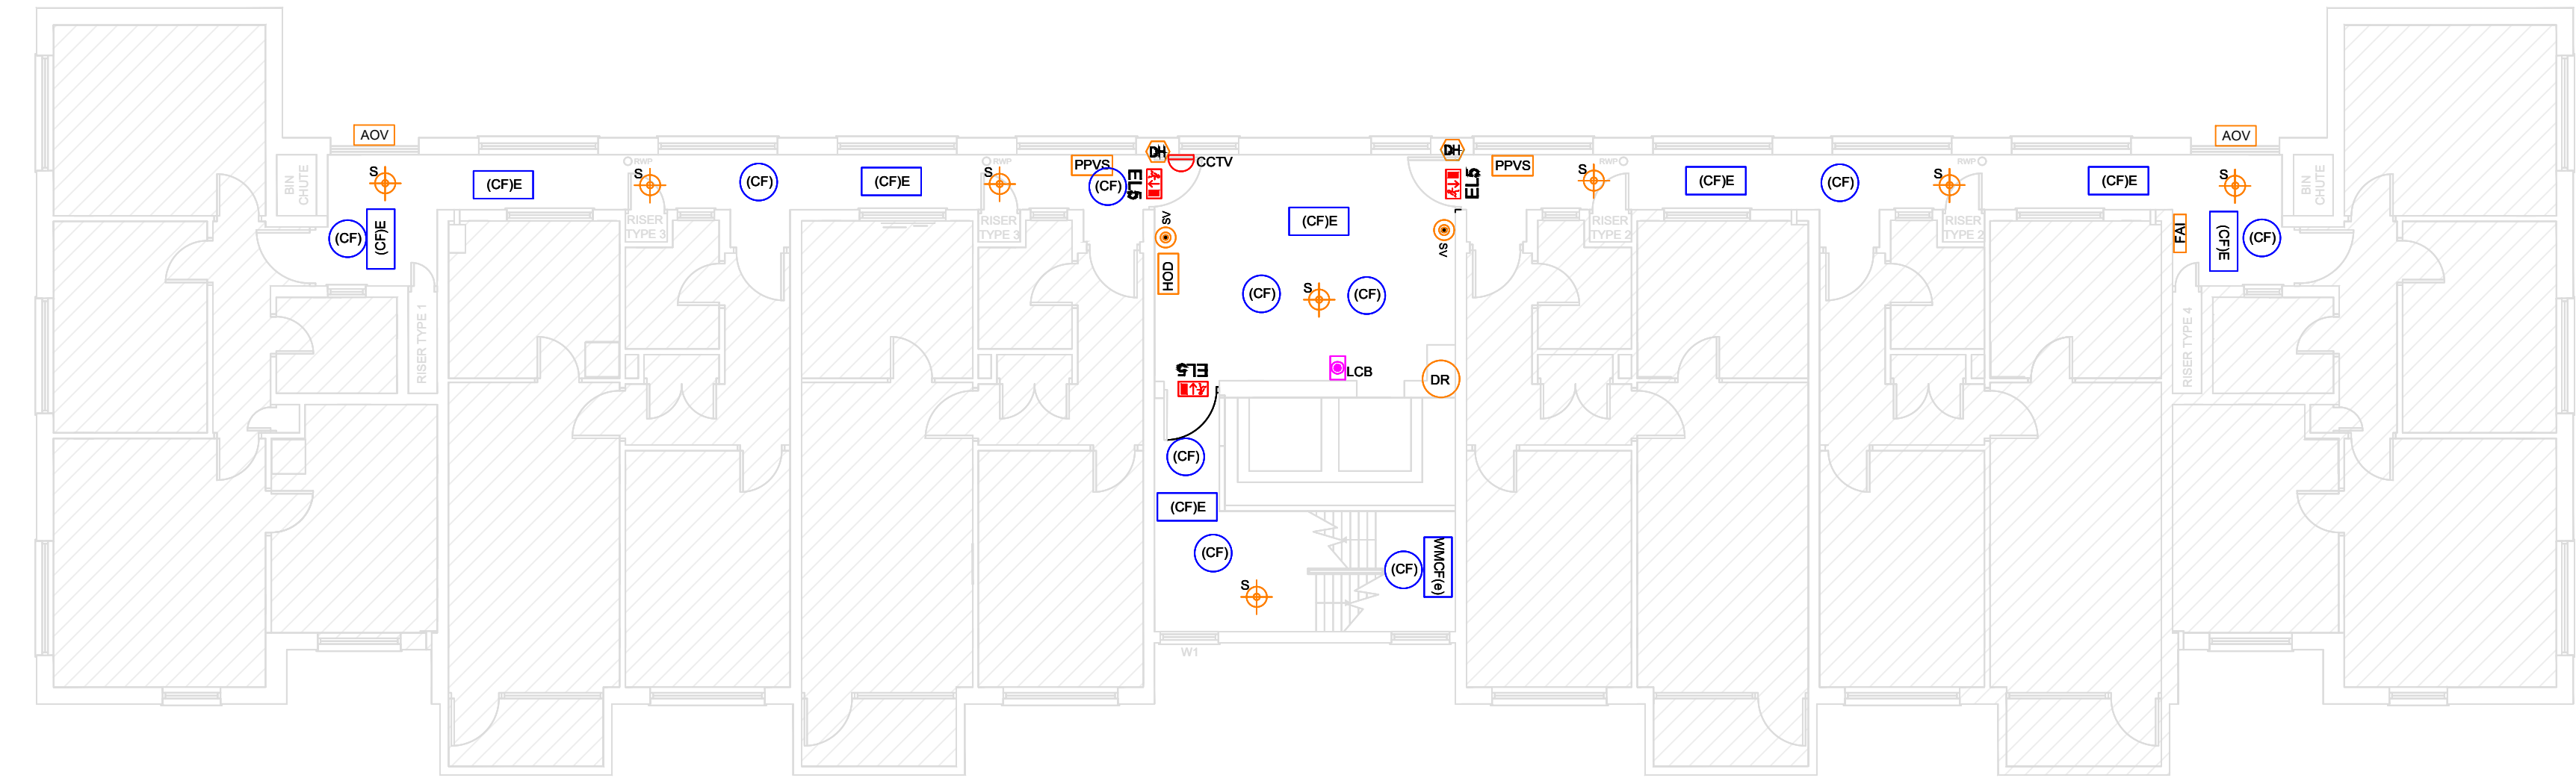


2nd Floor

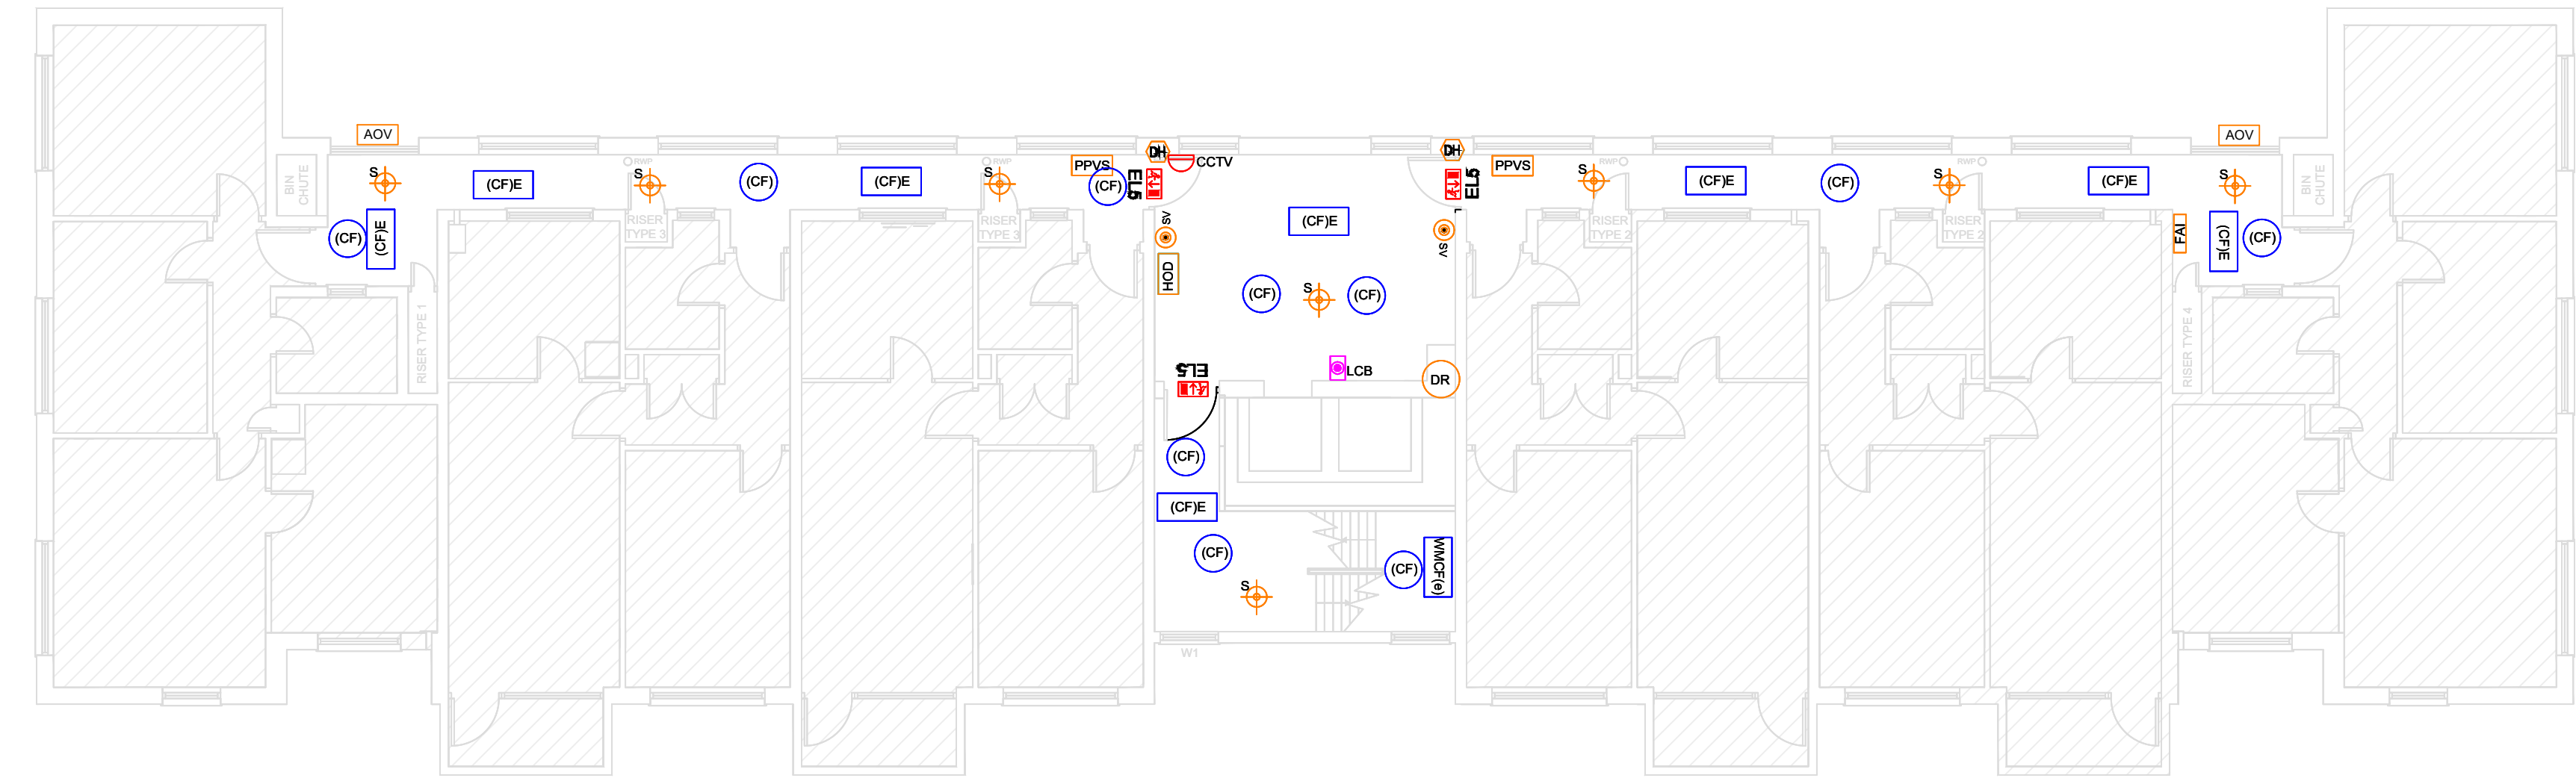

3rd Floor

Risers

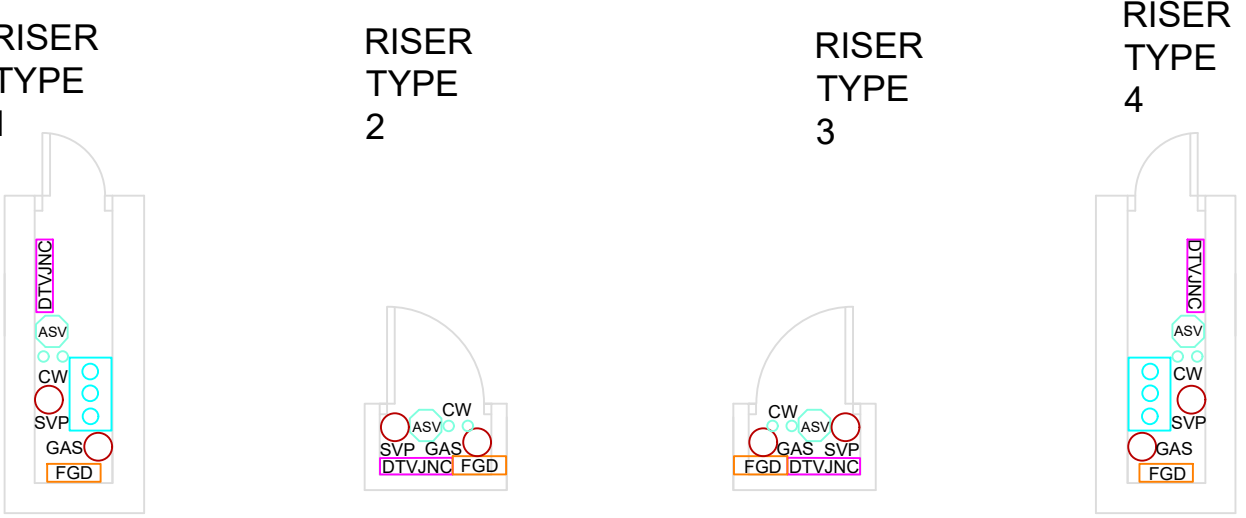

Key	
LIGHTING	
EL5	WALL MOUNTED DIRECTIONAL ESCAPE MAINTAINED LIGHT FITTING WITH LEGEND
(CF)	INTERNAL LIGHT FITTING- BULKHEAD MAINTAINED- COMPACT FLUORESCENT - CIRCULAR TYPE
(CFJE)	INTERNAL LIGHT FITTING- BULKHEAD (NON-MAINTAINED- EMERGENCY COMPACT FLUORESCENT - STANDARD TYPE)
ELECTRICAL MAINS DISTRIBUTION	
CO	MAINS ELECTRIC FEED
FIRE	
DR	DRY RISER
S	SMOKE DETECTOR HEAD
FAL	FIRE ALARM INTERFACE
SV	SMOKE VENT CONTROL ACTIVATION POINT
PPVS	POSITIVE PRESSURE VENTILATION SYSTEM
DH	ELECTROMAGNETIC DOOR HOLD-OPEN
FGD	FLAMMABLE GAS DETECTOR
HOD	DOOR HOLD-OPEN DEVICE INTERFACE
AOV	AUTOMATIC OPENING VENT
SECURITY AND ACCESS CONTROL SYSTEMS	
CCTV	CCTV CAMERA CEILING MOUNTED (DOME)
SERVICES	
GAS	GAS RISING MAIN
RWP	RAINWATER PIPE
SVP	SOIL VENT PIPE
HOT AND COLD WATER DISTRIBUTION AND HEATING	
ASV	ANTI-SHOCK VALVE
CW	COLD WATER SUPPLY
COMMUNICATIONS	
LCB	LIFT CALL BUTTON
DTJ	DIGITAL TELEVISION JUNCTION BOX

NOTES:

1. DRAWINGS TO BE READ IN CONJUNCTION WITH ALL SERVICES AND STRUCTURAL ENGINEERS DRAWINGS & SPECIFICATIONS.
2. © COPYRIGHT. DRAWINGS NOT TO BE REPRODUCED OR USED WITHOUT PRIOR WRITTEN CONSENT.

SCALE @A1 1:100	DATE OCT14	DRAWN BY JW	CHECKED BY BM
--------------------	---------------	----------------	------------------

DRAWING
Woolton View- Mechanical and Electrical Installations- Second and Third Floors

PROJECT
KHT Mechanical and Electrical Record Drawings

CLIENT
Knowsley Housing Trust

RIDGE

8TH FLOOR
HORTON HOUSE
EXCHANGE FLAGS
LIVERPOOL
L2 3YL

TEL: 01512433526
FAX: TBFAX
www.ridge.co.uk

DRG NO. 142529/WV/2F3F	REV -
---------------------------	----------

FILE REFERENCE:
Woolton View

XREF FILE REFERENCE:

