



WOOLTON VIEWS
6th Floor and 7th Floor Layout

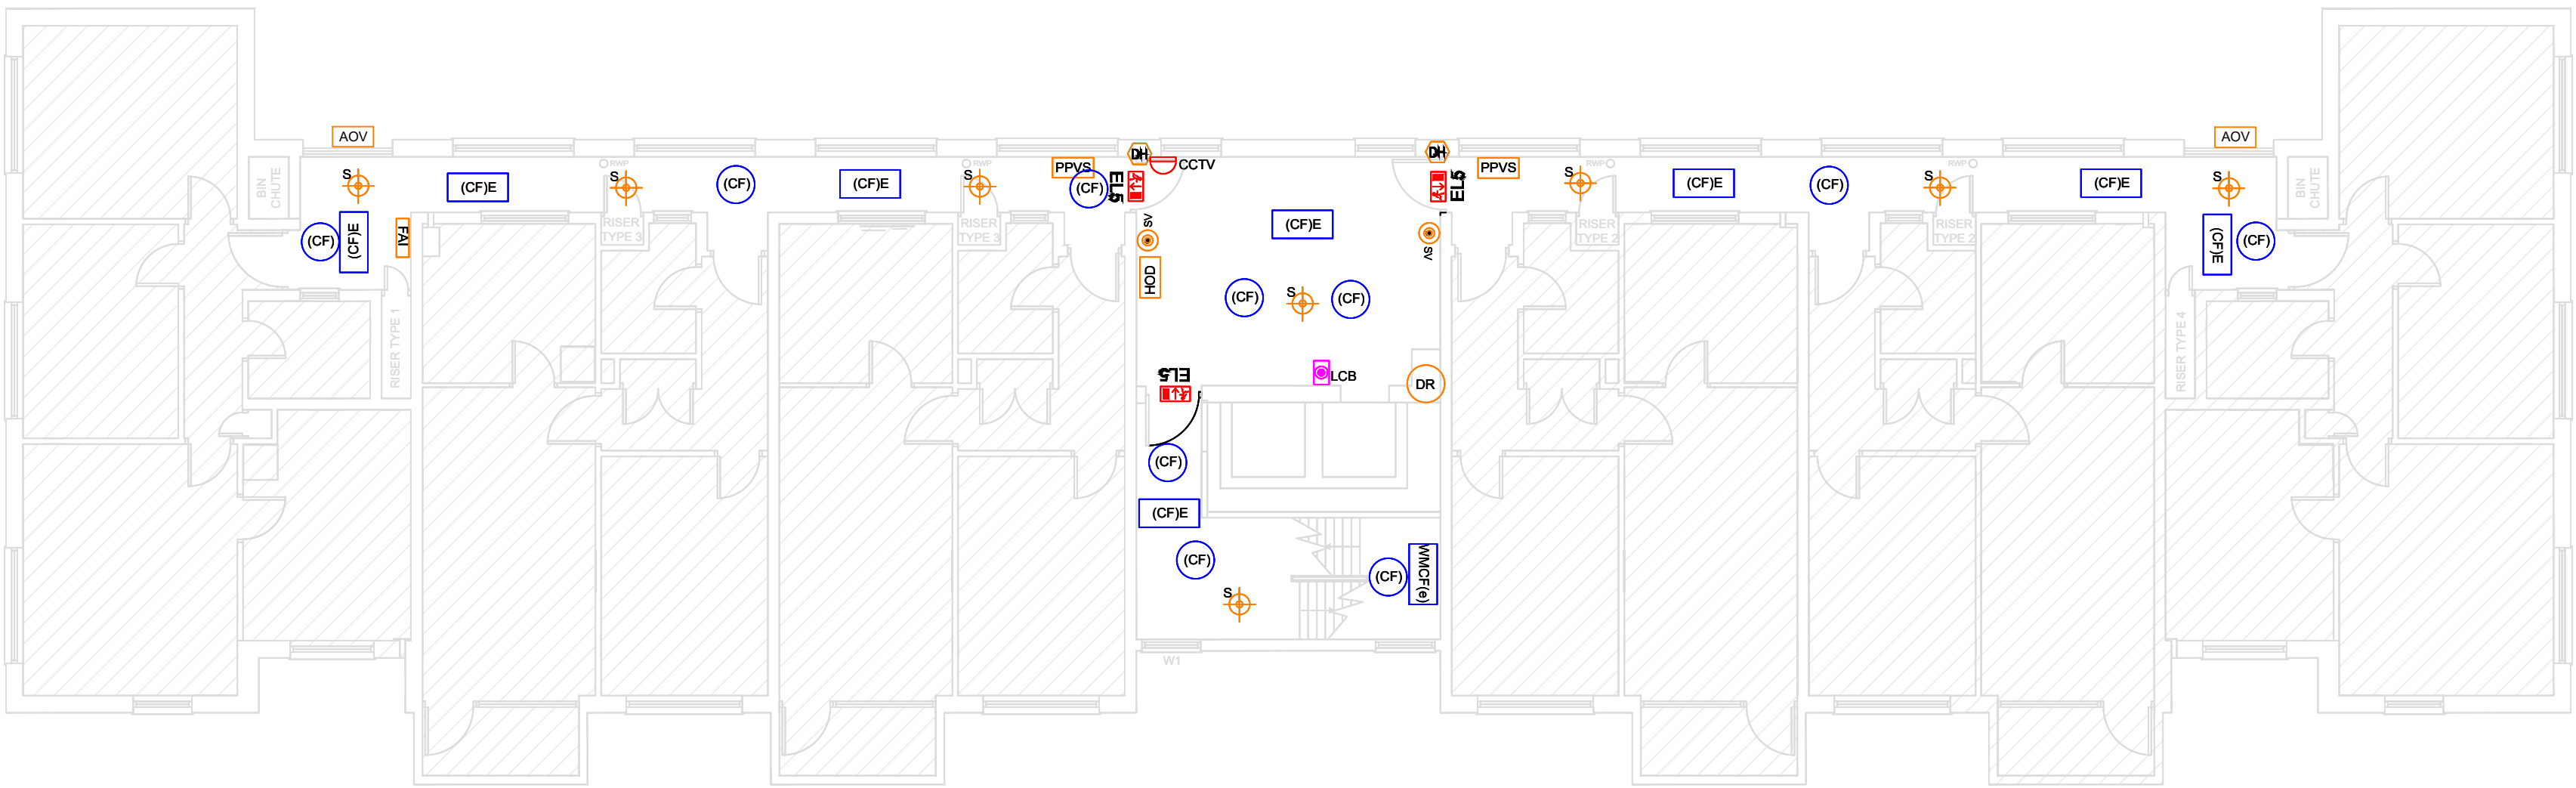


6th Floor

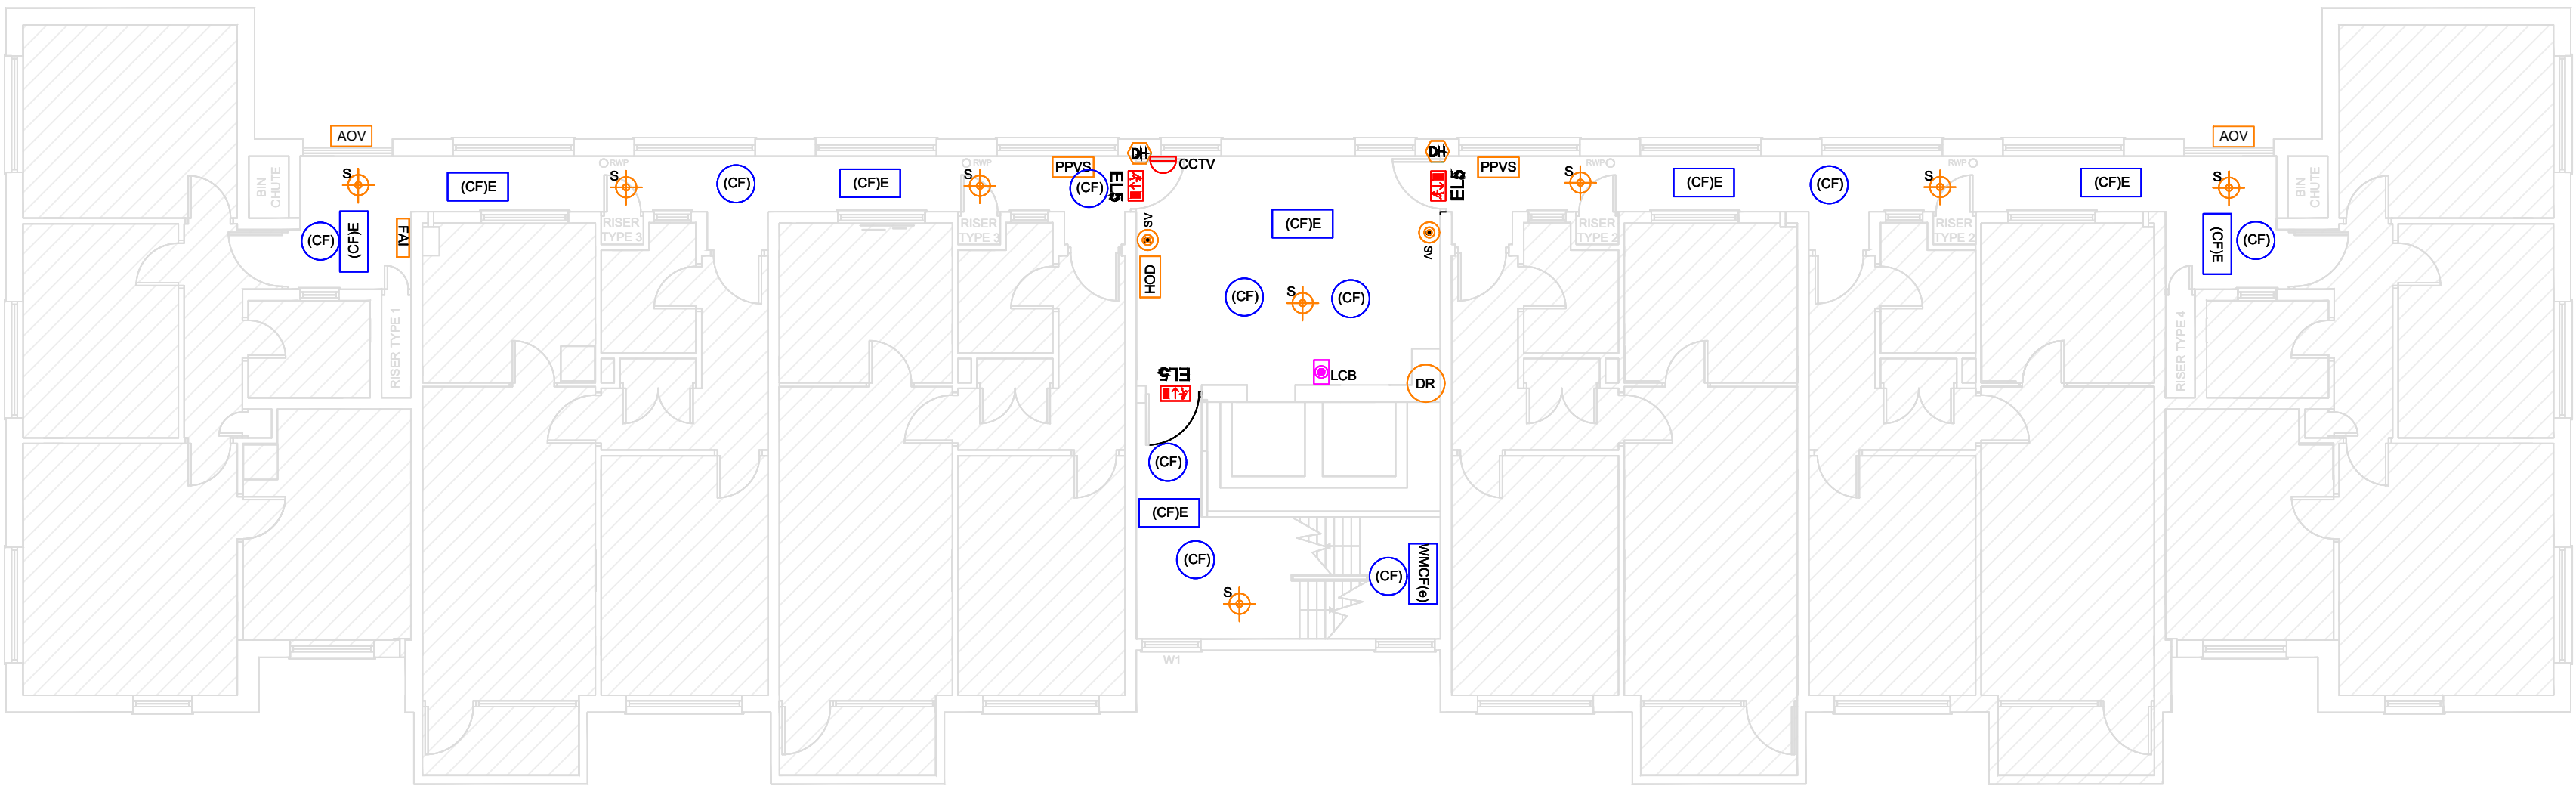

7th Floor

Risers

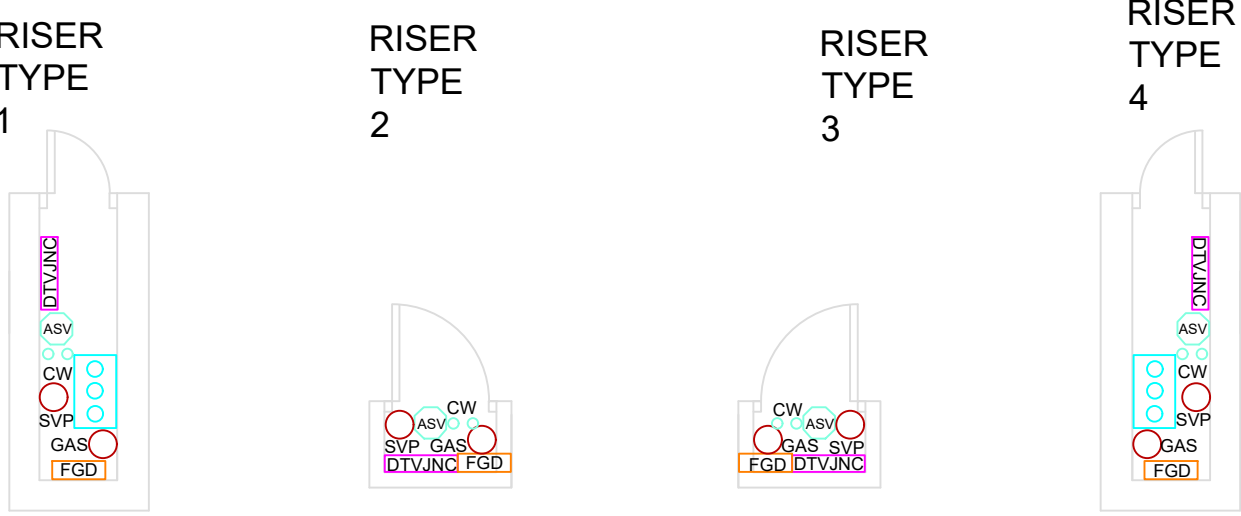

Key	
LIGHTING	
[EL5]	WALL MOUNTED DIRECTIONAL ESCAPE MAINTAINED LIGHT FITTING WITH LEGEND
(CF)	INTERNAL LIGHT FITTING- BULKHEAD MAINTAINED- COMPACT FLUORESCENT - CIRCULAR TYPE
[CFJE]	INTERNAL LIGHT FITTING- BULKHEAD (NON-MAINTAINED- EMERGENCY COMPACT FLUORESCENT - STANDARD TYPE)
ELECTRICAL MAINS DISTRIBUTION	
[CCTV]	MAINS ELECTRIC FEED
FIRE	
[DR]	DRY RISER
[S]	SMOKE DETECTOR HEAD
[FAI]	FIRE ALARM INTERFACE
[BV]	SMOKE VENT CONTROL ACTIVATION POINT
[PPVS]	POSITIVE PRESSURE VENTILATION SYSTEM
[DH]	ELECTROMAGNETIC DOOR HOLD-OPEN
[FGD]	FLAMMABLE GAS DETECTOR
[HOD]	DOOR HOLD-OPEN DEVICE INTERFACE
[AOV]	AUTOMATIC OPENING VENT
SECURITY AND ACCESS CONTROL SYSTEMS	
[CCTV]	CCTV CAMERA CEILING MOUNTED (DOME)
SERVICES	
[GAS]	GAS RISING MAIN
[RWP]	RAINWATER PIPE
[SVP]	SOIL VENT PIPE
HOT AND COLD WATER DISTRIBUTION AND HEATING	
[ASV]	ANTI-SHOCK VALVE
[CW]	COLD WATER SUPPLY
COMMUNICATIONS	
[LCB]	LIFT CALL BUTTON
[DTVJNC]	DIGITAL TELEVISION JUNCTION BOX

- NOTES:
- DRAWINGS TO BE READ IN CONJUNCTION WITH ALL SERVICES AND STRUCTURAL ENGINEERS DRAWINGS & SPECIFICATIONS
 - © COPYRIGHT. DRAWINGS NOT TO BE REPRODUCED OR USED WITHOUT PRIOR WRITTEN CONSENT.

SCALE @A1 DATE DRAWN BY CHECKED BY
1:100 OCT14 JW BM

DRAWING
Woolton View- Mechanical and Electrical
Installations- Sixth and Seventh Floors

PROJECT
KHT Mechanical and Electrical Record Drawings

CLIENT
Knowsley Housing Trust

RIDGE

8TH FLOOR
HORTON HOUSE
EXCHANGE FLAGS
LIVERPOOL
L2 3YL

TEL: 01512433526
FAX: TBFAX
www.ridge.co.uk

DRG NO
142529/WV/67F

REV
-

FILE REFERENCE:
Woolton View

XREF FILE REFERENCE:

1 0 1 2 3 4 5
SCALE 1:100 m