
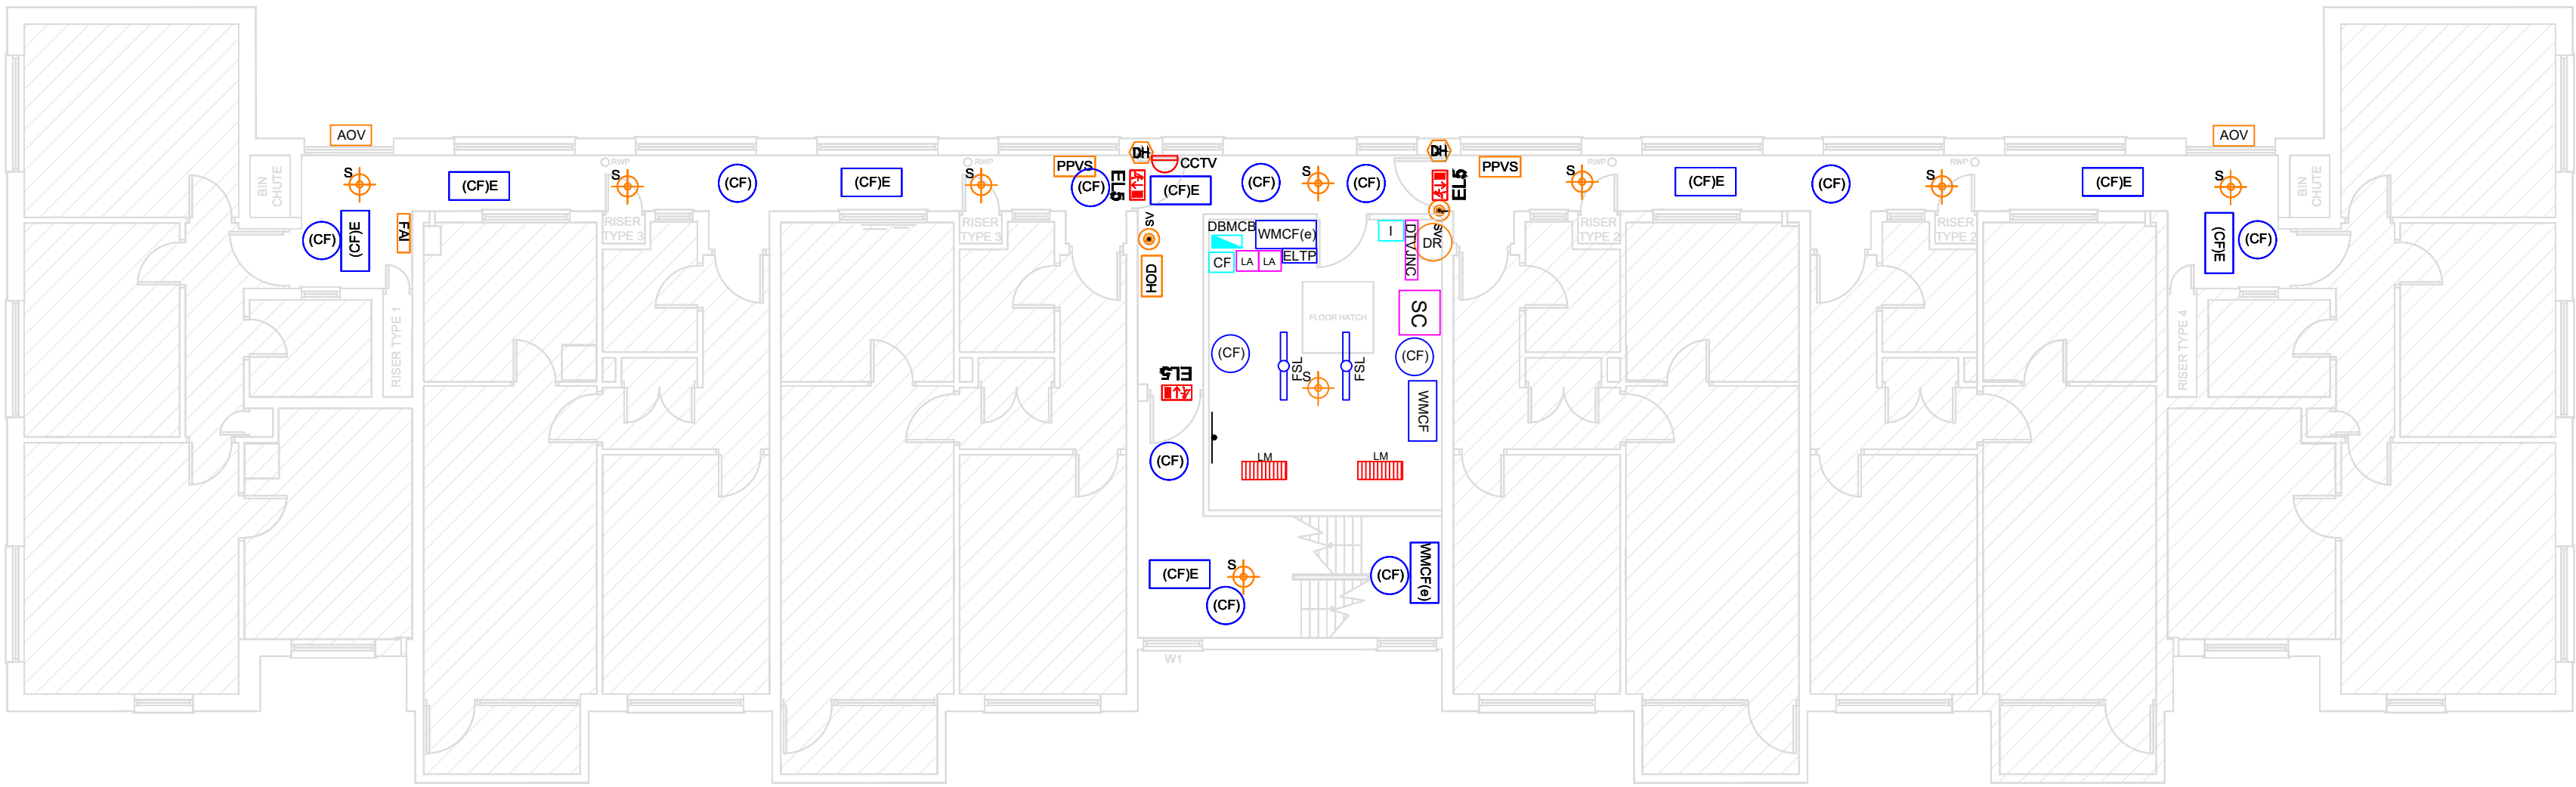


WOOLTON VIEWS

8th Floor Layout

Risers

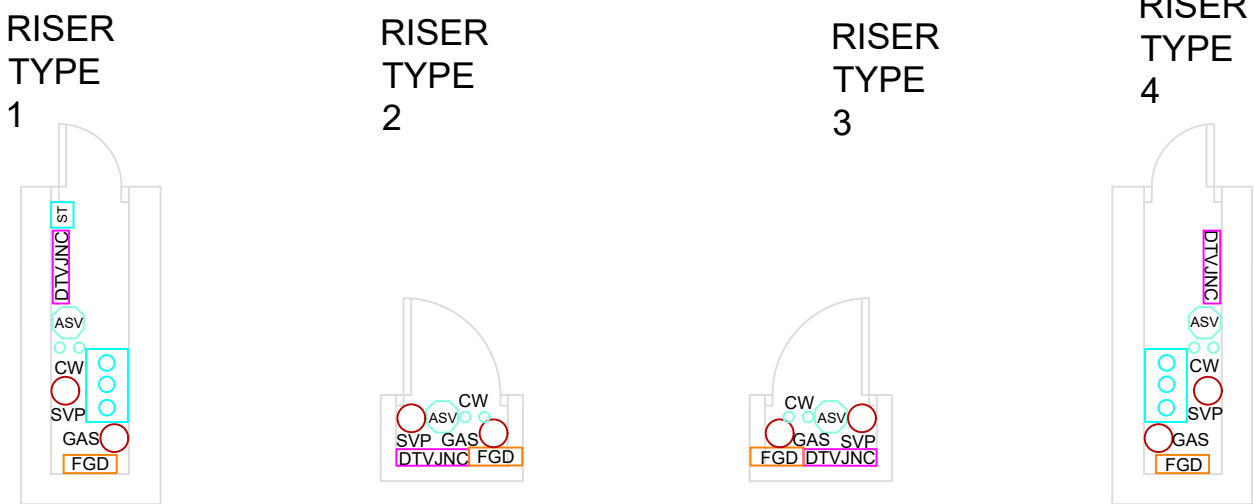

8th Floor

Key

WALL MOUNTED DIRECTIONAL ESCAPE MAINTAINED LIGHT FITTING WITH LEGEND	
INTERNAL LIGHT FITTING- BULKHEAD MAINTAINED- COMPACT FLUORESCENT - CIRCULAR TYPE	
INTERNAL LIGHT FITTING- BULKHEAD (NON-MAINTAINED- EMERGENCY COMPACT FLUORESCENT - STANDARD TYPE)	
INTERNAL LIGHT FITTING- FLUORESCENT STRIP LIGHT (NON-MAINTAINED - STANDARD TYPE)	
INTERNAL LIGHT FITTING- WALL MOUNTED FLUORESCENT) BULKHEAD (NON-MAINTAINED- COMPACT	
INTERNAL LIGHT FITTING- WALL MOUNTED EMERGENCY COMPACT FLUORESCENT BULKHEAD NON MAINTAINED	
EMERGENCY LIGHTING TEST POINT	

ELECTRICAL MAINS DISTRIBUTION

MAINS ELECTRIC FEED	
CARTRIDGE FUSE	
DISTRIBUTION BOARD- MCB PROTECTION	
ISOLATOR SWITCH	
SOLAR TRACKER INTERFACE	

FIRE

DRY RISER	
SMOKE DETECTOR HEAD	
FIRE ALARM INTERFACE	
SMOKE VENT CONTROL ACTIVATION POINT	
POSITIVE PRESSURE VENTILATION SYSTEM	
ELECTROMAGNETIC DOOR HOLD-OPEN	
FLAMMABLE GAS DETECTOR	
DOOR HOLD-OPEN DEVICE INTERFACE	
AUTOMATIC OPENING VENT	

LIFTS

LIFT MOTOR	
------------	--

SECURITY AND ACCESS CONTROL SYSTEMS

CCTV CAMERA CEILING MOUNTED (DOME)	
------------------------------------	--

SERVICES

GAS	GAS RISING MAIN
RWP	RAINWATER PIPE
SVP	SOIL VENT PIPE

HOT AND COLD WATER DISTRIBUTION AND HEATING

ANTI-SHOCK VALVE	
COLD WATER SUPPLY	
THERMOSTAT	

COMMUNICATIONS

LIFT CALL BUTTON	
DIGITAL TELEVISION JUNCTION BOX	
LIFT ALARM	

- NOTES:
- DRAWINGS TO BE READ IN CONJUNCTION WITH ALL SERVICES AND STRUCTURAL ENGINEERS DRAWINGS & SPECIFICATIONS
 - © COPYRIGHT. DRAWINGS NOT TO BE REPRODUCED OR USED WITHOUT PRIOR WRITTEN CONSENT.

SCALE @A1 DATE DRAWN BY CHECKED BY
1:100 OCT14 JW BM

DRAWING
Woolton View- Mechanical and Electrical
Installations- Eighth Floor

PROJECT
KHT Mechanical and Electrical Record Drawings

CLIENT
Knowsley Housing Trust

RIDGE

8TH FLOOR
HORTON HOUSE
EXCHANGE FLAGS
LIVERPOOL
L2 3YL

TEL: 01512433526
FAX: TBFAX
www.ridge.co.uk

DRG NO
142529/WW/8F

REV
-

FILE REFERENCE:
Woolton View

XREF FILE REFERENCE:

1 0 1 2 3 4 5
SCALE 1:100 m