


WOOLTON VIEWS
Roof Plan

Key



COMMUNAL TV AERIEL

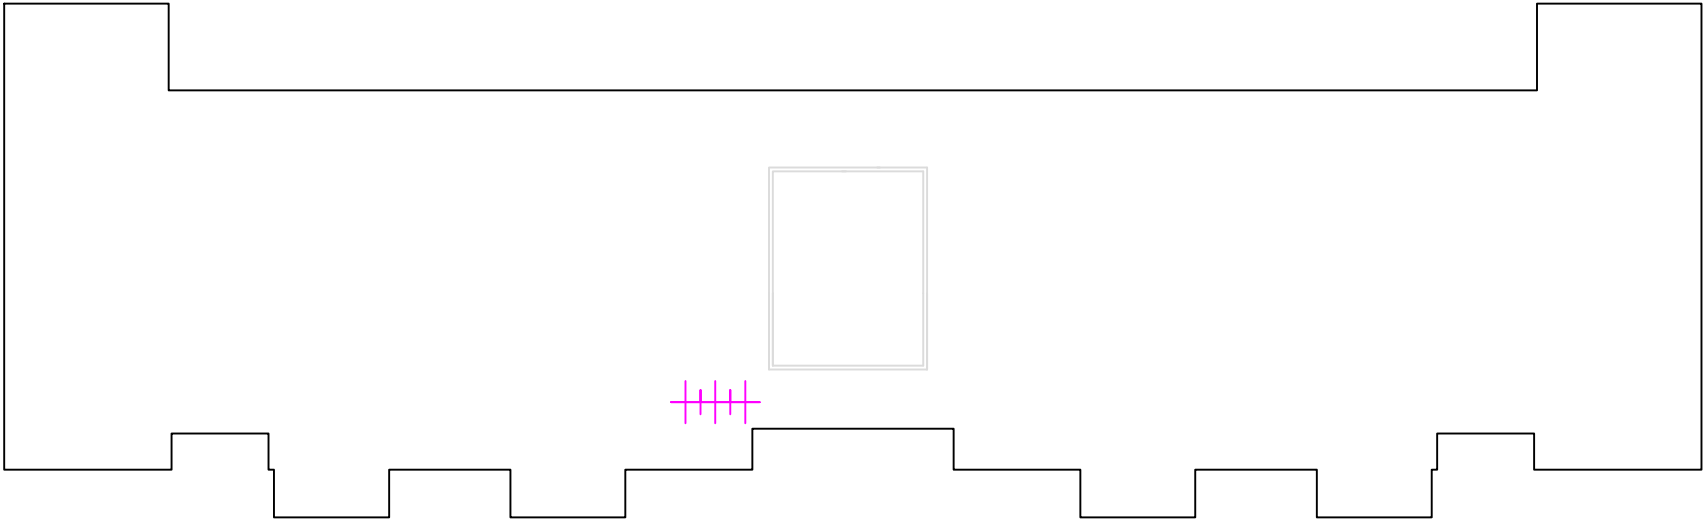

- NOTES:
- 1. DRAWINGS TO BE READ IN CONJUNCTION WITH ALL SERVICES AND STRUCTURAL ENGINEERS DRAWINGS & SPECIFICATIONS.
 - 2. © COPYRIGHT. DRAWINGS NOT TO BE REPRODUCED OR USED WITHOUT PRIOR WRITTEN CONSENT.

SCALE @A3 DATE DRAWN BY CHECKED BY
1:200 OCT14 JW BM

DRAWING
Woolton Views- Mechanical and Electrical
Installations- Roof Plan

PROJECT
KHT Mechanical and Electrical Record Drawings

CLIENT
Knowsley Housing Trust

RIDGE
8TH FLOOR
HORTON HOUSE
EXCHANGE FLAGS
LIVERPOOL
L2 3YL
TEL: 01512433526
FAX: TBFAX
www.ridge.co.uk

DRG NO
142529/WWIRP REV
-

FILE REFERENCE:
The Fairways

XREF FILE REFERENCE:

