



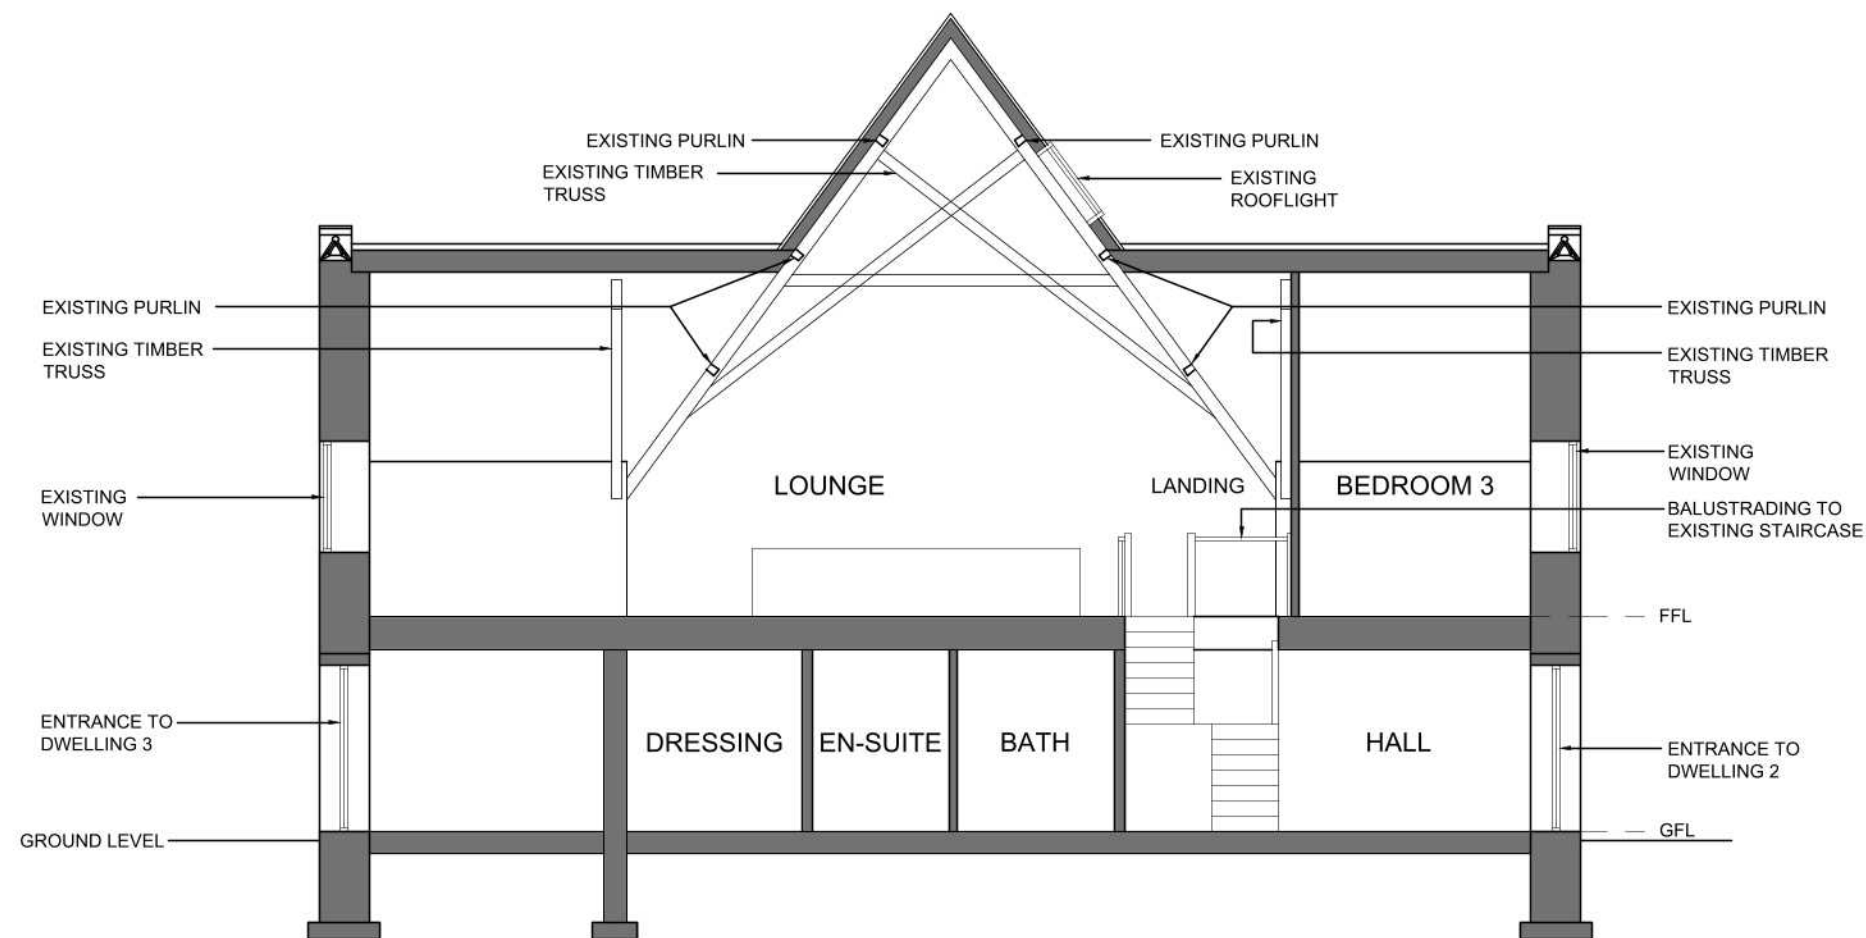


AS BUILT SECTION B-B

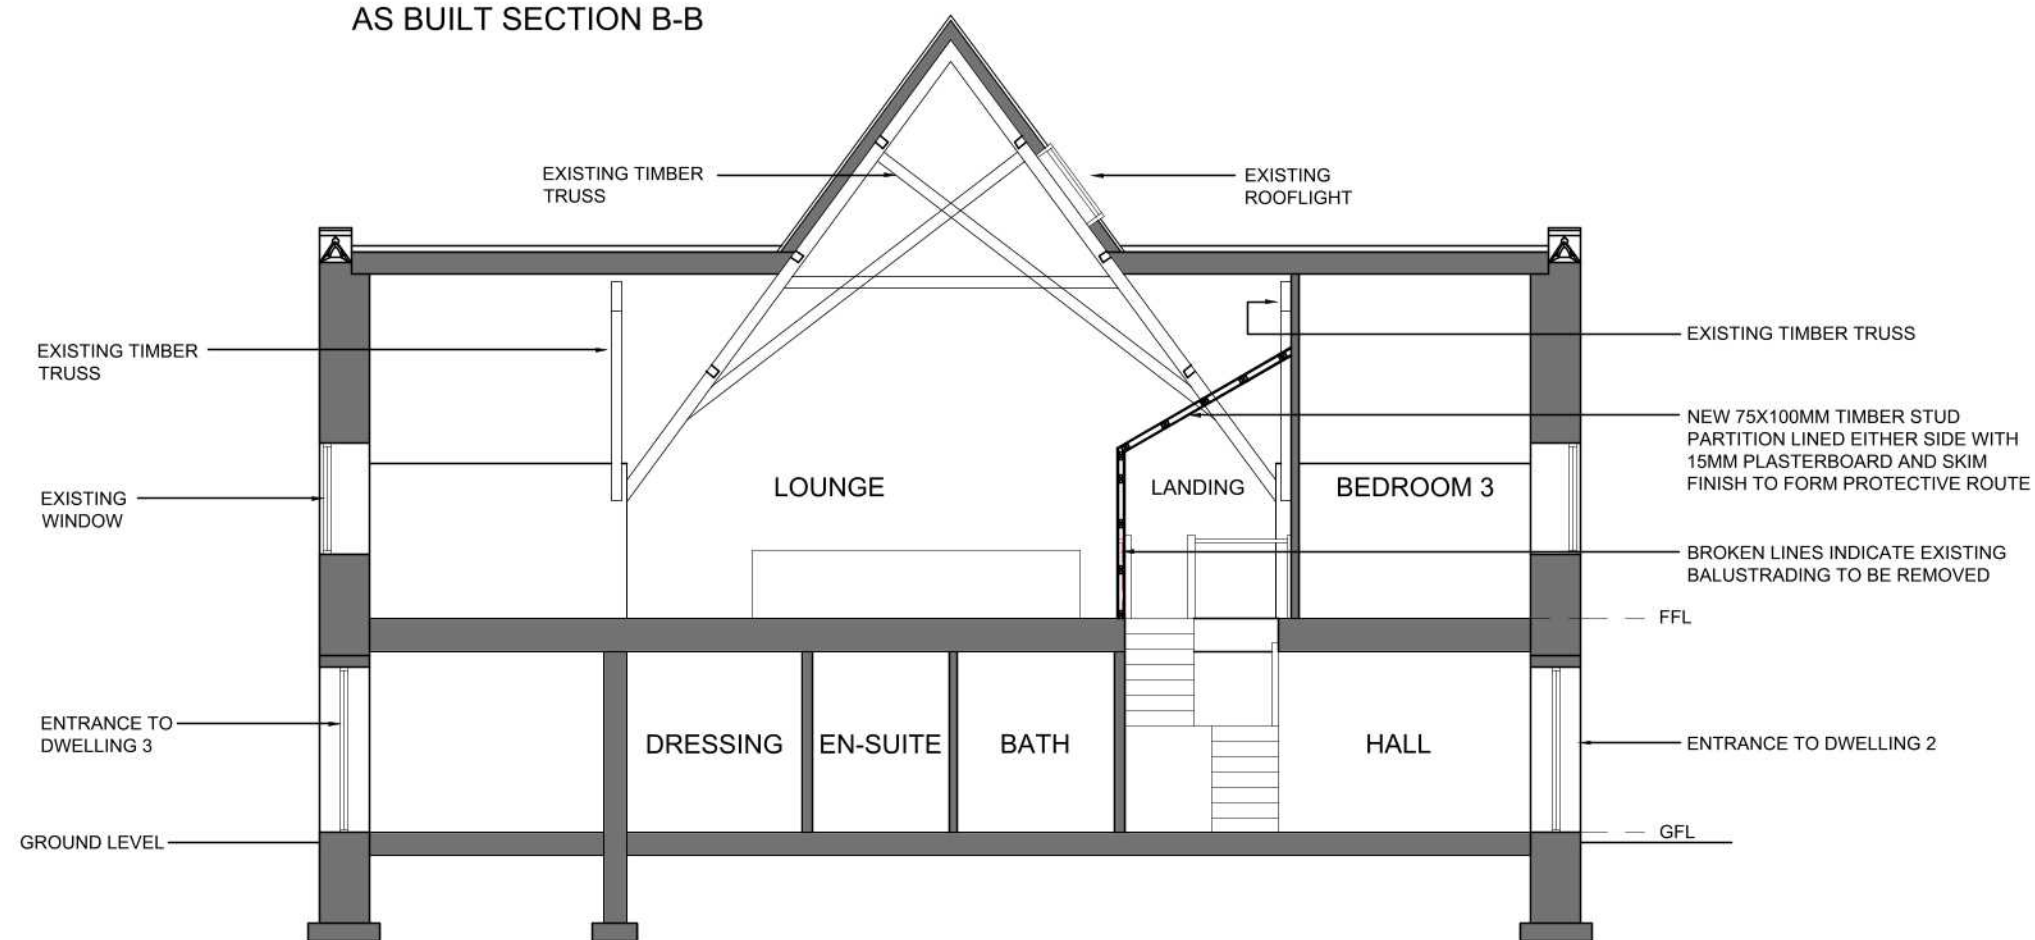

PROPOSED SECTION B-B

SCALE BAR (M)

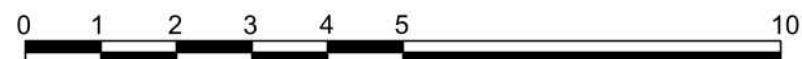

REV	DESCRIPTION
A	STUD WALL NOTE UPDATED 16.01.24 D.D.
DWELLING 2 - AS BUILT AND PROPOSED SECTION B-B PROPOSED CONVERSION OF EXISTING CHURCH INTO FIVE DWELLINGS PARK HALL, HUYTON HEY ROAD, LIVERPOOL	
CLIENT:	PARK HALL HUYTON LTD
DWG NO:	PL K1116/14
SCALE:	1/100 @ A3
DRAWN BY:	D.D.
DATE:	13/11/23
REV:	A
MICHIGAN HOUSE, 17-19 CHORLEY NEW ROAD, BOLTON, BL1 4QR TEL: 01204 392233 FAX: 01204 528505 WWW.NEILPIKEARCHITECTS.CO.UK EMAIL: INFO@NEILPIKEARCHITECTS.CO.UK	
COPYRIGHT OF THIS DRAWING REMAINS WITH THE ARCHITECT. DO NOT SCALE FROM THIS DRAWING. WORK TO FIGURED DIMENSIONS. CHECK ALL DIMENSIONS ON SITE. IN THE EVENT OF ANY DISCREPANCY REFER QUERY TO THE ARCHITECTS.	

