


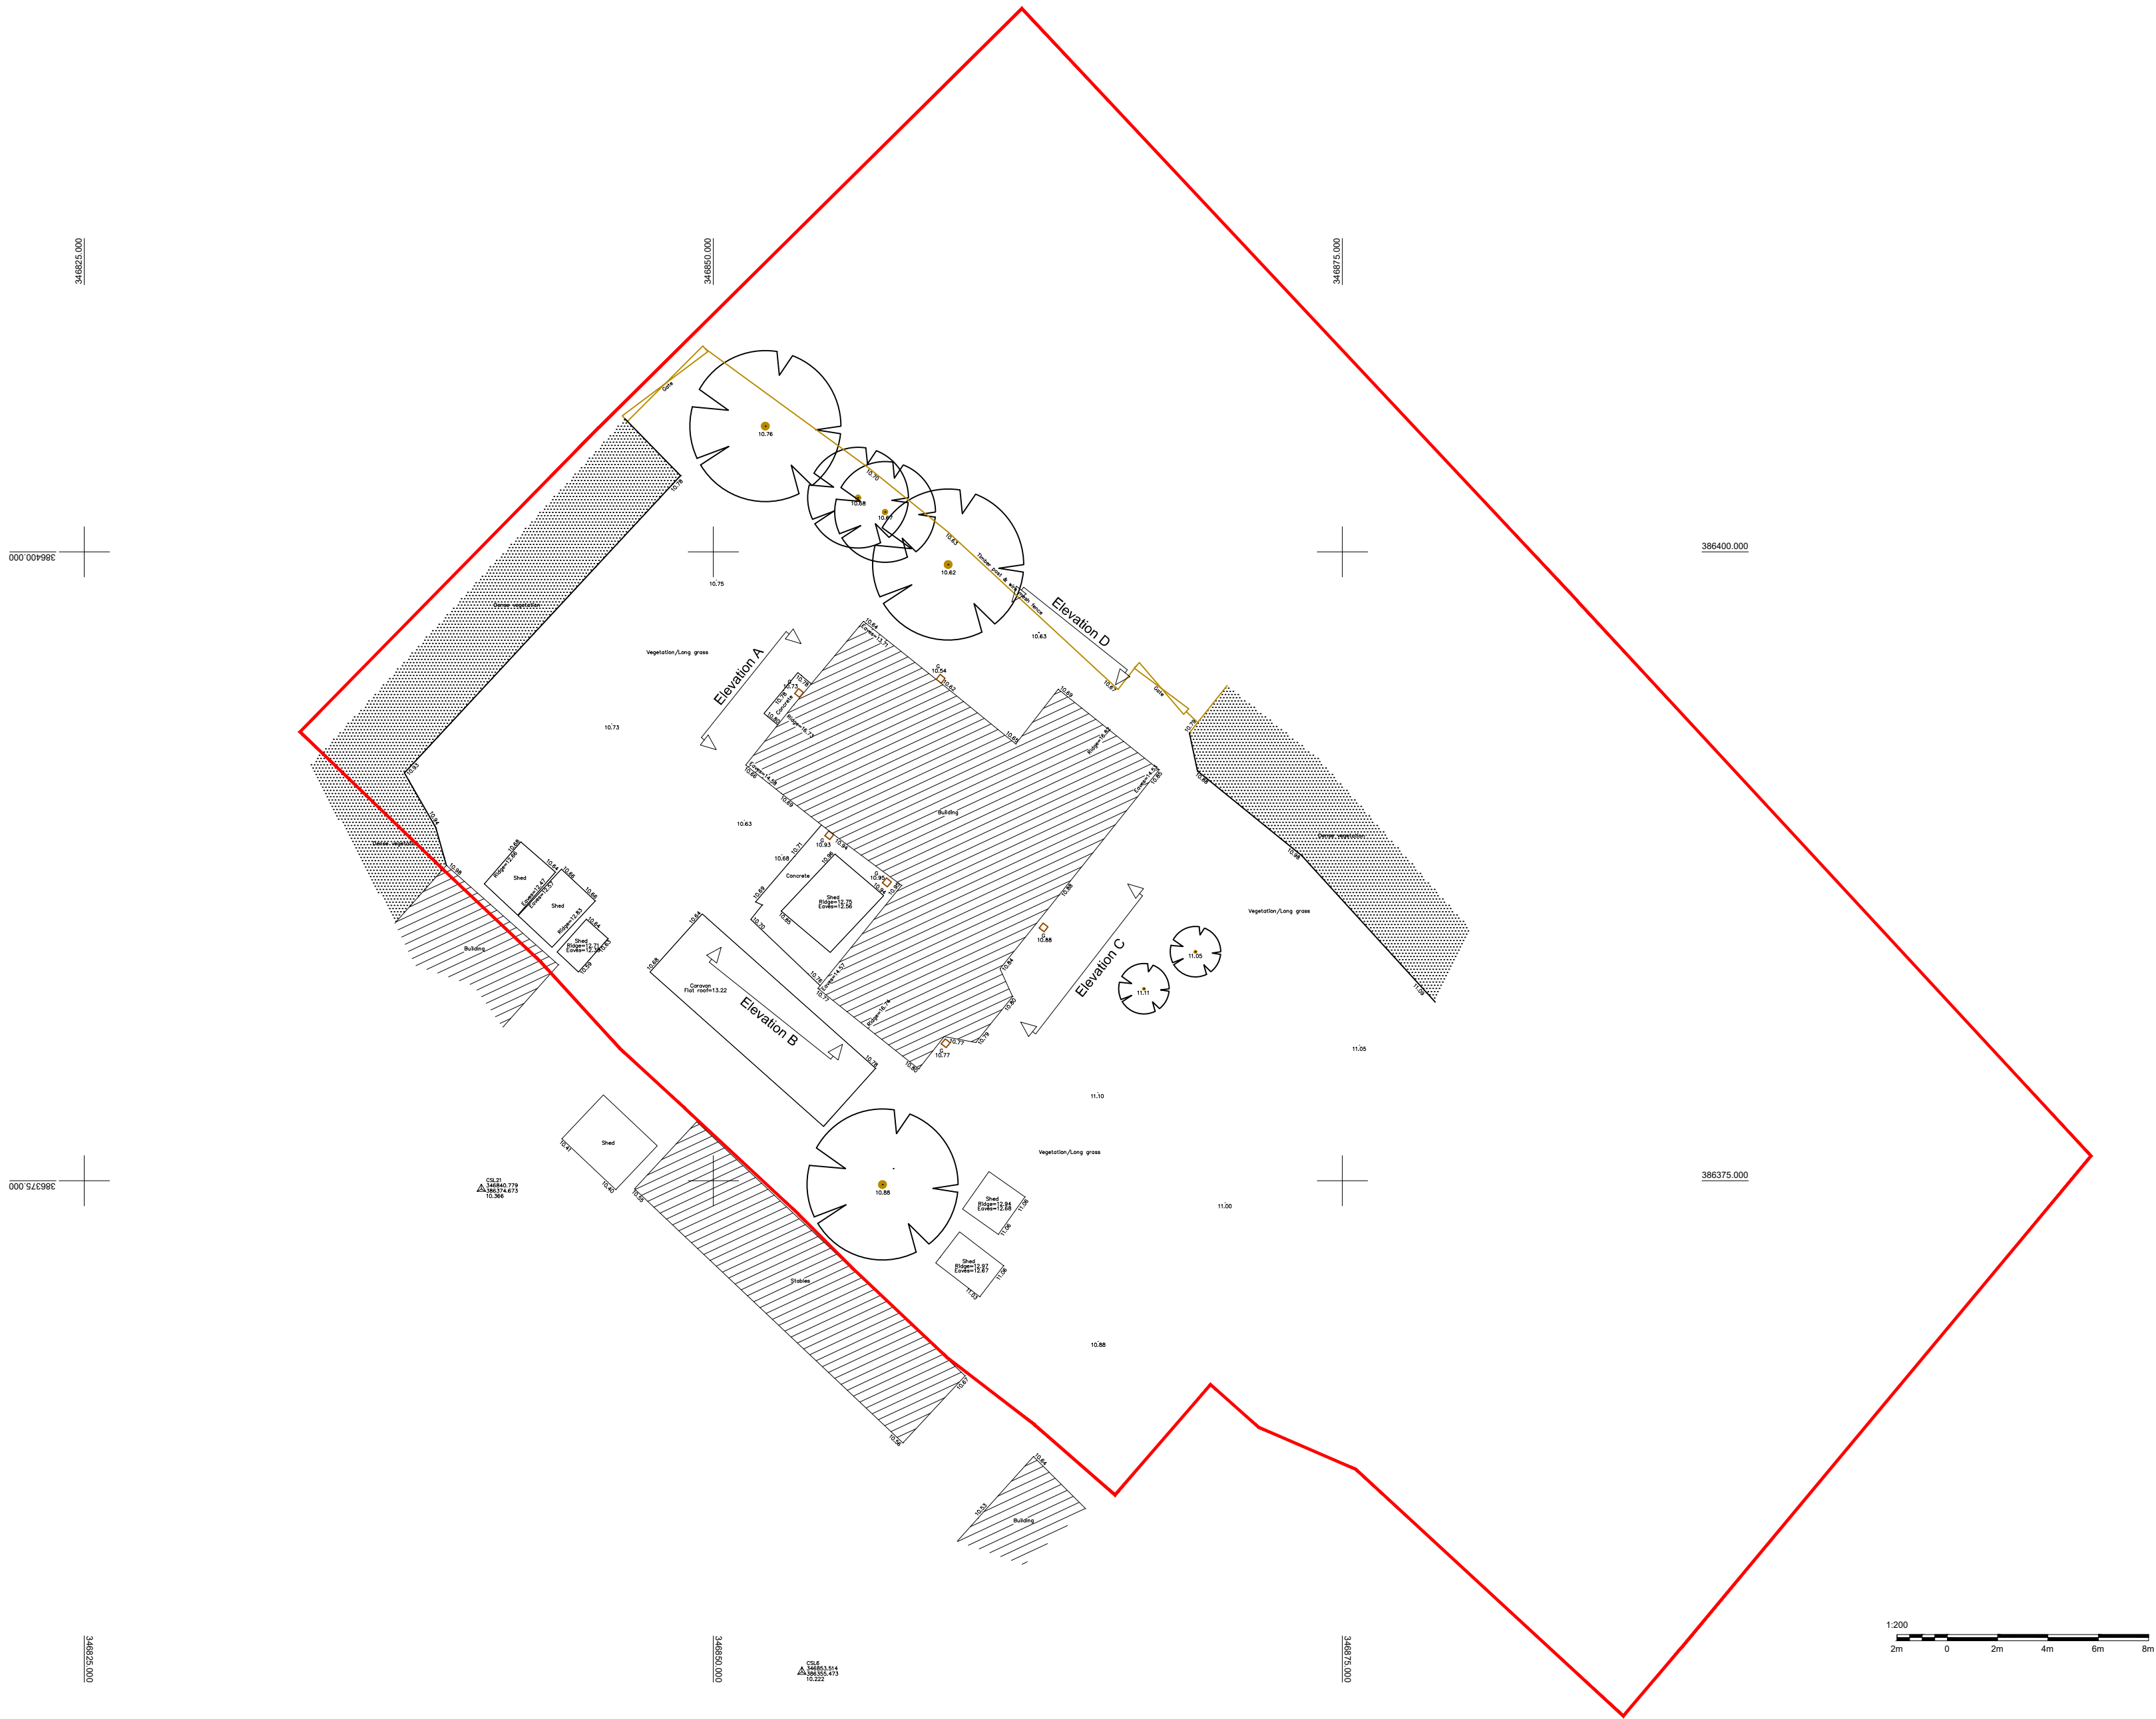

RED LINE DENOTES SITE BOUNDARY

Client				
Mr Luke Gumbley				
Project				
Spring Farm Garnetts Lane Tarbock Green Prescott L35 1QN				
Drawing Title				
Existing Site Plan / Topographical Survey				
Drawn	Checked	Drawn	Date	
PL	PL	A2	1:200 JULY 2025	
Project No	Drawing No		Revised	
25 - 992	00-02		-	



Philip Lambert Architecture Ltd.
King Edward House, 154 Clifton Drive South,
Lytham St Annes, FY8 1HG
Tel. 07811118904