


NOTE
This drawing must not be reissued, loaned or copied without the written consent of
Department of Corporate Resources, KMBC. (the originator).
All errors, omissions, discrepancies should be reported to the originator immediately.
All dimensions to be checked before site fabrication by the contractor, his sub-
contractor or supplier.


Any deviation from the drawing to be reported to the originator immediately.

Any mapped information depicted is based on Ordnance Survey material with the
permission of Ordnance Survey on behalf of the Controller of Her Majesty's Stationary
Office Crown Copyright.
Unauthorized reproduction infringes Crown Copyright and may lead to prosecution or
civil proceedings.
Knowsley MBC, LA 100017655
Ref: MAPREF


Drawing issue status:
PRELIMINARY ☐ CLIENT APPROVAL ☐ PLANNING ☐
BUILDING REGS ☐ TENDER ☐ CONSTRUCTION ☐ AS-BUILT ☐

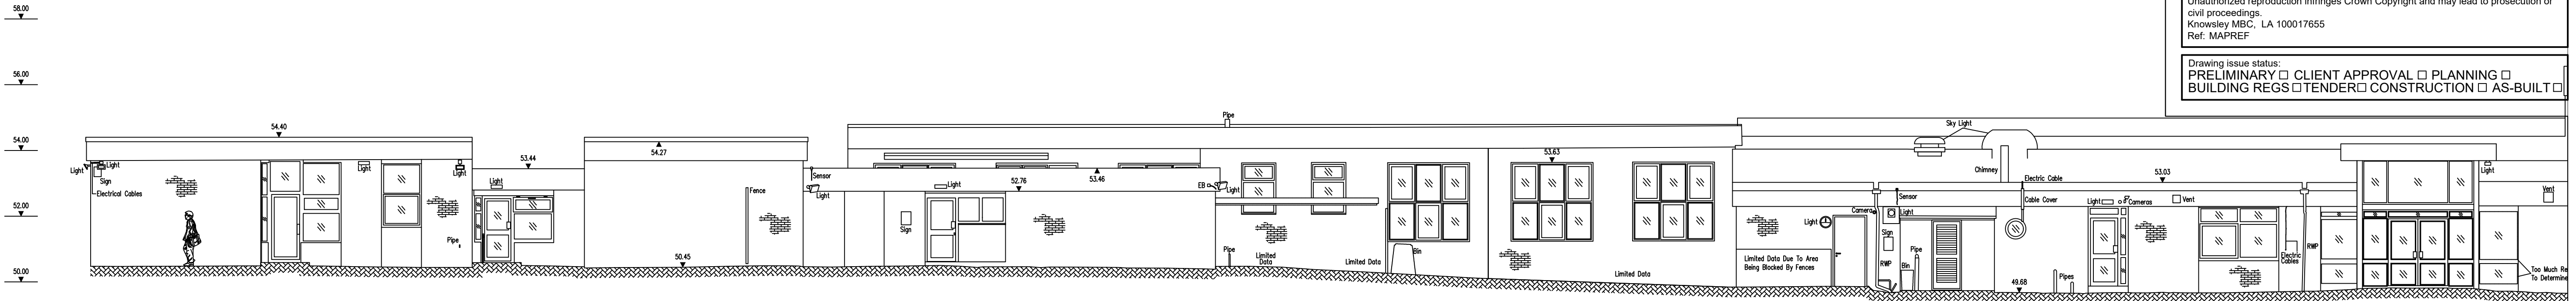

Elevation A

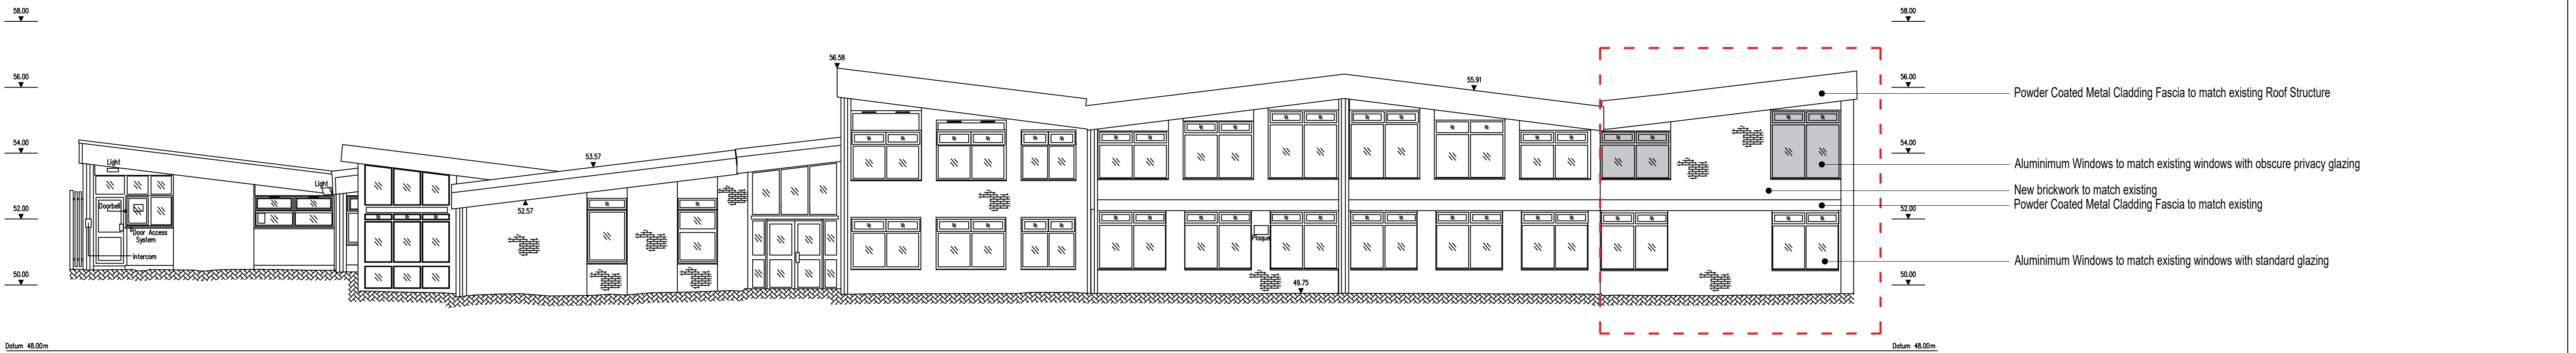

Elevation B

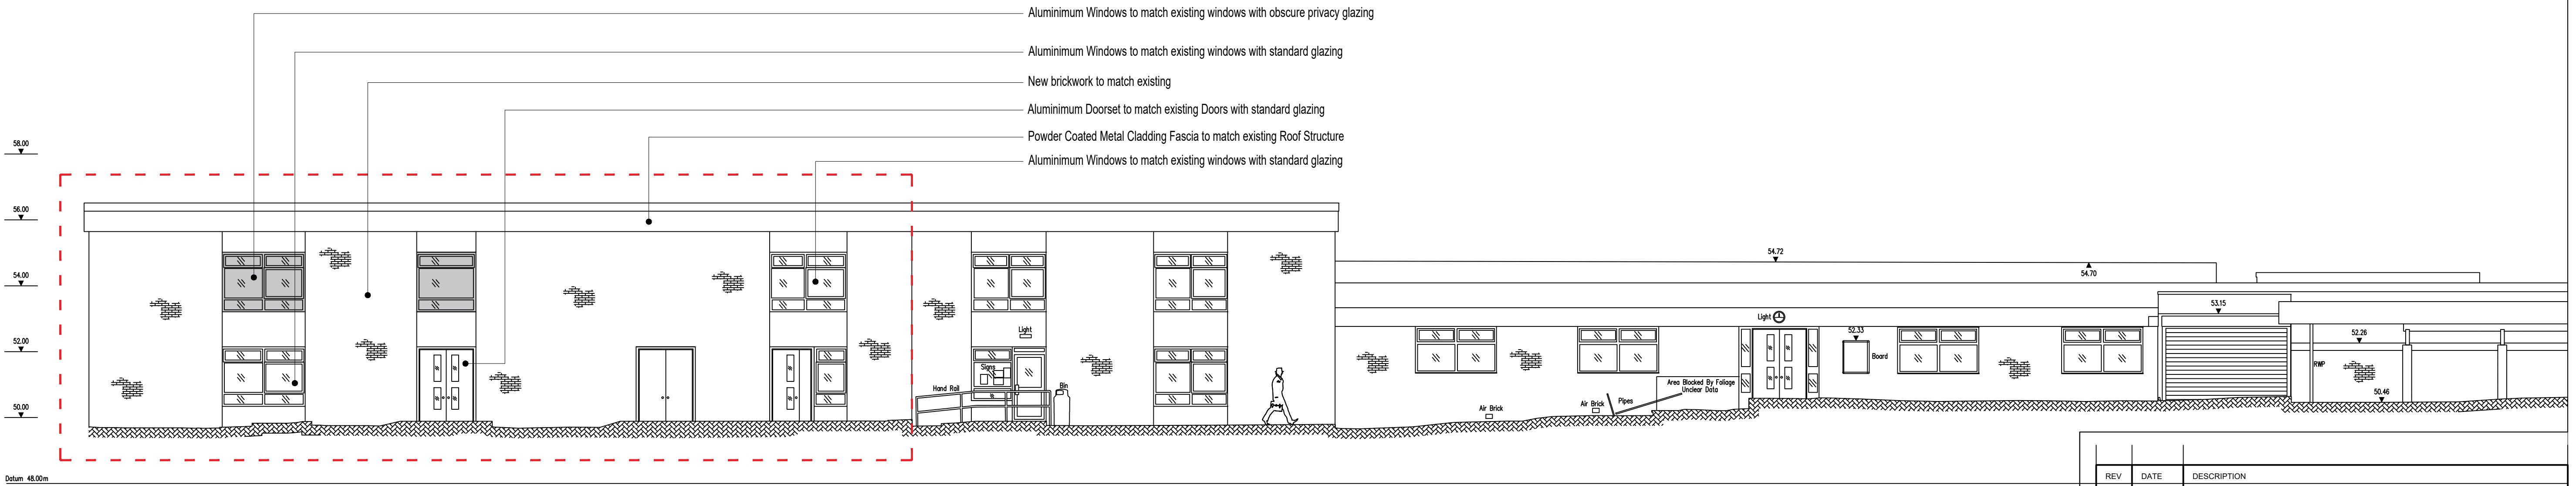

Elevation C

REV	DATE	DESCRIPTION
 Directorate of Corporate Resources Asset Management 2nd Floor Yorkon Buildings Archway Road Merseyside, L36 9YU TEL:0151 443 2611 FAX:		
PROJECT	CLIENT	
PLANTATION SCHOOL REFURBISH	CHILDREN'S SERVICES	
SUBJECT	SHEET SIZE	DATE
PROPOSED ELEVATIONS		01.10.22
		SCALE
		1:100
PROJECT NR	DRAWING NR	REV
2022/10/A	07	-
	DW	DW