
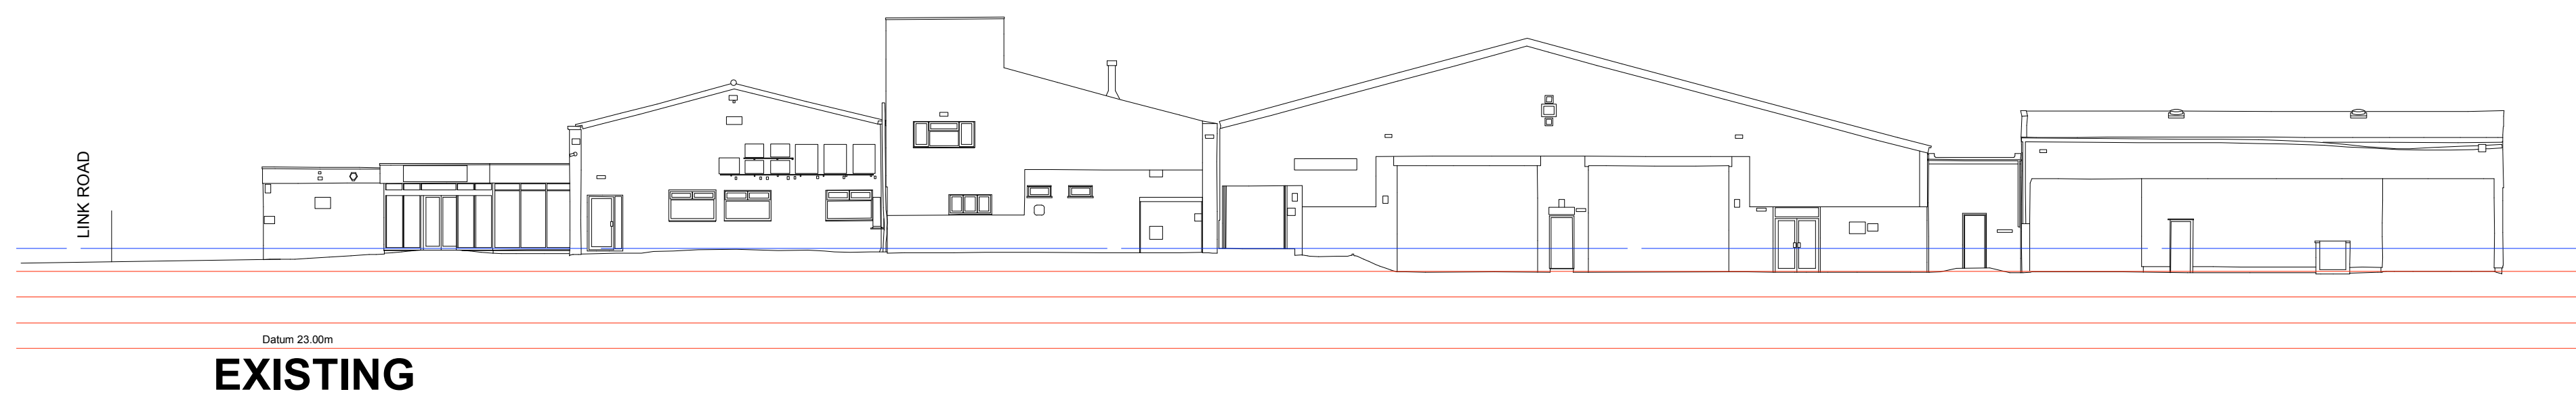


FRONT ROAD ELEVATION (WEST)

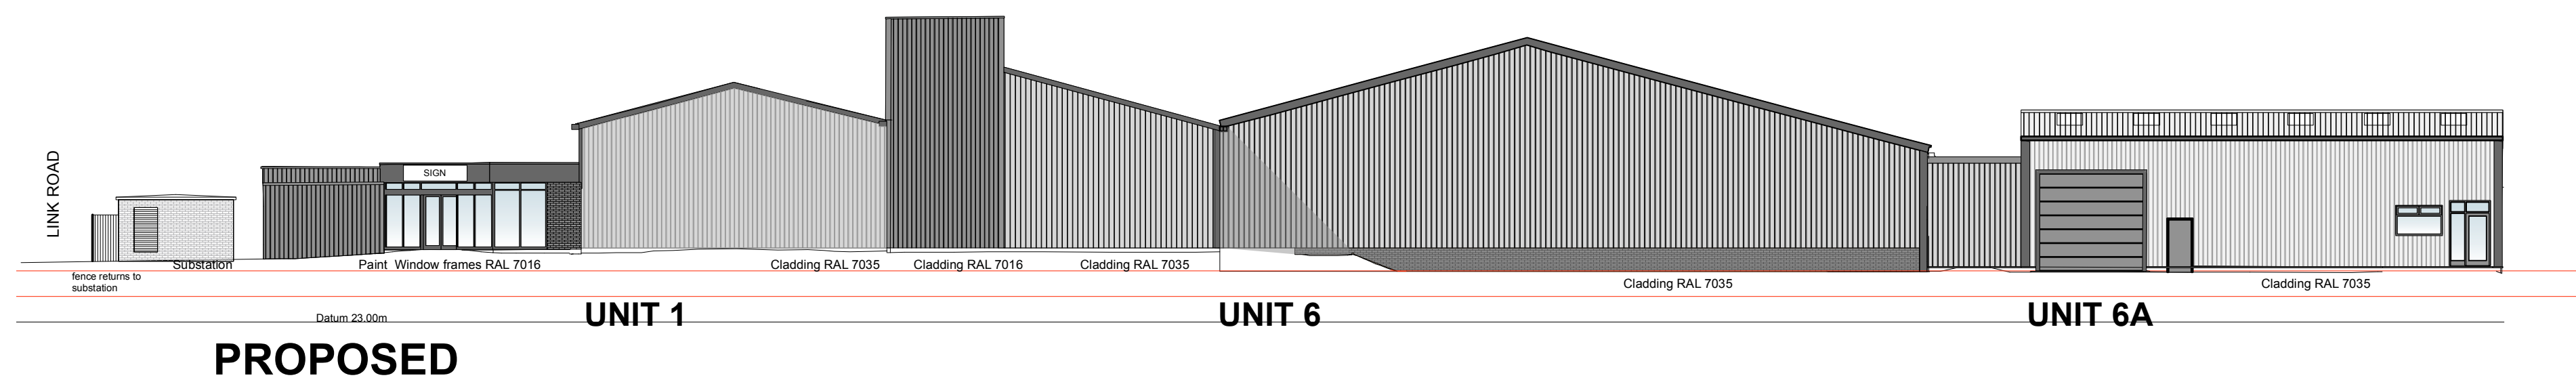

RH SIDE ELEVATION (SOUTH)

MATERIALS:

Roof Cladding: Profiled metal RAL 7035

Wall Cladding: Profiled metal RAL 7035 with accent areas RAL 7016

Fascais, doors and flashing trims: RAL 7016

Rev D: 17 1 24 Updated as built
Rev C: 9 2 23 Personnel door amended unit 4
Rev B: 8 2 23 Doors amended to front of Unit 2, 4 and 5
Rev A: 8 9 22 Substation set back 1m

Project	Link Road Site Huyton	Drawing Title	AS BUILT FRONT & RH SIDE ELEVATIONS		
Client	LINK DEVELOPMENTS (NW) LTD	Drawing No	20035 P106	rev	D
Status	PLANNING APPLICATION				
Scale	1:200	Drwg size	A1		
Drawn	TH	Date	27 05 2022		

Damson Consultancy Limited
Park View Farm Studio
Kilby Lonsdale
Cumbria
015395 41743
huyton@damsondesign.com architects and landscape designers

damson consultancy

