



PROPOSED

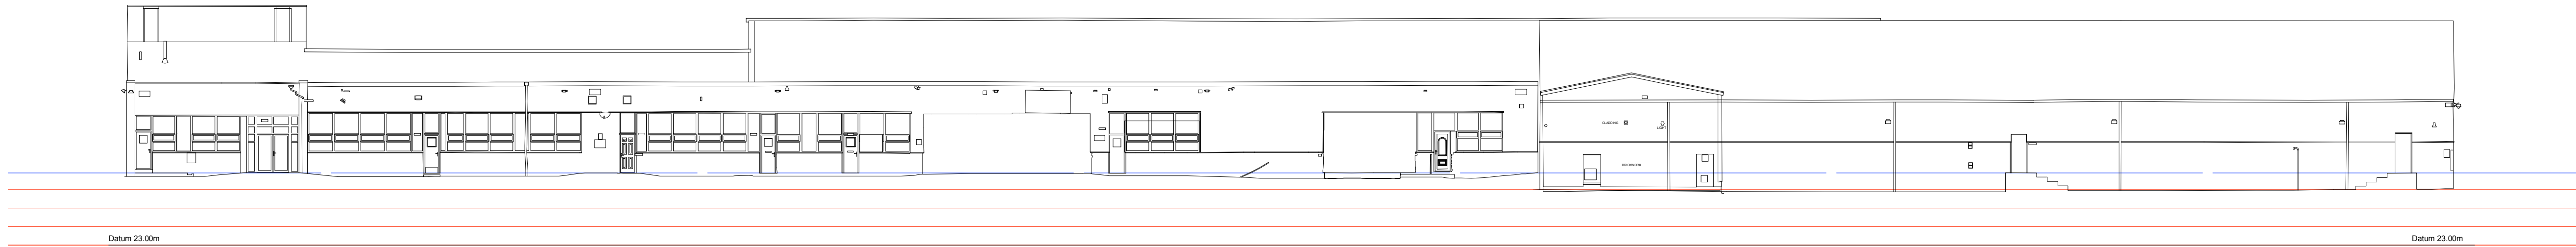


EXISTING

REAR ELEVATION (EAST)

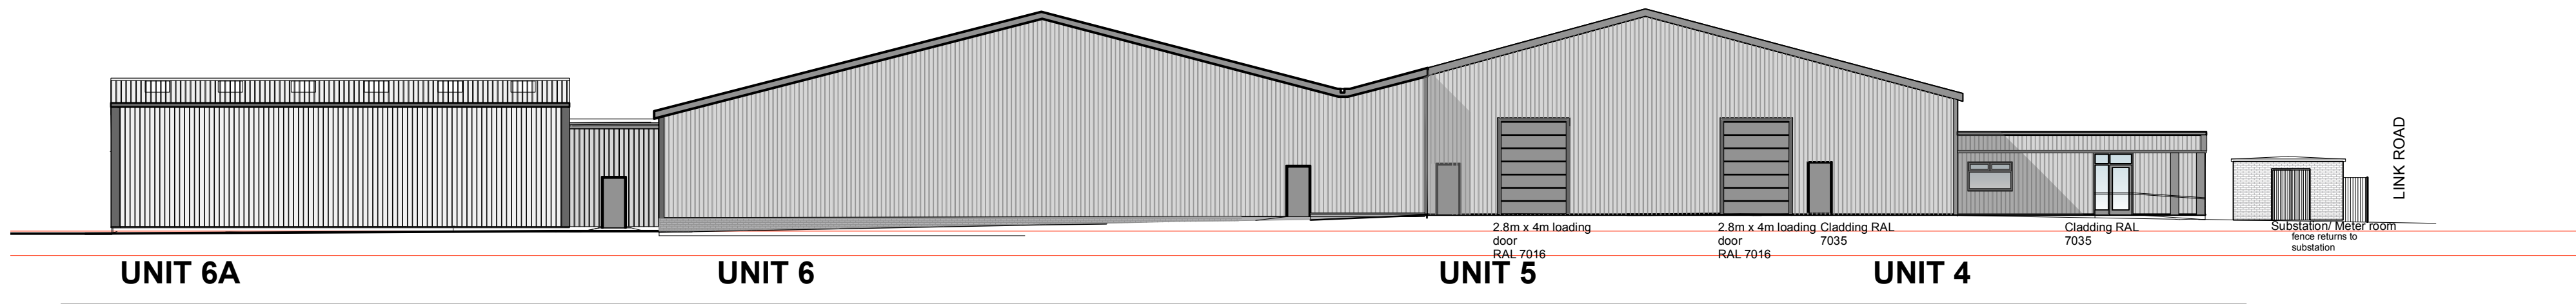

PROPOSED

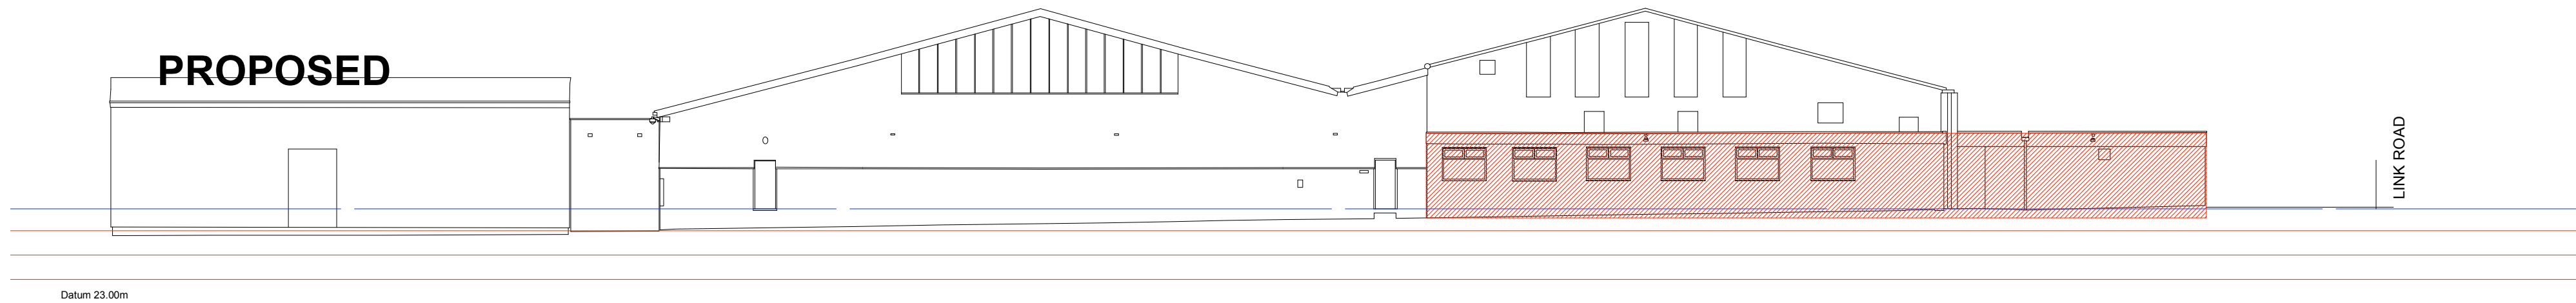

EXISTING

LH SIDE ELEVATION (NORTH)

MATERIALS:

Roof Cladding: Profiled metal RAL 7035

Wall Cladding: Profiled metal RAL 7035 with accent areas RAL 7016

Fascais, doors and flashing trims: RAL 7016

Rev D: 17 1 24 Updated as built
Rev C: 9 2 23 Personnel doors amended Unit 4
Rev B: 8 2 23 Doors amended Unit 4
Rev A: 8 9 22 Substation set back 1m

Project	Link Road Site Huyton		Drawing Title		AS BUILT REAR & LH SIDE ELEVATIONS	
			Drawing No	20035 P107	rev	D
Client	LINK DEVELOPMENTS (NW) LTD					
Status	PLANNING APPLICATION					
Scale	1: 200	Drwg size	A1			
Drawn	TH	Date	27 05 2022			

Damson Consultancy Limited
Pelle Wolf from Studio
Kilby Lonsdale
Consulting
015395 41743
huyton@damsondesign.com

architect and landscape designers



