
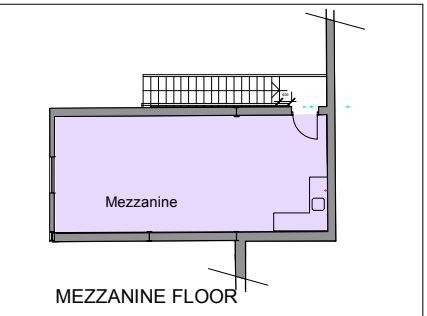


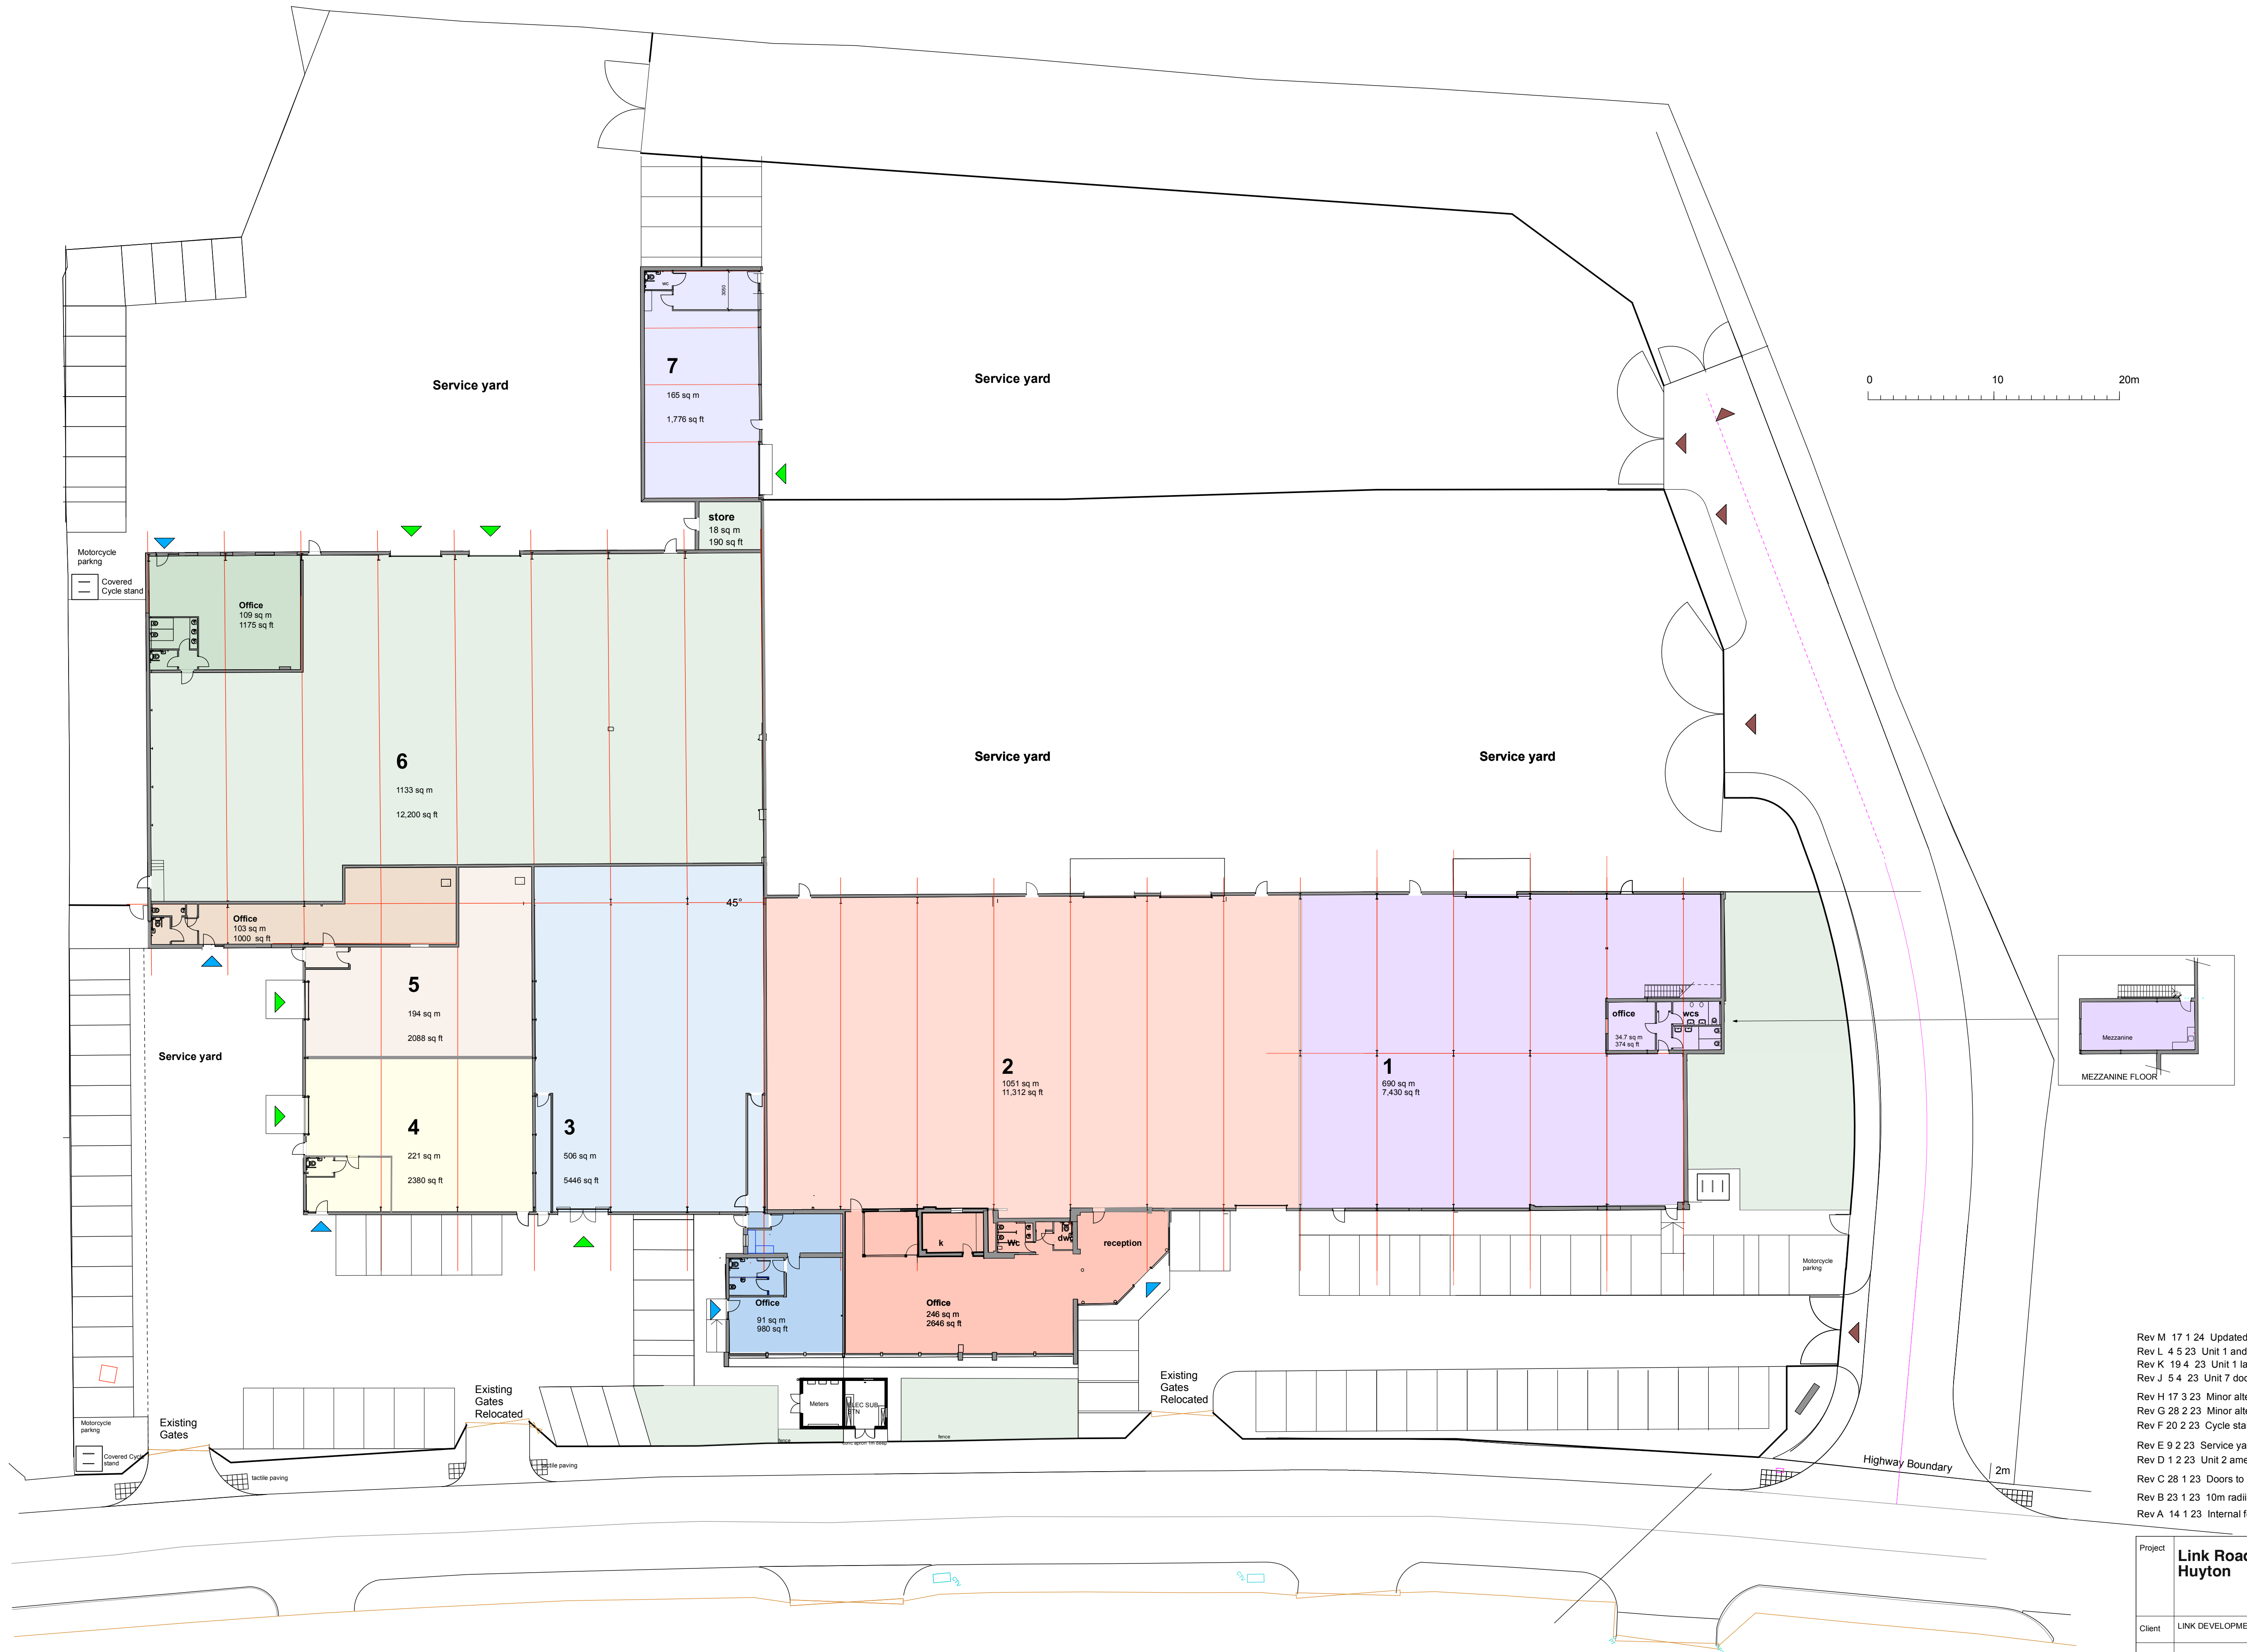

Rev M 17 1 24 Updated As Built
Rev L 4 5 23 Unit 1 and 2 combined as Unit 1
Rev K 19 4 23 Unit 1 layout amended
Rev J 5 4 23 Unit 7 door amended; unit 2 wc amended
Rev H 17 3 23 Minor alterations
Rev G 28 2 23 Minor alterations
Rev F 20 2 23 Cycle stands and motorcycle parking shown
Rev E 9 2 23 Service yard fence adjustment unit 2; door relocated unit 4
Rev D 1 2 23 Unit 2 amended; Unit 4 wc amended
Rev C 28 1 23 Doors to Unit 4 and 5 amended to suit structure
Rev B 23 1 23 10m radii and access points annotated
Rev A 14 1 23 Internal fences amended

Project	Link Road Site Huyton		Drawing Title	AS BUILT SITE PLAN	
			Drawing No	20035 P115	rev M
Client	LINK DEVELOPMENTS (NW) LTD				
Status	PLANNING APPLICATION				
Scale	1: 250	Drwg size	A1	Damson Consultancy Limited Pebble Team Studio Oakley Lane Cumbria LA1 1JF 015395 41743 henry@damsondesign.com architects and landscape design  damson consultancy	
Drawn	TH	Date	01 12 22		