



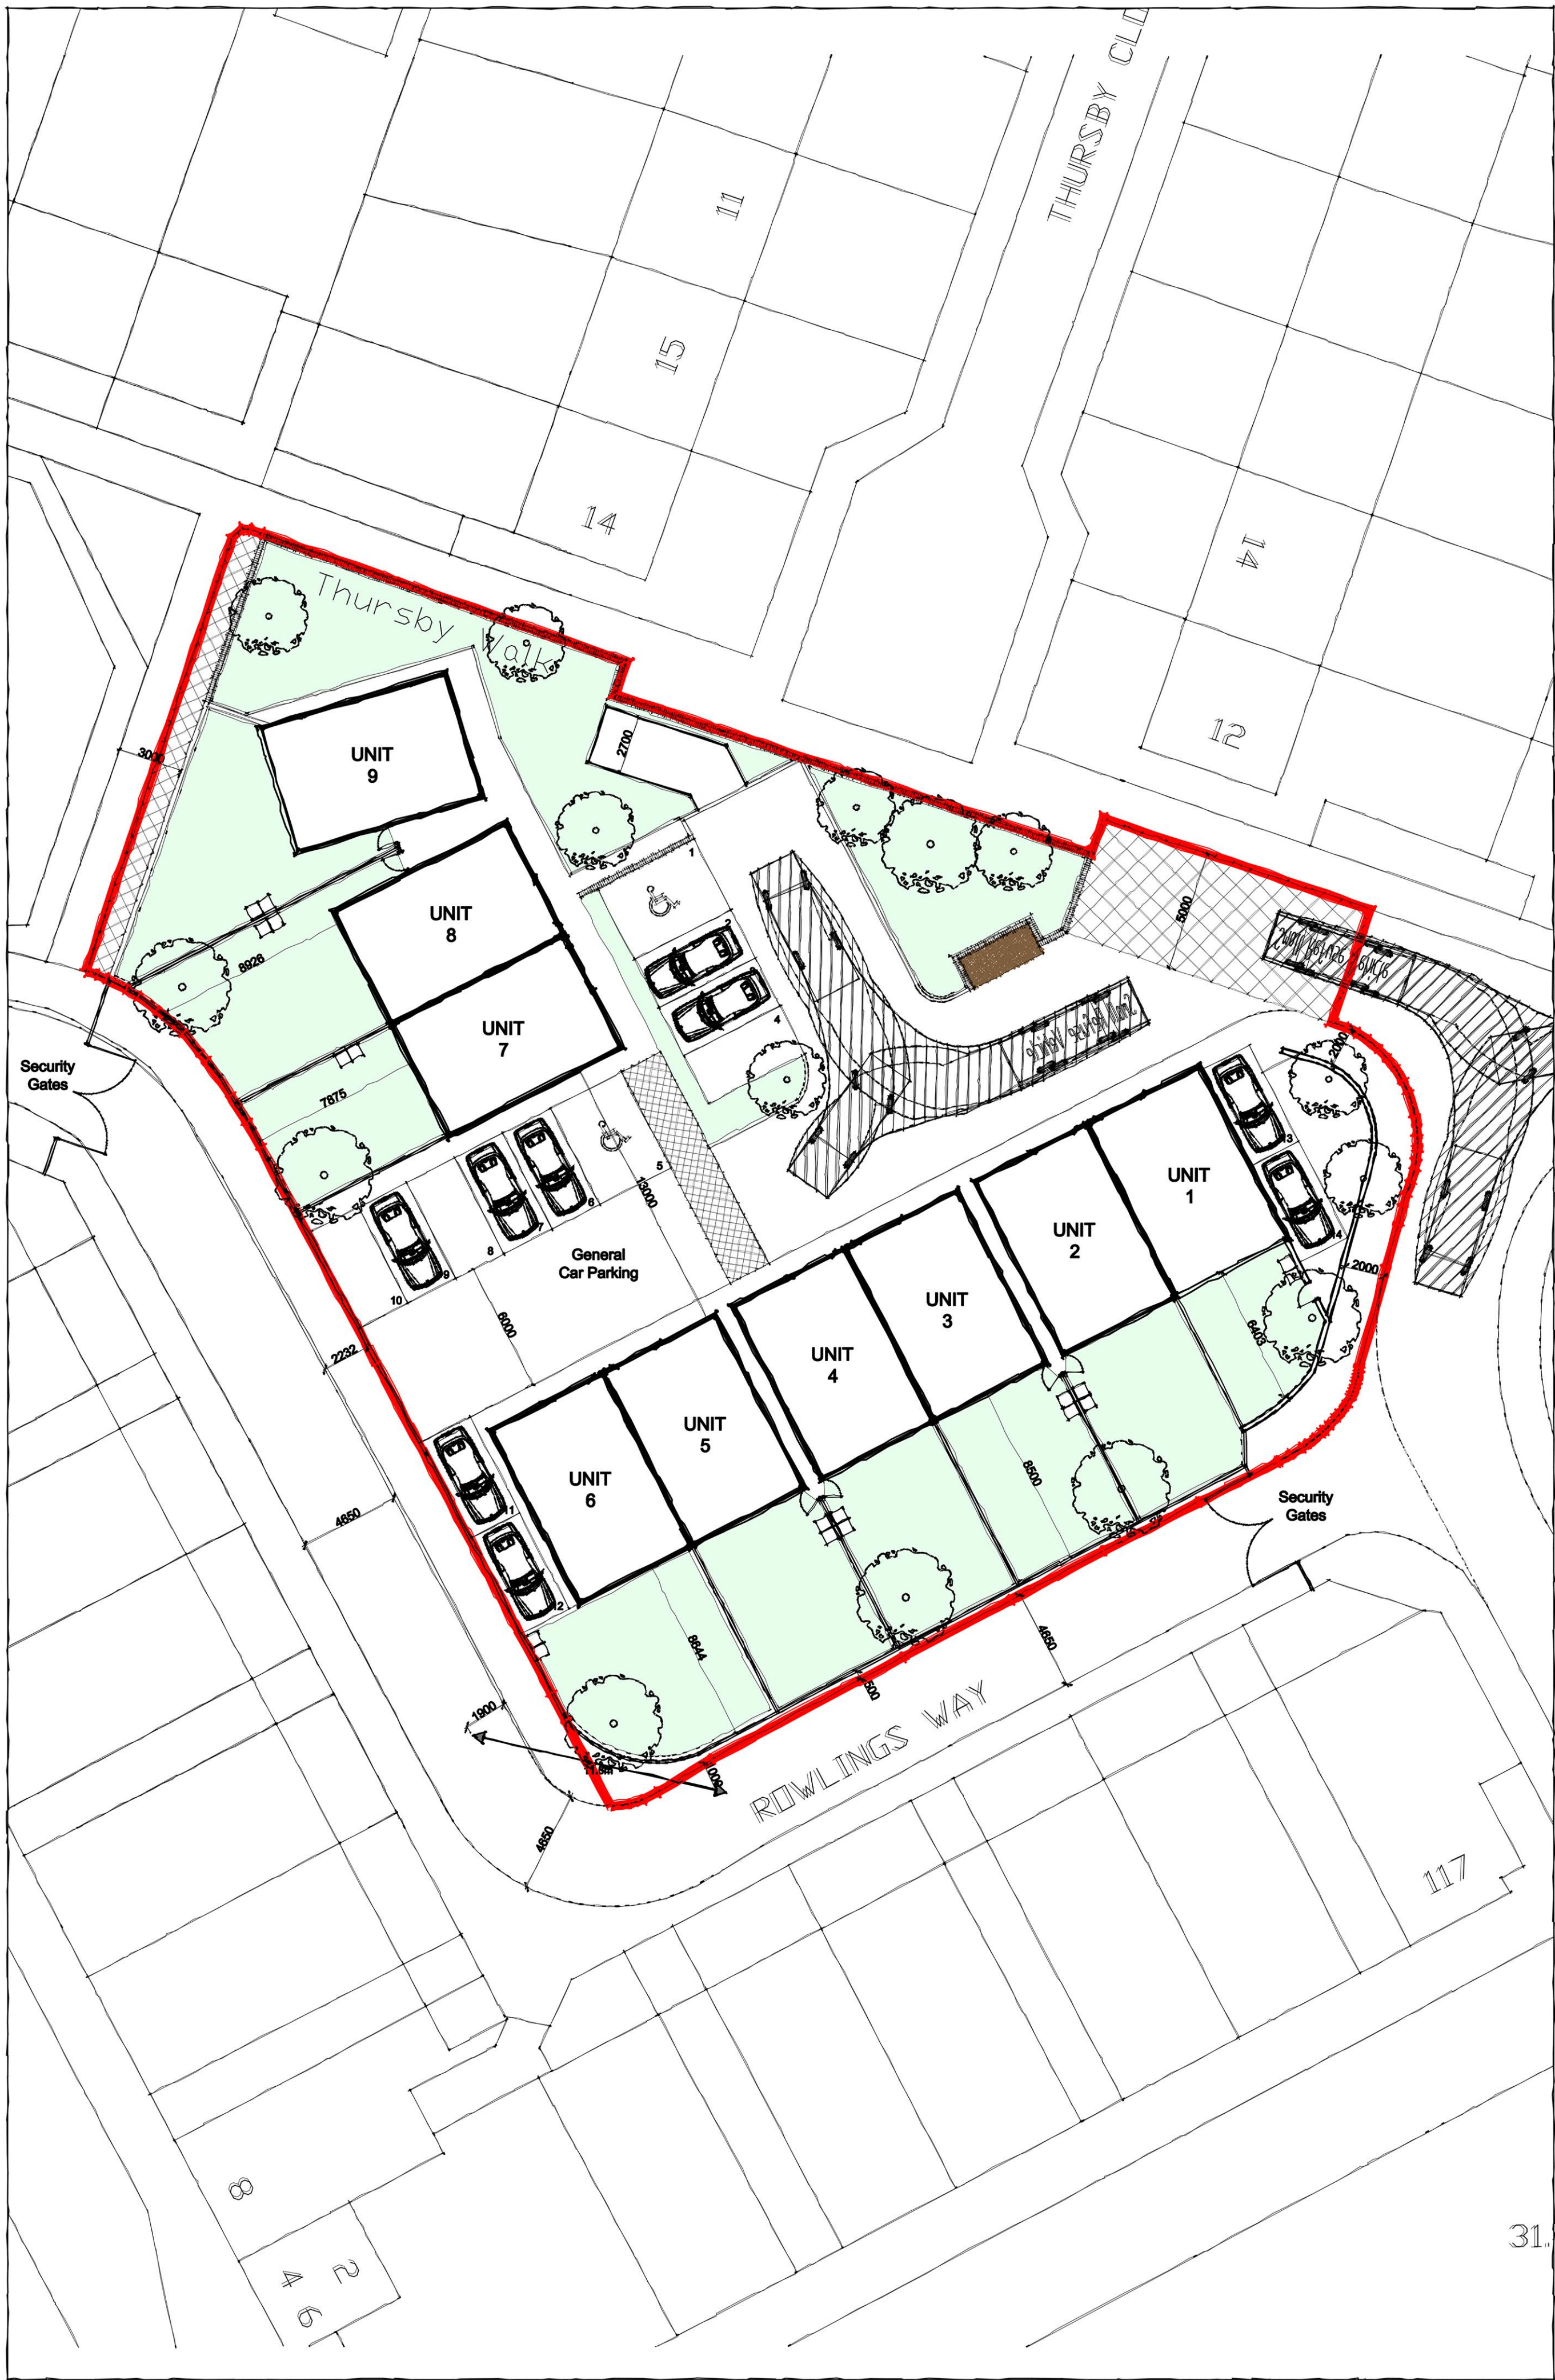

Approved Site Plan
Scale 1:200

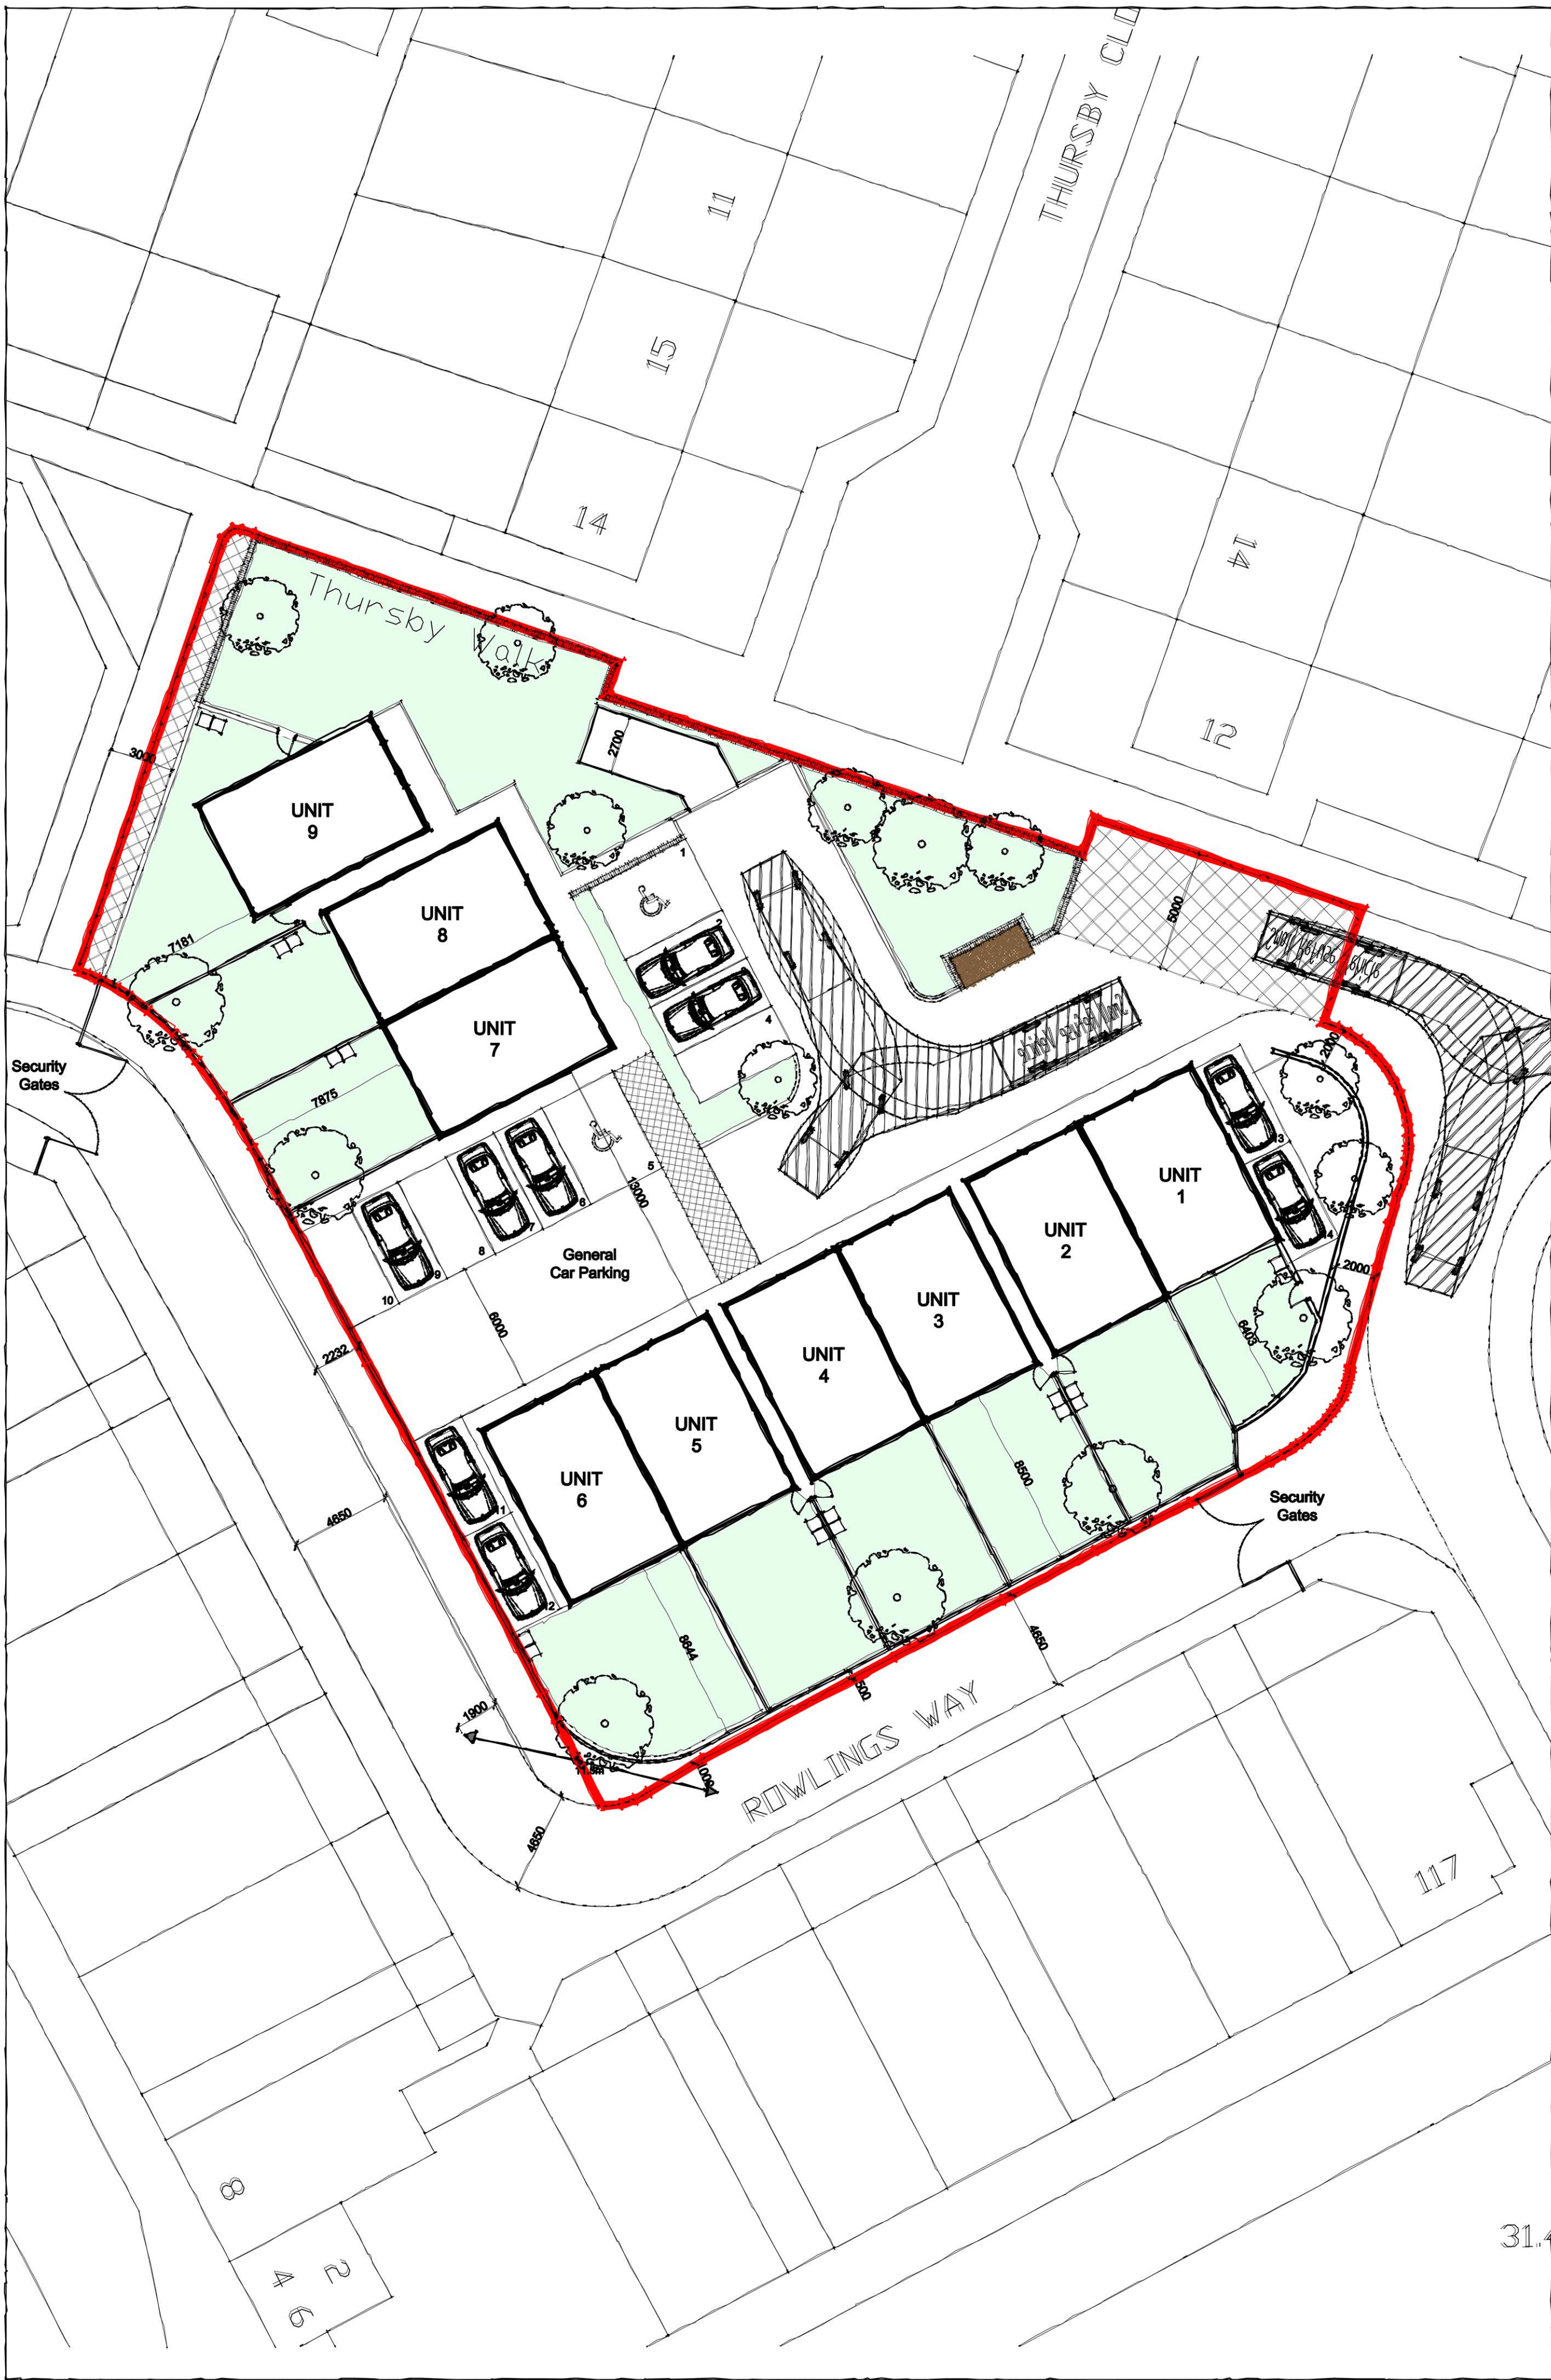

As-Built Site Plan
Scale 1:200

NOTES
All dimensions to be checked on site. Figured dimensions to be read in preference to scaled. Architect accepts no responsibility for any unauthorised amendments to the drawing and does not permit unauthorised copying of the drawing. This drawing is copyright and remains the property of Architect unless otherwise agreed.



1:200 Scale Bar
0 5 10 METRES



Photo 1 - Side View from Unit 8



Photo 2 - End Gable of Unit 9



Photo 3 - Front View of Unit 8 & 9



Photo 4 - Corner View of Unit 9

Client			
TBC			
Project Name			
9 No. Retirement Bungalows, Thursby Walk, Kirkby			
Drawing Title			
Approved & As-Built Site Plan			
Scale	Original Size	Planning	
1:200	A1	Checked	Approved
Date	Drawn	Checked	Approved
20.02.23	-	-	-
Drawing Number	Status		
500	Revision		