
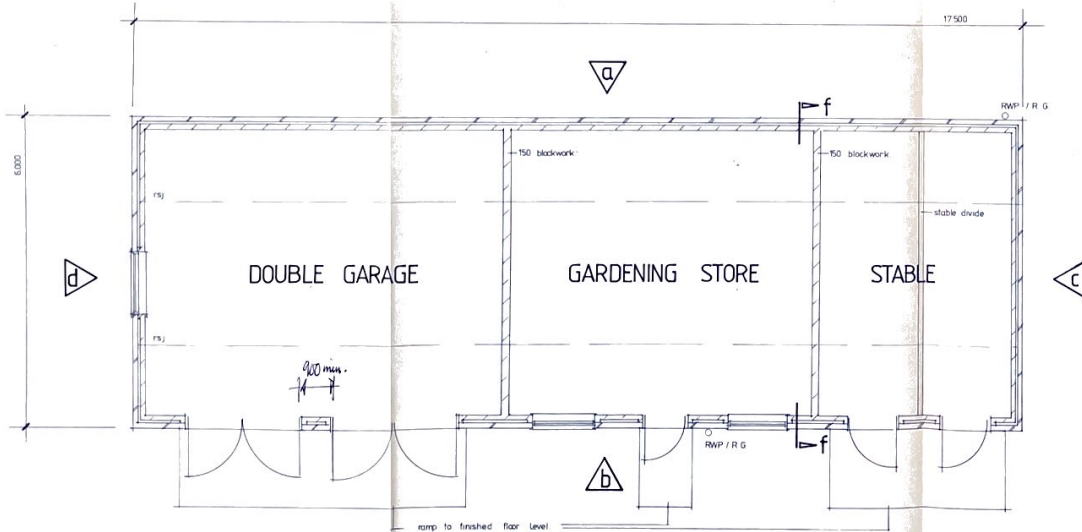


DECLARATION OF PASSING OF PLANS SUBJECT TO CONDITIONS

Your attention is drawn to the amendments/endorsements shown in red on the attached approved plan(s).


Please ensure that the Builder or person carrying out the Building work is made aware of these revisions and are incorporated into the construction as work proceeds on site.

Enforcement procedure for breach of the Building Regulations will be instigated under the Building Act if you fail to adhere to the revisions and other details shown on the approved plans.

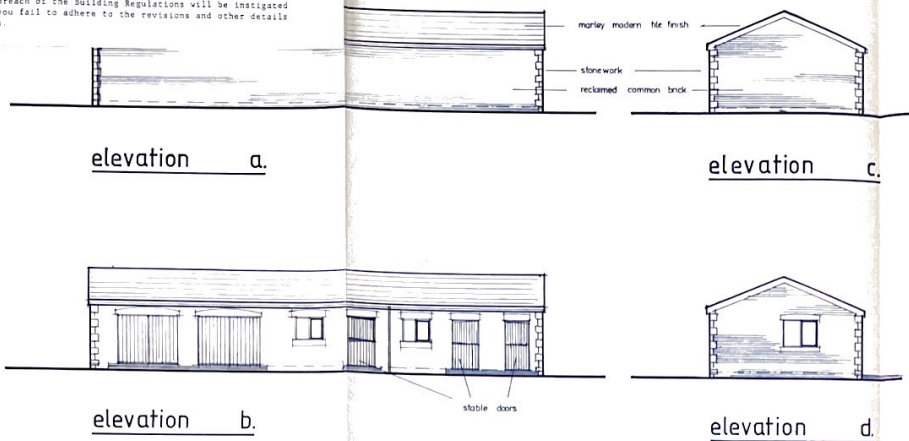


plan.

METROPOLITAN BOROUGH
OF
KNOWSLEY
APPROVED PLAN FOR
THE PURPOSES OF THE
BUILDING REGULATIONS
DATE: 15 JUL 1991

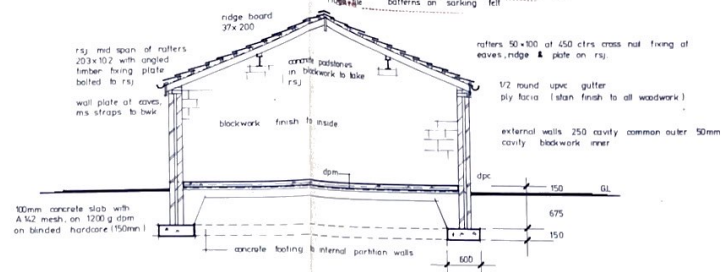

section f-f.

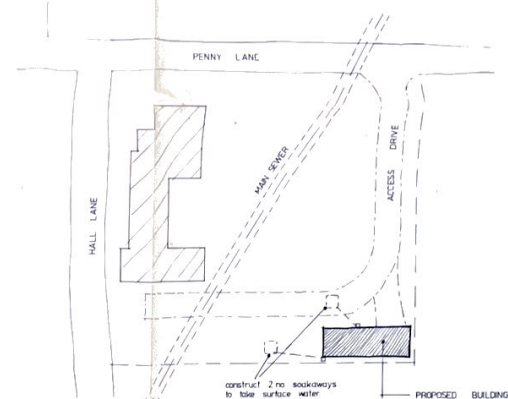

PROPOSED GARAGE / STABLE.

at: TOWN END FARM BARN.
CRONTON, WIDNES.
for: MR. CARL FLUTE.

SCALE 1:50 / 1:100 / 1:500 AUGUST 90 C.F. 01.

NOTE:

1. External wall plate fixed to top flange of beam and rafters spaced
2. This is
3. D.B. to be protected on 16" x 4" x 6" deep core pads.
4. D.B. to be connected to peak with very hot and fixed to walls.
5. Central part between garage door 100mm.
6. 4" x 16" on top of 11" profile spread.
7. 100mm
8. 100mm
9. 100mm
10. 100mm

Signed: K.King 15.7.91
mailey modern roof lies on 38x19 s.w.
ridgeline battens on parking left

KNOWSLEY M.B.C.
DATE - 5 JUN 1991
BUILDING REGULATIONS