


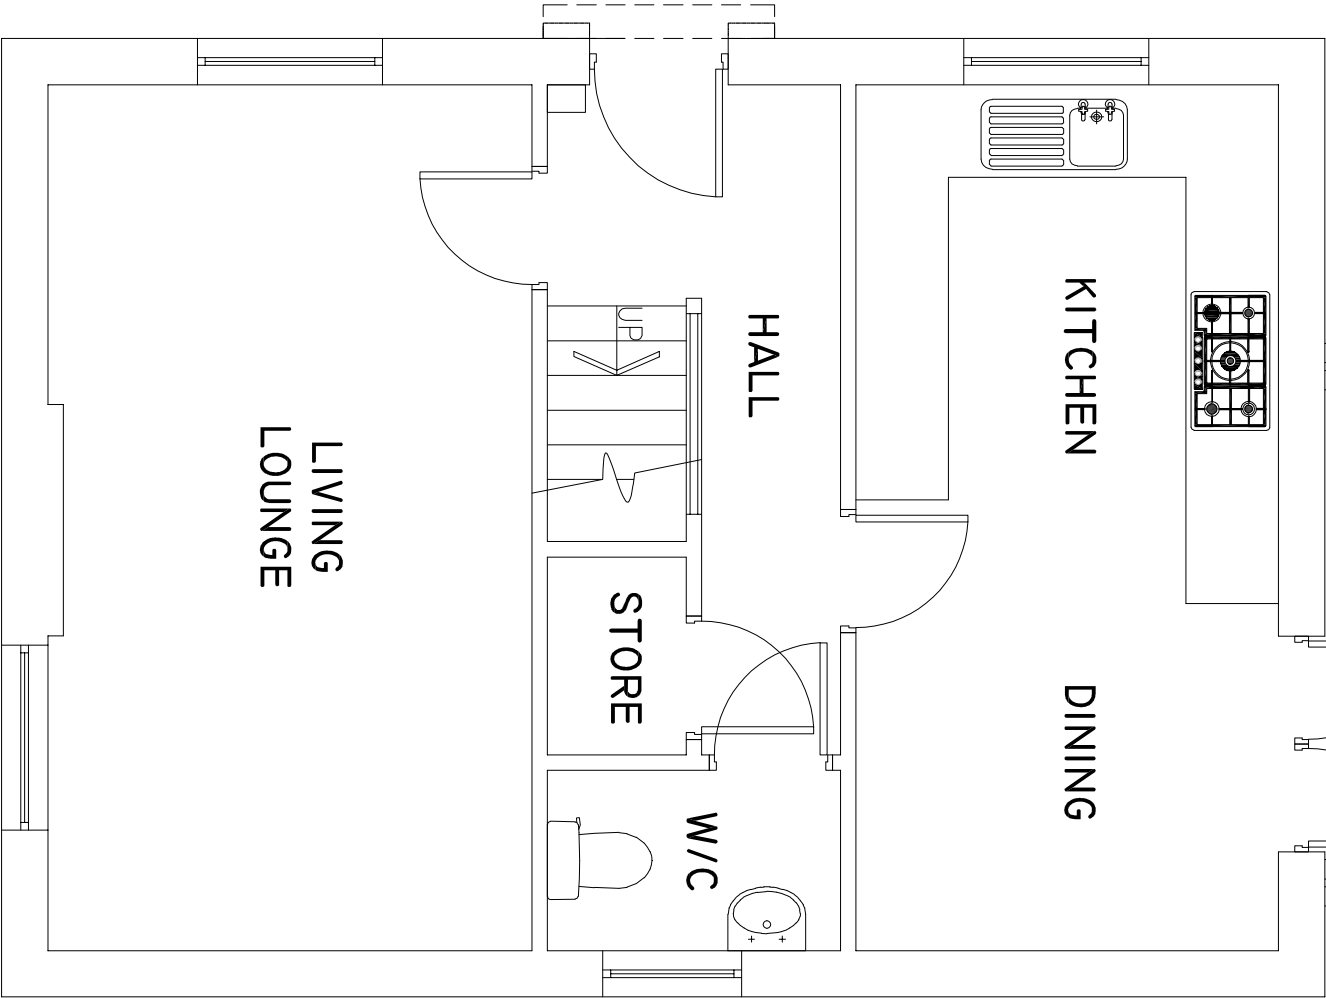
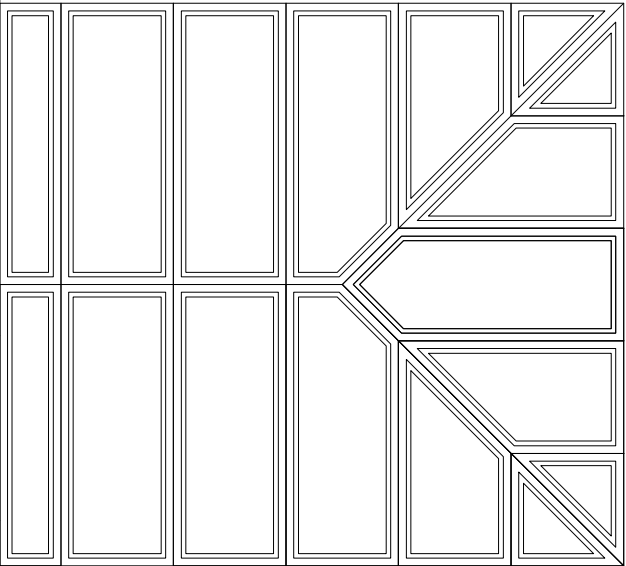


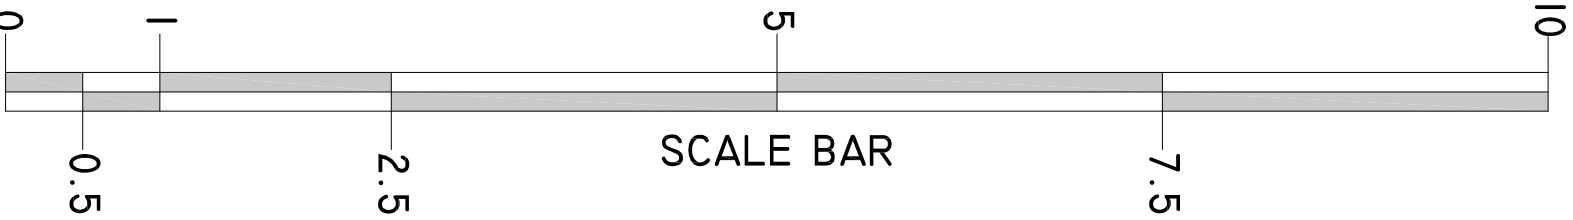

LOCATION PLAN
SCALE 1:1250

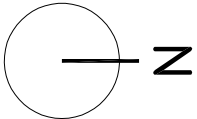

EXISTING GROUND FLOOR PLAN

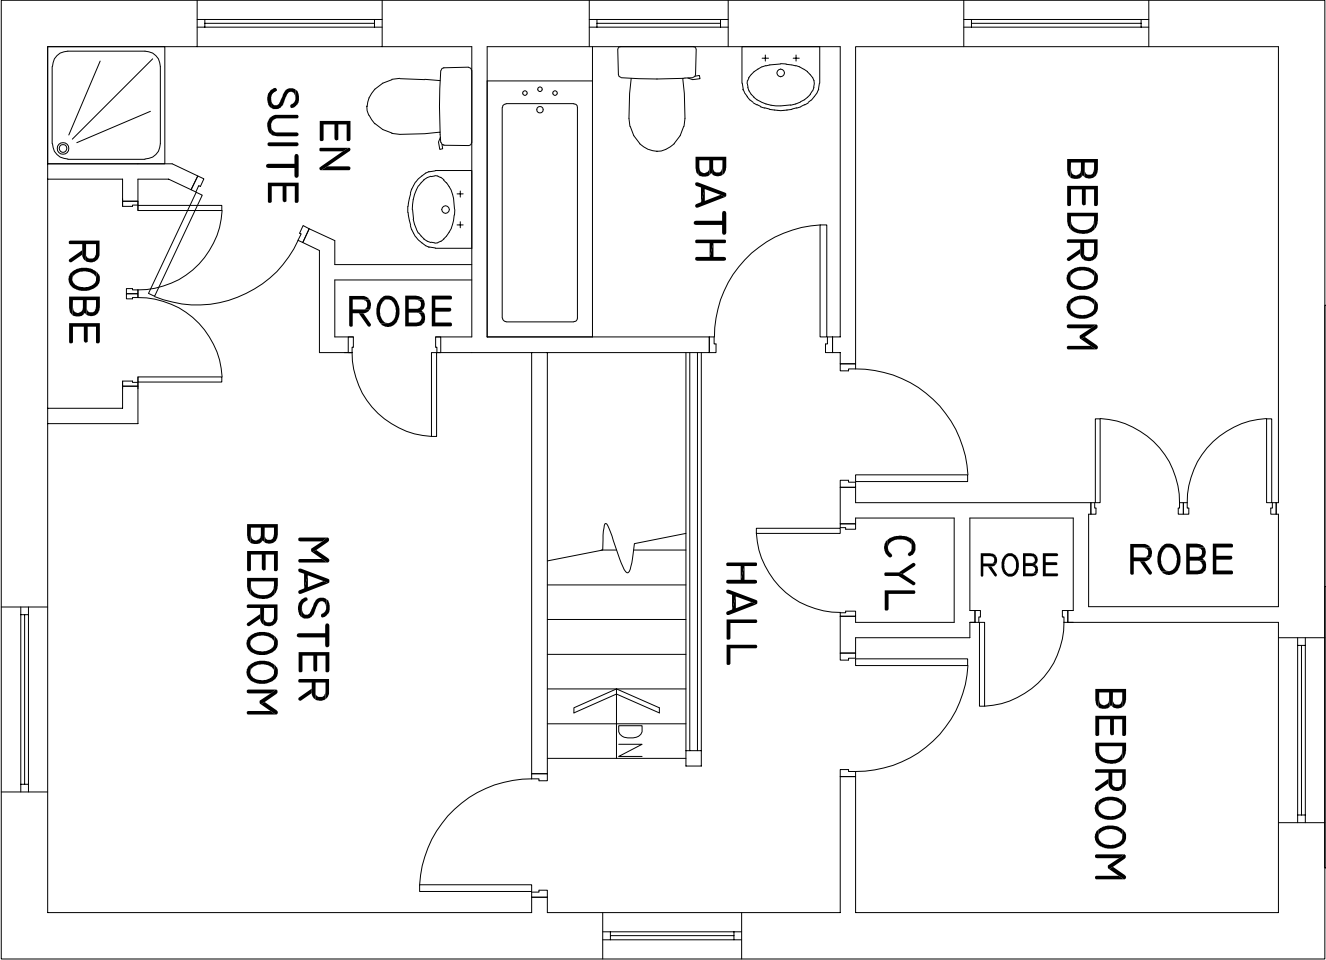

EXISTING FIRST FLOOR PLAN

ESKHANZ DESIGN
planning | design | project management
61 Pinceville St, Bradford
West Yorkshire, BD7 2AG
T. 07967 979977

Project PROPOSED CERTIFICATE OF
LAWFULNESS TO PROPERTY AT NO
47 YOXALL DRIVE, KIRKBY,
LIVERPOOL, L33 4HS
Title AS BUILT FLOOR PLANS

PLANNING			Ref
Date	Revision		

Scale	1:50 @ A3	Drawn	Checked
Date	FEB 22	Status	PLANNING
Dwg. No.	22-012-01		Rev.