

NOTE


This drawing must not be reissued, loaned or copied without the written consent of
Department of Corporate Resources, KMBC, (the originator).
All errors, omissions, discrepancies should be reported to the originator immediately.
All dimensions to be checked before site fabrication by the contractor, his sub-
contractor or supplier.

Any deviation from the drawing to be reported to the originator immediately.

Any mapped information depicted is based on Ordnance Survey material with the
permission of Ordnance Survey on behalf of the Controller of Her Majesty's Stationary
Office Crown Copyright.
Unauthorized reproduction infringes Crown Copyright and may lead to prosecution or
civil proceedings.
Knowsley MBC, LA 100017655
Ref: MAPREF

Drawing issue status:

PRELIMINARY☐ CLIENT APPROVAL☐ PLANNING☐
BUILDING REGS☐ TENDER☐ CONSTRUCTION☐ AS-BUILT☒

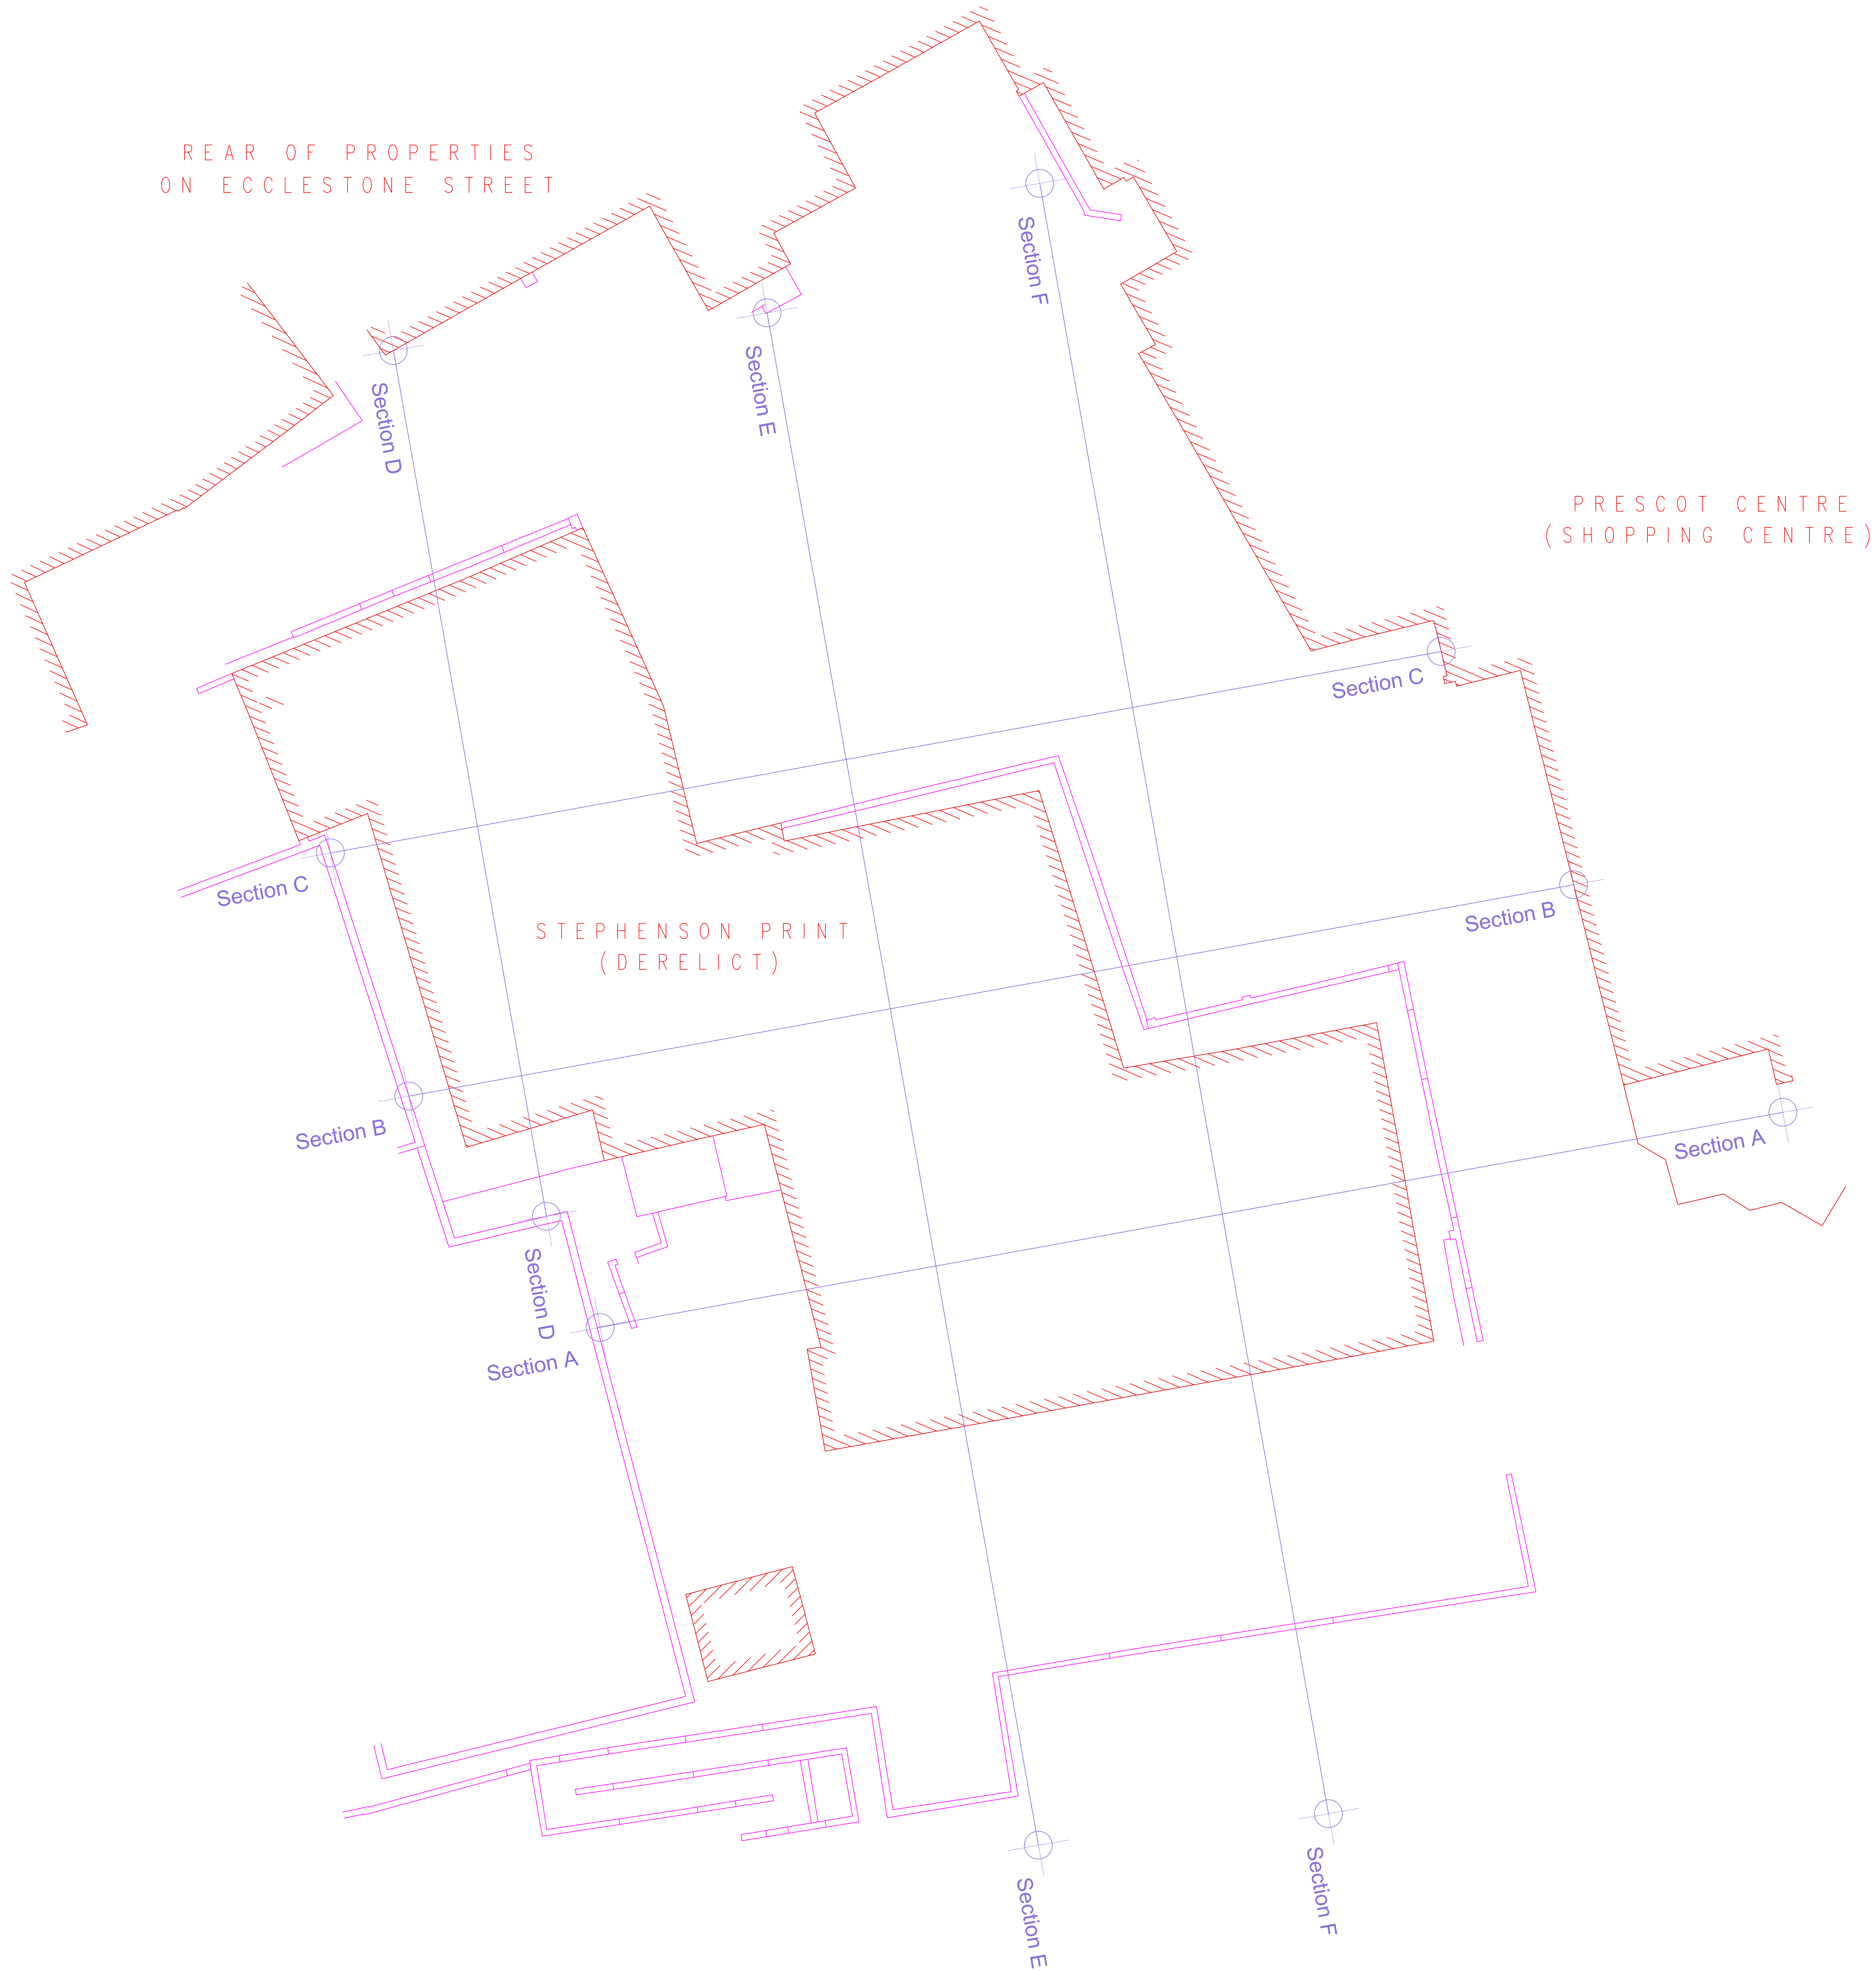

1:100

2m 0 2m 4m 6m 8m 10m

N

REV	DATE	DESCRIPTION
Directorate of Corporate Resources Asset Management 2nd Floor Yorkon Buildings Archway Road Merseyside, L36 9YU Knowsley Council TEL: 0151 443 2611 FAX:		
PROJECT	STEPHENSONS PRINTWORKS	DEMOLITION
SUBJECT	SECTION PLANS	
PROJECT NR	090223	
DRAWING NR	06	
REV	RG	
DATE	19/09/24	
SCALE	1:100@A0	
CHECKED	-	
DRAWN	RG	
CLIENT	KMBC	