

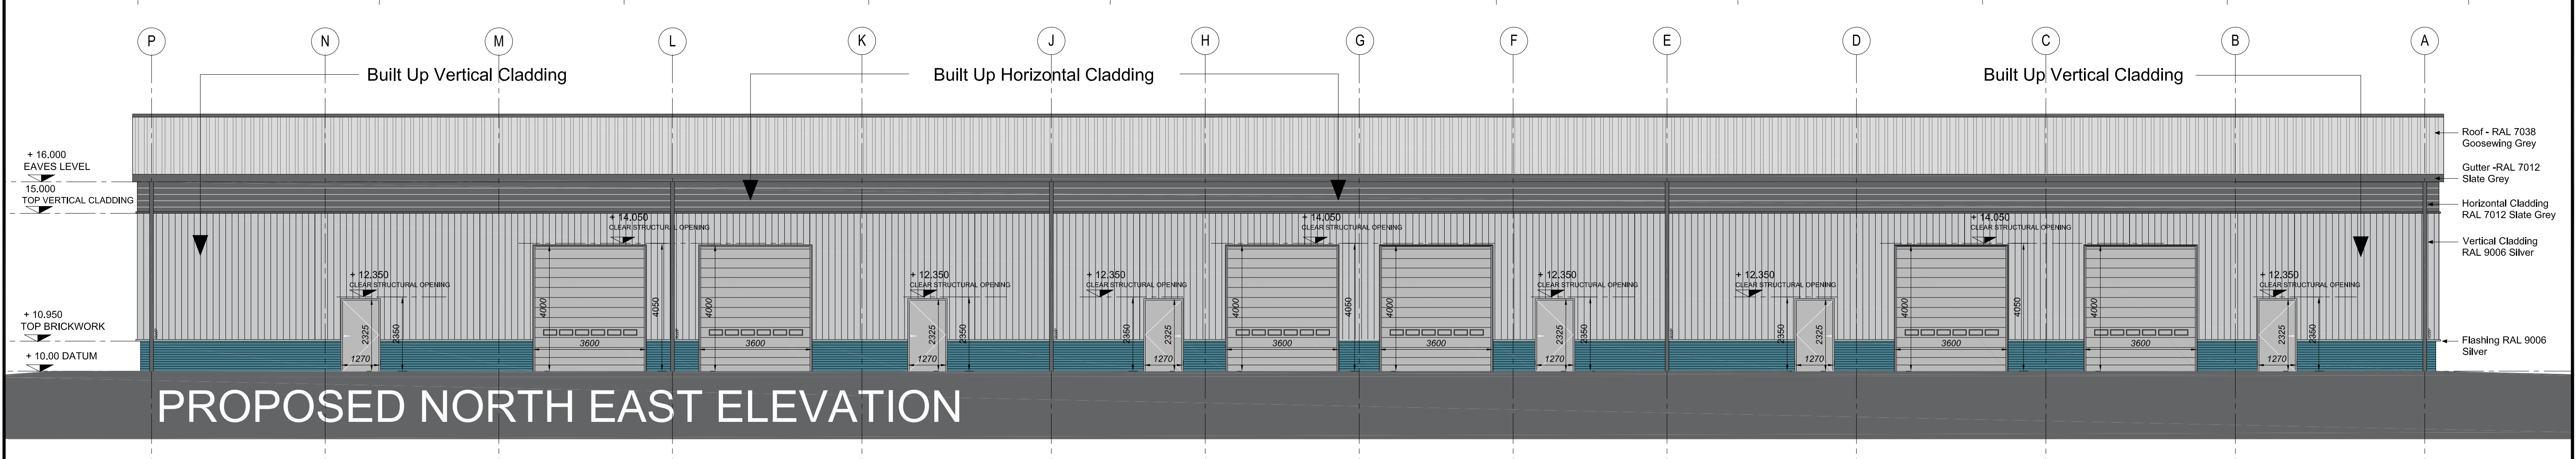


AS BUILT

The Contractor is responsible for checking dimensions and any discrepancy to be verified with the Architects before proceeding. Figured dimensions to be worked to only. Subject to all Local Authority and Statutory approvals.
DO NOT SCALE

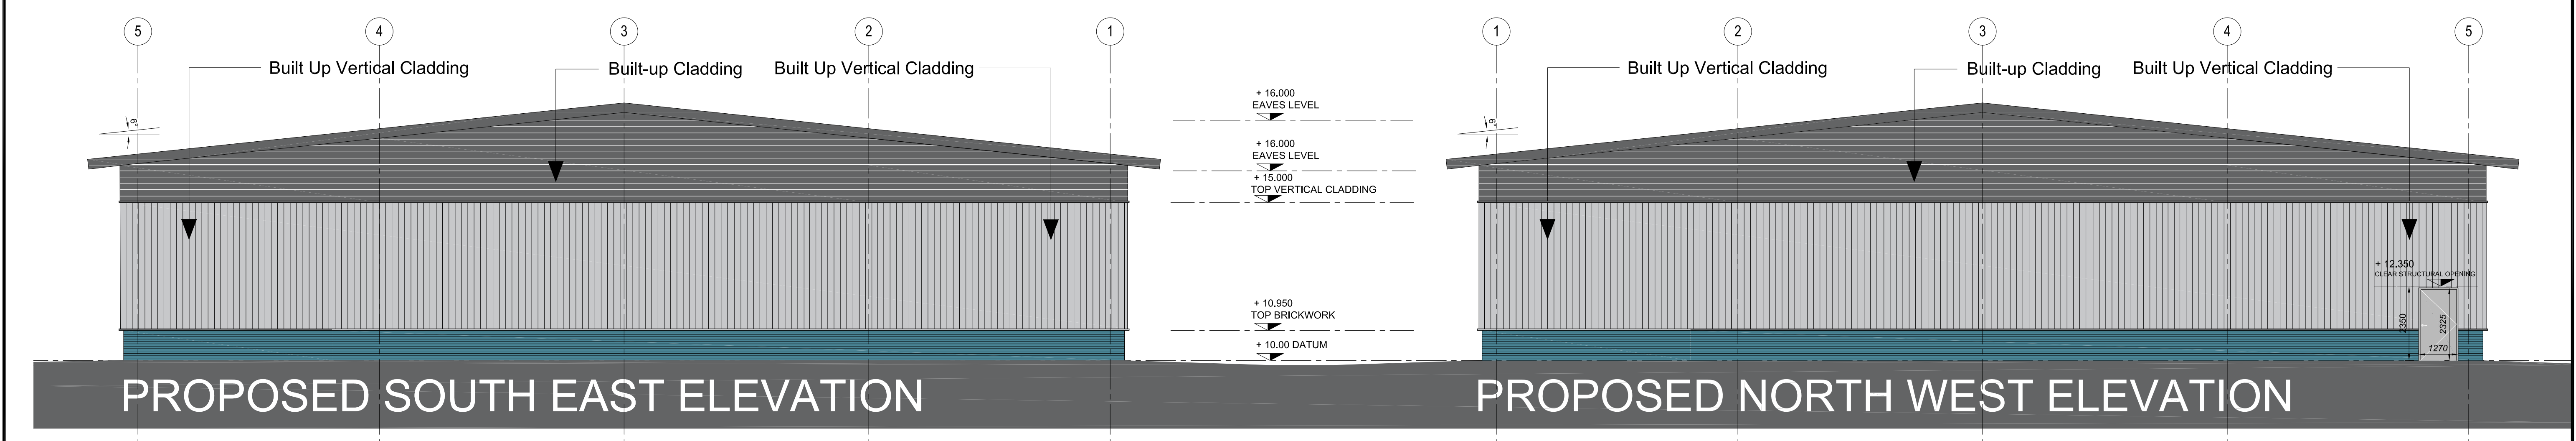

EMERSON HOUSE, HEYES LANE,
ALDERLEY EDGE,
CHESHIRE SK9 7LF
Tel: (01625) 588400, Fax: (01625) 588276

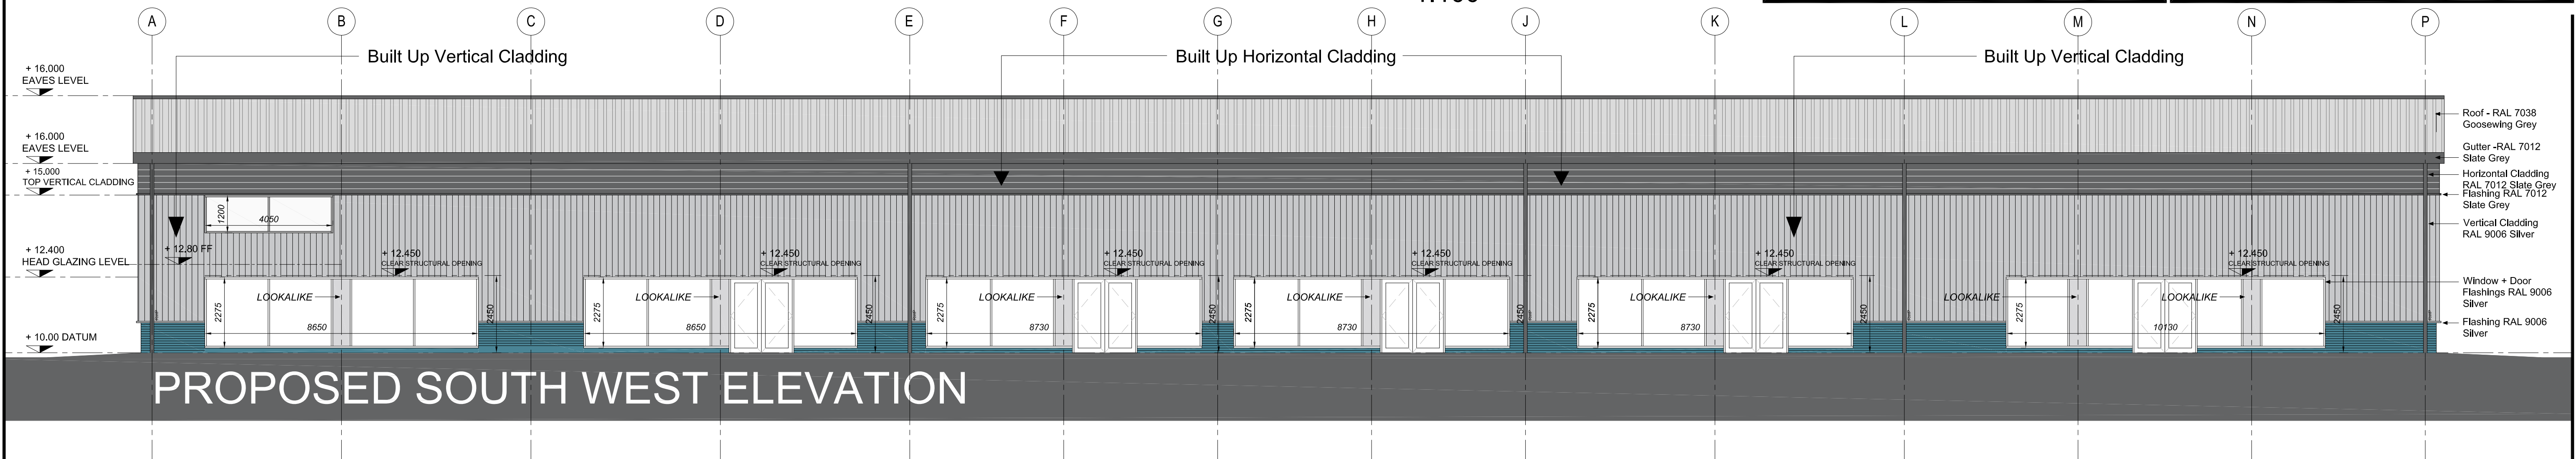

location
Academy Business Park
Lees Road Knowsley L33 7SA

title
UNITS 6C - 6G SINGLE STOREY
PROPOSED ELEVATIONS

scale
1:100 @ A1

ref
t.l.h.

checked

date
21.04.22

drawing no.
1374-AB-6007

REV	DESCRIPTION	DATE